


CURVE DATA

P.I. STA.	0+90.46
P.C. STA.	0+45.68
P.T. STA.	1+12.43
Δ	46° 45' 05" LT
D	100'
R	57.30'
T	24.77'
L	46.75'

PLAN
0 20 40 FEET

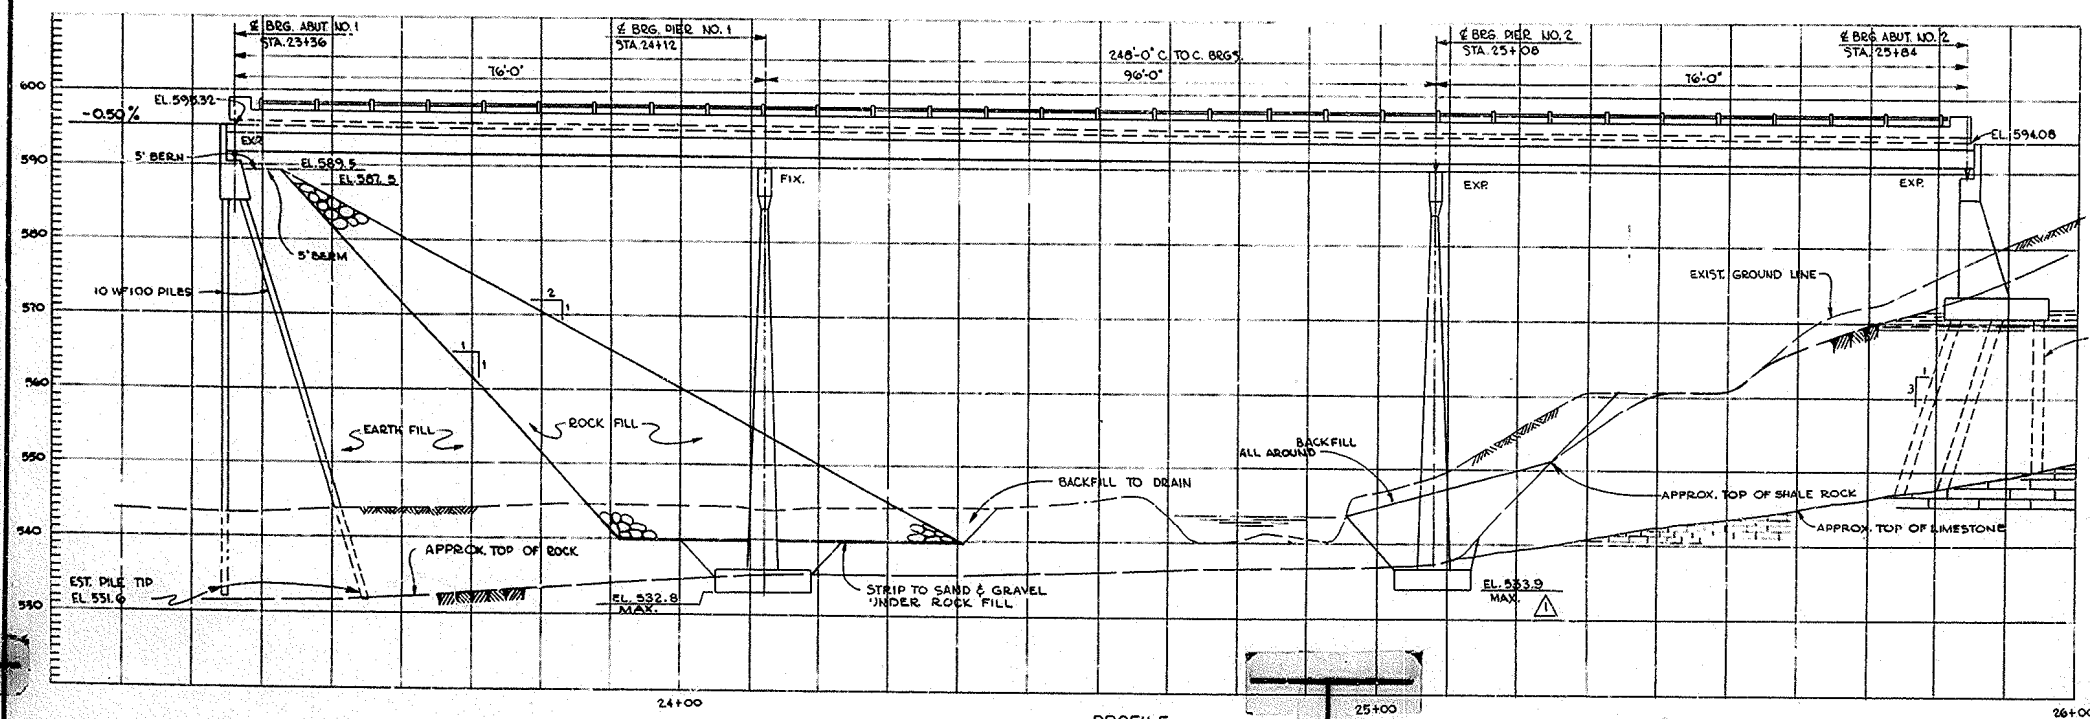

PROFILE

- NOTE:**
1. CONICAL TRANSITION FOR ROCK, PYRAMIDAL FOR EARTH
 2. FLARE SHOULDERS IN 50'
 3. BORINGS SHOWN THUS ●
 4. 10 W/100 PILES TO BE FURNISHED BY GOV'T.


DRILL 10" Ø HOLES THRU SHALE INTO LIMESTONE. SET PILES (10 W/100) AND FILL HOLES WITH CONCRETE.

ALLEN Co. Drawing No. 17553 SHEET 1 of 13


DESIGNED BY:	13 JULY 52	STA., CURVE DATA (ELEV. CHANGED. (AMOUNT. 1. DTD. 14 JUNE 52))	G.C.B.
DRAWN BY: W.E.R.	DATE	DESCRIPTION	BY
TRACED BY: A.J.B.			
CHECKED BY: S.F.F.			
SUBMITTED BY:			
APPROVED BY:			

U.S. ARMY ENGINEER DISTRICT, LOUISVILLE
CORPS OF ENGINEERS
LOUISVILLE, KENTUCKY

OHIO RIVER BASIN
BARREN RIVER RESERVOIR
SITE NO. 13 - RELOCATION COUNTY RD. NO. 224
TRACE CREEK BRIDGE
PLAN & PROFILE

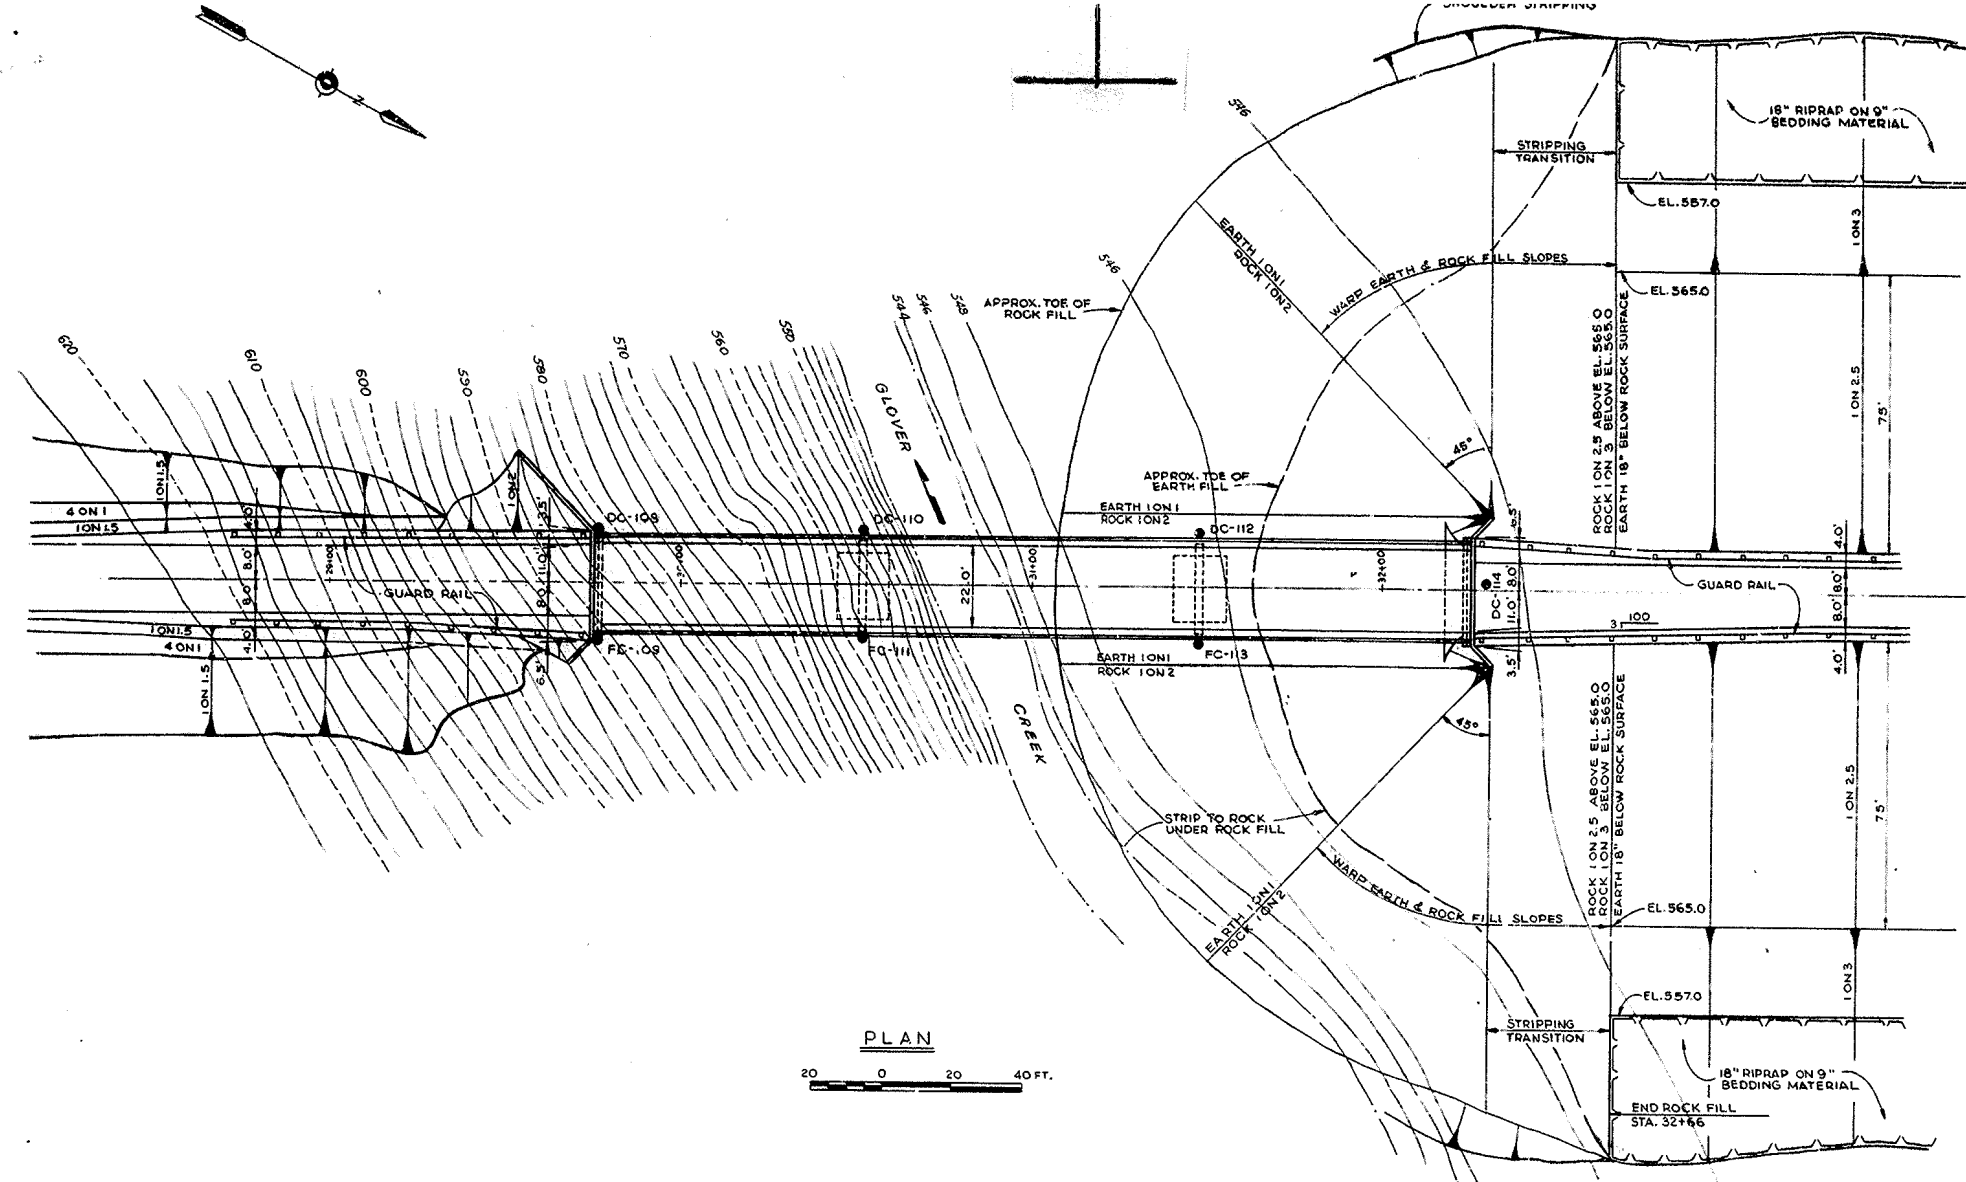

PLAN
0 20 40 FT.

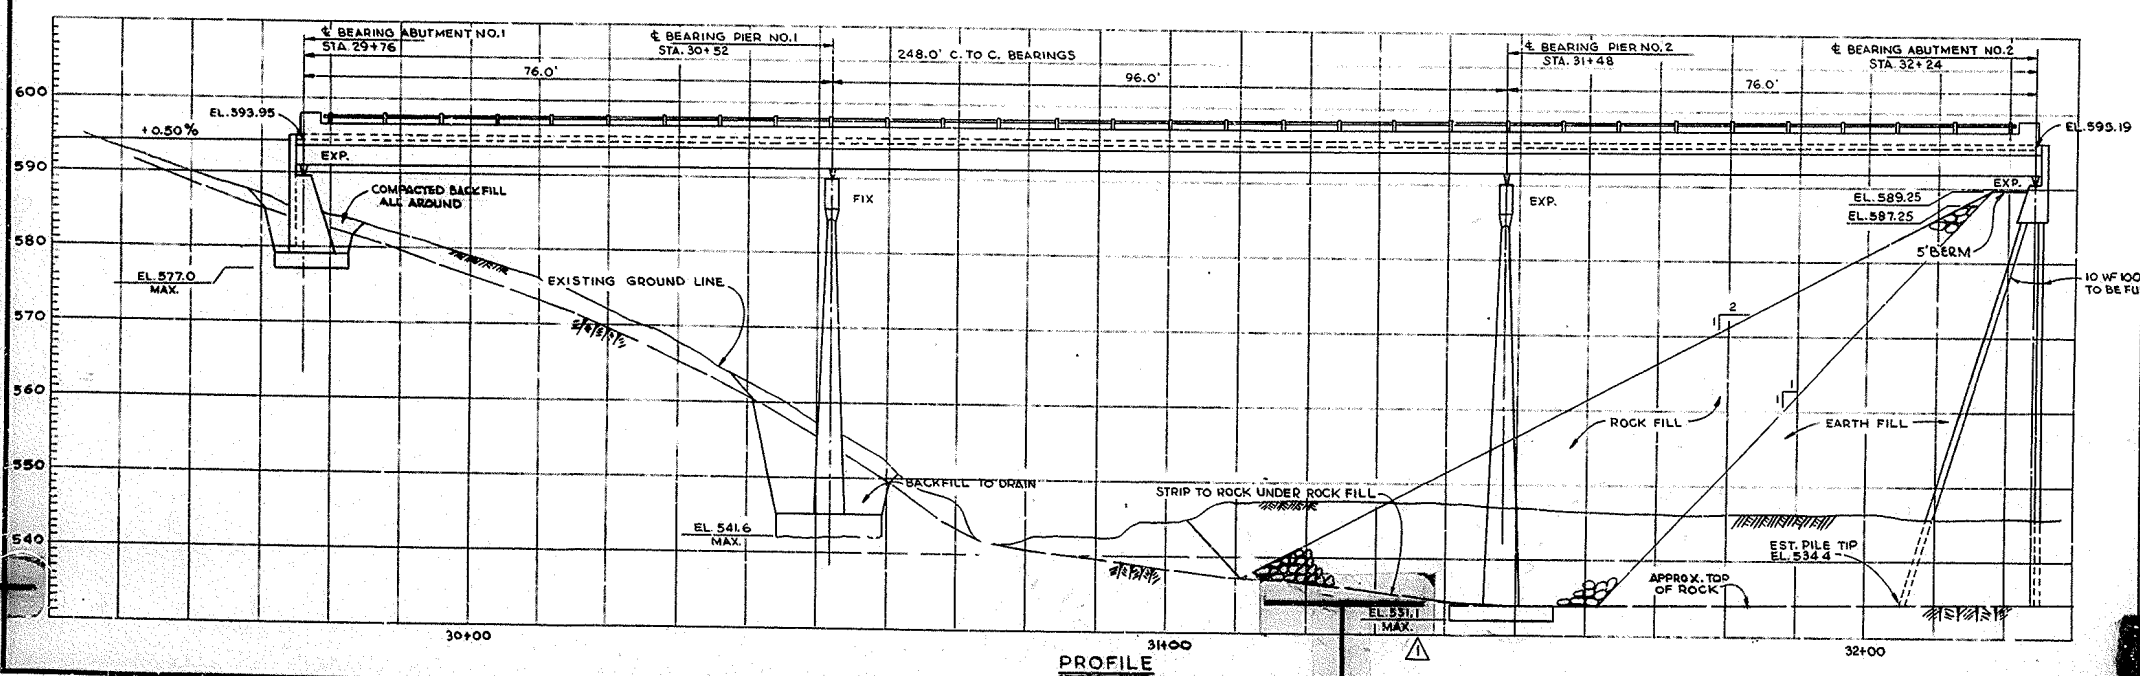





PROFILE

- NOTES:
 1. CONICAL TRANSITION FOR ROCK, PYRAMIDAL FOR EARTH.
 2. FLARE SHOULDERS IN 50'
 3. BORINGS SHOWN THUS: ●

10 WF 100 PILES TO BE FURNISHED BY GOVT. ALLEN CO. DRAWING NO. 17553 SHEET 2



DESIGNED BY:	13 MAY 52	ELEVATION CHANGED (AMDT #1, DTD. 14 JUNE 52)	G.C.B.
DRAWN BY: WER-M.O.R.	DATE	DESCRIPTION	BY
TRACED BY: C.T.B.			
CHECKED BY: S.F.F.			
SUBMITTED BY:			
APPROVED BY:			
U.S. ARMY ENGINEER DISTRICT, LOUISVILLE CORPS OF ENGINEERS LOUISVILLE, KENTUCKY			
OHIO RIVER BASIN BARREN RIVER RESERVOIR SITE NO. 13-RELOCATION COUNTY RD. NO. 224 GLOVER CREEK BRIDGE PLAN & PROFILE			
DATE:			

RECORD DRAWING "AS BUILT"

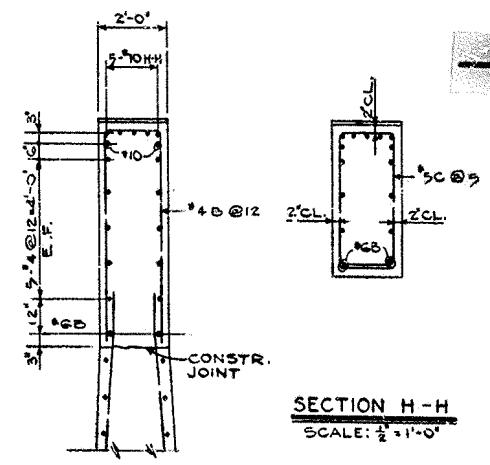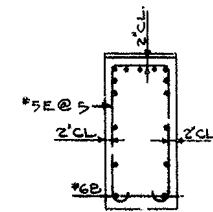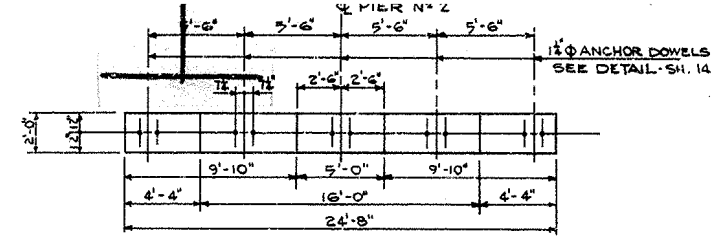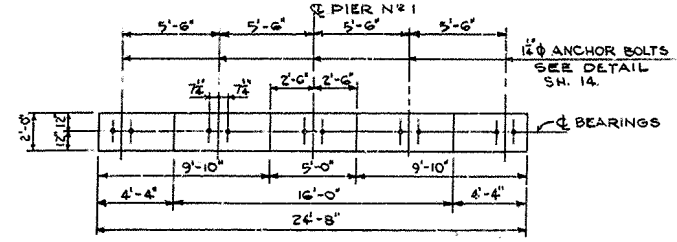

SECTION F-F
SCALE: 1/2" = 1'-0"

NOTE:
LOCATE TOP FACE BARS
TO AVOID ANCHOR BOLTS
AND DOWEL PINS.

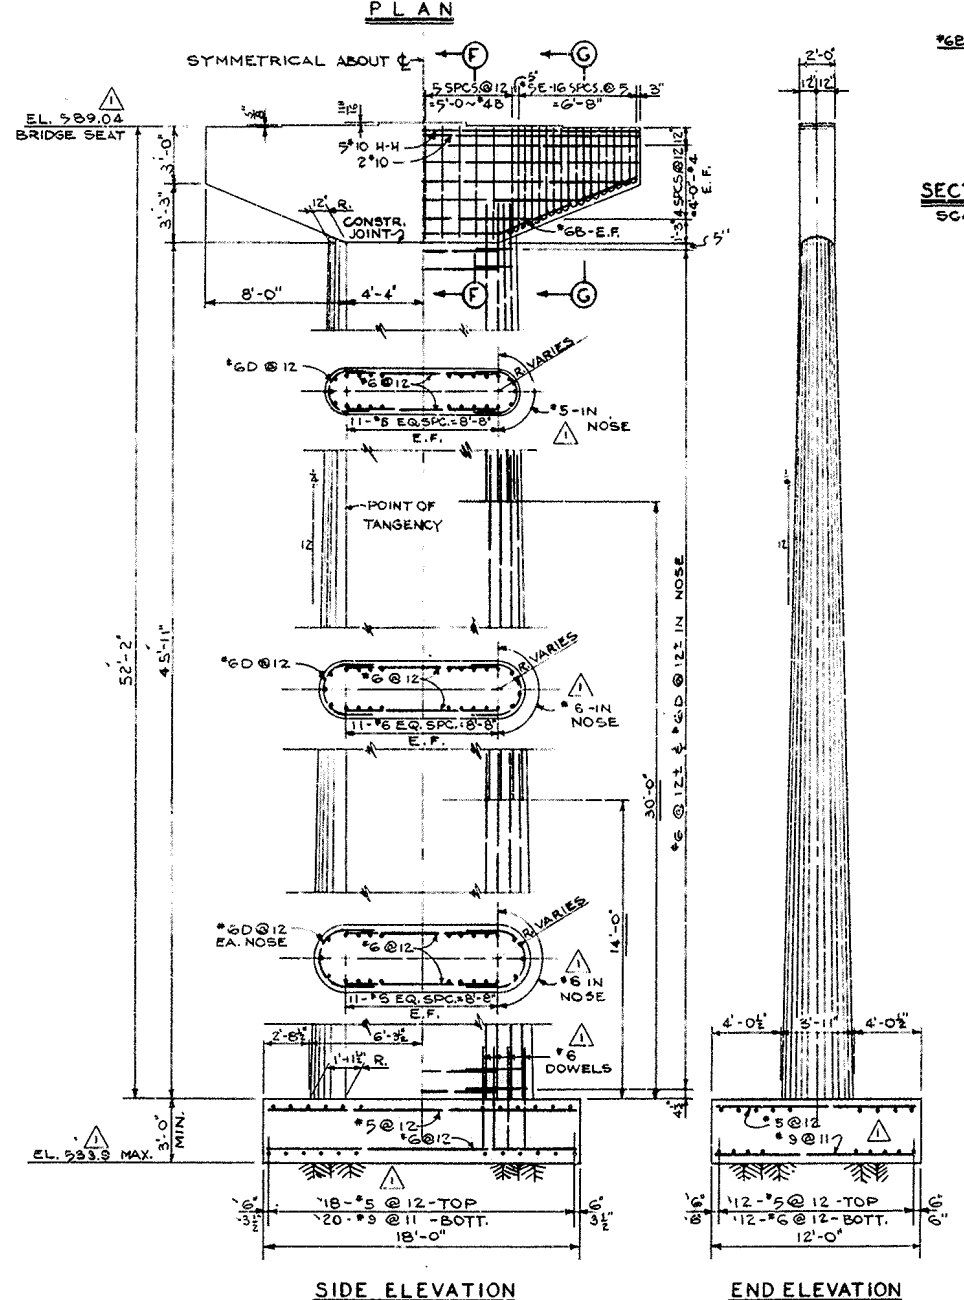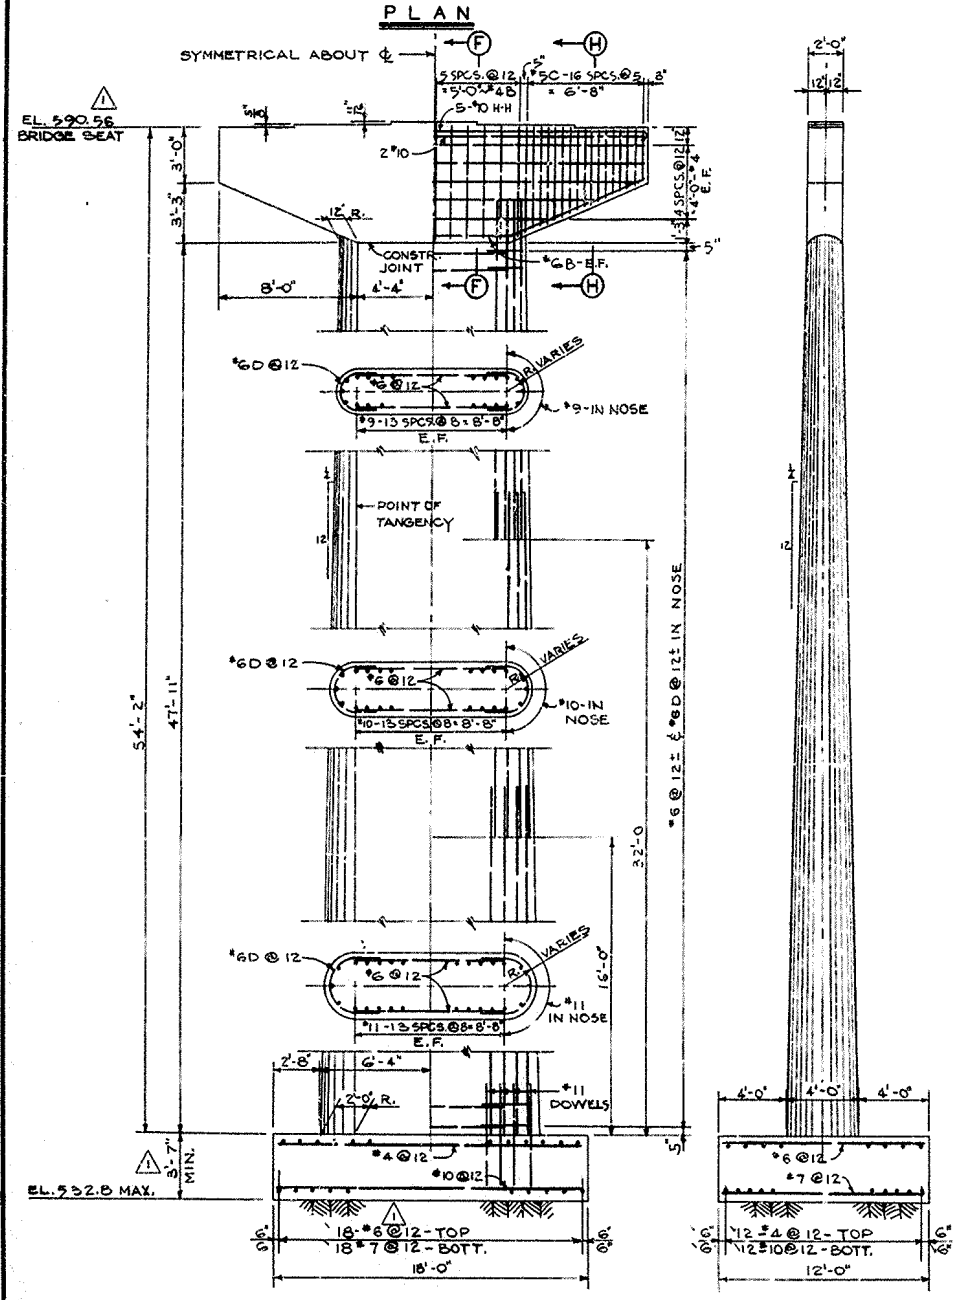

ALLEN Co. DRAWING No. 17553 SHEET 6


REVISION	DATE	DESCRIPTION	BY
1	13 JULY 72	ELEVATIONS, DIMENSIONS, BAR SIZE AND SPACING	
		CHANGED. (AMDT. #1, DTD. 14 JUNE 72)	G.C.B.

U.S. ARMY ENGINEER DISTRICT, LOUISVILLE
CORPS OF ENGINEERS
LOUISVILLE, KENTUCKY


DESIGNED BY: _____
DRAWN BY: V.H.P.
TRACED BY: _____
CHECKED BY: S.F.F.
SUBMITTED BY: _____
APPROVED BY: _____
DATE: _____

OHIO RIVER BASIN
BARREN RIVER RESERVOIR
SITE NO. 13-RELOCATION COUNTY RD. NO. 224
TRACE CREEK BRIDGE
PIERS

RECORD DRAWING-"AS BUILT"

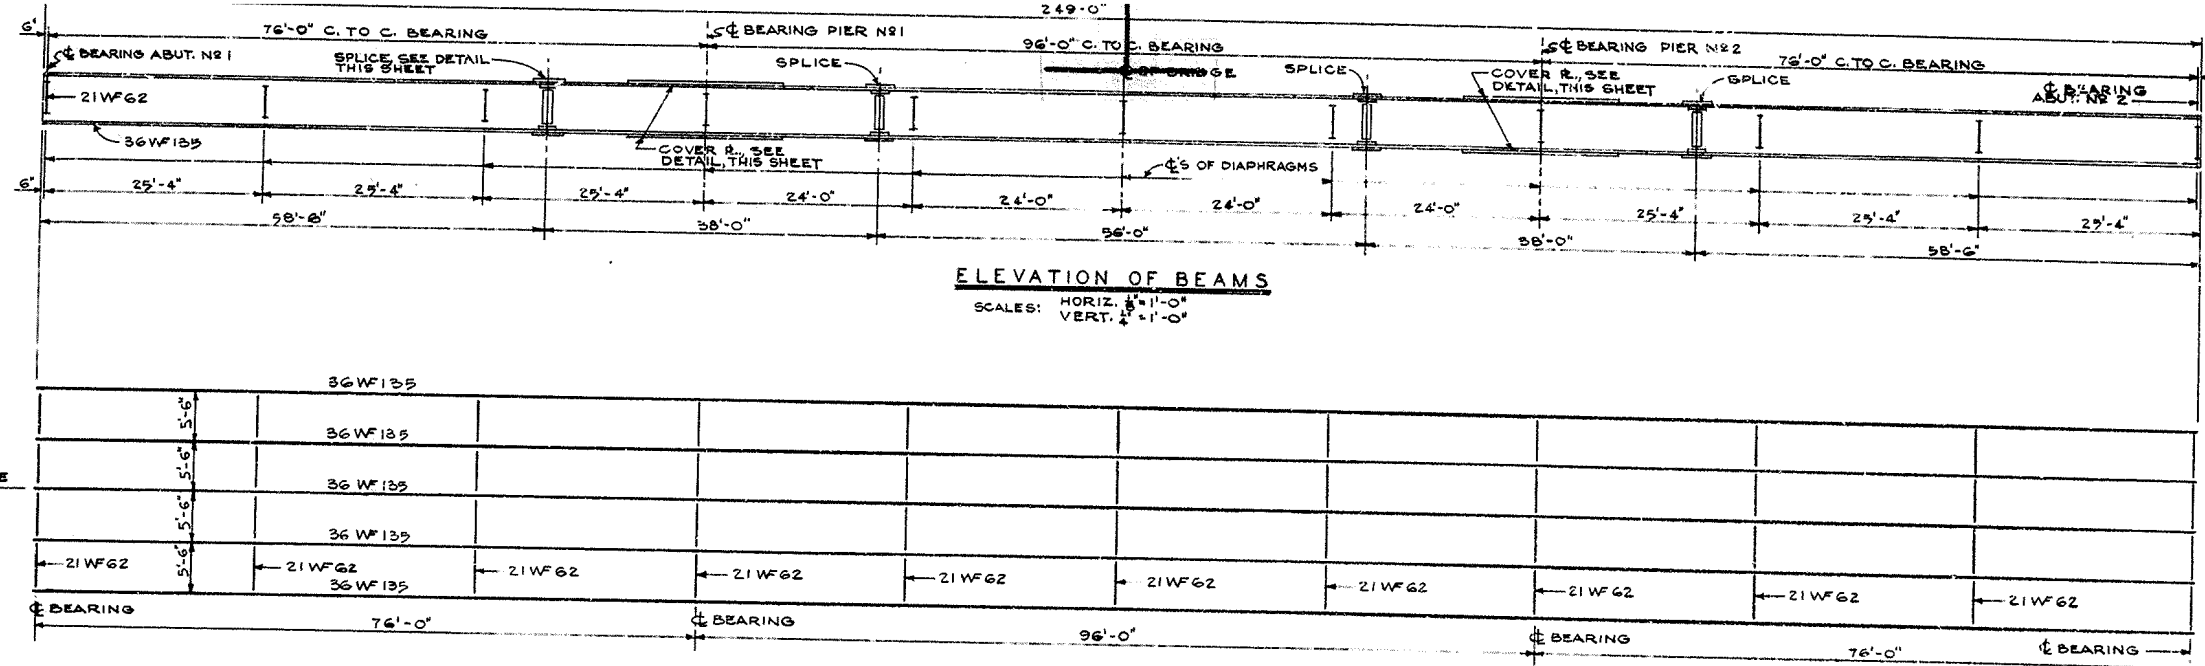


ELEVATION OF BEAMS
 SCALES: HORIZ. $\frac{1}{8}'' = 1'-0''$
 VERT. $\frac{1}{4}'' = 1'-0''$

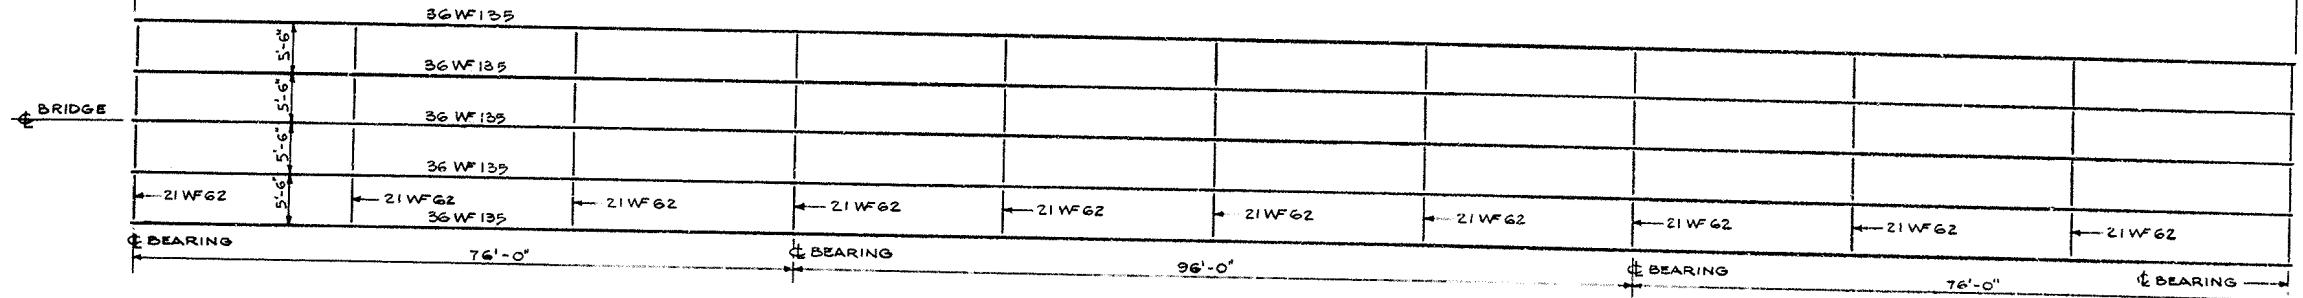


PLAN OF BEAMS
 SCALE: $\frac{1}{8}'' = 1'-0''$


NOTE:
 E-D INDICATES END DIAPHRAGM
 I-D INDICATES INTERMEDIATE DIAPHRAGM

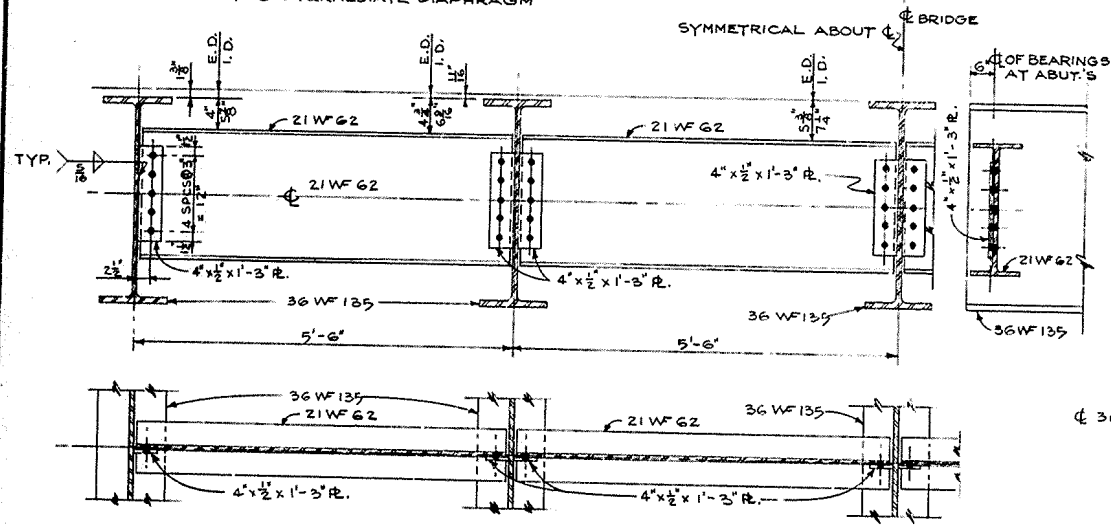

END & INTERMEDIATE DIAPHRAGMS
 SCALE: $1'' = 1'-0''$

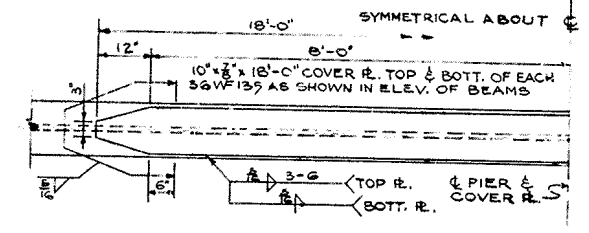


COVER PLATE DETAIL
 SCALE: $\frac{1}{2}'' = 1'-0''$

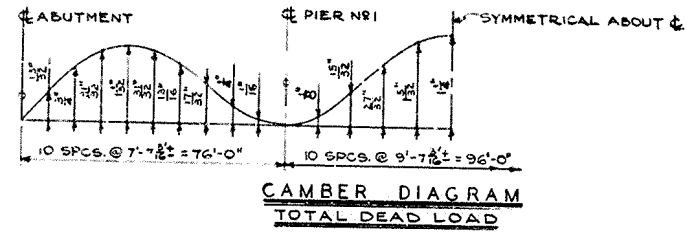


CAMBER DIAGRAM
 TOTAL DEAD LOAD

NOTE:
 TOTAL DEADLOAD INCLUDES CONCRETE DECK, HANDRAIL, FUTURE SURFACING AND STRUCTURAL STEEL.

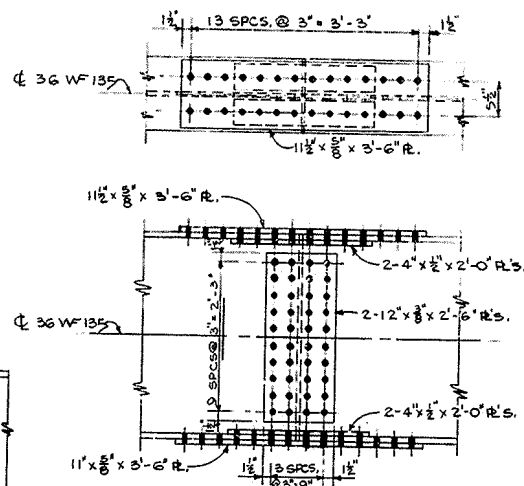

NOTE:
 ANY SPLICE MAY BE OMITTED AT THE CONTRACTOR'S OPTION.
SPlice DETAIL
 SCALE: $1'' = 1'-0''$

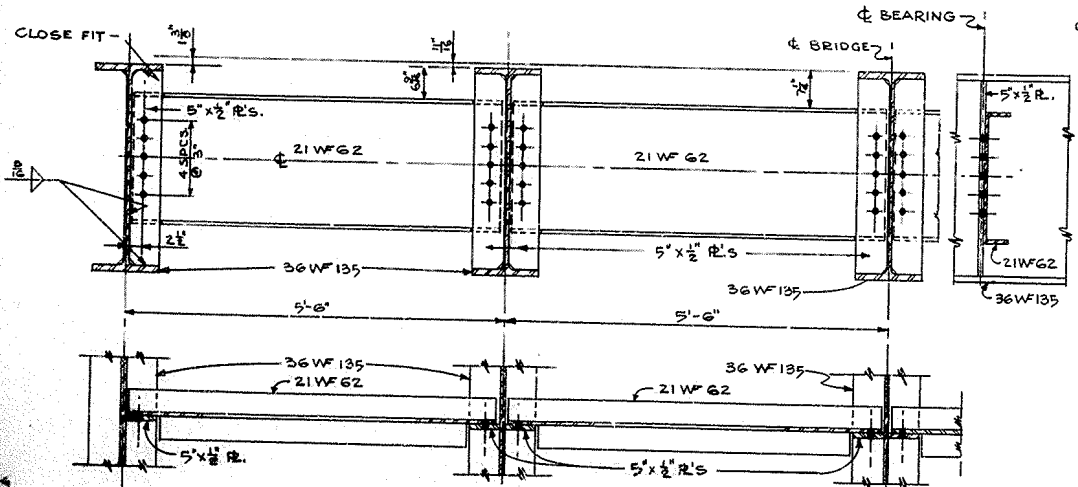

DIAPHRAGMS OVER PIERS
 SCALE: $1'' = 1'-0''$

NOTES

- 1- OPEN HOLES $\frac{1}{8}'' \phi$, FOR $\frac{3}{8}''$ HIGH STRENGTH BOLTS OR RIVETS
- 2- MATERIAL: BEAMS & COVER PLATES - ASTM-A36, REMAINDER - ASTM-A7.
- 3- FOR EXPANSION JOINT DETAILS, SEE SH. 23.
- 4- FOR BEARING DETAILS, SEE SH. 42.
- 5- BEAMS TO BE FABRICATED AND ERECTED WITH THE NATURAL CAMBER OF BEAM UP.

ALLEN Co. Drawing No. 17553 SHEET 8

REVISION	DATE	DESCRIPTION	BY

DESIGNED BY: S.F.F.
 DRAWN BY: E.P.S.
 CHECKED BY: V.H.P.
 SUBMITTED: [Signature]
 APPROVED: [Signature] DATE: MAY 1962

U.S. ARMY ENGINEER DISTRICT, LOUISVILLE
 CORPS OF ENGINEERS
 LOUISVILLE, KENTUCKY



OHIO RIVER BASIN
 BARREN RIVER RESERVOIR
 SITE NO.13-RELOCATION COUNTY RD. NO.224
 GLOVER & TRACE CREEK BRIDGES
 FRAMING

STATION	BEAM "C"		BEAM "B"		BEAM "D"		BEAM "A"		BEAM "E"	
	PROFILE GRADE	CONSTR. ELEV. TOP OF STEEL	CONSTR. ELEV. TOP OF STEEL	X	CONSTR. ELEV. TOP OF STEEL	X	CONSTR. ELEV. TOP OF STEEL	X	CONSTR. ELEV. TOP OF STEEL	X
29+76.0	593.950	593.950			593.888			593.834		
29+83.6	593.988	594.016			593.954			593.902		
29+91.2	594.022	594.077			594.019			593.963		
29+98.8	594.064	594.150			594.068			594.016		
30+06.4	594.102	594.173			594.111			594.059		
30+14.0	594.140	594.207			594.145			594.093		
30+21.6	594.178	594.232			594.170			594.118		
30+29.2	594.216	594.251			594.183			594.137		
30+36.8	594.254	594.270			594.208			594.154		
30+44.4	594.292	594.293			594.231			594.179		
30+52.0	594.330	594.330			594.268			594.216		
30+59.6	594.378	594.383			594.321			594.269		
30+67.2	594.426	594.454			594.392			594.340		
30+74.8	594.474	594.528			594.464			594.414		
30+82.4	594.522	594.594			594.534			594.482		
31+00.0	594.570	594.651			594.599			594.537		
31+07.6	594.618	594.692			594.630			594.578		
31+15.2	594.666	594.720			594.658			594.605		
31+22.8	594.714	594.742			594.742			594.628		
31+30.4	594.762	594.767			594.705			594.653		
31+38.0	594.810	594.810			594.748			594.696		
31+45.6	594.848	594.849			594.787			594.735		
31+53.2	594.886	594.902			594.840			594.788		
31+60.8	594.924	594.959			594.897			594.845		
31+68.4	594.962	595.016			594.954			594.902		
31+76.0	595.07	595.067			595.005			594.953		
31+83.6	595.038	595.099			595.047			594.995		
32+01.2	595.076	595.142			595.090			595.028		
32+08.8	595.114	595.165			595.103			595.051		
32+16.4	595.152	595.180			595.118			595.066		
32+24.0	595.190	595.190			595.128			595.076		




TABLE OF SCREED ELEVATIONS
"GLOVER CREEK" BRIDGE -- SITE 13

STATION	BEAM "C"		BEAM "B"		BEAM "D"		BEAM "A"		BEAM "E"	
	PROFILE GRADE	CONSTR. ELEV. TOP OF STEEL	CONSTR. ELEV. TOP OF STEEL	X	CONSTR. ELEV. TOP OF STEEL	X	CONSTR. ELEV. TOP OF STEEL	X	CONSTR. ELEV. TOP OF STEEL	X
23+36.0	595.320	595.320			595.258			595.208		
23+43.6	595.282	595.310			595.248			595.194		
23+51.2	595.244	595.299			595.233			595.181		
23+58.8	595.206	595.272			595.210			595.158		
23+66.4	595.168	595.239			595.177			595.123		
23+74.0	595.130	595.197			595.137			595.083		
23+81.6	595.092	595.146			595.084			595.032		
23+89.2	595.054	595.089			595.027			594.975		
23+96.8	595.016	595.032			594.970			594.918		
23+104.4	594.978	594.979			594.917			594.865		
24+12.0	594.940	594.940			594.878			594.825		
24+19.6	594.892	594.897			594.835			594.783		
24+27.2	594.844	594.872			594.810			594.755		
24+34.8	594.796	594.850			594.788			594.734		
24+42.4	594.748	594.822			594.760			594.708		
24+50.0	594.700	594.781			594.729			594.667		
24+57.6	594.652	594.724			594.694			594.612		
24+65.2	594.604	594.658			594.667			594.544		
24+72.8	594.556	594.604			594.624			594.522		
24+80.4	594.508	594.584			594.584			594.470		
24+88.0	594.460	594.460			594.491			594.397		
24+95.6	594.412	594.422			594.446			594.346		
25+03.2	594.364	594.400			594.361			594.305		
25+10.8	594.316	594.381			594.338			594.282		
25+18.4	594.268	594.342			594.319			594.267		
25+26.0	594.220	594.322			594.300			594.248		
25+33.6	594.172	594.303			594.275			594.223		
25+41.2	594.124	594.280			594.239			594.189		
25+48.8	594.076	594.260			594.194			594.145		
25+56.4	594.028	594.207			594.145			594.093		
25+64.0	593.980	594.146			594.084			594.032		
25+71.6	593.932	594.080			594.018			593.964		


TABLE OF SCREED ELEVATIONS
"TRACE CREEK" BRIDGE -- SITE 13

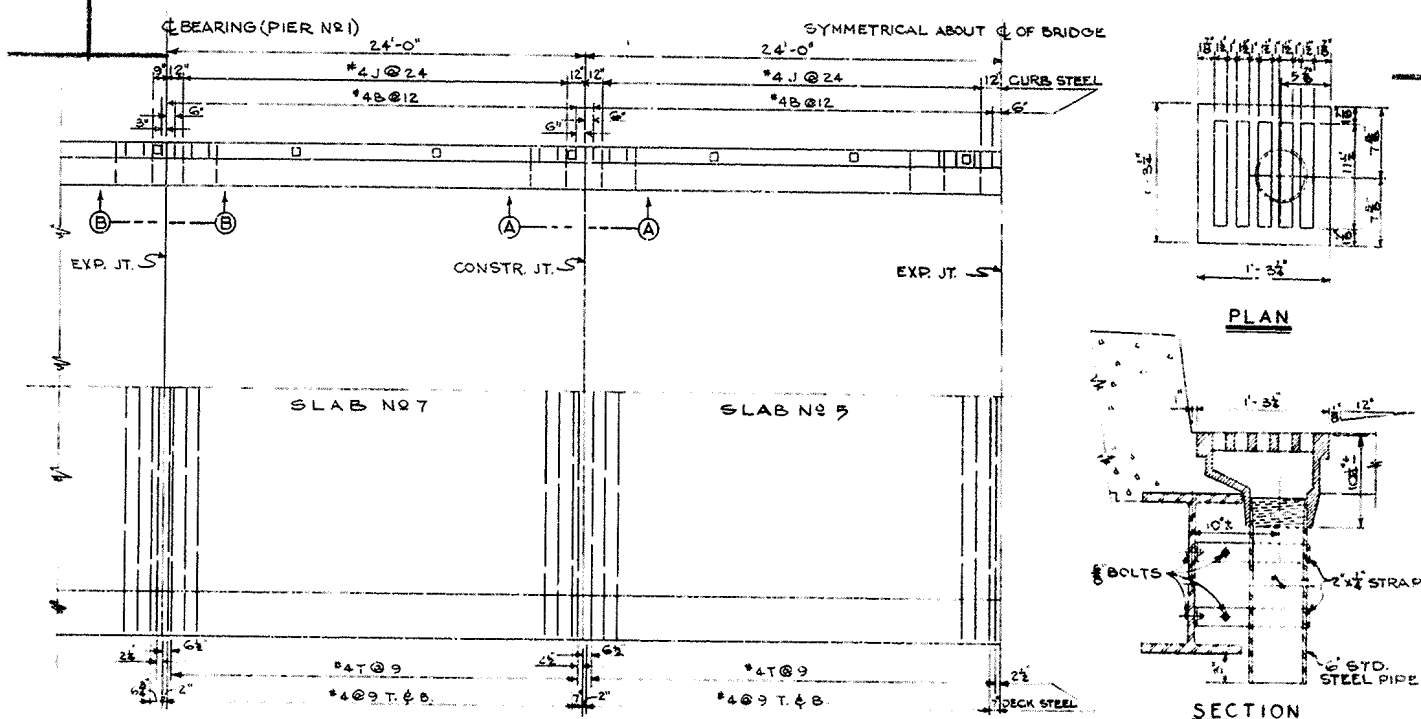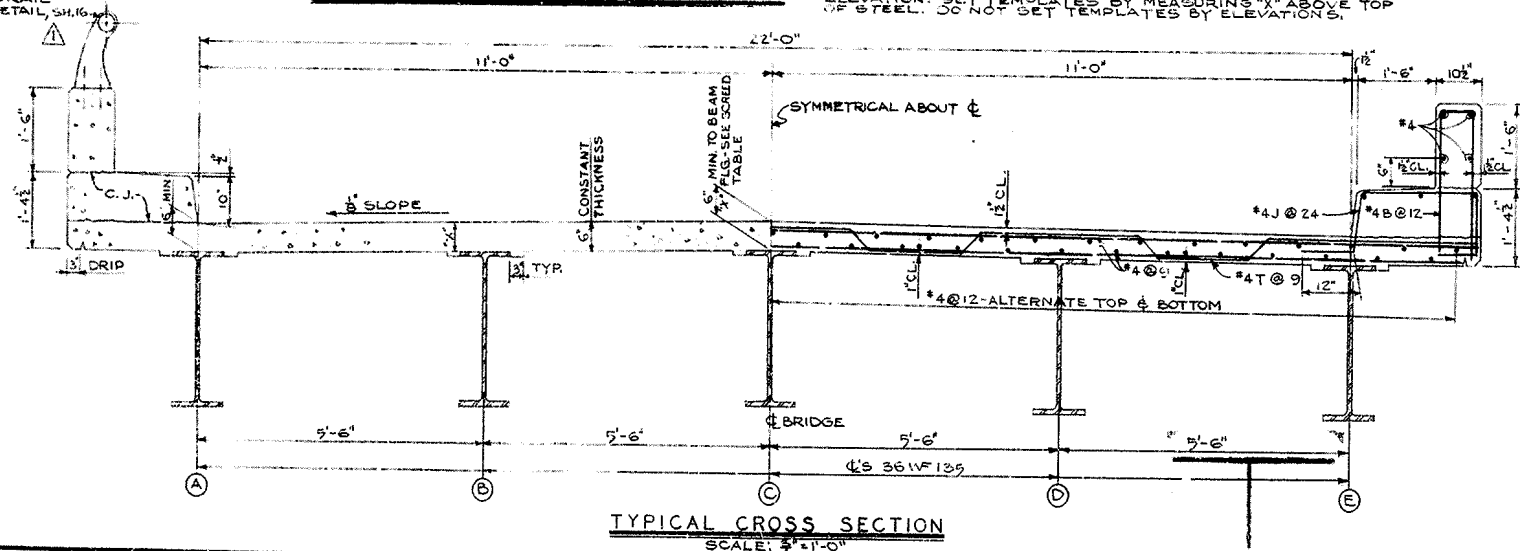

PARTIAL PLAN OF BRIDGE
REINFORCING
SCALE: 1/4" = 1'-0"

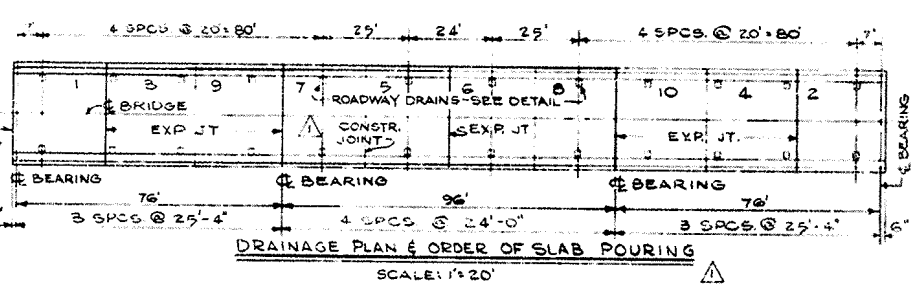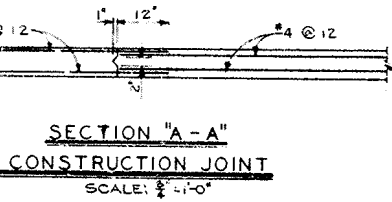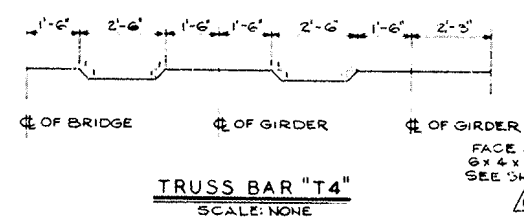

ELEVATION OF BRIDGE HANDRAIL
SCALE: 1/4" = 1'-0"

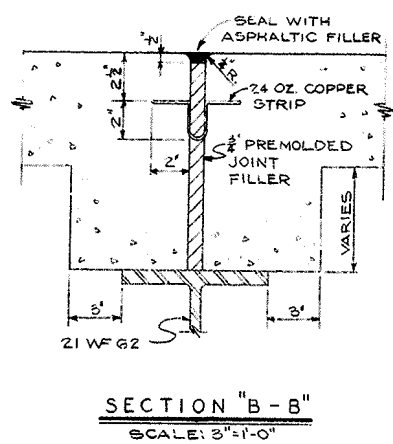

NOTES:
1- FOR REINFORCING STEEL COVERAGE NOTES & BAR ENDING SCHEDULE, SEE SH. 13
2- FOR GENERAL NOTES, SEE SH. 13
3- FOR DETAILS OF END POST, SEE SH. 16.

ALLEN CO. DRAWING NO. 17533 SHEET 3

REVISION	DATE	DESCRIPTION	BY

U.S. ARMY ENGINEER DISTRICT, LOUISVILLE
CORPS OF ENGINEERS
LOUISVILLE, KENTUCKY

DESIGNED BY: S.F.F.
DRAWN BY: V.H.P.
TRACED BY: V.H.P.
CHECKED BY: JFF
SUBMITTED: *R. Karlar*
ASST. CHIEF ENGINEERING DIV.


OHIO RIVER BASIN
BARREN RIVER RESERVOIR
SITE NO. 13-RELOCATION COUNTY RD. NO. 224
GLOVER & TRACE CREEK BRIDGES
DECK

APPROVED: *Allen*
CHIEF ENGINEERING DIV.

APPROVED: *Allen*
SUPERVISOR


MAY 1962

DRAWING NUMBER
BR 79-12.6/41

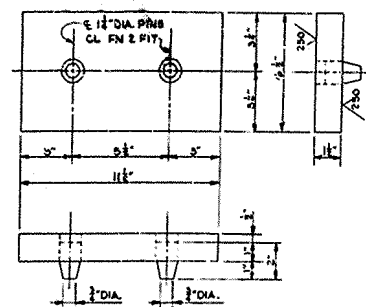


TOP SHOE

MAKE: 20 MATERIAL: STRUCT. STEEL A373

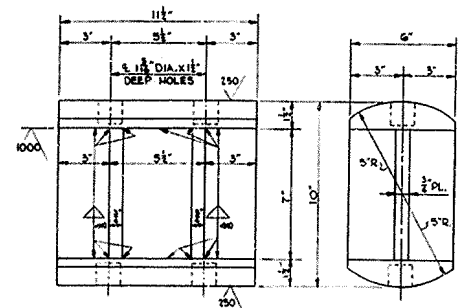


ROCKER

MAKE: 20 MATERIAL: STRUCT. STEEL A373

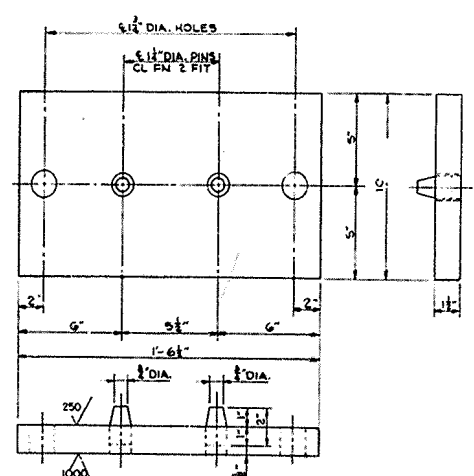


BOTTOM SHOE

MAKE: 20 MATERIAL: STRUCT. STEEL A373
SCALE: 3"=1'-0"

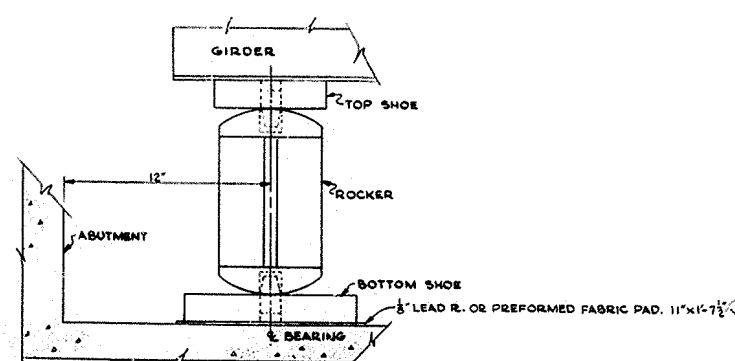


ABUTMENTS NO. 1 & 2

EXPANSION BEARING ASSEMBLY

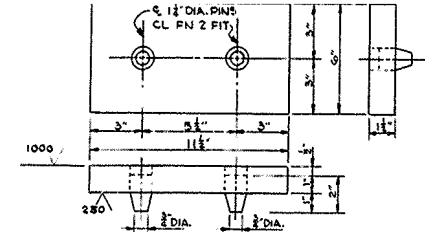


TOP SHOE

MAKE: 10 MATERIAL: LOW ALLOY STEEL A441

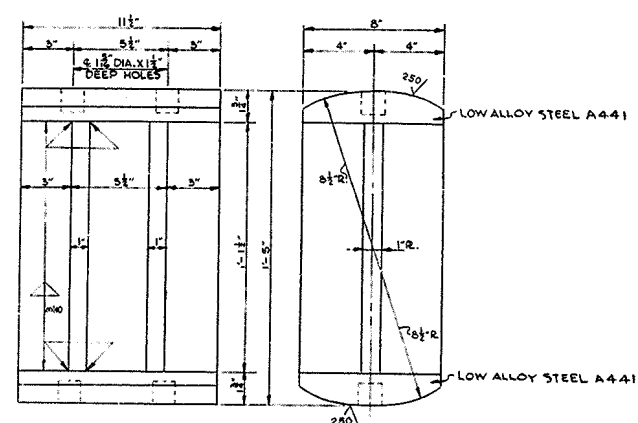


ROCKER

MAKE: 10 MATERIAL: STRUCT. ST. A373 (EXCEPT AS NOTED)

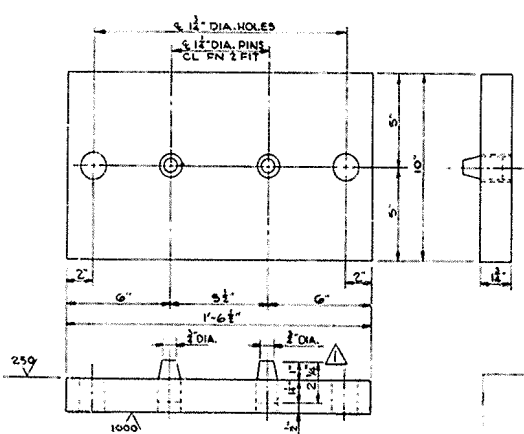


BOTTOM SHOE

MAKE: 10 MATERIAL: LOW ALLOY STEEL A441

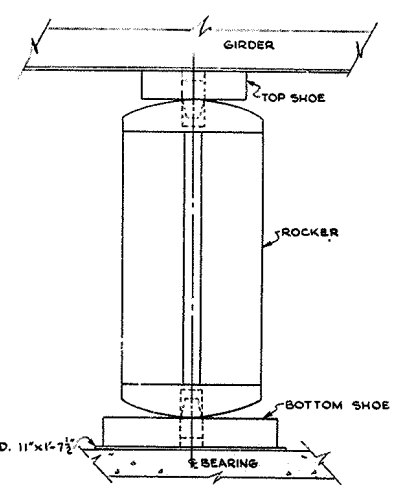


PIER NO. 2

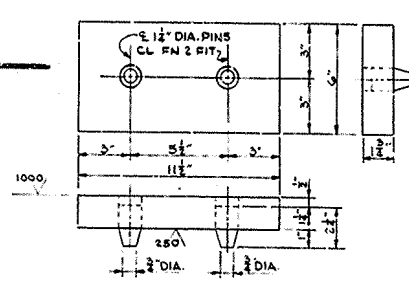


TOP SHOE

MAKE: 10 MATERIAL: STRUCT. STEEL A373

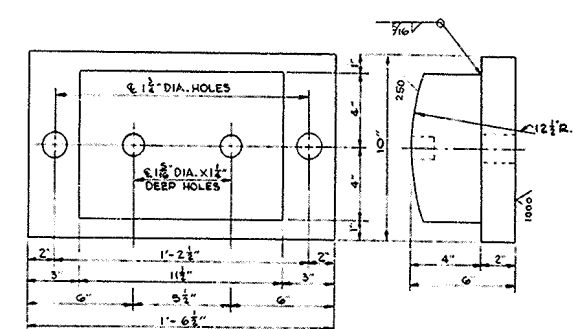

BOTTOM SHOE

MAKE: 10 MATERIAL: STRUCT. STEEL A373

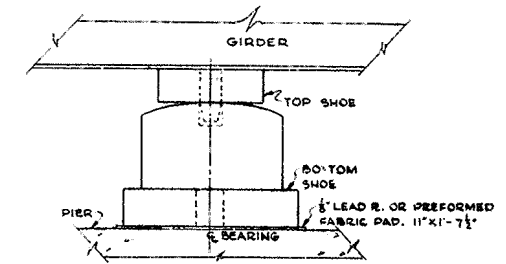












PIER NO. 1

FIXED BEARING ASSEMBLY

NOTES

1. THE TOP SHOES SHALL BE WELDED TO THE GIRDERS WITH CONTINUOUS FILLET WELDS OF MINIMUM SIZES PERMITTED BY A.W.S. SPECIFICATION FOR THE THICKER METAL CONNECTED.
2. AFTER BASE PLATES ARE PROPERLY SET ON POSITION DOWELS OR ANCHOR BOLTS, MOLTEN LEAD SHALL BE Poured IN THE HOLES AND CAULKED UNTIL THE HOLES ARE FILLED FLUSH TO TOP OF PLATE.


ALLEN Co. Drawing No. 17553		SHEET 10	
REVISION	DATE	DESCRIPTION	BY
1	13 JULY '52	DIMENSION CHANGED, NOTES ADDED. (AMDT. # 112 DTD. 14 6 18 JUNE '50)	G.C.B.
U.S. ARMY ENGINEER DISTRICT, LOUISVILLE CORPS OF ENGINEERS LOUISVILLE, KENTUCKY			
DESIGNED BY:	OHIO RIVER BASIN		
DRAWN BY: R.W.S.	BARREN RIVER RESERVOIR		
TRACED BY: R.W.S.	SITE NO. 13 - RELOCATION COUNTY RD. NO. 224		
CHECKED BY: S.F.F.	GLOVER & TRACE CREEK BRIDGES		
SUBMITTED:	BEARING DEVICES		
APPROVED: R.H. Adams	APPROVED: James H. Lewis	DATE:	MAY 1952

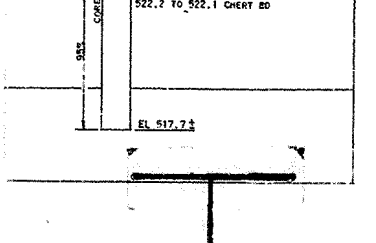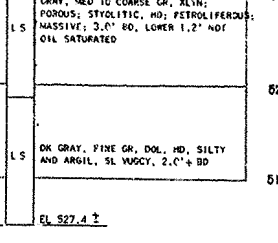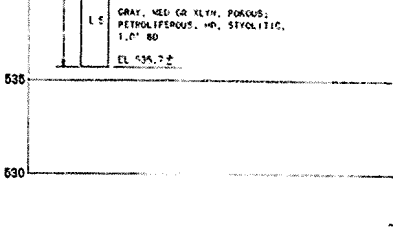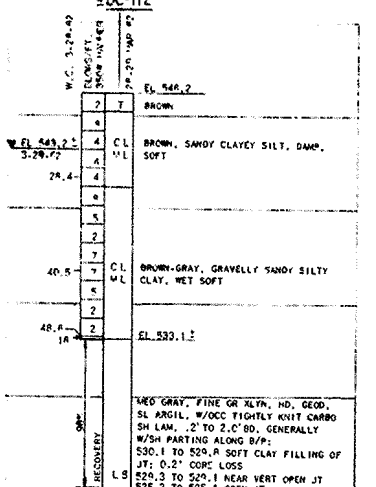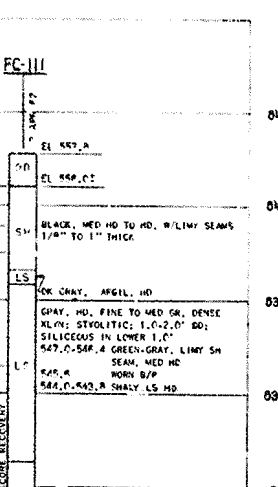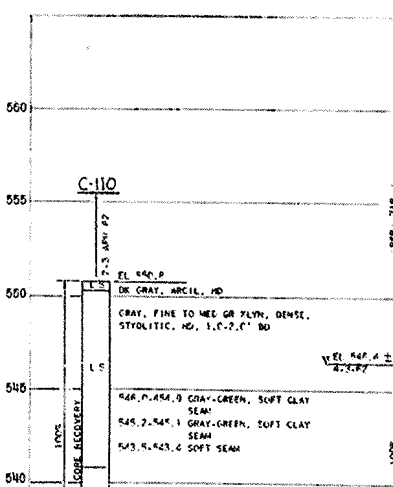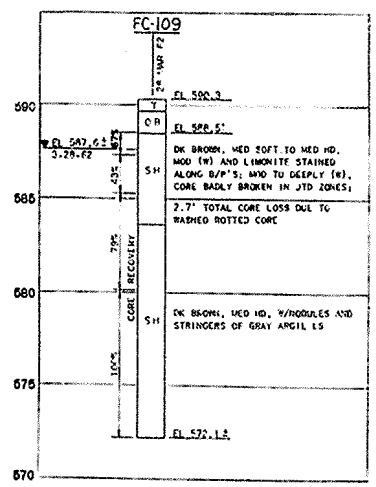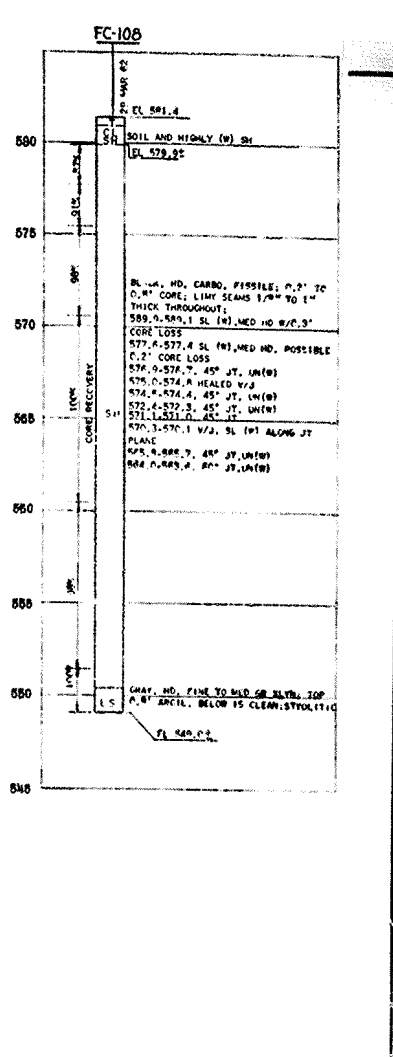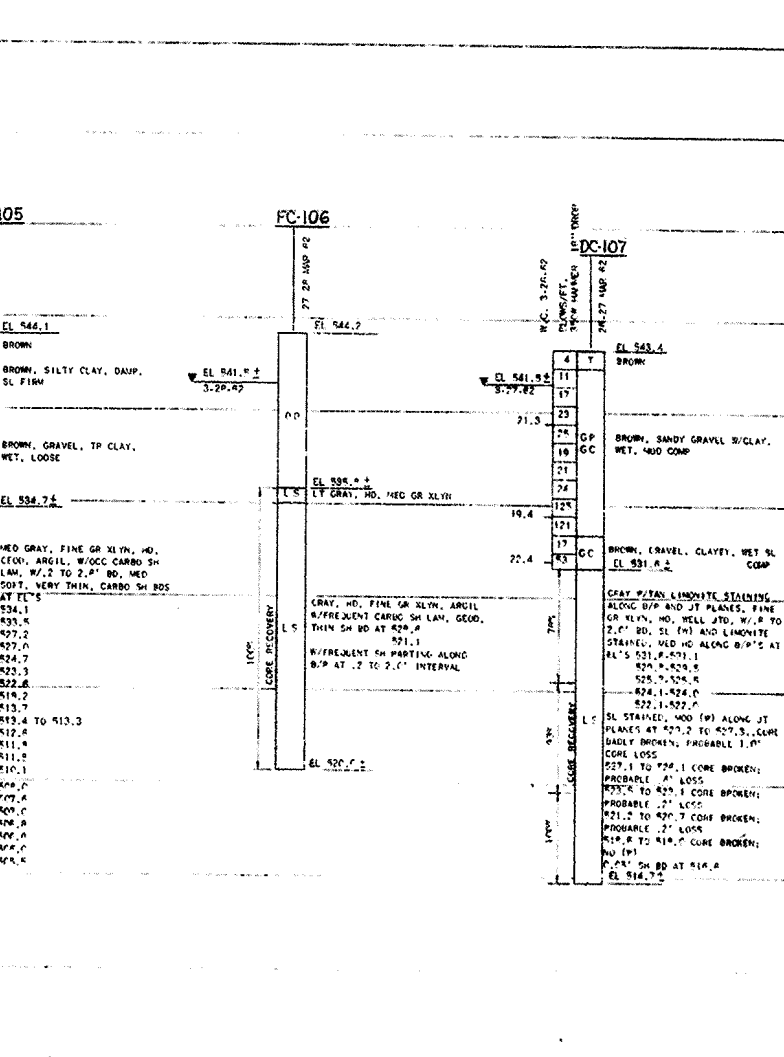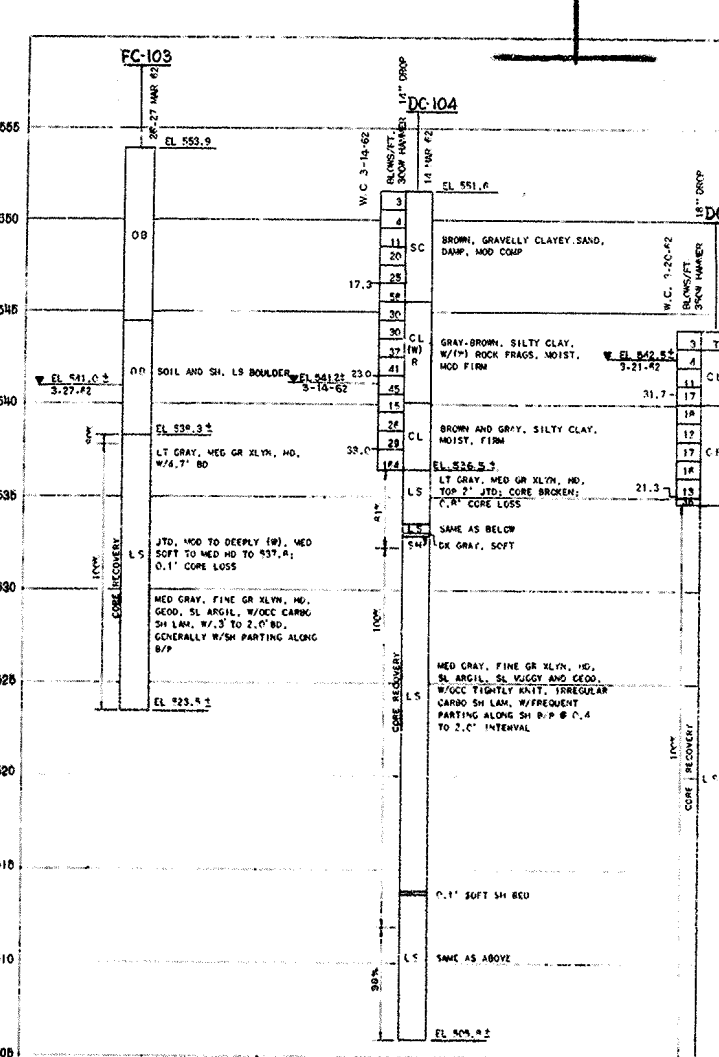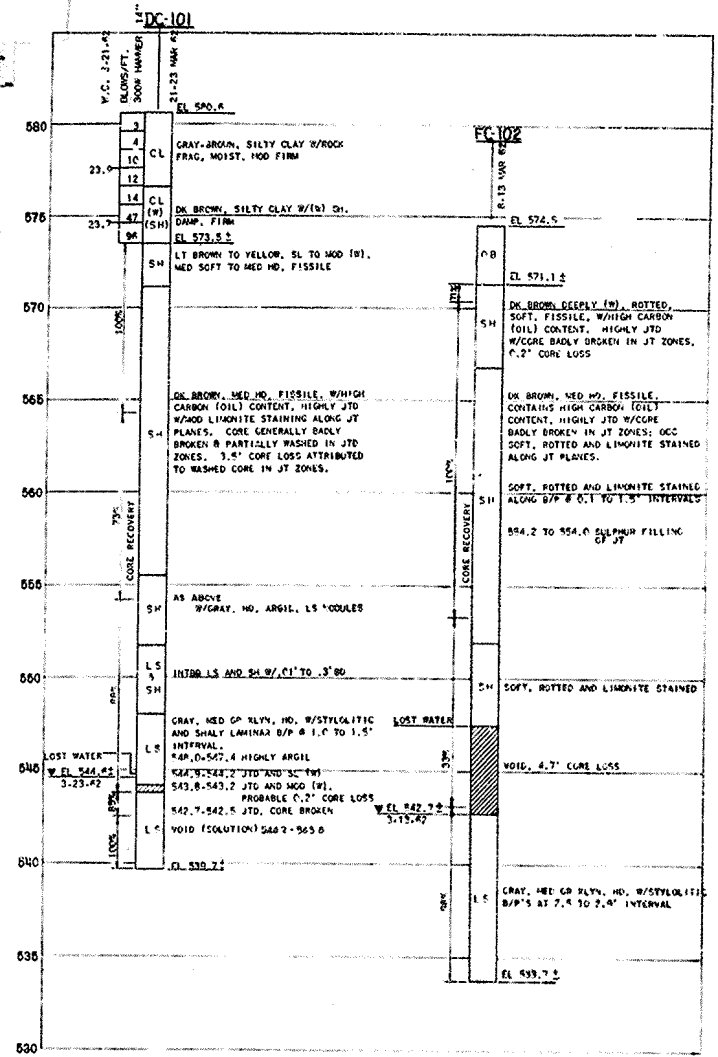

ALLEN Co Drawing No. 17553 SHEET 11

DESIGNED BY:	OHIO RIVER BASIN
DRAWN BY: C. T. B.	BARREN RIVER RESERVOIR
TRACED BY:	SITE NO. 13-RELOCATION COUNTY ROAD 224
CHECKED BY:	BORING LOGS
SUBMITTED:	SHEET 1
APPROVED:	DATE: MAY 1954

RECORD DRAWING-"AS BUILT"





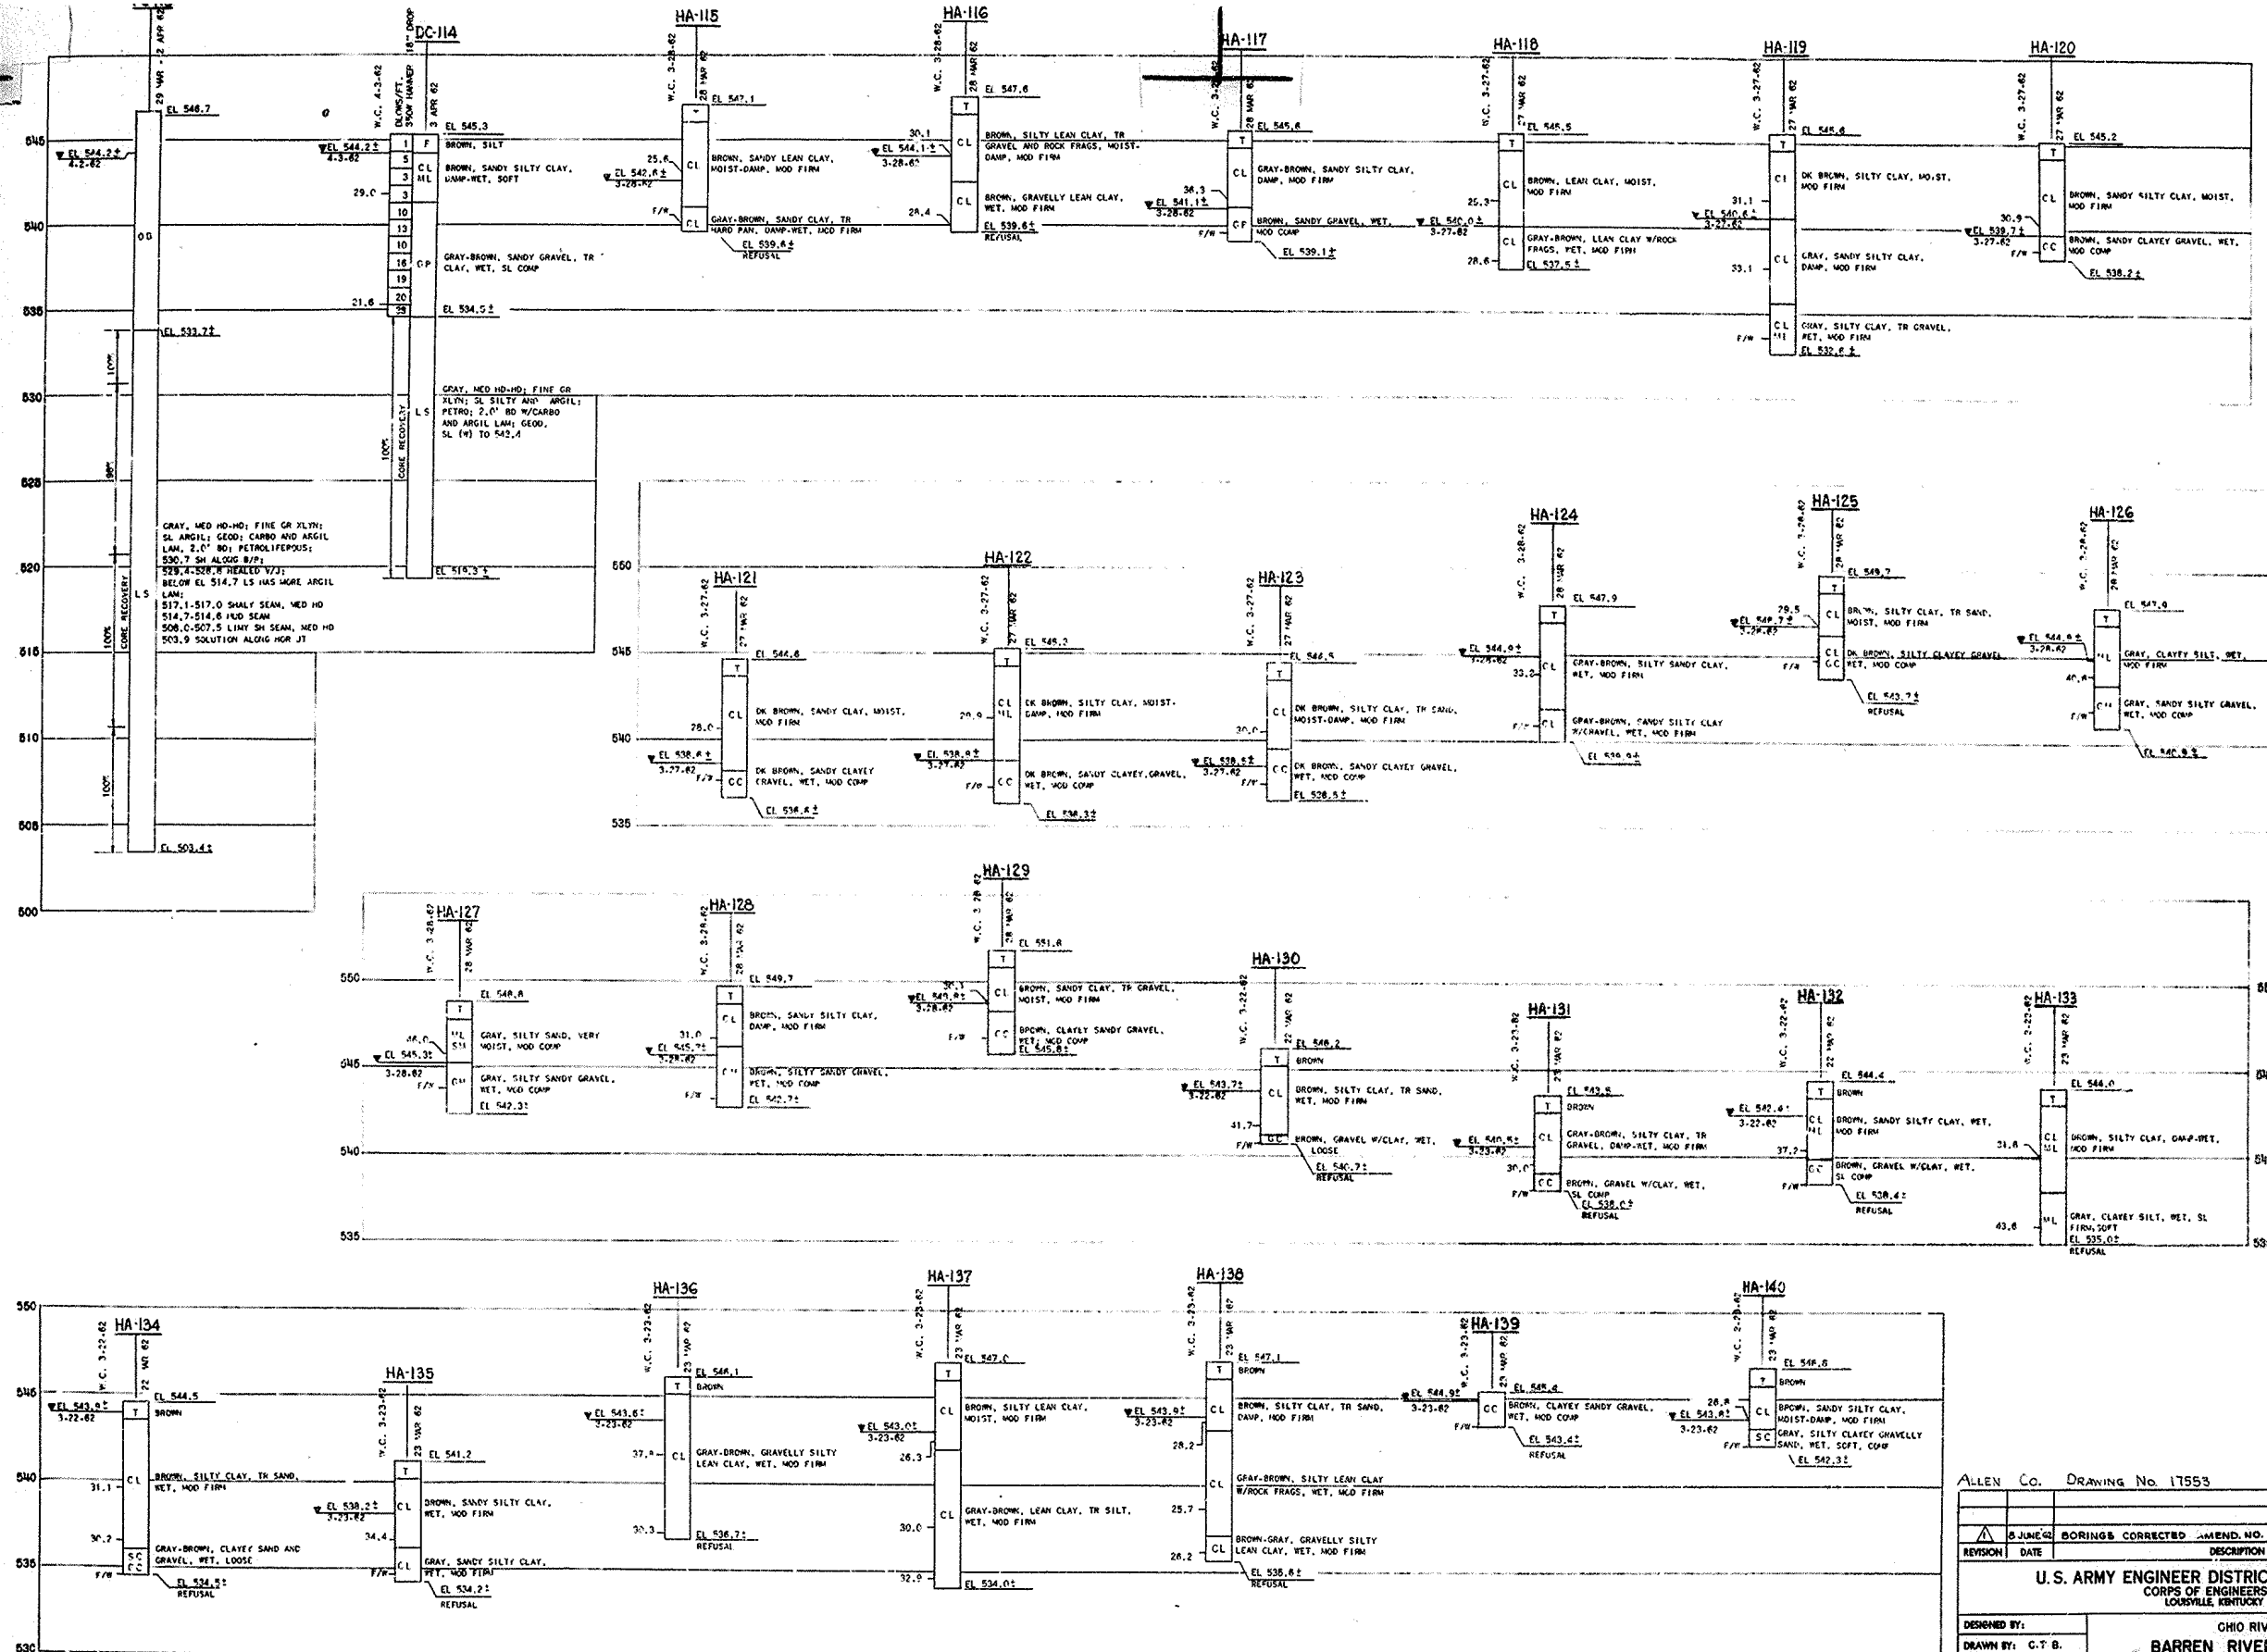


ALLEN Co. DRAWING No. 17553 SHEET 12


REVISION	DATE	DESCRIPTION	BY
Δ	8 JUN 62	BORINGS CORRECTED - MEND. NO. 1	E.L.M.

U.S. ARMY ENGINEER DISTRICT, LOUISVILLE
 CORPS OF ENGINEERS
 LOUISVILLE, KENTUCKY

DESIGNED BY: CHIO RIVER BASIN
 DRAWN BY: C.T.B. BARREN RIVER RESERVOIR
 TRACED BY: SITE NO.13-RELOCATION COUNTY RD. NO.224
 CHECKED BY: BORING LOGS
 SUBMITTED: SHEET 2
 APPROVED: *[Signature]* DATE: MAY 1962

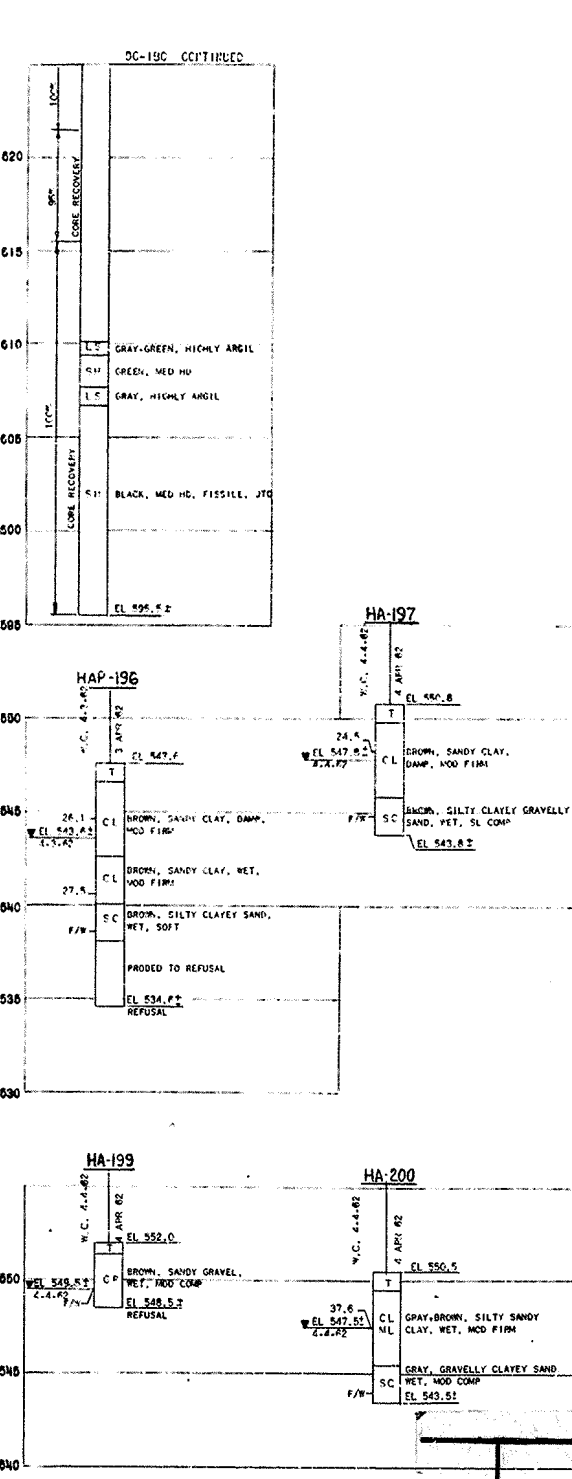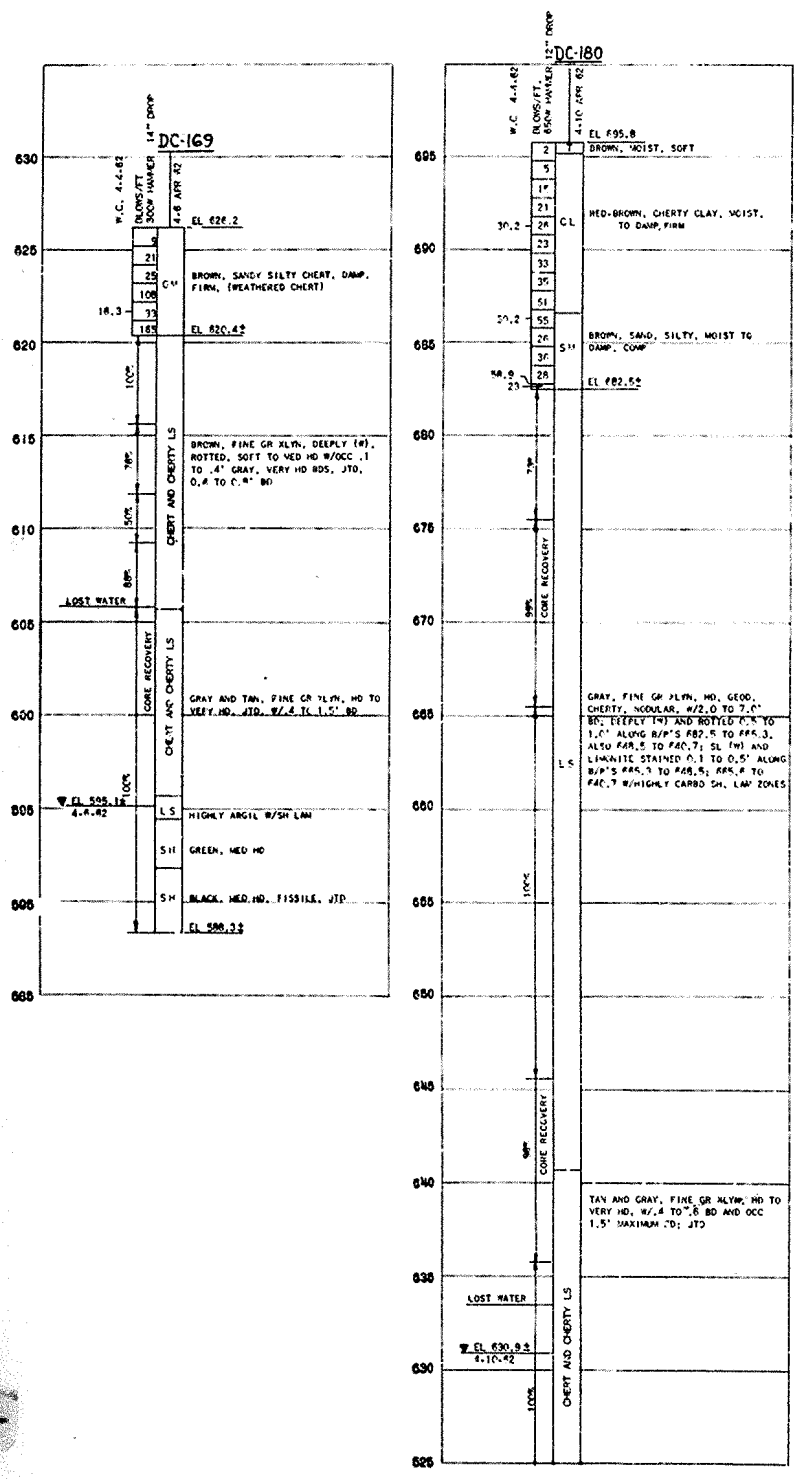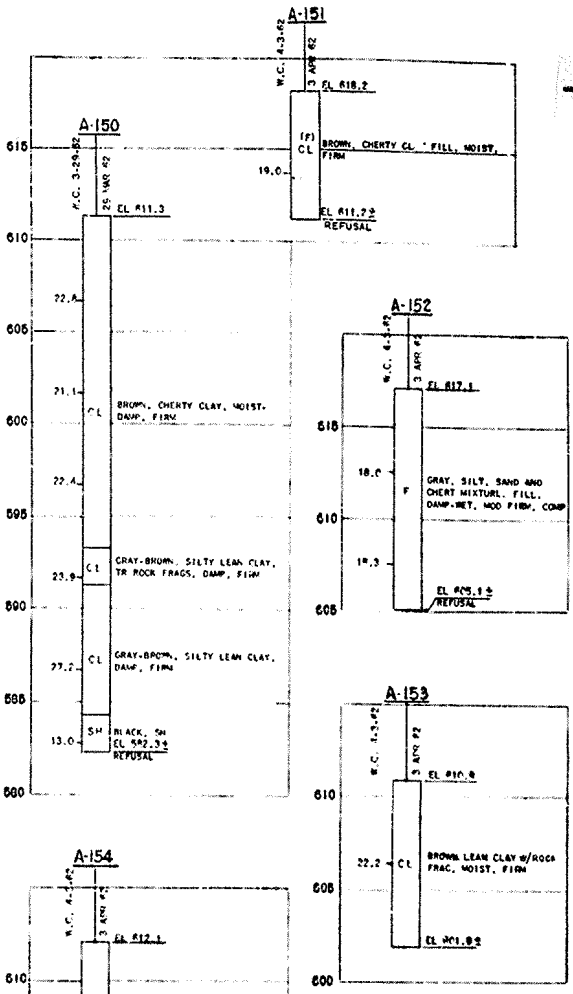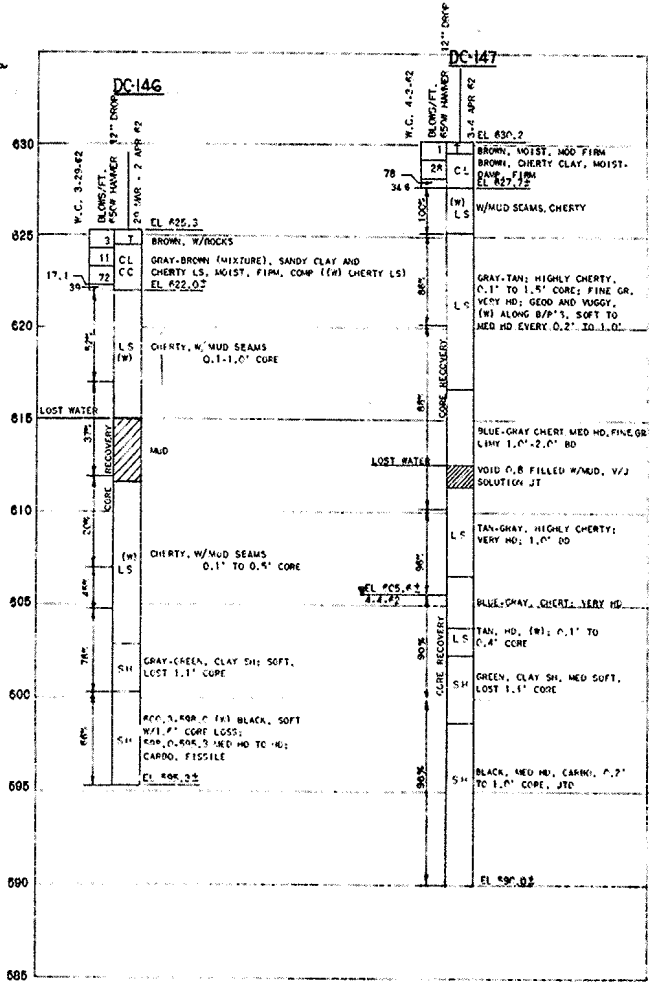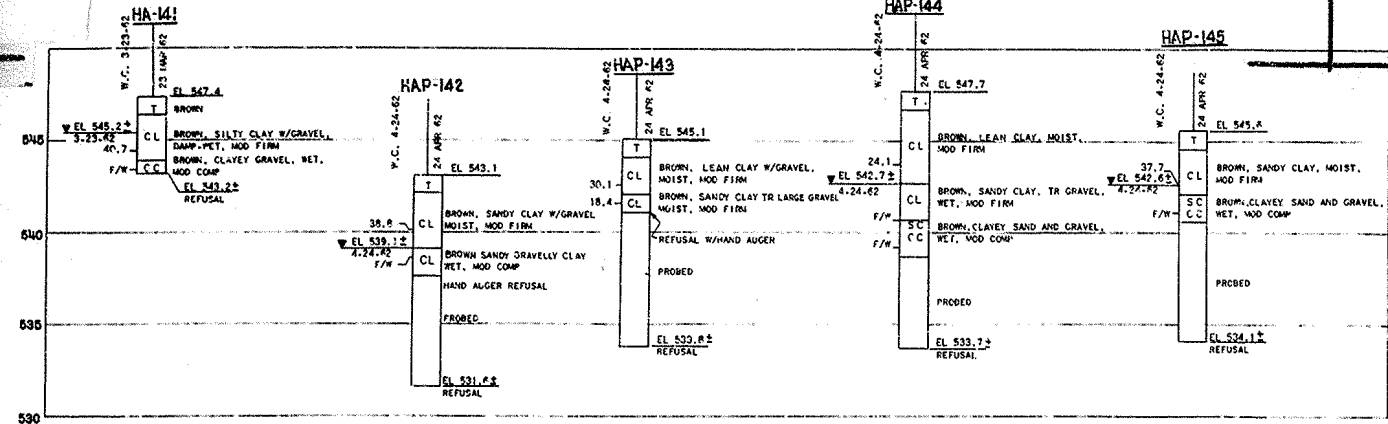

HOLE No	TOP ELEV.	BOTT ELEV.	DEPTH	REMARKS
P-155	618.8	611.3	7.5	
P-156	600.8	596.4	14.0	
P-157	600.6	595.1	5.5	REFUSAL
P-158	602.1	597.8	4.3	
P-159	587.0	582.0	5.0	
P-160	594.0	590.5	3.5	
P-161	592.2	589.2	3.0	
P-162	604.4	598.4	6.0	
P-163	603.0	596.5	6.5	
P-164	633.7	630.5	3.2	
P-165	610.5	606.5	4.0	
P-166	574.1	571.8	2.3	
P-167	611.3	608.8	2.5	
P-168	583.1	580.6	2.5	
P-169	600.6	594.6	6.0	
P-170	621.4	617.4	4.0	
P-171	602.9	599.4	3.5	
P-172	602.9	599.4	3.5	
P-173	605.1	598.6	6.5	
P-174	608.8	606.6	2.2	
P-175	594.4	587.4	7.0	
P-176	654.4	650.9	3.5	
P-177	603.0	599.8	3.2	
P-178	605.4	602.6	2.8	
P-179	622.4	620.2	2.2	
P-180	608.4	604.1	4.3	
P-181	607.0	603.7	3.3	
P-182	607.0	603.7	3.3	
P-183	607.0	603.7	3.3	
P-184	609.4	607.9	1.5	
P-185	597.6	591.1	6.5	
P-186	616.1	614.0	2.1	
P-187	600.4	592.4	8.0	REFUSAL
P-188	611.4	611.4	0.0	ROCK OUTCROP
P-189	595.8	591.6	4.2	REFUSAL

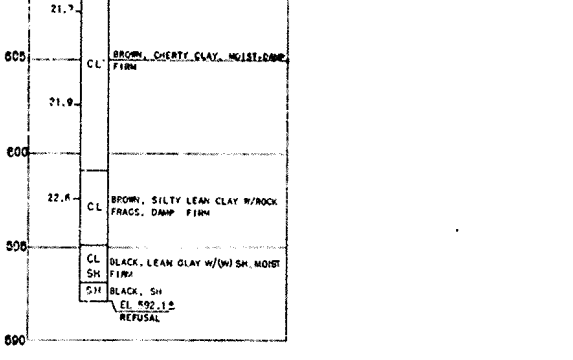

ALLEN CO. DRAWING No. 17553 SHEET 13

DESIGNED BY:	OHIO RIVER BASIN
DRAWN BY: C.L.B.	BARREN RIVER RESERVOIR
TRACED BY:	SITE NO.13-RELOCATION COUNTY RD. NO.224
CHECKED BY:	BORING LOGS
SUBMITTED BY:	SHEET 3
APPROVED BY:	DATE: MAY 1962