

COMMONWEALTH OF KENTUCKY
DEPARTMENT OF HIGHWAYS
PLAN AND PROFILE OF PROPOSED
STATE HIGHWAY

SUBSECTION OF CONTRACT RS312(9) SP15-334-6
15-334-6C1 GRADE DRAIN AND SURFACE FROM STA.13+00
TO STA.332+44.52.

CHECKED & VERIFIED
R.W. DIVISION
Tom V. Mann DATE 9-18-75
DIRECTOR R.W. DIVISION

AS BUILT PLANS

DIRECTOR - Division of Construction
Date: 10/7/74

THE CONTROL OF ACCESS ON THIS PROJECT
SHALL BE BY PERMIT FROM STA.21+00.00 LT.
& 21+00.00 RT. TO STA.332+44.52

THIS PROJECT IS A FULLY CONTROLLED
ACCESS HIGHWAY FROM KY. TURNPIKE (I-65) TO
STA.21+00.00 LT. AND RT.

THESE PLANS ARE FOR GRADE, DRAIN & SURFACING

PREPARED AND SUBMITTED
DATE October 10, 1969

BY: WRIGHT, MORGAN, BROWN & MCKNIGHT, INC.
SECTION ENGINEER

BY: Clyde E. Brown
KY. REGISTRATION NO. 3309



KENTUCKY
DEPARTMENT OF HIGHWAYS
COUNTY OF
BULLITT

BARDSTOWN — SHEPHERDSVILLE (KY. 245)
ROAD

STATE PROJECT No. SP 15-334-6 RS 312 (9) DATE 1971

DESIGNED BY: 19 BY M.B. Transman 5/12/71
DESIGN ENGINEER

APPROVED 5/26/71 BY B.R. Honer 5/26/71
DIRECTOR OF TRAFFIC

PLAN CHECKED 19 BY () CHIEF DRAFTSMAN

SURVEY AND PLAN APPROVED 6-18-71 BY E.D. Smith 6-18-71
DIRECTOR OF DESIGN

SURVEY AND PLAN APPROVED 6-18-71 BY J.L. Harrison 6-18-71
STATE HIGHWAY ENGINEER

U.S. DEPARTMENT OF TRANSPORTATION
FEDERAL HIGHWAY ADMINISTRATION

APPROVED:

DIVISION ENGINEER

DATE

INDEX OF SHEETS

SHEET NO.	DESCRIPTION
1	LAYOUT SHEET
2 - 29	TYPICAL SECTIONS—SUMMARY OF QUANTITIES---
29-31	GENERAL NOTES
3 - 16	PLAN AND PROFILE SHEETS
17-34e	DETAIL SHEETS
35-36	REFERENCE SHEETS
37-38	RIGHT OF WAY SUMMARY SHEETS
39-44	RIGHT OF WAY STRIP MAPS
45-50	SOIL PROFILE SHEETS
51-78	PIPE SHEETS
79-293	CROSS SECTION SHEETS

* REED BOOK & PAGE # ON RW SUMMARY SHEETS

Sheets Not Included in sheet Totals
2a, 2b, 2c, 2d, 2e, 2f, 2g, 2h, 2i, 3a, 3ab, 3ac, 3ad, & 3ae

LIST OF STANDARD DRAWINGS

- | | |
|---|---|
| 10.01a Curve Widening and Superlevation. | 14.11a 4' Roll Barrier Medians |
| 10.03h Miscellaneous Standards Part 1. | 15.08d Miscellaneous Drainage Structures - Part 3 |
| 10.04h Miscellaneous Standards Part 2. | 17.01d Right of Way Fence |
| 10.11 Typical Embankment Foundation Benches | 17.02a Right of Way Fencing Details |
| 10.12a Paved Ditch (Type 1) | 17.03L Steel Beam Guard Rail |
| 11.01c Drainage Pipe Standards (Circular Pipe) | 17.04k Typical Guard Rail Installations |
| 11.03e 30"-36"-42" Diameter Pipe Culverts @ 0° Skew. | 17.10c Guard Rail End Treatment and Terminal Sections |
| 11.04d 48"-54"-60" Diameter Pipe Culverts @ 0° Skew. | |
| 11.05e 30"-36"-42" Diameter Pipe Culverts @ 15° Skew. | |
| 11.06e 48"-54"-60" Diameter Pipe Culverts @ 15° Skew. | |
| 11.07c 30"-36"-42" Diameter Pipe Culverts @ 30° Skew. | |
| 11.09f 30"-36"-42" Diameter Pipe Culverts @ 45° Skew. | |
| 11.10c U-Type Headwalls | |
| 11.22c Pipe Bedding Details | |
| 11.23c Circular Pipe and Non-Circular Pipe Charts | |
| 11.26b 60" Diameter Pipe Culvert @ 15° Skew. | |
| 11.43c Pipe Bedding and Projection Limit Details. | |
| 11.44a Pipe Bedding and Projection Limit Details. | |
| 11.45b 15'-18'-24' Ditch Box Inlet Type 1. | |
| 11.51a Perforated Pipe Standards | |
| 11.52d Subgrade Drainage Details | |
| 11.53c Perforated Pipe Underdrain | |
| 11.54b Perforated Pipe Details | |
| 11.55b Perforated Pipe Headwalls | |

TOTAL STD. DRAWINGS 39
TOTAL BRIDGE SHEETS 27

14.08a Island Curb Construction Details.

DESIGN CRITERIA


CLASS OF HIGHWAY	2
TYPE OF TERRAIN	ROLLING
DESIGN SPEED	60 MPH
REQUIRED PSD	475
REQUIRED PSD	2100
LEVEL OF SERVICE	C
ADT (1988)	1900
ADT (1988)	4600
DVH (1988)	600
D %	50
T %	5

DESIGNED

% UNRESTRICTED 1500 SD 52 %
LEVEL OF SERVICE C
MAX. DISTANCE W/O PASSING 2.5 mi.


CONVENTIONAL SIGNS

UNIMPROVED ROAD
GRADE AND DRAINED ROAD
SOIL SURFACE ROAD
METAL SURFACED ROAD
LOW TYPE BITUMINOUS ROAD
PAVED ROAD
COUNTY LINE
CORPORATE LIMITS
SURVEY LINE
PROPOSED RIGHT OF WAY
GRADE LINE
TRAVELLED WAY
RAILROAD
FENCES (EXCEPT STONE & HEDGE)
STONE FENCE
HEDGE FENCE
TREES & STUMPS
PIPE LINE
TELEPHONE POLES
PIPE CULVERT
CONCRETE CULVERT & BRIDGE
LARGE STREAM
SMALL STREAM
BENCH MARKS
ROAD INTERSECTIONS
MARSH
BUILDINGS

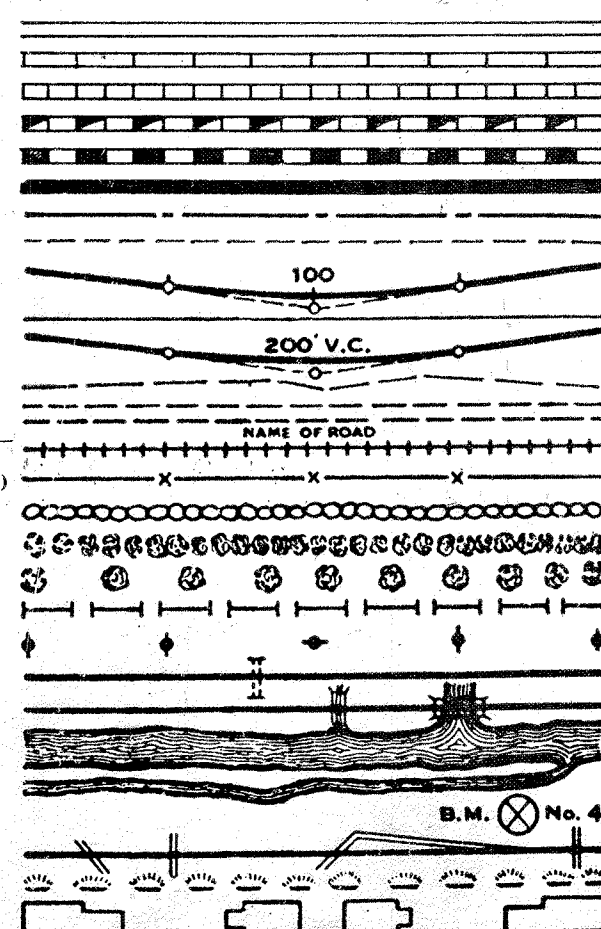

DESIGNED

PSD HORIZONTAL 61 %
PSD VERTICAL 75 %
PSD COMBINED (TOTAL) 24 %

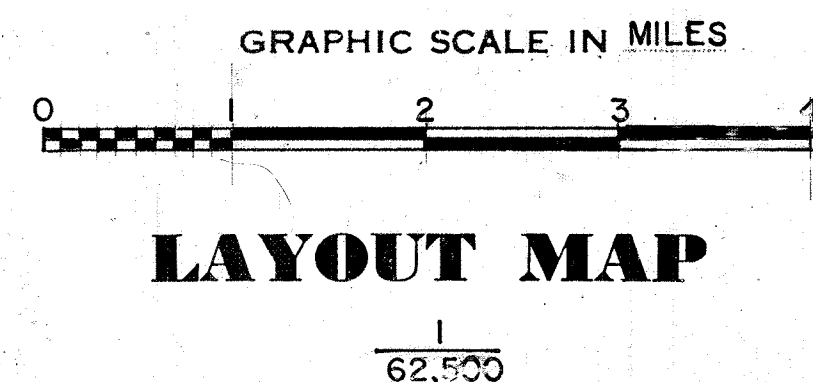

GROSS LENGTH 32014.84 LIN. FT. 6.063 MILES	GROSS LENGTH LIN. FT. MILES	GROSS LENGTH LIN. FT. MILES	GROSS LENGTH LIN. FT. MILES
ADDED FOR EQUALITIES 70.32 LIN. FT. 6.063 MILES	ADDED DEDUCTED FOR EQUALITIES LIN. FT. MILES	ADDED DEDUCTED FOR EQUALITIES LIN. FT. MILES	ADDED DEDUCTED FOR EQUALITIES LIN. FT. MILES
NET LENGTH 32014.84 LIN. FT. 6.063 MILES	NET LENGTH LIN. FT. MILES	NET LENGTH LIN. FT. MILES	NET LENGTH LIN. FT. MILES
RAILROAD CROSSINGS NO. NOT INCLUDED LIN. FT. BRIDGES	RAILROAD CROSSINGS NO. NOT INCLUDED LIN. FT. BRIDGES	RAILROAD CROSSINGS NO. NOT INCLUDED LIN. FT. BRIDGES	RAILROAD CROSSINGS NO. NOT INCLUDED LIN. FT. BRIDGES

LETTING DATE 11-19-71

COMMONWEALTH OF KENTUCKY
DEPARTMENT OF HIGHWAYS
PLAN AND PROFILE OF PROPOSED
STATE HIGHWAY

SUBSECTION OF CONTRACT RS312(9) SP15-334-6
15-334-6C1 GRADE DRAIN AND SURFACE FROM STA.13+00
TO STA.332+44.52.

1A

SHEET NO.	DESCRIPTION
1	LAYOUT SHEET
2 - 29	TYPICAL SECTIONS—SUMMARY OF QUANTITIES—
2h-2i	GENERAL NOTES
3-16	PLAN AND PROFILE SHEETS
17-34e	DETAIL SHEETS
35-36	REFERENCE SHEETS
37-38	RIGHT OF WAY SUMMARY SHEETS
39-44	RIGHT OF WAY STRIP MAPS
45-50	SOIL PROFILE SHEETS
51-78	PIPE SHEETS
79-293	CROSS SECTION SHEETS

Sheets Not Included in sheet Totals
2a, 2b, 2c, 2d, 2e, 2f, 2g, 2h, 2i, 34a, 34b, 34c, 34d, & 34e

LIST OF STANDARD DRAWINGS

- | | |
|--|---|
| 10.01a Curve Widening and Superelevation | 14.11a 4 Roll Barrier Medians |
| 10.03h Miscellaneous Standards Part 1 | 15.08d Miscellaneous Drainage Structures-Part 3 |
| 10.04h Miscellaneous Standards Part 2 | 17.01d Right-of-Way Fence |
| 10.11 Typical Embankment Foundation Benches | 17.02a Right of Way Fencing Details |
| 10.12a Paved Ditch (Type 1) | 17.03L Steel Beam Guard Rail |
| 11.01c Drainage Pipe Standards (Circular Pipe) | 17.04k Typical Guard Rail Installations |
| 11.03e 30"-36"-42" Diameter Pipe Culverts @ 0° Skew | 17.16c Guard Rail End Treatment and Terminal Sections |
| 11.04d 48"-54"-60" Diameter Pipe Culverts @ 0° Skew | |
| 11.05e 30"-36"-42" Diameter Pipe Culverts @ 15° Skew | |
| 11.06e 48"-54"-60" Diameter Pipe Culverts @ 15° Skew | |
| 11.07c 30"-36"-42" Diameter Pipe Culverts @ 30° Skew | |
| 11.08f 30"-36"-42" Diameter Pipe Culverts @ 45° Skew | |
| 11.10c U-Type Headwalls | |
| 11.22c Pipe Bedding Details | |
| 11.23c Circular Pipe and Non-Circular Pipe Charts | |
| 11.26b 66" Diameter Pipe Culvert @ 15° Skew | |
| 11.43c Pipe Bedding and Projection Limit Details | |
| 11.44a Pipe Bedding and Projection Limit Details | |
| 11.45b 15"-18"-24" Ditch Box Inlet Type 1 | |
| 11.51a Perforated Pipe Standards | |
| 11.52d Subgrade Drainage Details | |
| 11.53c Perforated Pipe Underdrain | |
| 11.54b Perforated Pipe Details | |
| 11.55b Perforated Pipe Headwalls | |
- 16.01n Cement Concrete Pavement
16.02h Contraction Joint Load Transfer Assembly
16.04d Station Markings Cement Concrete Pavement
16.05e Cement Concrete Pavement Joint Details
16.08b Cement Concrete Pavement Joint Types & Spacing
18.21b Misting
18.23a Netting
18.06b Expansion Joint Load Transfer Assembly

TOTAL STD. DRAWINGS 39
TOTAL BRIDGE SHEETS 27

14.08a Island Curb Construction Details.


DESIGN CRITERIA

CLASS OF HIGHWAY	2
TYPE OF TERRAIN	ROLLING
DESIGN SPEED	60 MPH
REQUIRED NPSD	475
REQUIRED PSD	2100
LEVEL OF SERVICE	C
ADT (1966)	219
ADT (1988)	4600
DVH (1988)	600
D	50
T	5

DESIGNED

% UNRESTRICTED 1500 SD	52 %
LEVEL OF SERVICE	C
MAX. DISTANCE W/O PASSING	2.5 mi.

CONVENTIONAL SIGNS

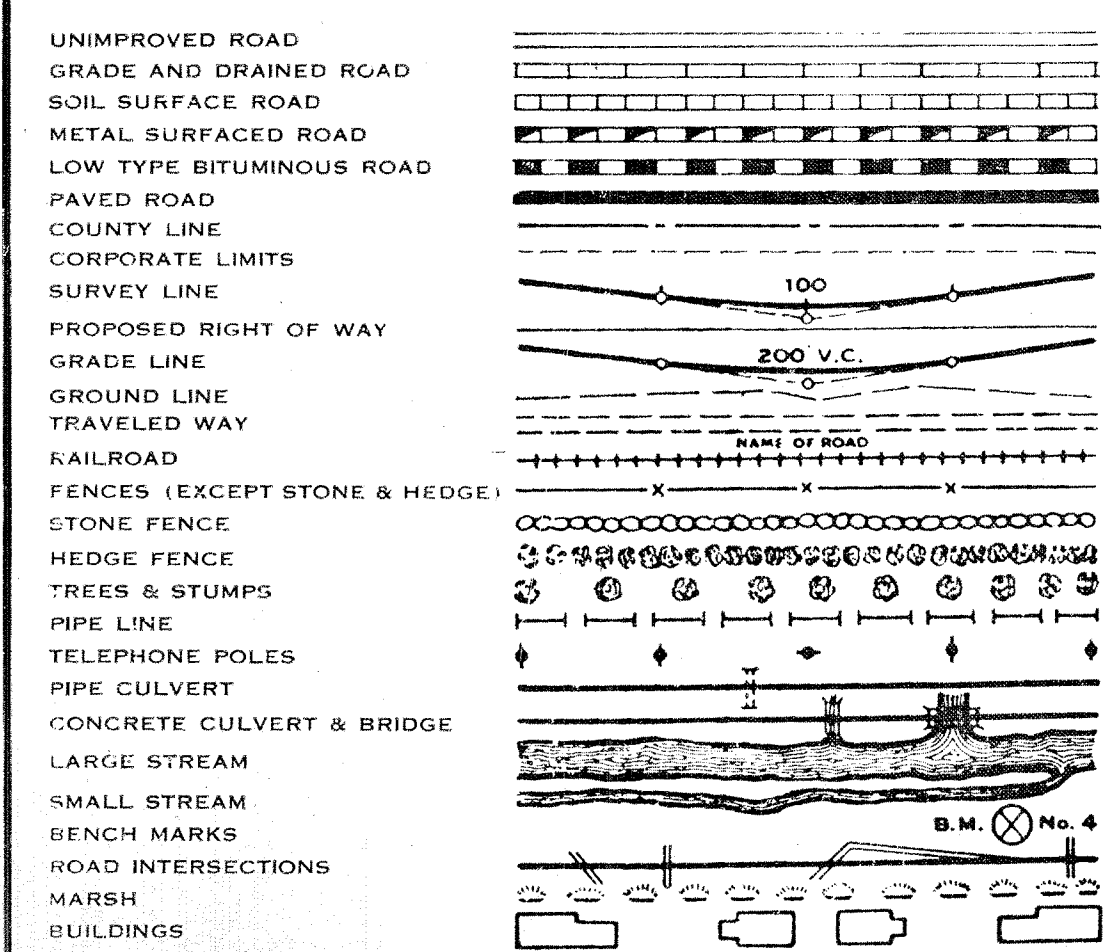


DESIGNED

PSD HORIZONTAL	61%
PSD VERTICAL	75%
PSD COMBINED (TOTAL)	24%

GRAPHIC SCALE IN MILES

LAYOUT MAP

SECTION 1	SECTION 2	TOTAL
GROSS LENGTH 9700.00 LIN. FT. 1.837 MILES	GROSS LENGTH 19014.84 LIN. FT. 3.601 MILES	GROSS LENGTH 28714.84 LIN. FT. 5.438 MILES
NET LENGTH 9700.00 LIN. FT. 1.837 MILES	NET LENGTH 19014.84 LIN. FT. 3.601 MILES	NET LENGTH 28714.84 LIN. FT. 5.438 MILES
RAILROAD CROSSINGS No. 1	RAILROAD CROSSINGS No. 1	RAILROAD CROSSINGS No. 1
BRIDGES No. 1	BRIDGES No. 1	BRIDGES No. 1

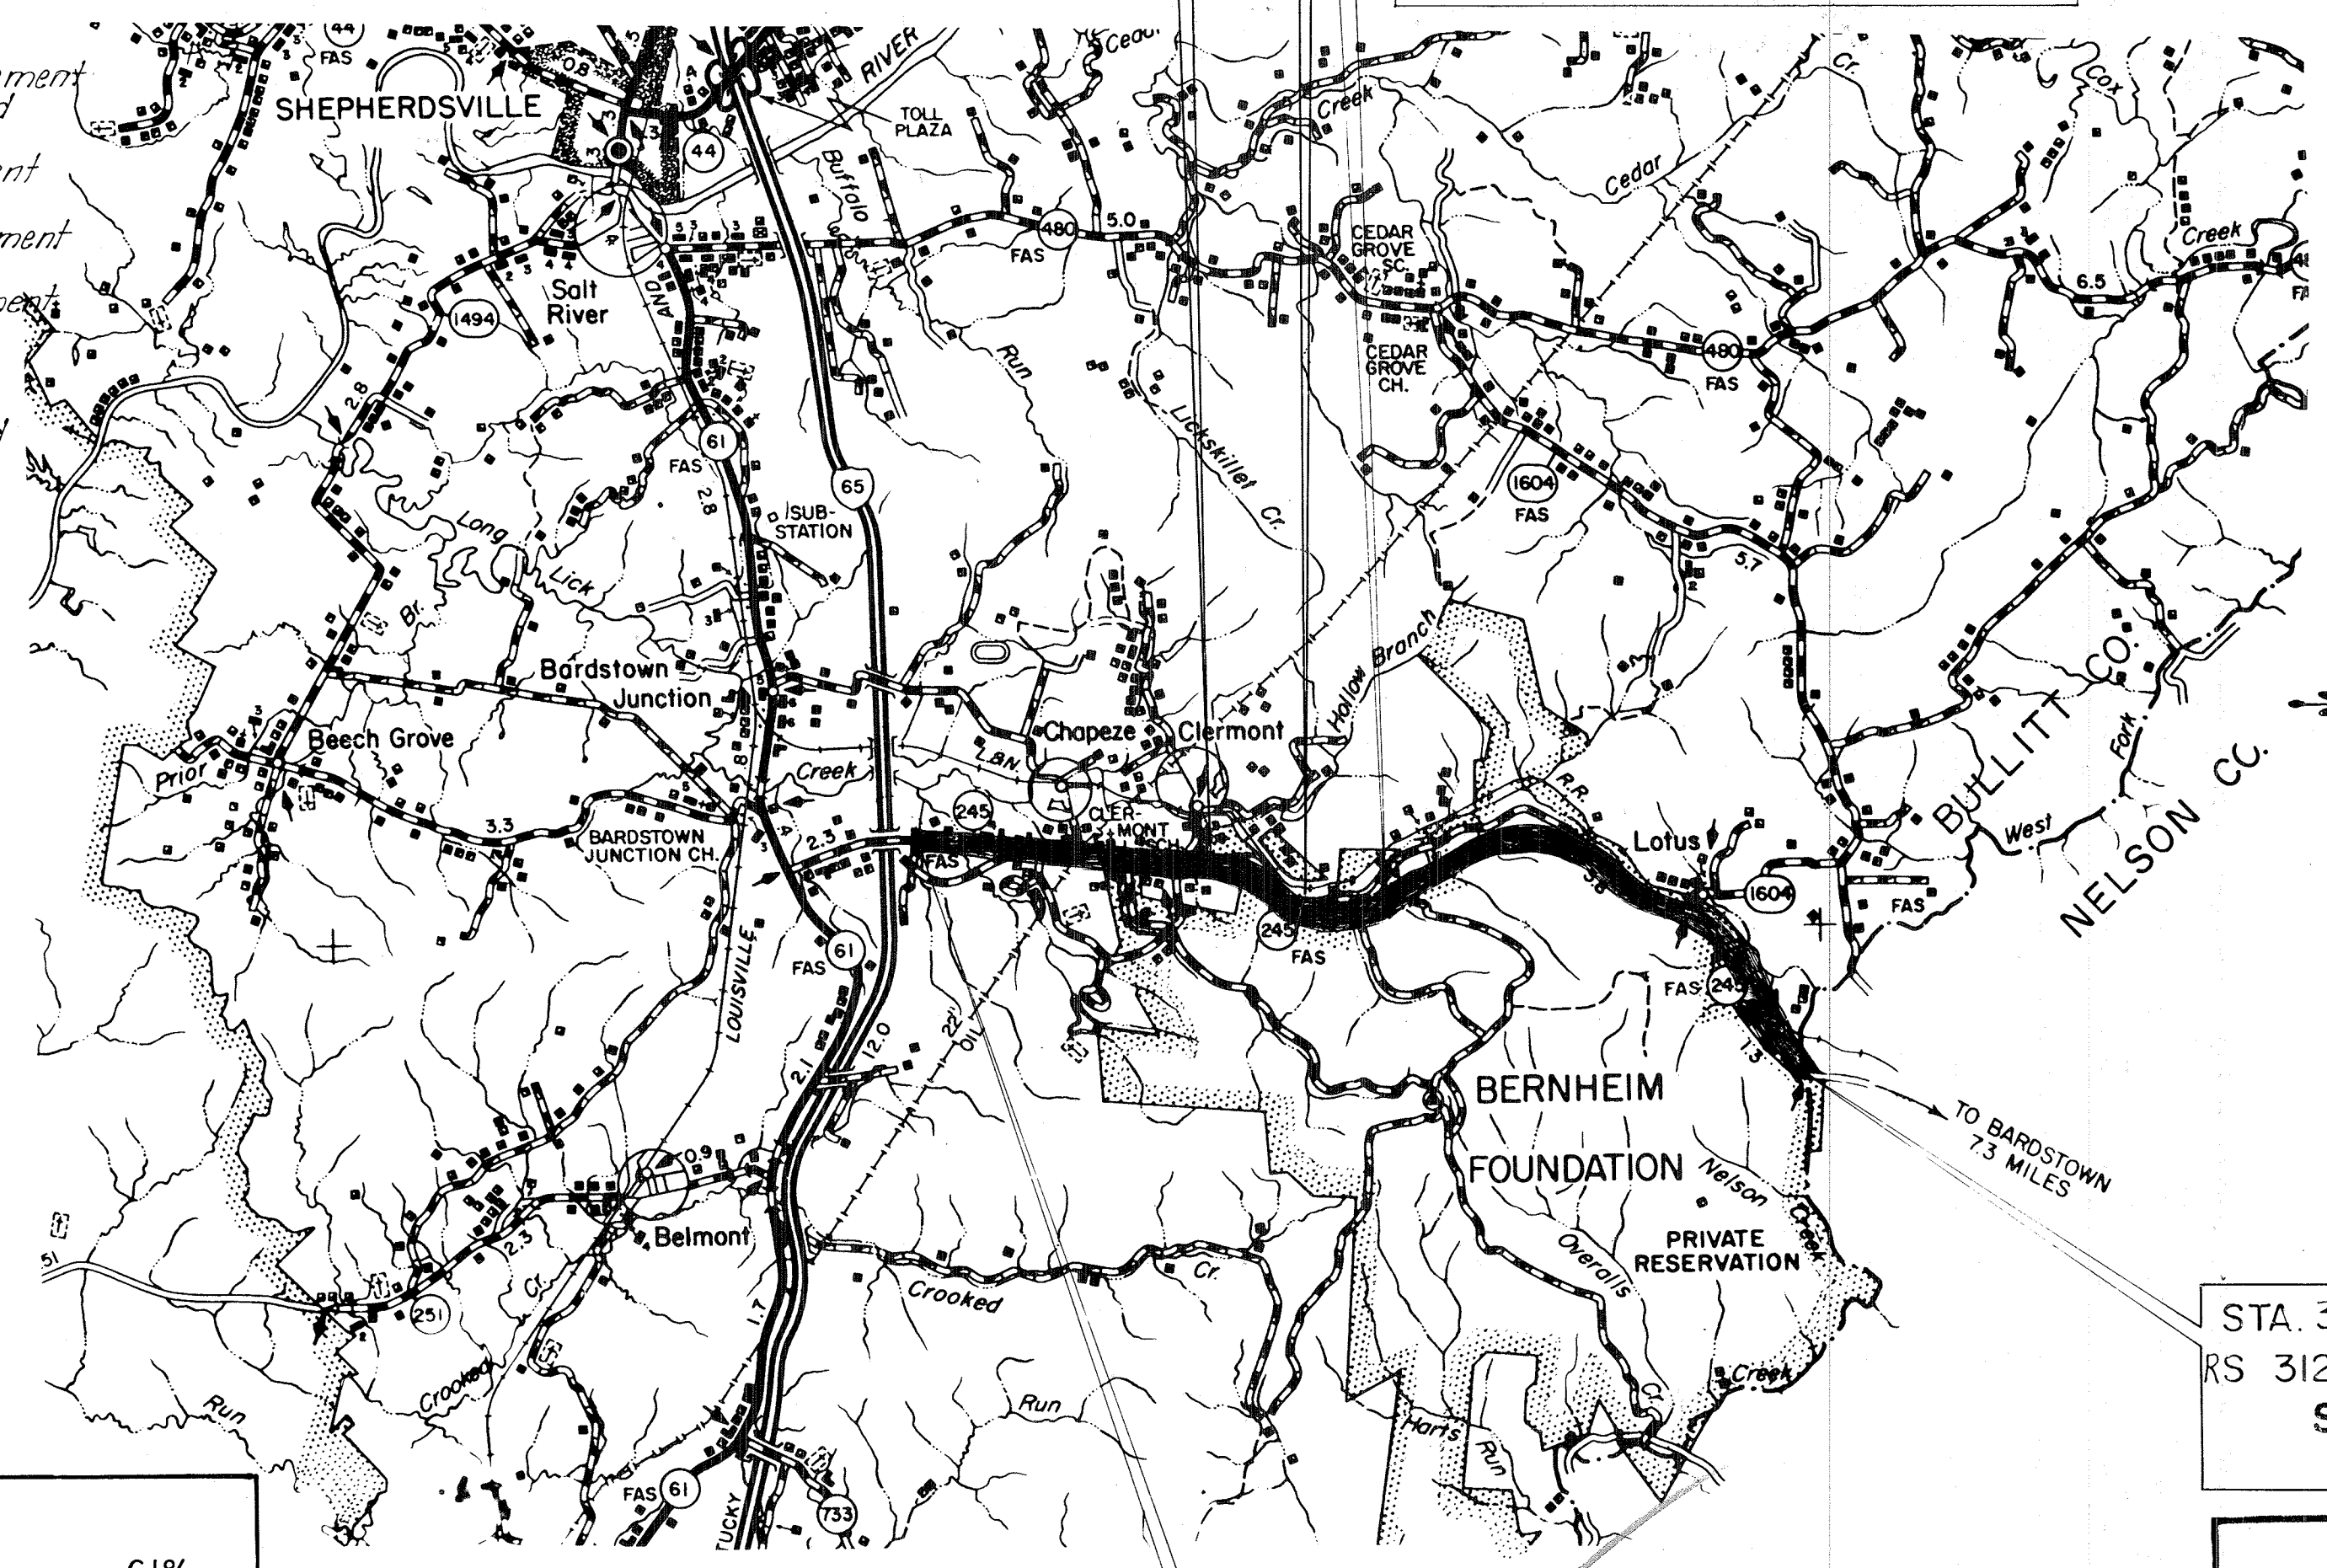

CHECKED & VERIFIED
R/W DIVISION

THE CONTROL OF ACCESS ON THIS PROJECT
SHALL BE BY PERMIT FROM STA.21+00.00 LT.
& 21+00.00 RT. TO STA.332+44.52


THIS PROJECT IS A FULLY CONTROLLED
ACCESS HIGHWAY FROM KY TURNPIKE (I-65) TO
STA.21+00.00 LT. AND RT.

AS BUILT PLANS

DIRECTOR - Division of Construction
Date: 10/2/69

THESE PLANS ARE FOR GRADE, DRAIN & SURFACING

PREPARED AND SUBMITTED
DATE October 10, 1969
BY: WRIGHT, MORGAN, BROWN & MCKNIGHT, INC.
SECTION ENGINEER
BY: Clyde E. Brown
KY. REGISTRATION NO. 3309

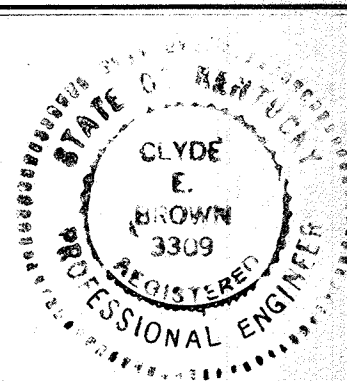

KENTUCKY
DEPARTMENT OF HIGHWAYS
COUNTY OF
BULLITT

BARDSTOWN — SHEPHERDSVILLE (KY. 245)
ROAD

STATE PROJECT No. SP 15-334-6 DATE RS 312 (9) 1971

DESIGNED BY: M.B. Farnsworth 5/12/71
APPROVED 5/12/71 BY B.R. Farnsworth
DIRECTOR OF TRAFFIC

PLAN CHECKED 19 BY CHIEF DRAFTSMAN
SURVEY AND PLAN APPROVED 6-18-71 BY E.O. Keith
DIRECTOR OF DESIGN
SURVEY AND PLAN APPROVED 18 BY STATE HIGHWAY ENGINEER


U.S. DEPARTMENT OF TRANSPORTATION
FEDERAL HIGHWAY ADMINISTRATION

APPROVED: DIVISION ENGINEER DATE


LETTING DATE 11/11

TYPICAL SECTIONS

MAIN LINE

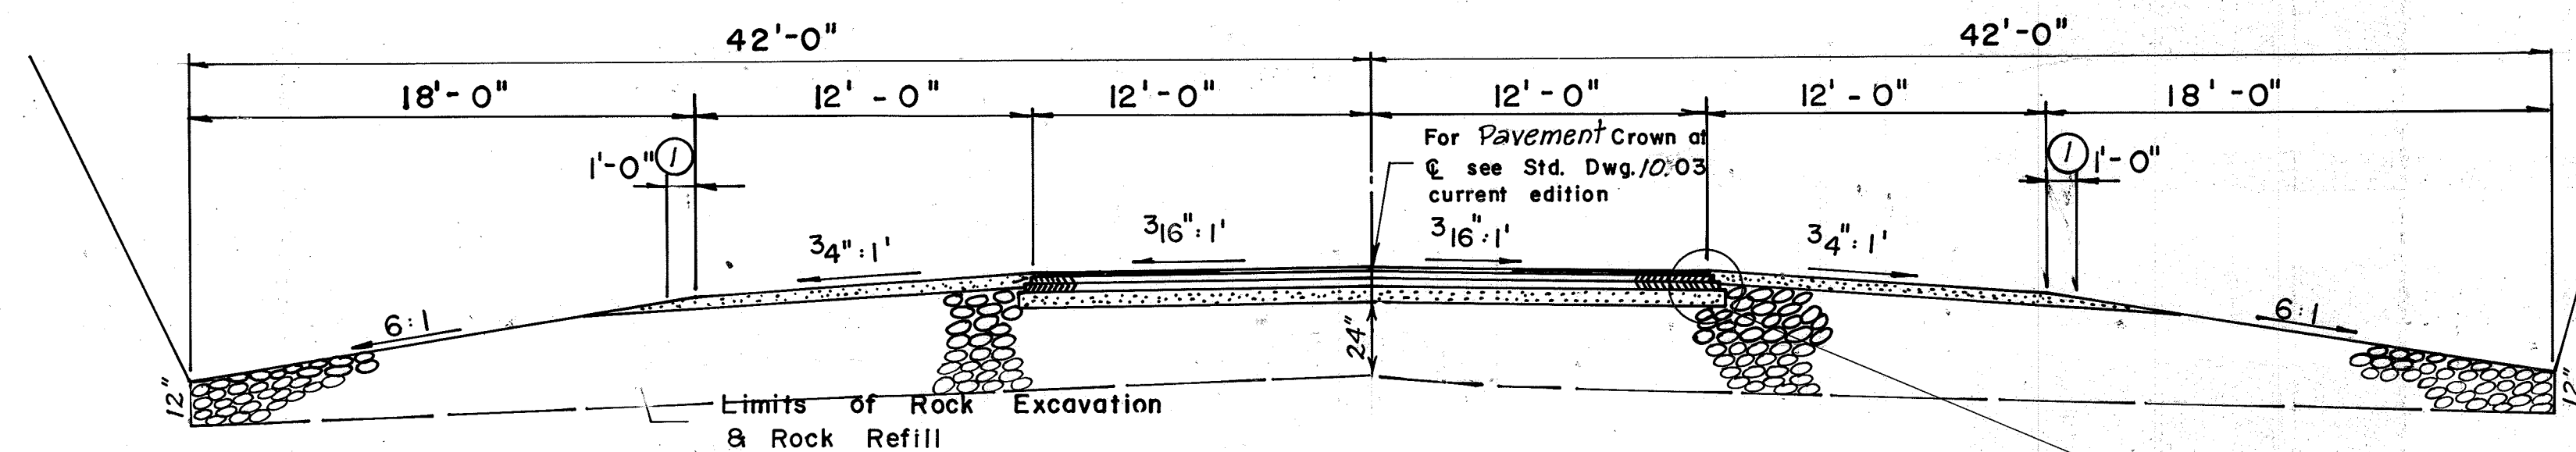

NORMAL - CUT

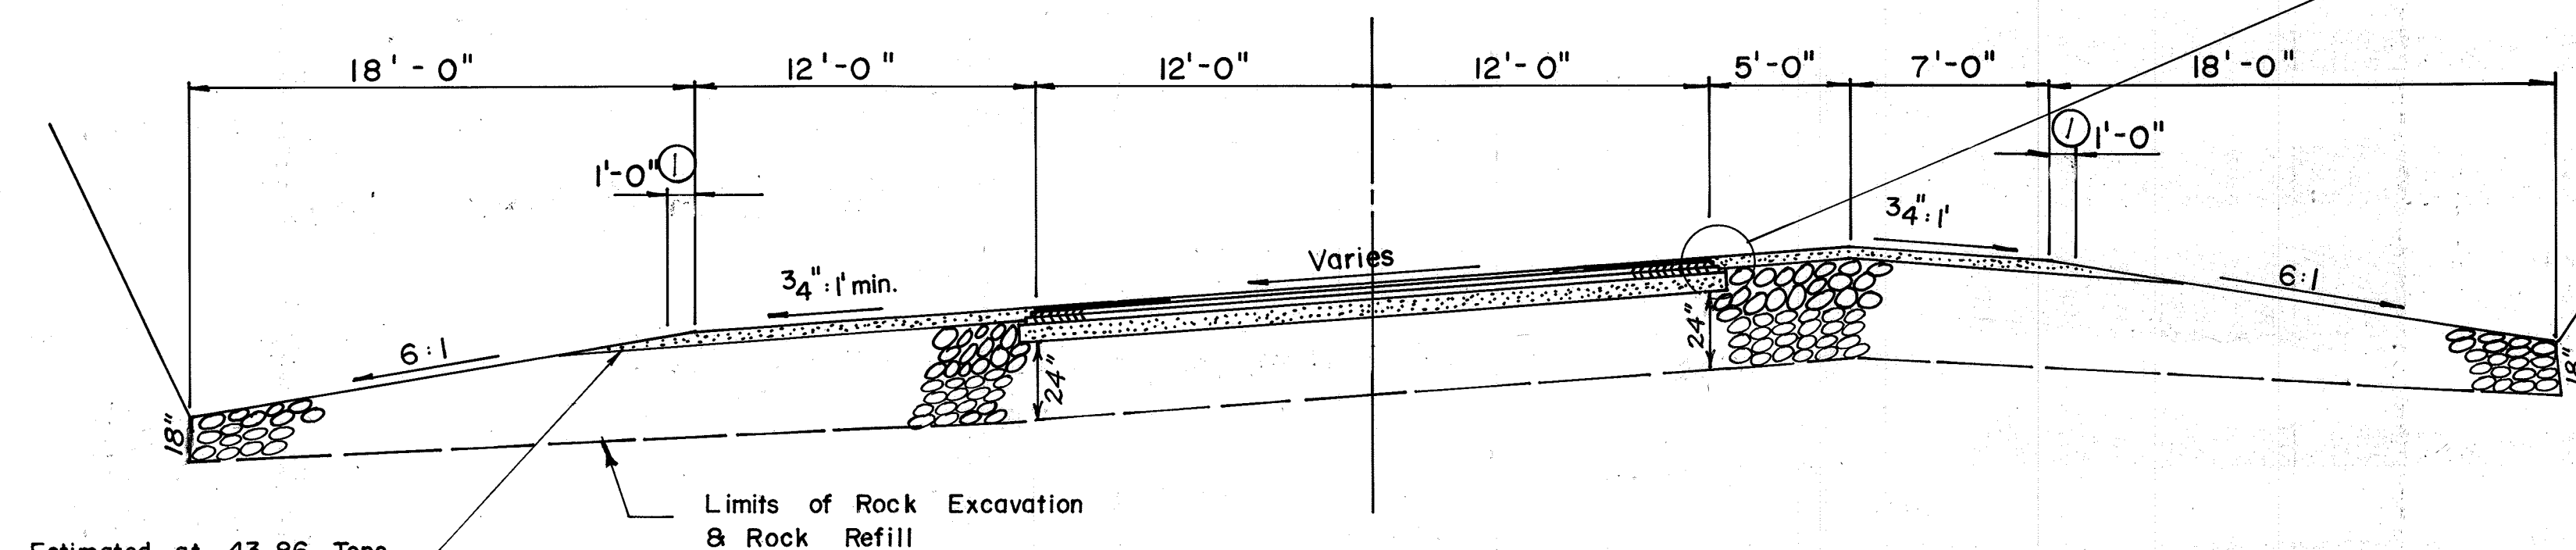

SUPERELEVATED - CUT


NEW CONSTRUCTION

GRADE, DRAIN AND FLEXIBLE PAVEMENT

USING

- APPROXIMATELY 13 1/2" BASE..... 8"± Compacted Depth Dense Graded Aggregate Base
5 1/2" Class 1 Base - [Compacted Bituminous Concrete Base (2-2 3/4 Courses)]
- TACK COAT..... 0.10 Gal. per sq. yd. Apply as directed by the Engineer
- APPROXIMATELY 1" Class 1 Surface..... 1" Compacted Depth Bituminous Concrete Surface, Type "A"
- STABILIZED SHOULDER..... One lift of Rock Excavation Constructed in accordance with Special Provision No. 41a.
Rock Topfill or Rock Refill
5"± Compacted Depth Dense Graded Aggregate Base
0.35 Gal. per sq. yd. RT-2 or AE Primer L
0.30 Gal. per sq. yd. RS-2 or RC-800 (Seal Coat)
20 Lbs. per sq. yd. Crushed Stone Size No. 78 (Compacted by pneumatic rolling)
0.35 Gal. per sq. yd. RS-2 or RC-800 (Seal Coat)
15 Lbs. per sq. yd. Crushed Stone Size No. 8 (Compacted by pneumatic rolling)
- ① 0.25 Gal. per sq. yd. RS-2 or RC-800 (Seal Coat)
① 20 lbs. per sq. yd. Crushed Stone Size No. 8

See Cross-Section for slopes outside the limits of the Shoulder.

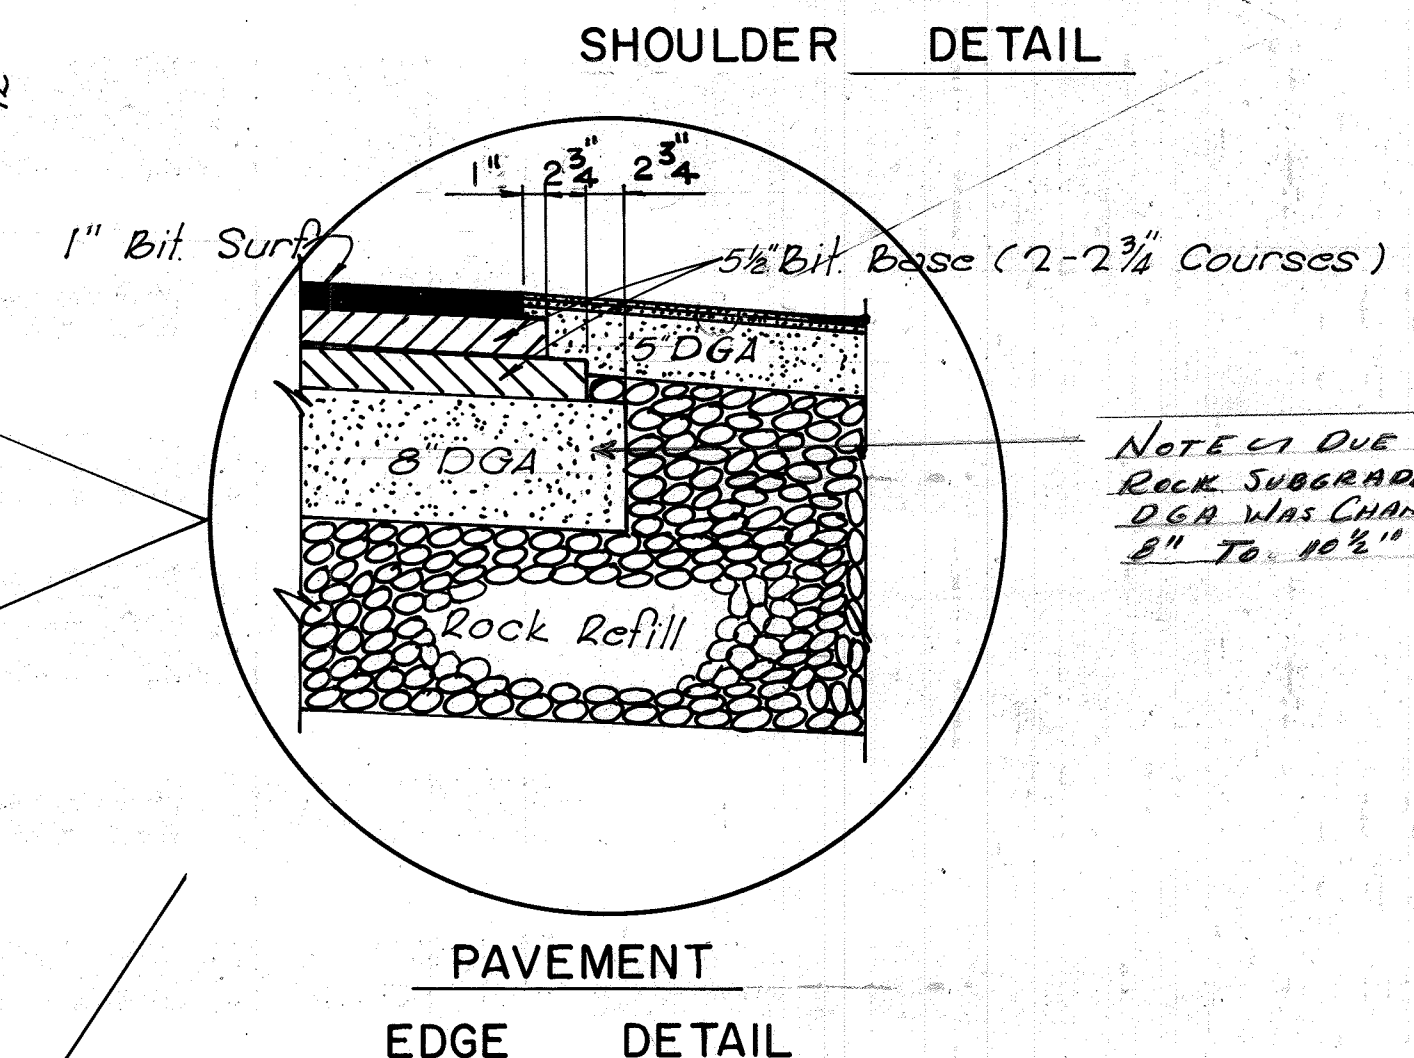


NOTE: DUE TO CHANGE FROM
ROCK SUBGRADE TO DIRT SUBGRADE
DGA WAS CHANGED FROM
8" TO 10 1/2" @ 13+00 - 110+00

Note: The 24" undercut line as shown
on Typical Sections shall govern over Cross-Sections.


① The last course of Oil and Stone shall extend down the slope one foot.

TYPICAL SECTIONS

MAIN LINE

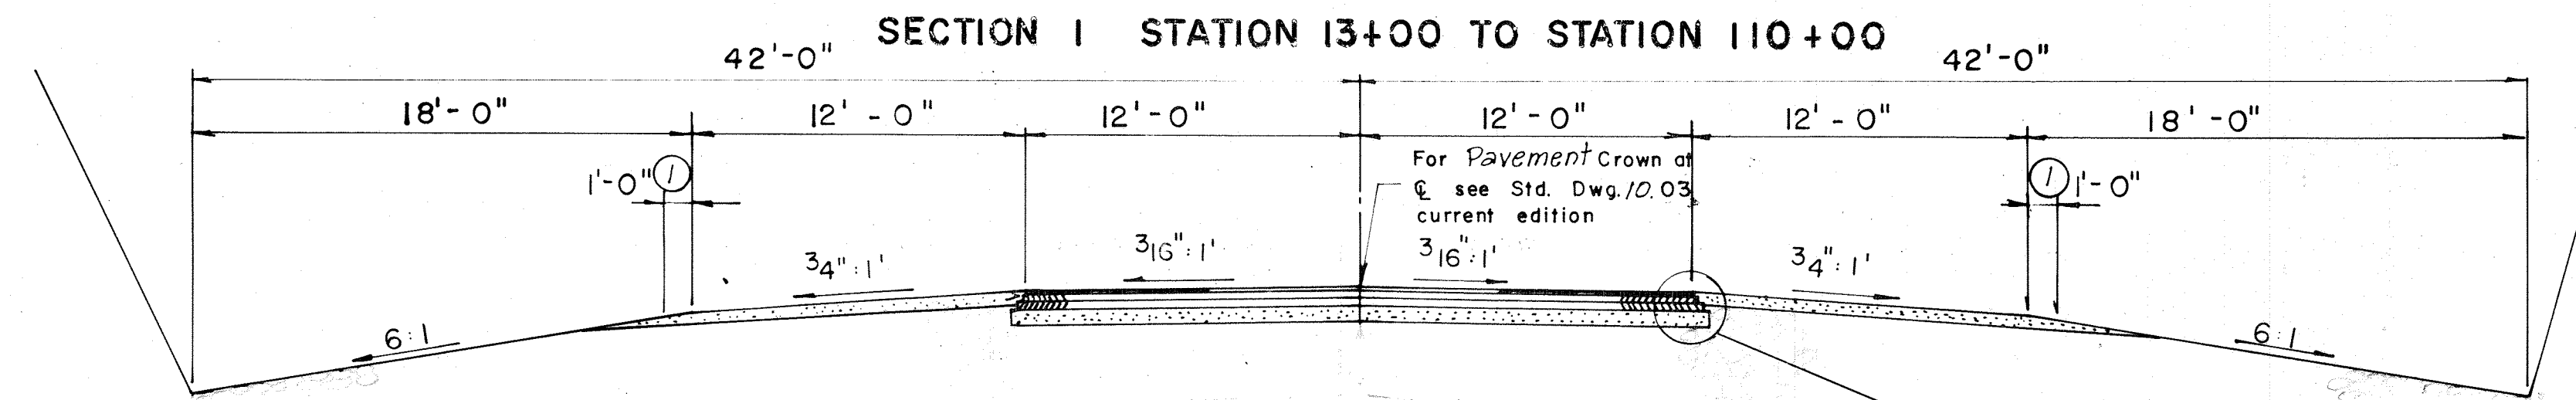

NORMAL - CUT

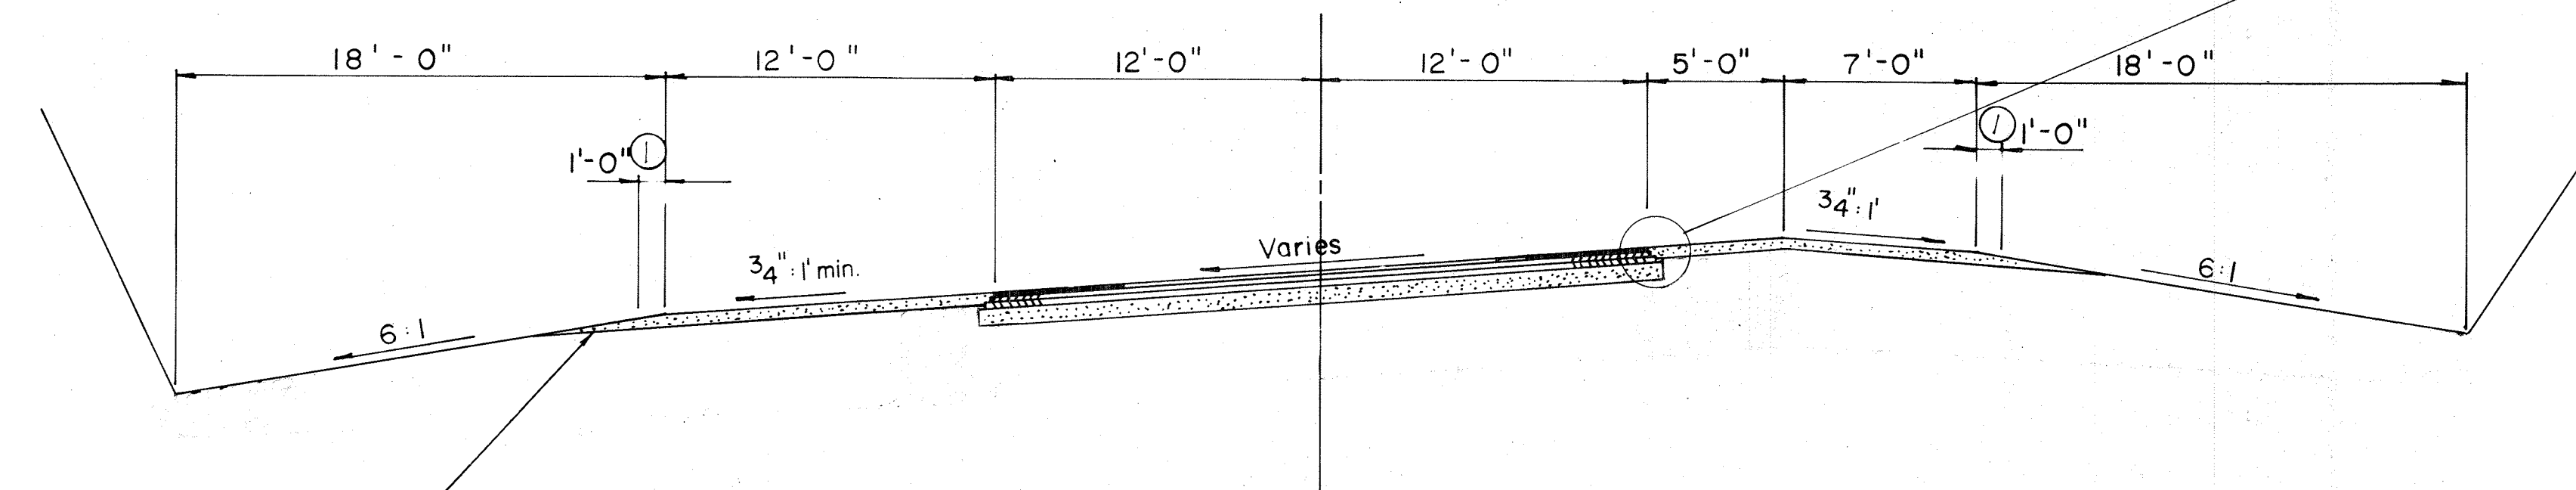

Estimated at 43.86 Tons
D.G.A. per 100' Sta.

SUPERELEVATED - CUT

NEW CONSTRUCTION

GRADE, DRAIN AND FLEXIBLE PAVEMENT


USING

- APPROXIMATELY 16" BASE..... ☐ 10 1/2" Compacted Depth Dense Graded Aggregate Base
☐ 5 1/2" Class I Base - [Compacted Bituminous Concrete Base (2-2 3/4 Courses)]
- TACK COAT..... ☐ 0.10 Gal. per sq. yd. Apply as directed by the Engineer
- APPROXIMATELY 1" Class I Surface..... ☐ 1" Compacted Depth Bituminous Concrete Surface, Type "A"
- STABILIZED SHOULDER..... ☐ 5" Compacted Depth Dense Graded Aggregate Base
☐ 0.35 Gal. per sq. yd. RS-2 or RC-800 (Seal Coat)
☐ 0.30 Gal. per sq. yd. RS-2 or RC-800 (Seal Coat)
☐ 70 Lbs. per sq. yd. Crushed Stone Size No. 78 (Compacted by pneumatic rolling)
☐ 0.35 Gal. per sq. yd. RS-2 or RC-800 (Seal Coat)
☐ 15 Lbs. per sq. yd. Crushed Stone Size No. 8 (Compacted by pneumatic rolling)
- ① 0.25 Gal. per sq. yd. RS-2 or RC-800 (Seal Coat)
 ① 20 lbs. per sq. yd. Crushed Stone Size No. 8

① The last course of oil and stone shall extend down the slope one foot.

2A

SHOULDER DETAIL

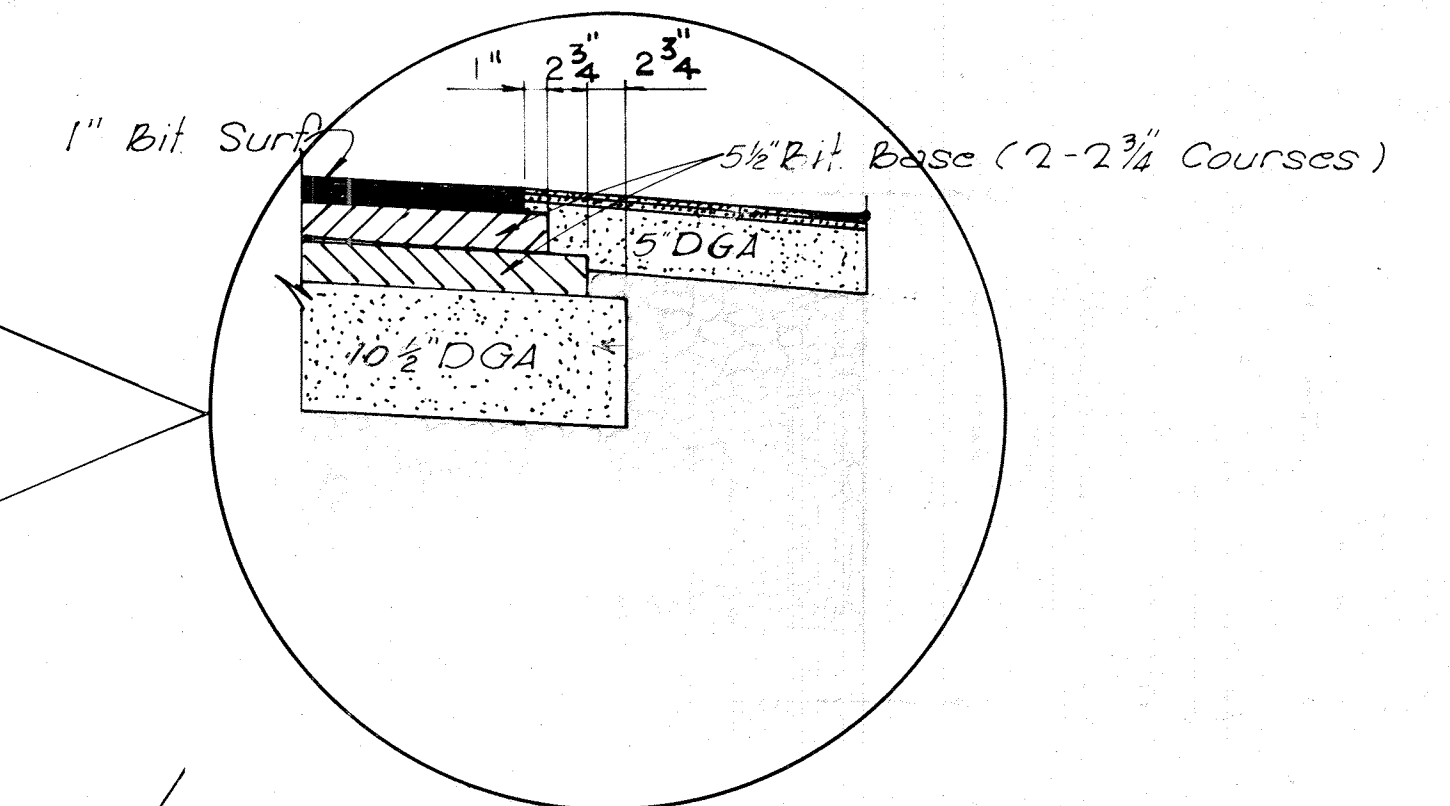

PAVEMENT EDGE DETAIL

See Cross-Section for slopes outside the limits of the Shoulder.


KY. DEPT. OF H'WAYS.	
STA. TO	STA.
CONST. REVISION NO. 1	
SEE CH'G. ORDER NO. 4	
SUBMITTED BY	DATE
RECOMMENDED FOR APPROVAL BY	DATE
RECOMMENDED FOR APPROVAL BY	DATE
APPROVED BY	DATE

Note: Original typical section Sta. 13+00 to 110+00 changed due to fact rock fill was not available because of decision to not remove rock excavation thru slide area Sta. 110-143.
 (Typical as shown constructed. Earth Sub-grade with 10 1/2" DGA instead of 5" DGA & Rock foundation.)


TYPICAL SECTIONS

MAIN LINE

SECTION I STATION 13+00 TO STATION 110+00

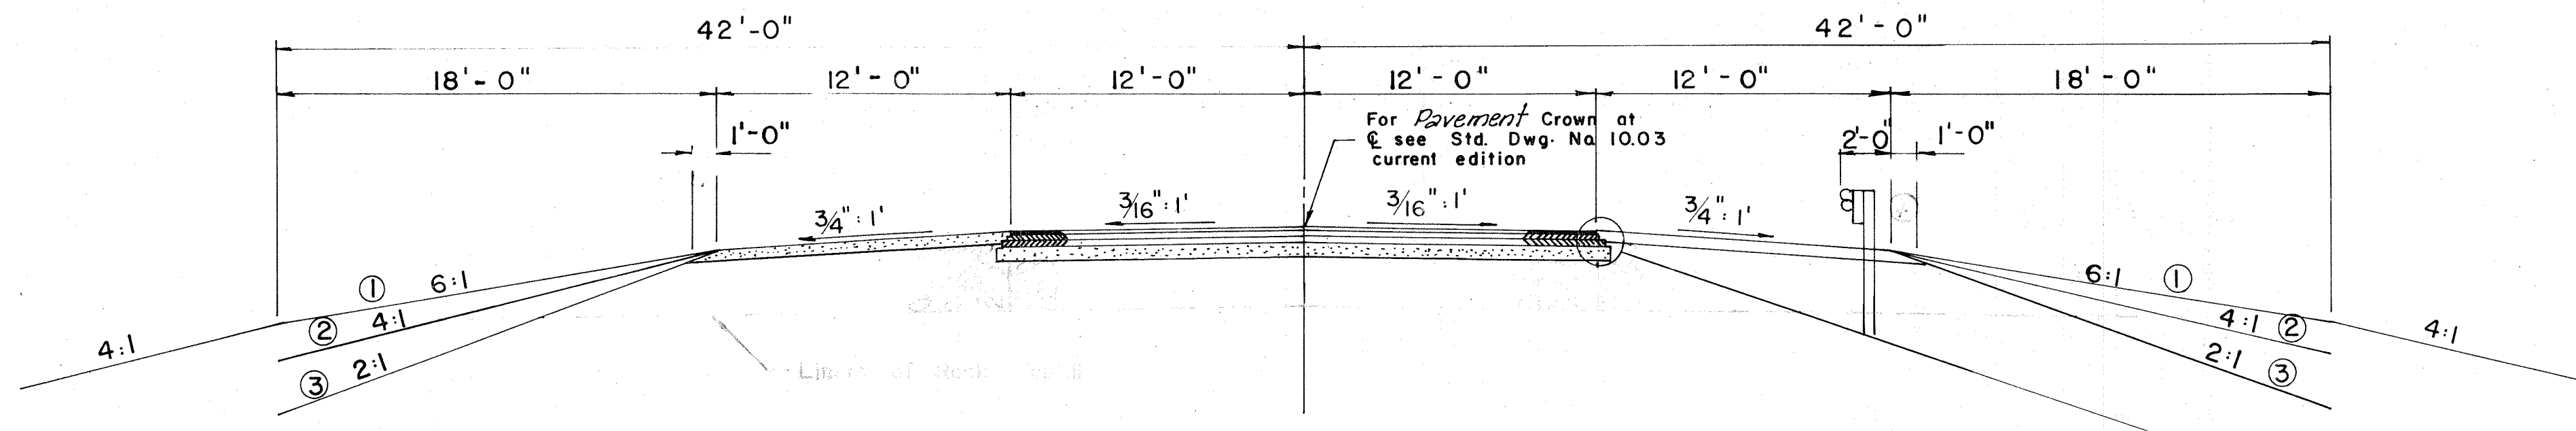


NORMAL-FILL

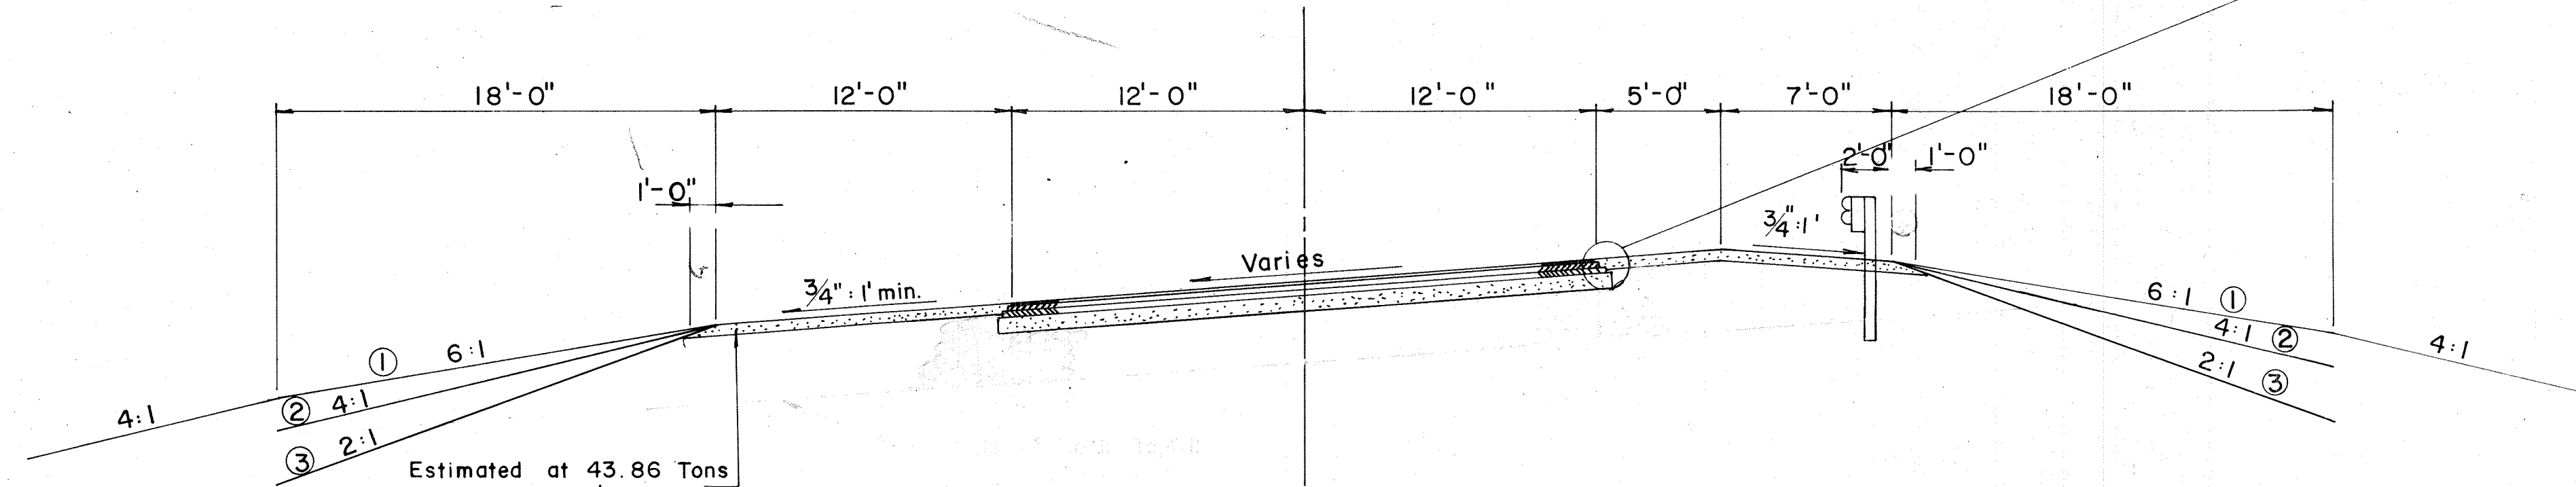

SUPERELEVATED-FILL
 NEW CONSTRUCTION
 GRADE, DRAIN AND FLEXIBLE PAVEMENT
 USING

- APPROXIMATELY 16" BASE..... 10 1/2" Compacted Depth Dense Graded Aggregate Base
 5 1/2" Class I Base - [Compacted Bituminous Concrete Base (2-2 3/4" Courses)]
- TACK COAT..... 0.10 Gal. per sq. yd. (Apply as directed by Engineer)
- APPROXIMATELY 1" CLASS I SURFACE..... 1" Compacted Depth Bituminous Concrete Surface, Type A
- STABILIZED SHOULDER..... 5" Compacted Depth Dense Graded Aggregate Base
 0.35 Gal. per sq. yd. RT-2 or AE Primer L
 0.30 Gal. per sq. yd. RS-2 or RC-800 (Seal Coat)
 70 Lbs. per sq. yd. Crushed Stone Size No. 78 (Compact by pneumatic rolling)
 0.35 Gal. per sq. yd. RS-2 or RC-800 (Seal Coat)
 1.5 Lbs. per sq. yd. Crushed Stone Size No. 8 (Compact by pneumatic rolling)
- ④ 0.25 Gal. per sq. yd. RS-2 or RC-800 (Seal Coat)
- ④ 20 lbs. per sq. yd. Crushed Stone Size No. 8

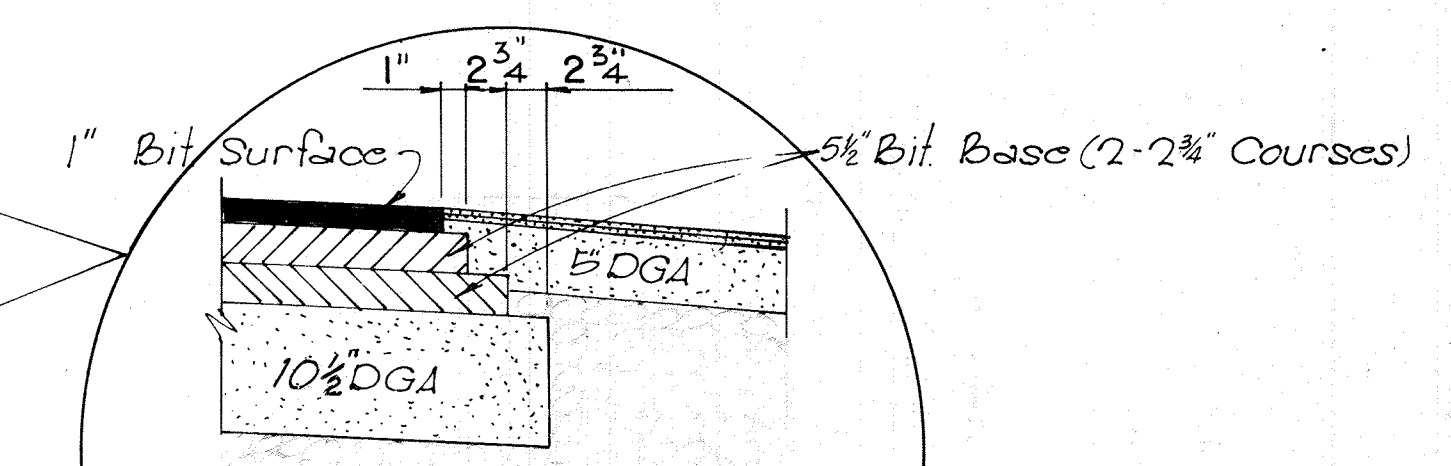

* See Note Page 2

PAVEMENT		DEPT. OF H'WAYS.	
EDGE DETAIL	STA.	TO	STA.
CONST. REVISION NO. 1		SEE CH'G. ORDER NO. 4	
SUBMITTED BY	RES. ENGR.	DATE	
RECOMMENDED FOR APPROVAL BY	DIST. ENGR.	DATE	
RECOMMENDED FOR APPROVAL BY	DIR. OF CONST.	DATE	
APPROVED BY	PROJECTS MANAGEMENT		

- ① For Fills Under 10'
- ② For Fills 10'-20'
- ③ For Fills Over 20' or 10'-20' with Guard Rail

See Cross-sections for slopes outside the limits of the Shoulder.


④ The last course of Oil and Stone shall extend down the slope one foot

TYPICAL SECTIONS


MAIN LINE

BULLITT COUNTY				
BARDSTOWN-SHEPHERDSVILLE RD. (KY 245)				
SP 15-334	STATE	FISCAL YEAR	SHEET NO.	TOTAL SHEETS
7	KY.	1971	3	372

3

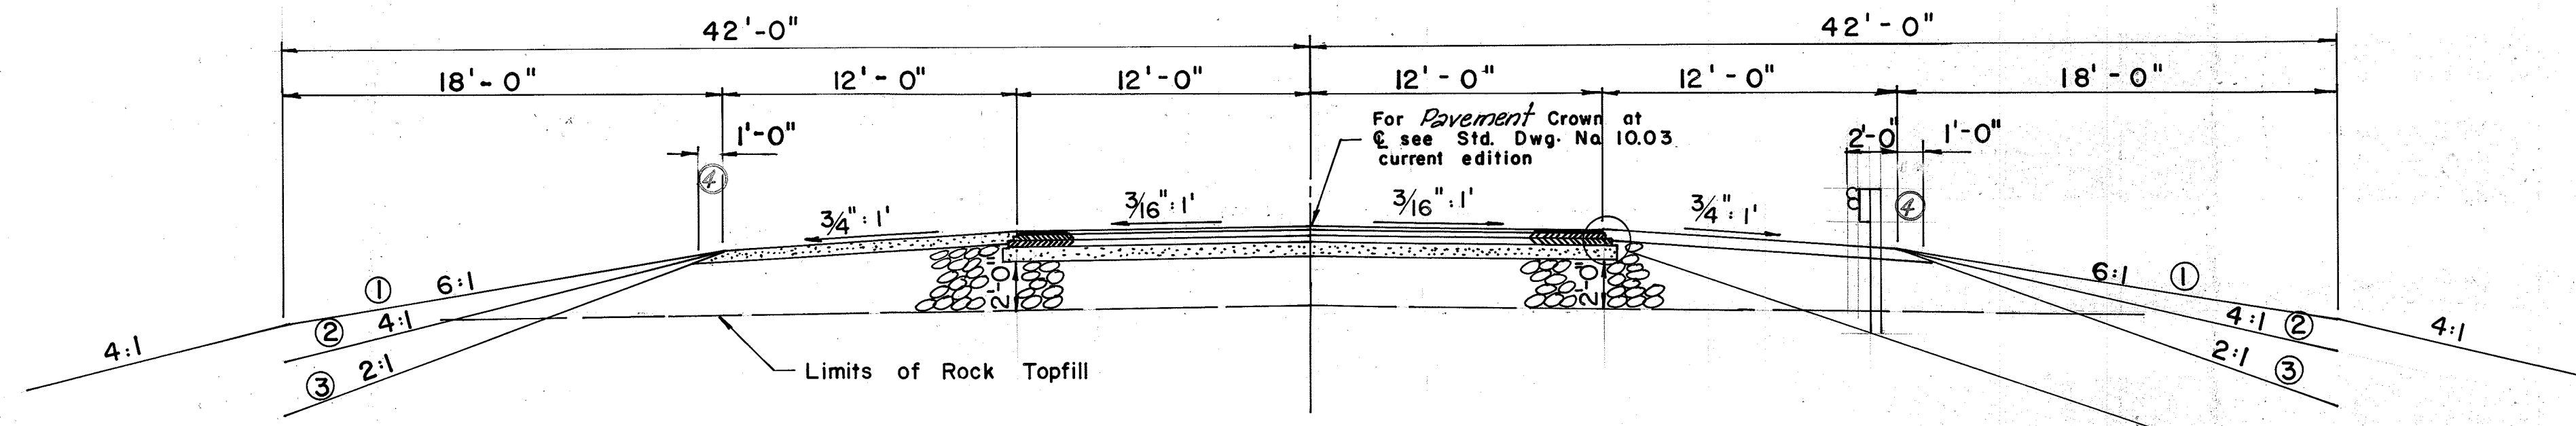

NORMAL— FILL

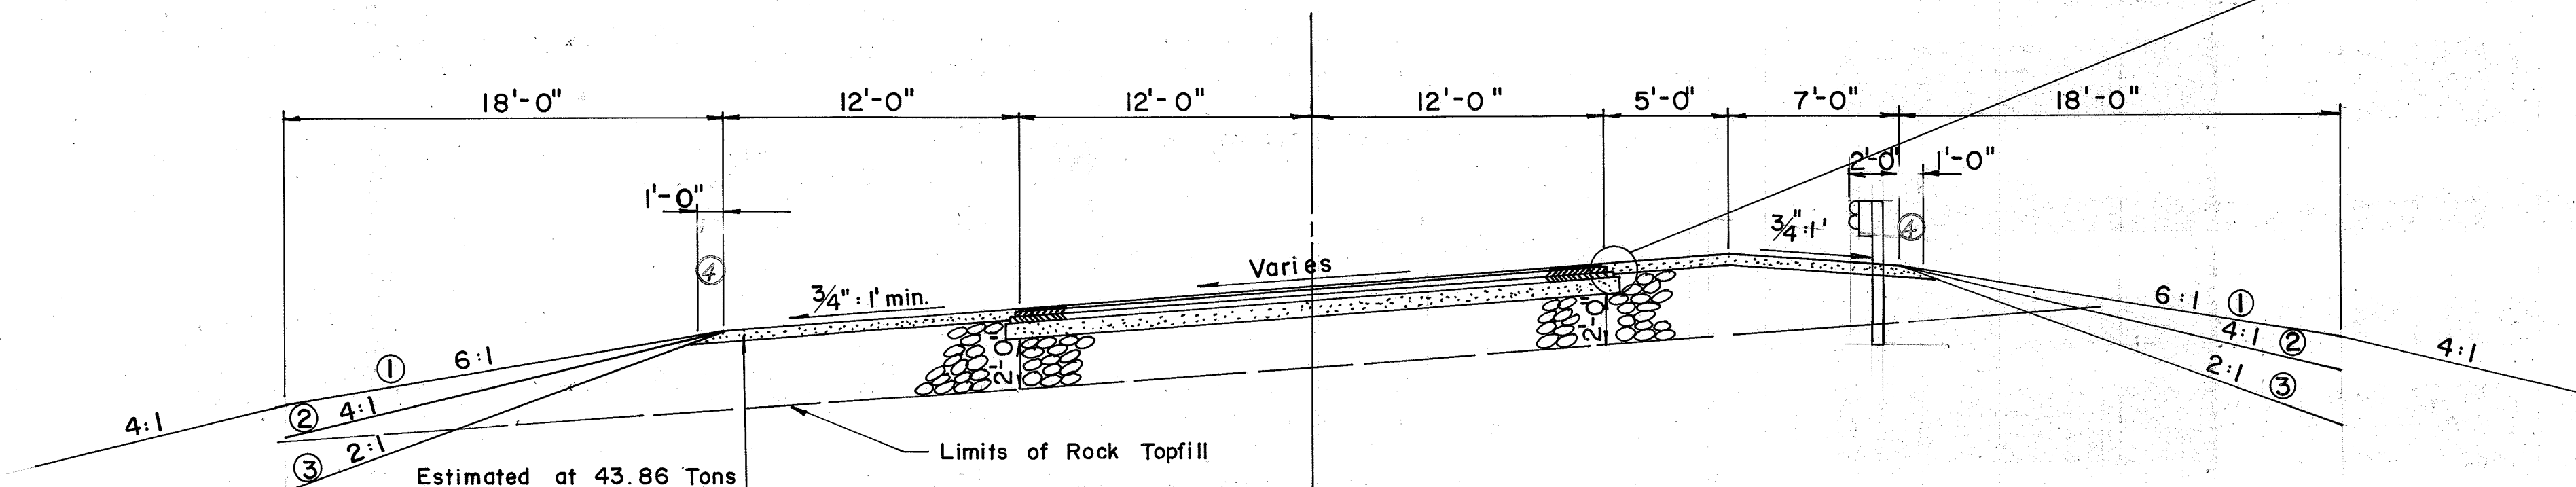

SUPERELEVATED— FILL NEW CONSTRUCTION GRADE, DRAIN AND FLEXIBLE PAVEMENT

USING


- APPROXIMATELY 1 1/2" BASE 8"± Compacted Depth Dense Graded Aggregate Base
5 1/2" Class I Base — [Compacted Bituminous Concrete Base (2-2 1/4" Courses)]
- TACK COAT..... 0.10 Gal. per sq. yd. (Apply as directed by Engineer)
- APPROXIMATELY 1" CLASS I SURFACE 1"± Compacted Depth Bituminous Concrete Surface, Type "A"
- STABILIZED SHOULDER..... One lift of rock roadbed material Constructed in accordance with Special Provision No. 41A.
5"± Compacted Depth Dense Graded Aggregate Base
0.35 Gal. per sq. yd. RT-2 or AE Primer L
0.30 Gal. per sq. yd. RS-2 or RC-800 (Seal Coat)
70 Lbs. per sq. yd. Crushed Stone Size No. 78 (Compact by pneumatic rolling)
0.35 Gal. per sq. yd. RS-2 or RC-800 (Seal Coat)
15 Lbs. per sq. yd. Crushed Stone Size No. 8 (Compact by pneumatic rolling)
- ④ 0.25 Gal. per sq. yd. RS-2 or RC-800 (seal Coat)
④ 20 lbs. per sq. yd. Crushed Stone Size No. 8

- ① For Fills Under 10'
② For Fills 10' - 20'
③ For Fills Over 20' or 10' - 20' with Guard Rail

See cross-sections for slopes outside the limits of the shoulder.

Note:
The 24" undercut line as shown on typical sections shall govern over cross sections.


④ The last course of Oil and Stone shall extend down the slope one foot

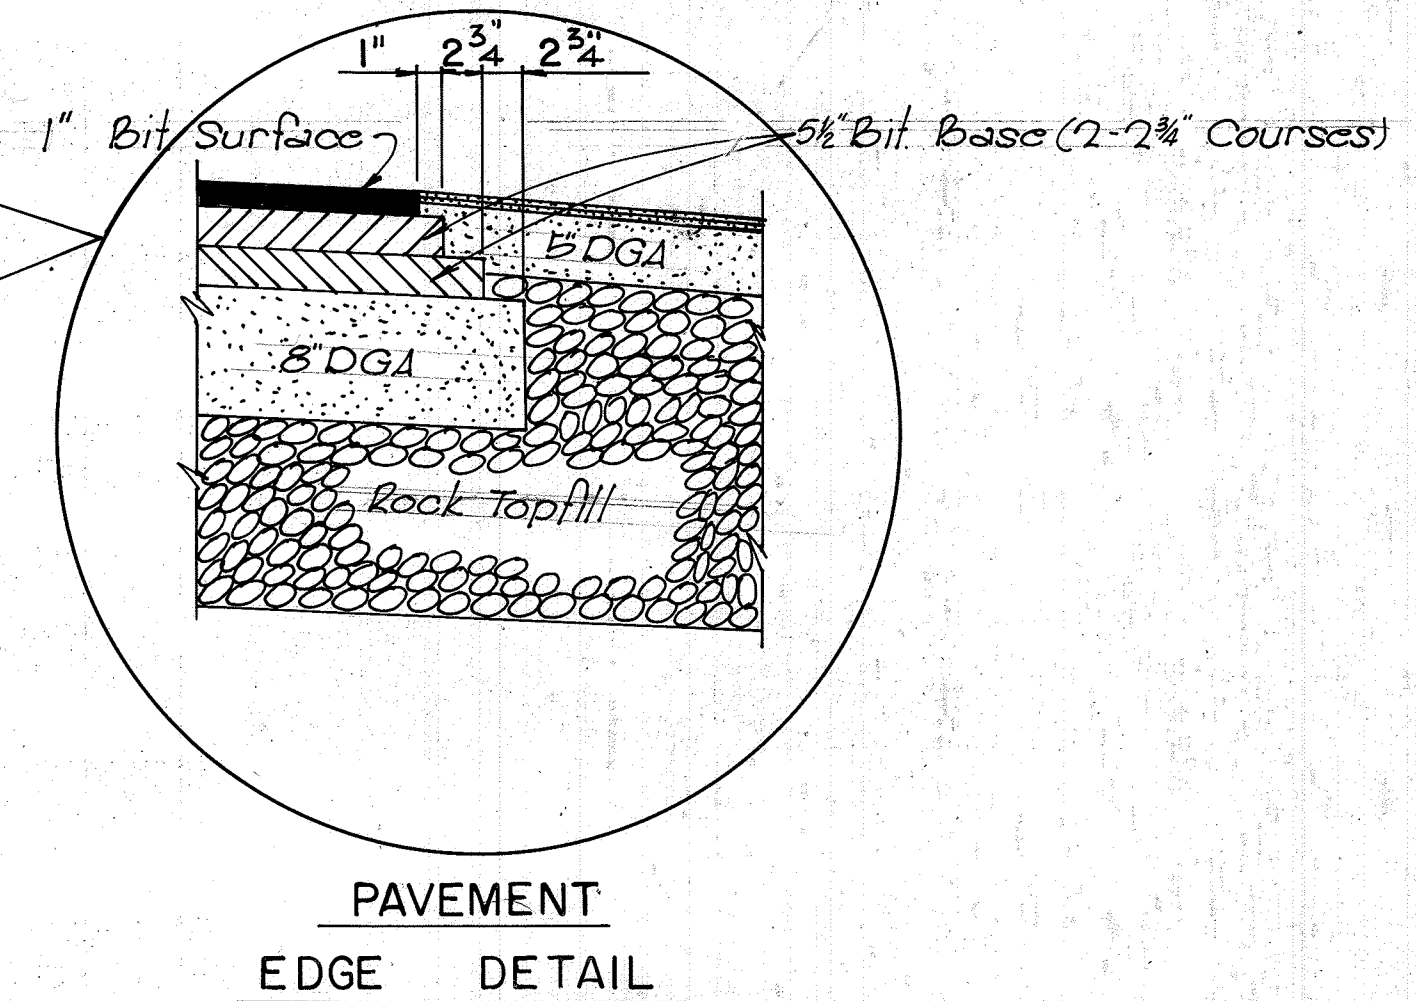


TYPICAL SECTIONS

MAIN LINE

SECTION 2 STATION 143+00 TO STATION 332+44.52

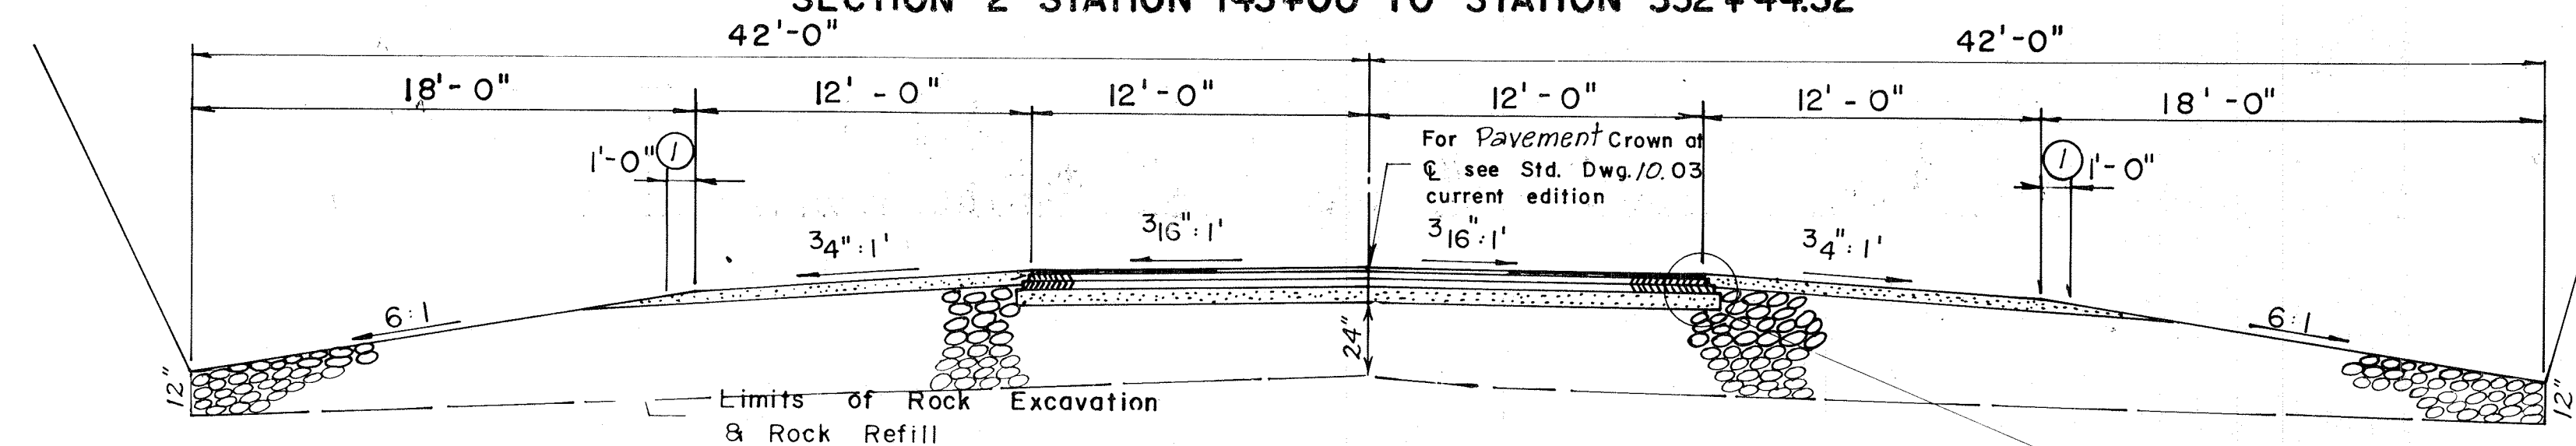

NORMAL - CUT

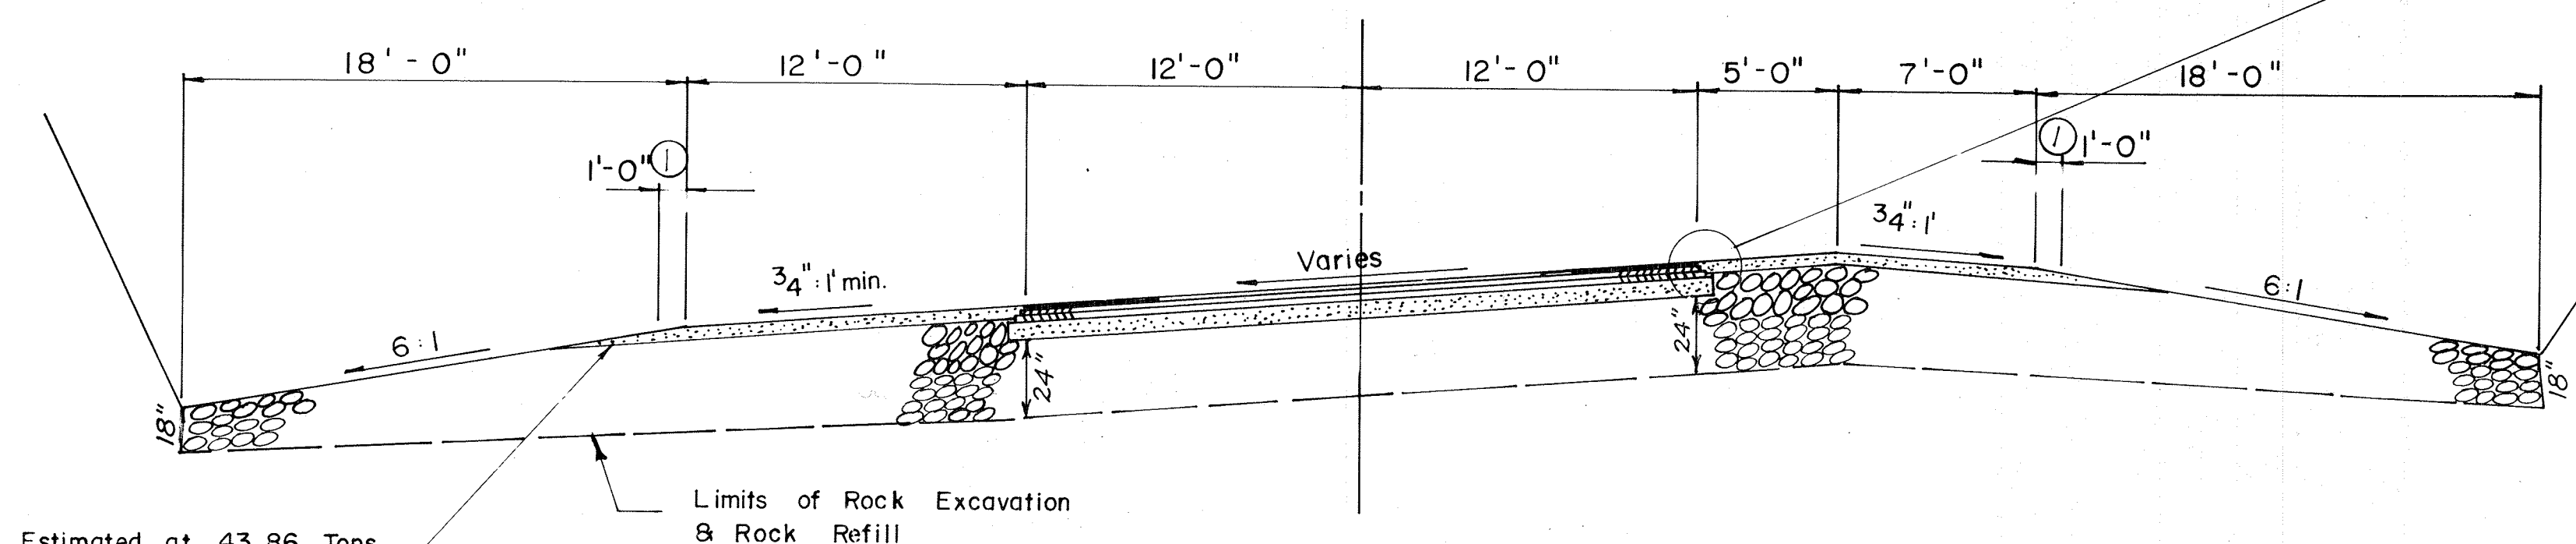

SUPERELEVATED - CUT

NEW CONSTRUCTION

GRADE, DRAIN AND FLEXIBLE PAVEMENT

USING

- APPROXIMATELY 13 1/2" BASE..... 8" Compacted Depth Dense Graded Aggregate Base
5 1/2" Class I Base [Compacted Bituminous Concrete Base (2-2 3/4 Courses)]
- TACK COAT..... 0.10 Gal. per sq. yd. Apply as directed by the Engineer
- APPROXIMATELY 1" Class I Surface..... 1" Compacted Depth Bituminous Concrete Surface, Type "A"
- STABILIZED SHOULDER..... one lift of Rock Excavation Constructed in accordance with Special Provision No. 41a.
Rock Topfill or Rock Refill
5" Compacted Depth Dense Graded Aggregate Base
0.35 Gal. per sq. yd. RT-2 or AE Primer L
0.30 Gal. per sq. yd. RS-2 or RC-800 (Seal Coat)
70 Lbs. per sq. yd. Crushed Stone Size No. 78 (Compacted by pneumatic rolling)
0.35 Gal. per sq. yd. RS-2 or RC-800 (Seal Coat)
15 Lbs. per sq. yd. Crushed Stone Size No. 8 (Compacted by pneumatic rolling)
- ① 0.25 Gal. per sq. yd. RS-2 or RC-800 (Seal Coat)
① 20 lbs. per sq. yd. Crushed Stone Size No. 8


① The last course of oil and stone shall extend down the slope one foot.

Construction Revision No. 1
SHEET 9 of 5

BULLIT COUNTY			
BARDSTOWN-SHEPHERDSVILLE RD (KY 245)			
FED. DIST. ROAD NO.	STATE	FISCAL YEAR	SHEET NO.
7	KY	1971	372

3A

SHOULDER DETAIL

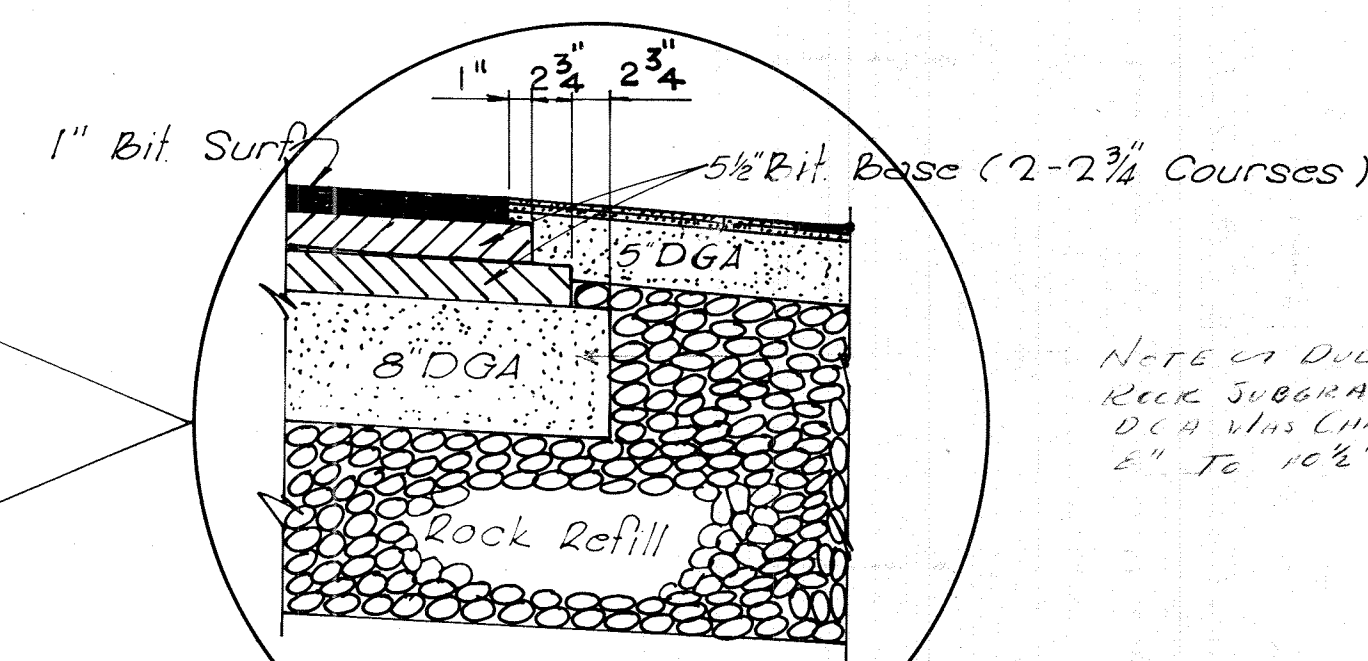

PAVEMENT
EDGE DETAIL

Note: The 24" undercut line as shown on Typical Sections shall govern over Cross-Sections.

See Cross-Section for slopes outside the limits of the Shoulder.

KY. DEPT. OF H'WAYS.	
STA. TO	STA.
CONST. REVISION NO. 1	
SEE CH'G. ORDER NO. 4	
SUBMITTED BY	RES. ENGR. DATE
RECOMMENDED FOR APPROVAL BY	DIST. ENGR. DATE
RECOMMENDED FOR APPROVAL BY	DIR. OF CONST. DATE
APPROVED BY	PROJECTS MANAGEMENT ENGR. DATE


Note: This typical same as original - Only the location has changed. Now reads Sta. 143+00 to 332+44.52 (Original 13+00 to 332+44.52)

3 B


TYPICAL SECTIONS

MAIN LINE

SECTION 2 STATION 143+00 TO STATION 332+44.52

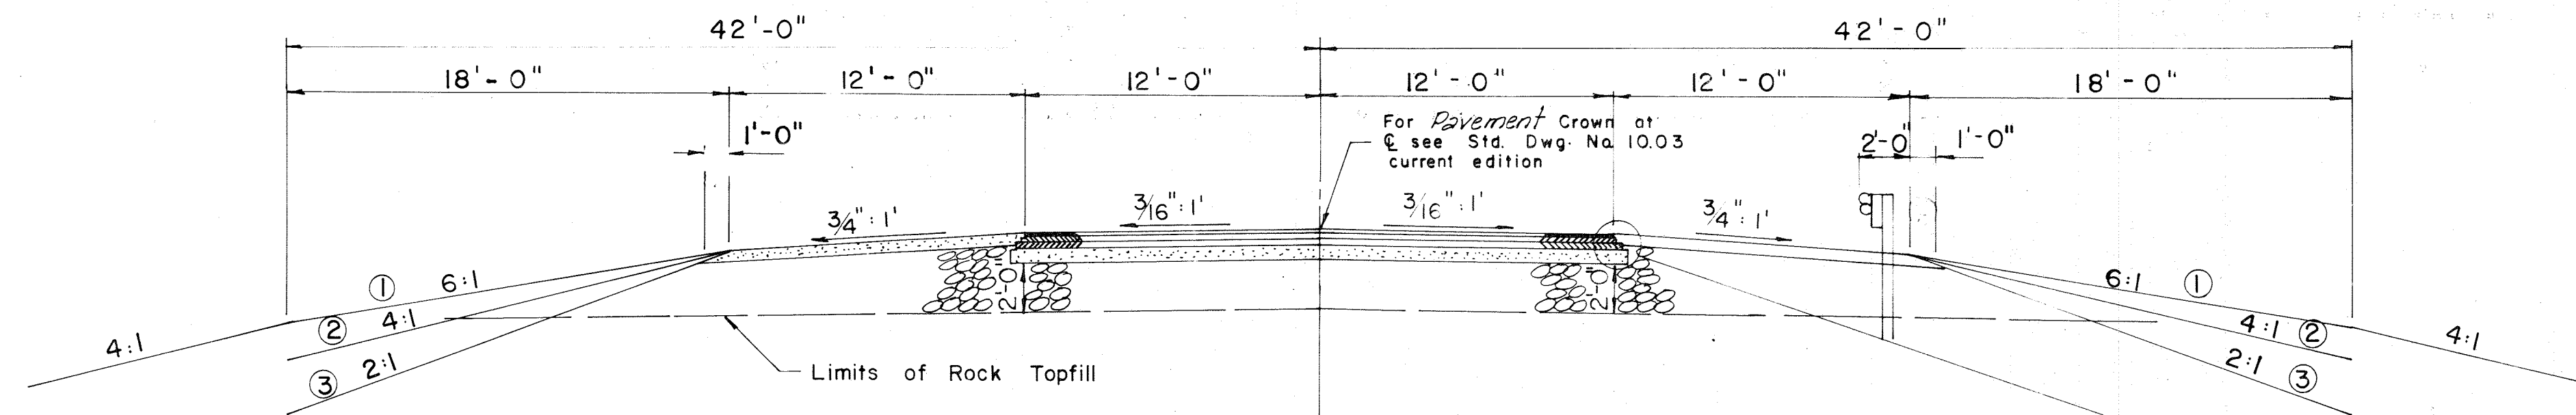

NORMAL— FILL

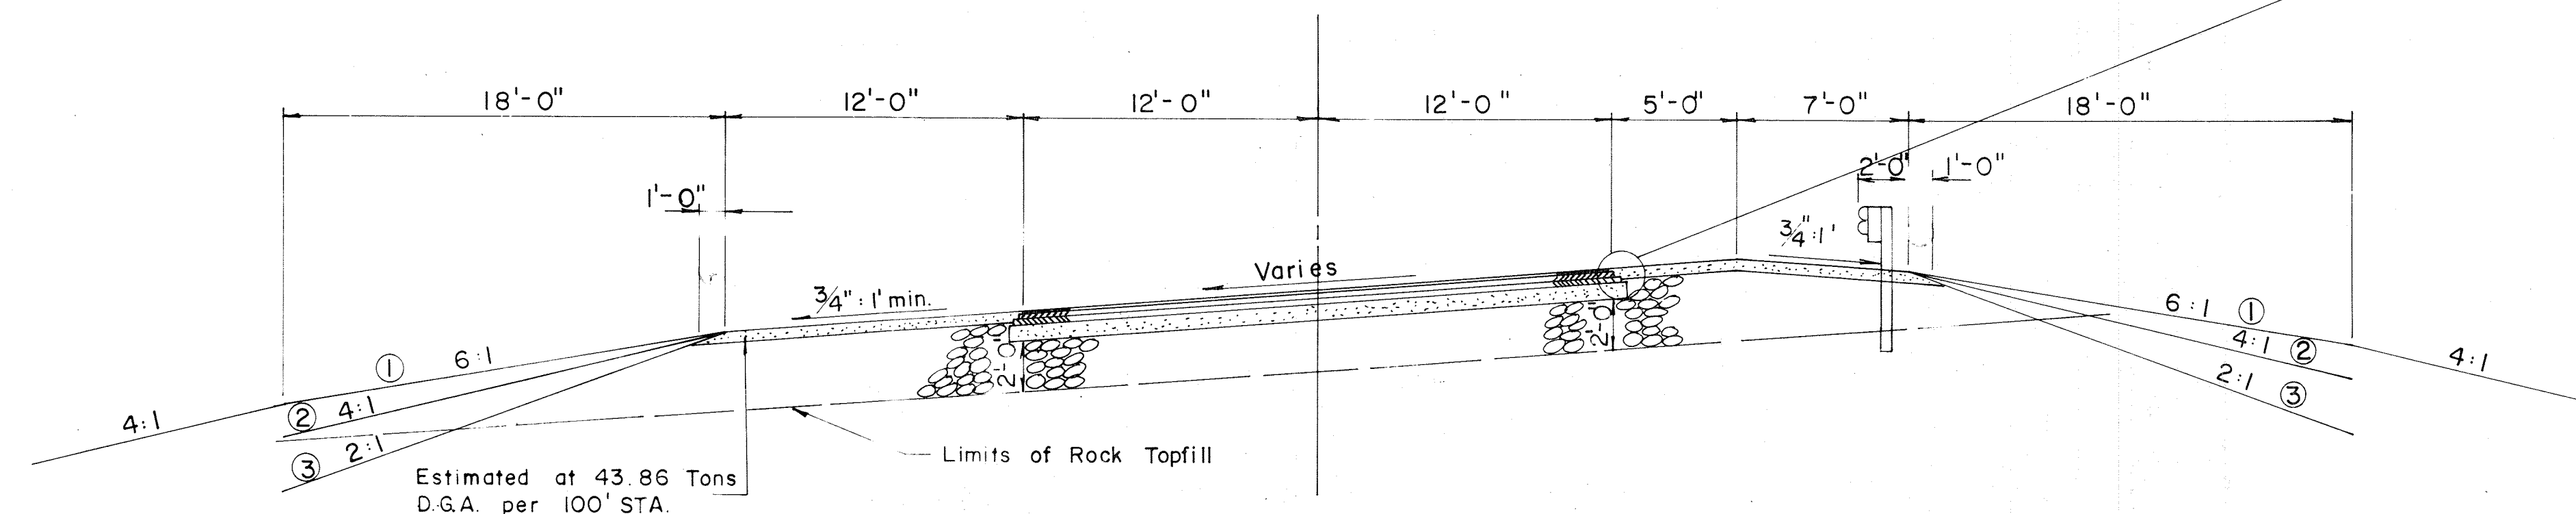


SUPERELEVATED— FILL NEW CONSTRUCTION GRADE, DRAIN AND FLEXIBLE PAVEMENT USING

- APPROXIMATELY 1 1/2" BASE 8"± Compacted Depth Dense Graded Aggregate Base
 5 1/2" Class I Base - [Compacted Bituminous Concrete Base (2-2 1/4" Courses)]
- TACK COAT..... 0.10 Gal. per sq. yd. (Apply as directed by Engineer)
- APPROXIMATELY 1" CLASS I SURFACE 1"± Compacted Depth Bituminous Concrete Surface, Type "A"
- STABILIZED SHOULDER..... One lift of rock roadbed material constructed in accordance with Special Provision No. 41A.
 5"± Compacted Depth Dense Graded Aggregate Base
 0.35 Gal. per sq. yd. RT-2 or AE Primer L
 0.30 Gal. per sq. yd. RS-2 or RC-800 (Seal Coat)
 70 Lbs. per sq. yd. Crushed Stone Size No. 78 (Compact by pneumatic rolling)
 0.35 Gal. per sq. yd. RS-2 or RC-800 (Seal Coat)
 15 Lbs. per sq. yd. Crushed Stone Size No. 8 (Compact by pneumatic rolling)
- ① 0.25 Gal. per sq. yd. RS-2 or RC-800 (Seal Coat)
 ④ 20 lbs. per sq. yd. Crushed Stone Size No. 8

See cross-sections for slopes outside the limits of the Shoulder.

Note:
 The 64" compact limit is shown on typical section shall extend over shoulder.

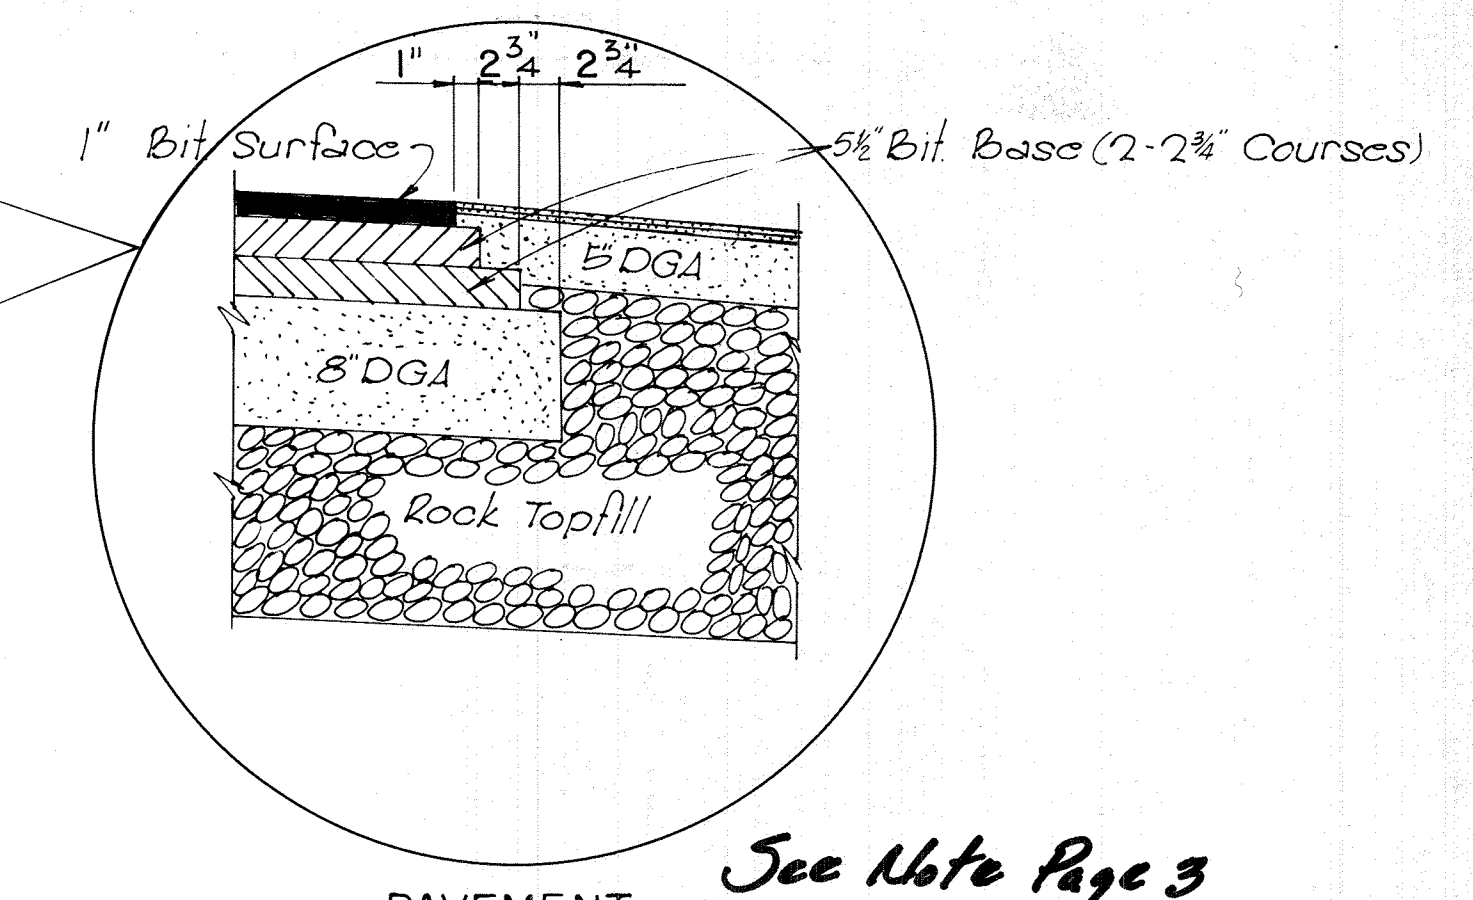

PAVEMENT
 EDGE DETAIL. DEPT. OF H'WAYS.

STA. TO STA.
 CONST. REVISION NO. 1
 SEE CH'G. ORDER NO. 4


SUBMITTED BY: [Signature] DATE: 12-77
 RECOMMENDED FOR RES. ENGR. DATE: 12-77
 APPROVAL BY: [Signature] DATE: 12-77
 RECOMMENDED FOR DIST. ENGR. DATE: 12-77
 APPROVAL BY: [Signature] DATE: 12-77
 DIR. OF CONST. DATE: 12-77
 APPROVED BY: [Signature] DATE: 12-77
 PROJECTS MANAGEMENT ENGR. DATE: 12-77

- ① For Fills Under 10'
 ② For Fills 10' - 20'
 ③ For Fills Over 20' or 10' - 20' with Guard Rail


① The last course of Oil and Stone shall extend down the slope one foot

BULLITT COUNTY				
BARDSTOWN-SHEPHERDSVILLE RD (KY245)				
SP 15-334 RS 312 (9)				
FED. ROAD DIST. NO.	STATE	FISCAL YEAR	SHEET NO.	TOTAL SHEETS
7	KY.	1971	28	372

Diagram illustrating the Edge Detail of a concrete slab. The detail shows a cross-section of the slab with a 3" base, a 1" surface, and a 10" DGA base. The dimensions are given in inches.

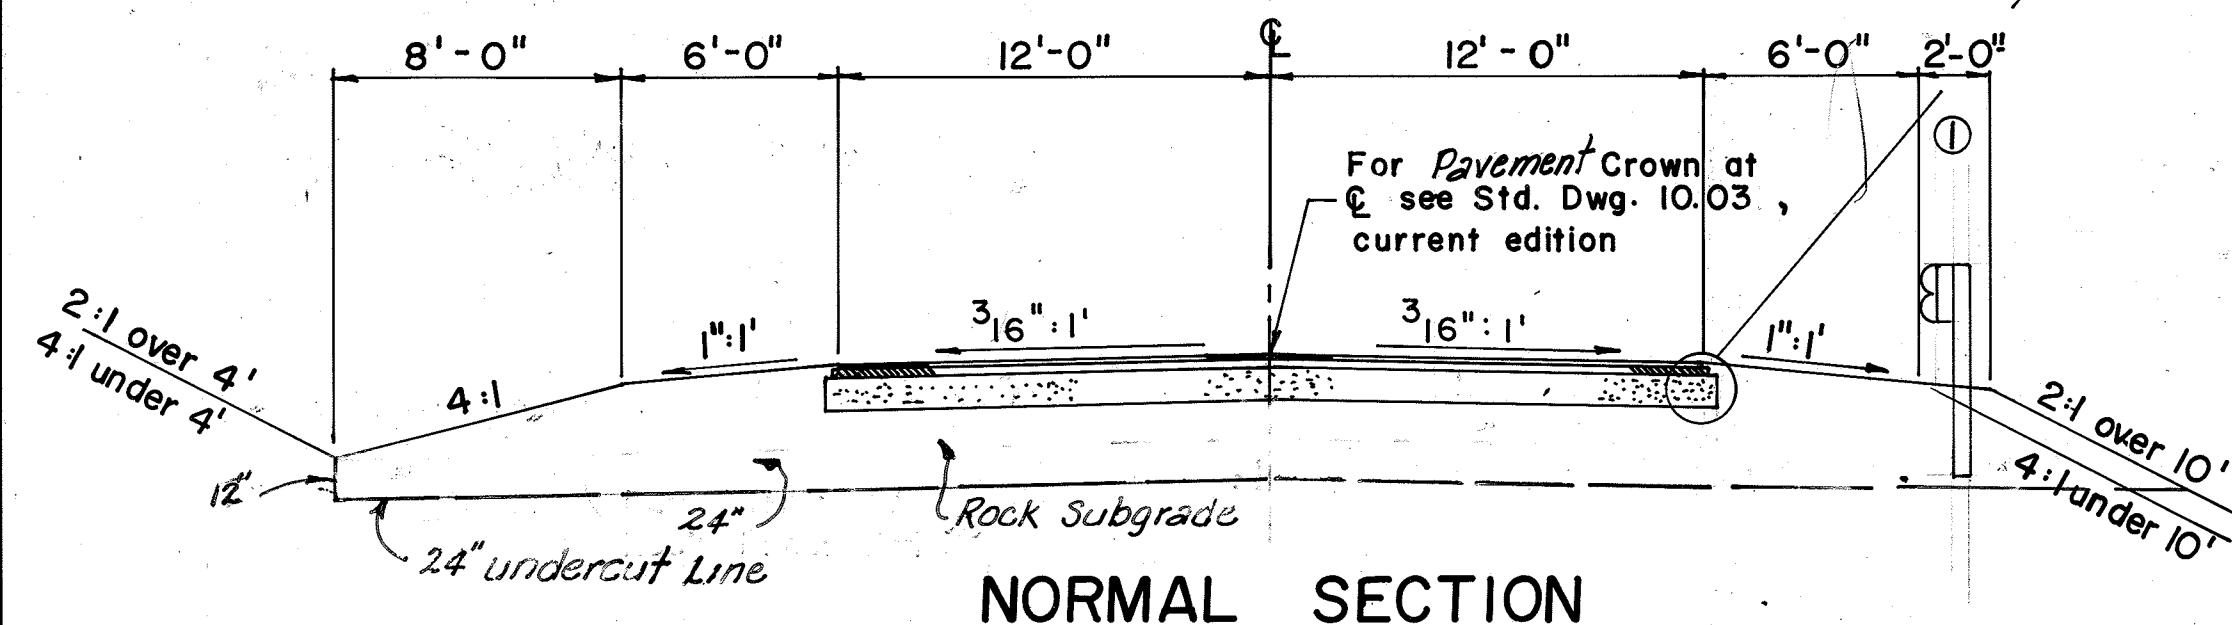


NORMAL SECTION

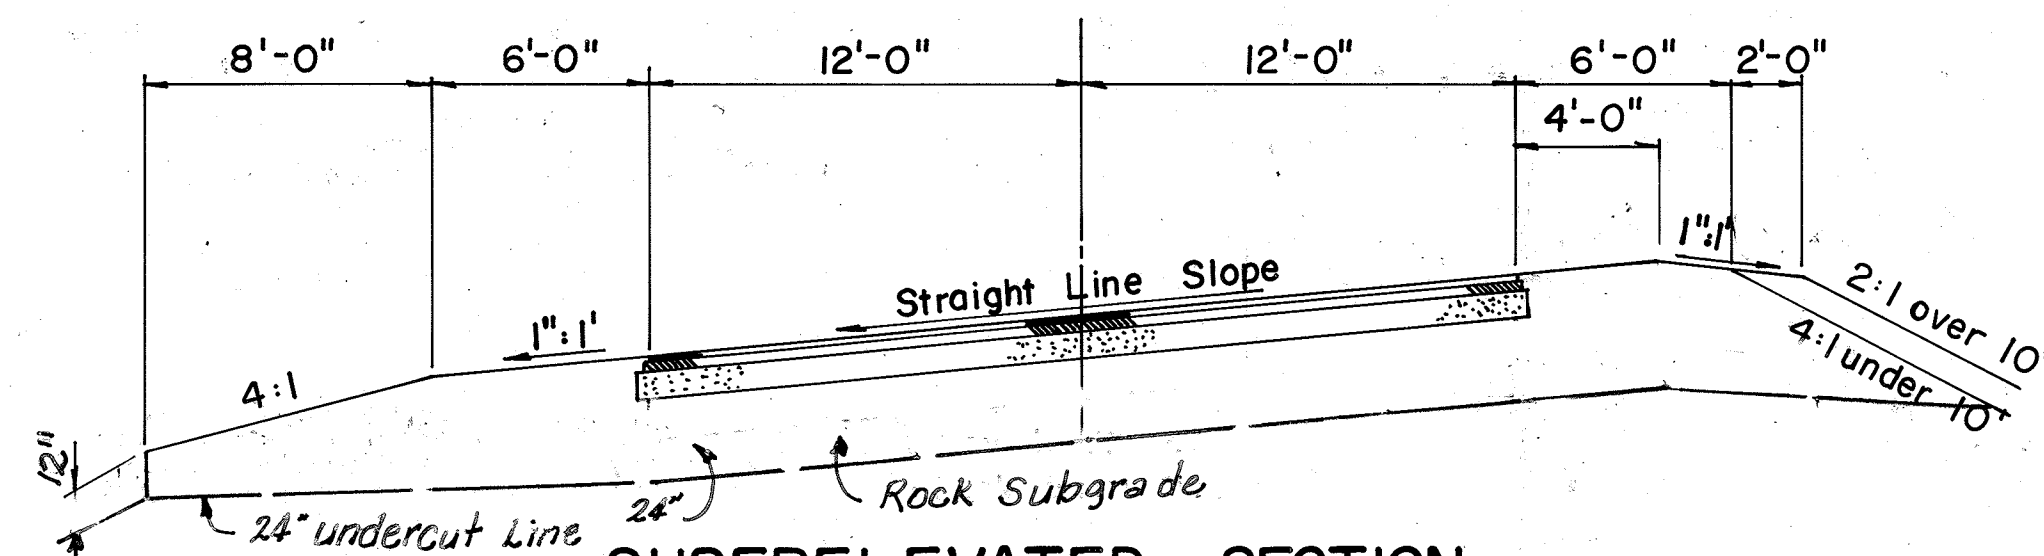

SUPERELEVATED SECTION


USING

RAMP C (Lt. Sta. 16+98.63)

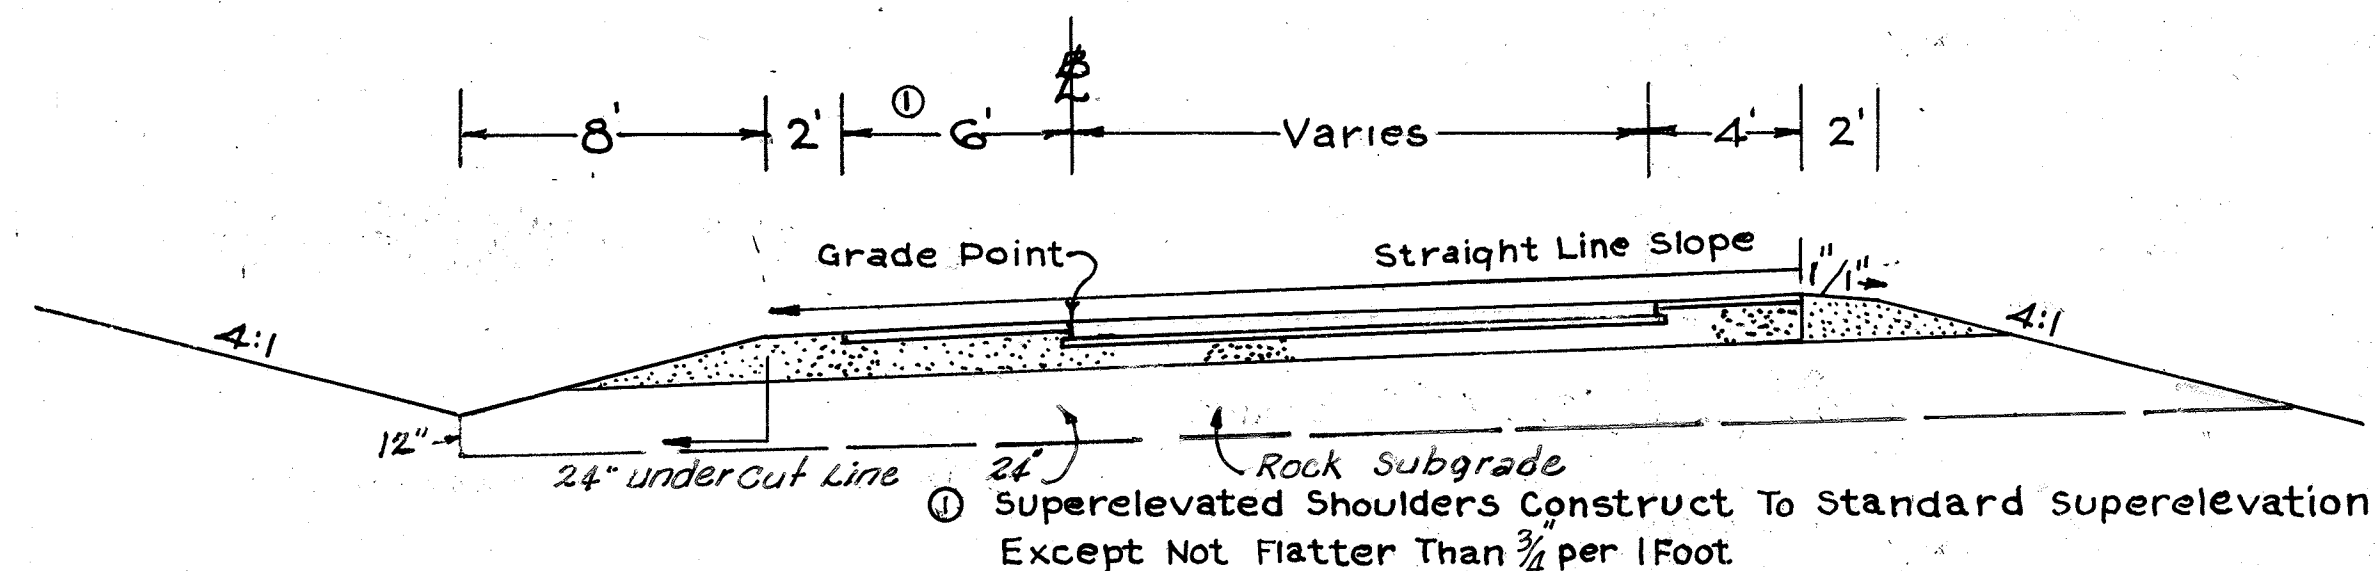


APPROXIMATELY 6" BASE.....[Compacted Dense Graded Aggregate Base
9" Surface.....[uniform Cement Concrete Pavement, Type "D"
SHOULDER.....[Full Depth Compacted Dense Graded Aggregate
0.25 Gal. per sq. yd. RT-2 or AE Primer L
2" Compacted Depth Bituminous Concrete Surface Type "A"

PARK MAINT. ENTR. (RT. STA. 102+70)

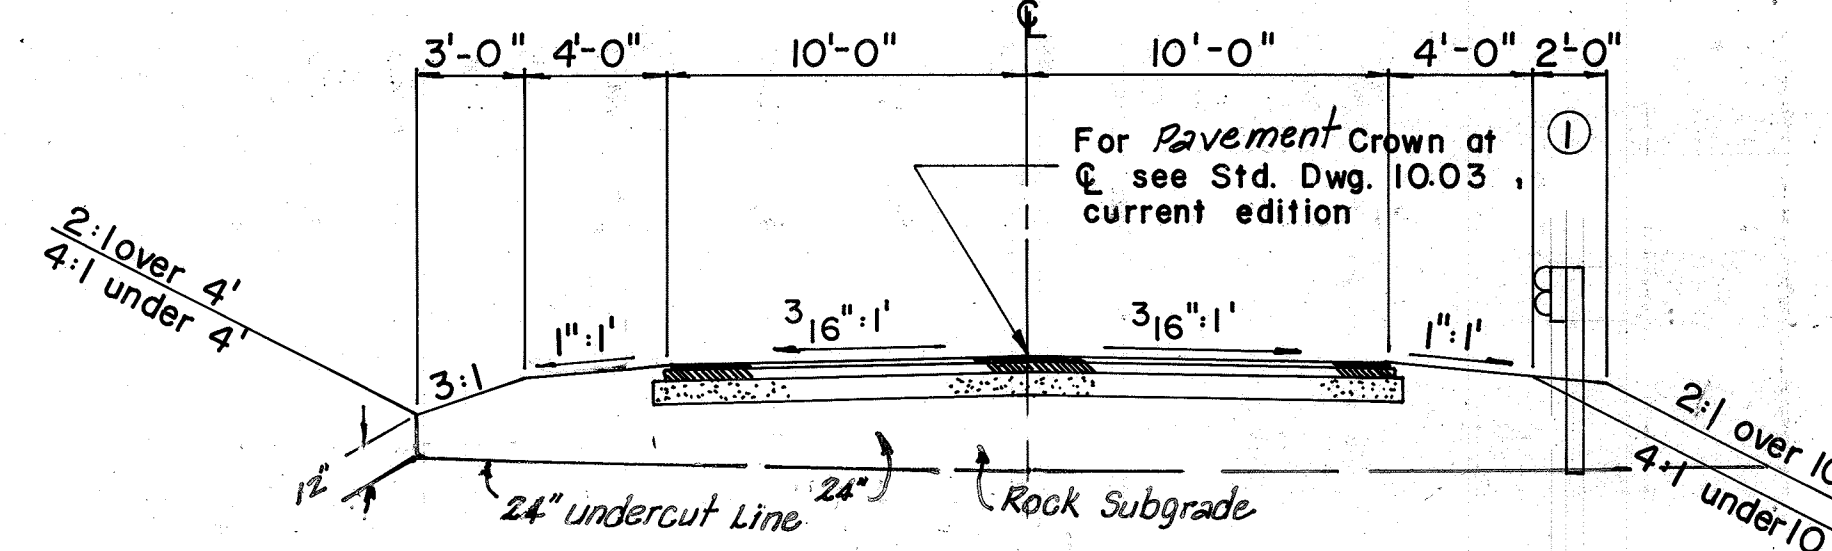

NORMAL SECTION

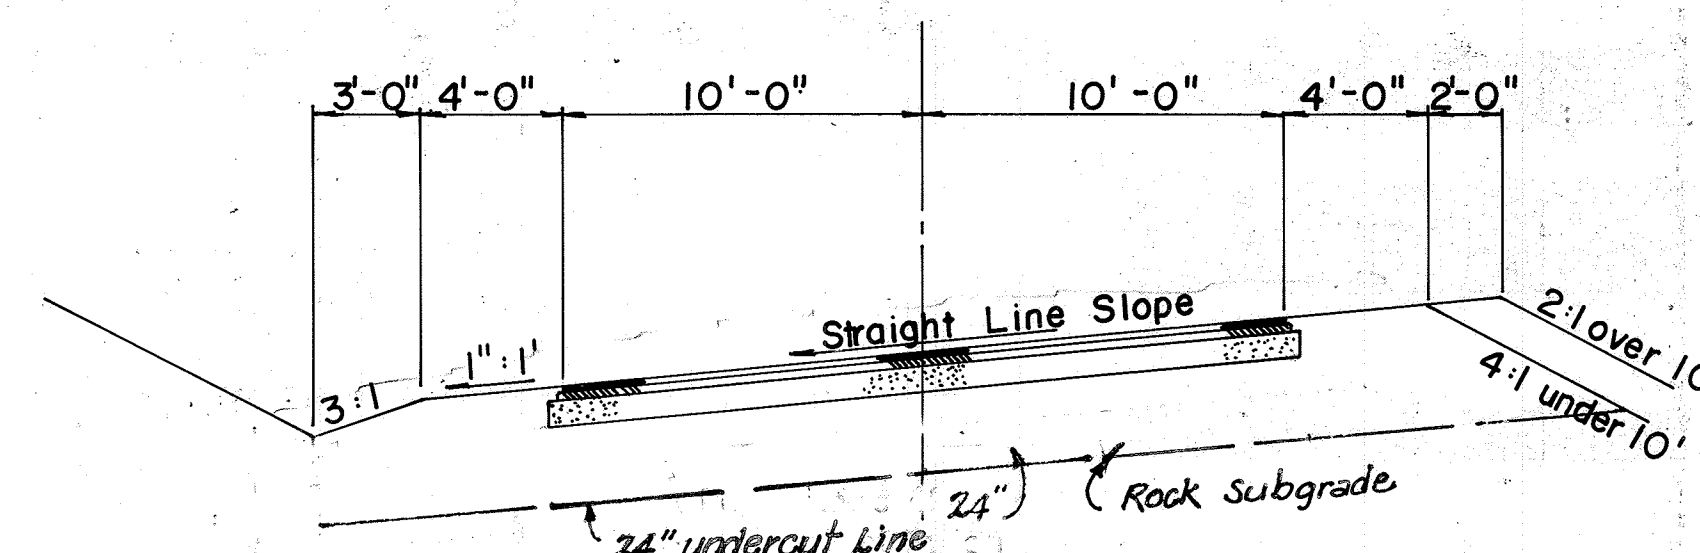


SUPERELEVATED SECTION

== USING


Note: The 24" undercut line as shown on typical sections shall govern over cross-sections.

① Shoulders shall be widened 2 feet where Steel Beam Guard Rail is to be installed.
See Cross-Sections for Slopes outside the limits of the Shoulder.

CHAPEZE LANE (LT. STA. 73+10)
COUNTY ROAD APPROACH (RT. STA. 43+75)

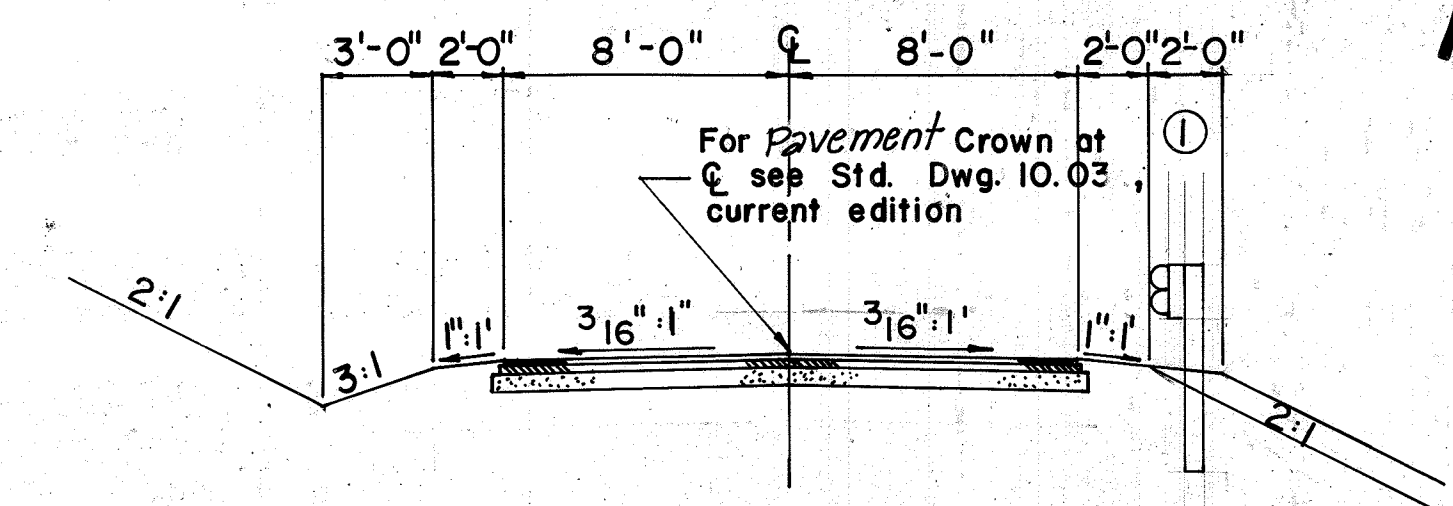

NORMAL SECTION

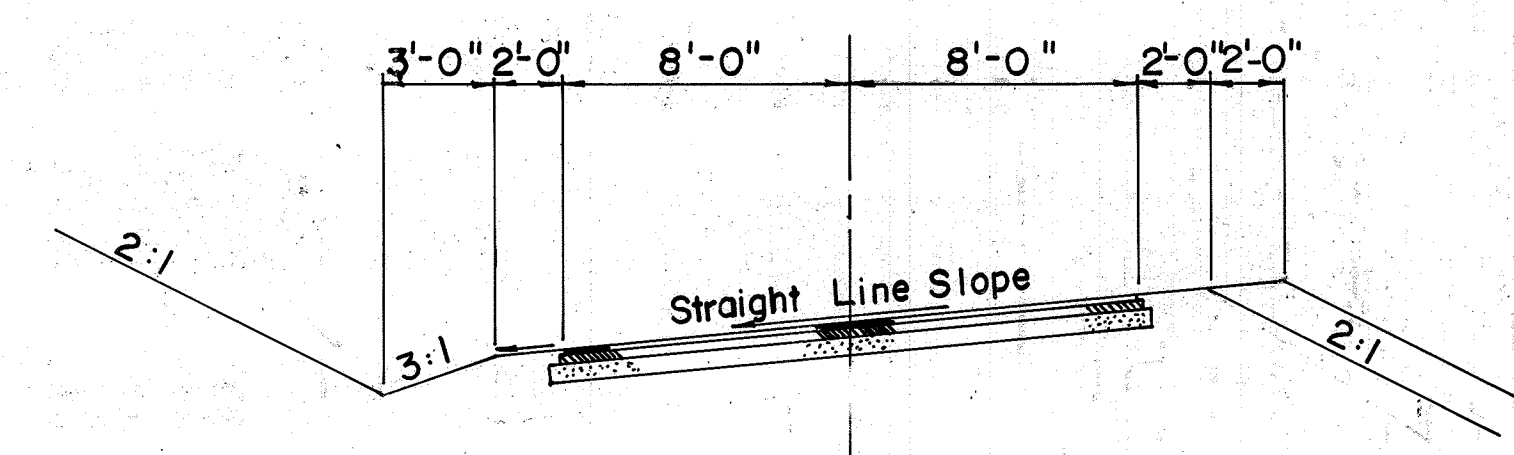

SUPERELEVATED SECTION

== USING

APPROXIMATELY 9" BASE..... 6" Compacted Depth Dense Graded Aggregate Base
3" + Class I Base - [Compacted Bituminous Concrete Base]

TACK COAT..... 0.10 Gal. per sq. yd (Apply as directed by the Engineer.)


APPROXIMATELY 1" CLASS "I" SURFACE..... 1" + Compacted Depth Bituminous Concrete Surface, Class I (Type 'A')

TYPICAL SECTIONS


COUNTY FARM APPROACH (RT. STA. 16+40)

RESTAURANT ENTR. (RT. STA. 28+50)

NORMAL SECTION

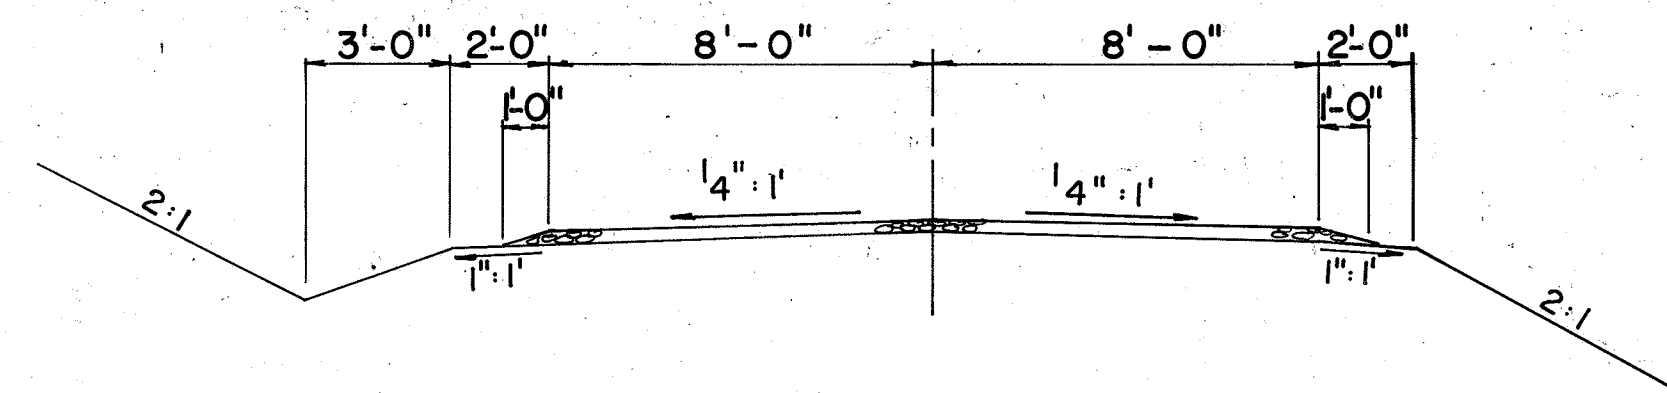

SUPERELEVATED SECTION

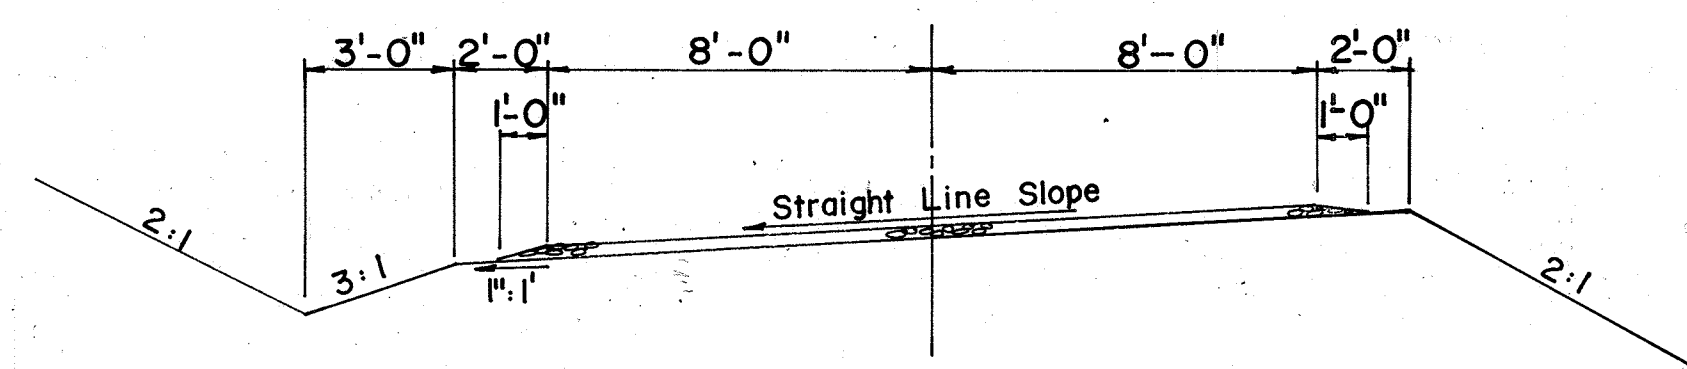

NEW CONSTRUCTION: Grade, Drain & Traffic Bound Base

USING

Crushed Limestone Size No. 610 applied loose equal to 2" Compacted Depth


OR

① River Gravel Size No. 710 applied loose equal to 2" Compacted Depth


FRONTAGE ROAD NO. 1 (LT. STA. 21+50)
RELOCATED CO. ROAD (RT. STA. 21+50)
RESIDENTIAL AND PARK FIRE ENTRANCES ②
FIELD ENTRANCES AND ROAD APPR. (RT. STA. 162+00)

BITUMINOUS

TRAFFIC BOUND

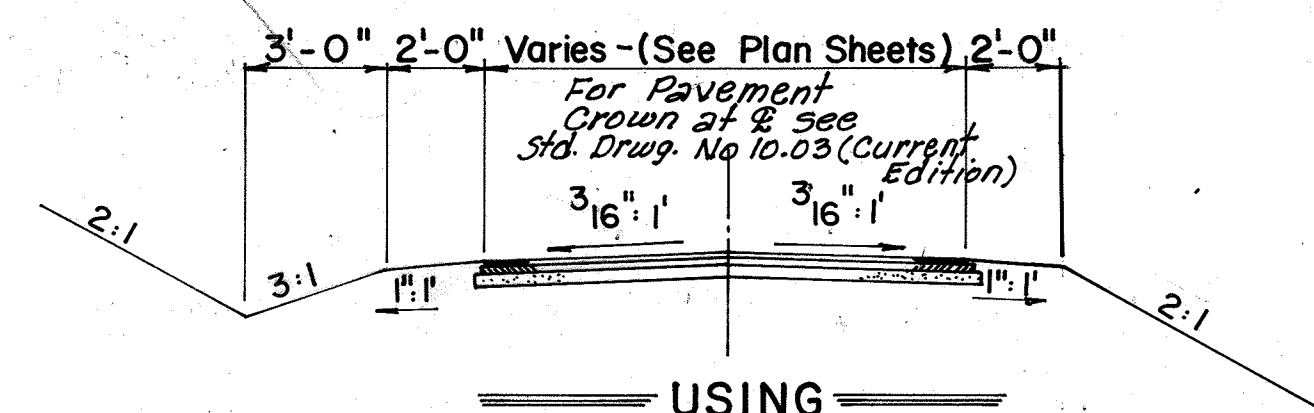

USING

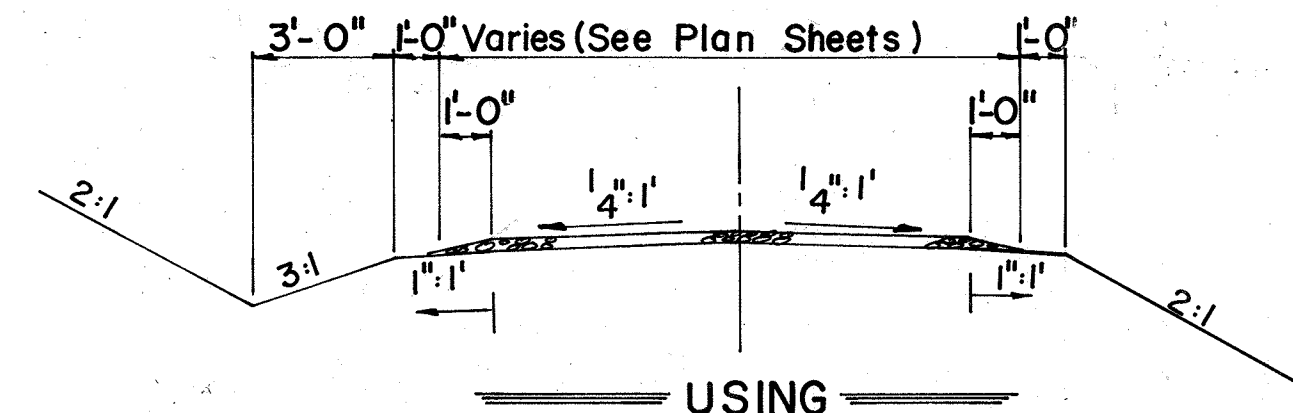

USING

Crushed Limestone Size No. 610 equal to 2" Compacted Depth

OR

① River Gravel Size No. 710 equal to 2" Compacted Depth

APPROXIMATELY 7" BASE 4" ± Compacted Depth Dense Graded Aggregate Base
3" ± Class I Base 3" ± Compacted Bituminous Concrete Base

TACK COAT 0.10 Gal. per sq. yd (Apply as directed by the Engineer)


APPROXIMATELY 1" SURFACE 1" ± Compacted Depth Bituminous Concrete Surface, Class "I" (Type "A")

MEDIAN DETAILS

(see Standard Drawing No. 14.11, Current edition)

TYPICAL


STA. 55+53- STA. 55+80
STA. 64+00- STA. 64+72
STA. 64+03- STA. 100+35
STA. 103+22- STA. 106+27

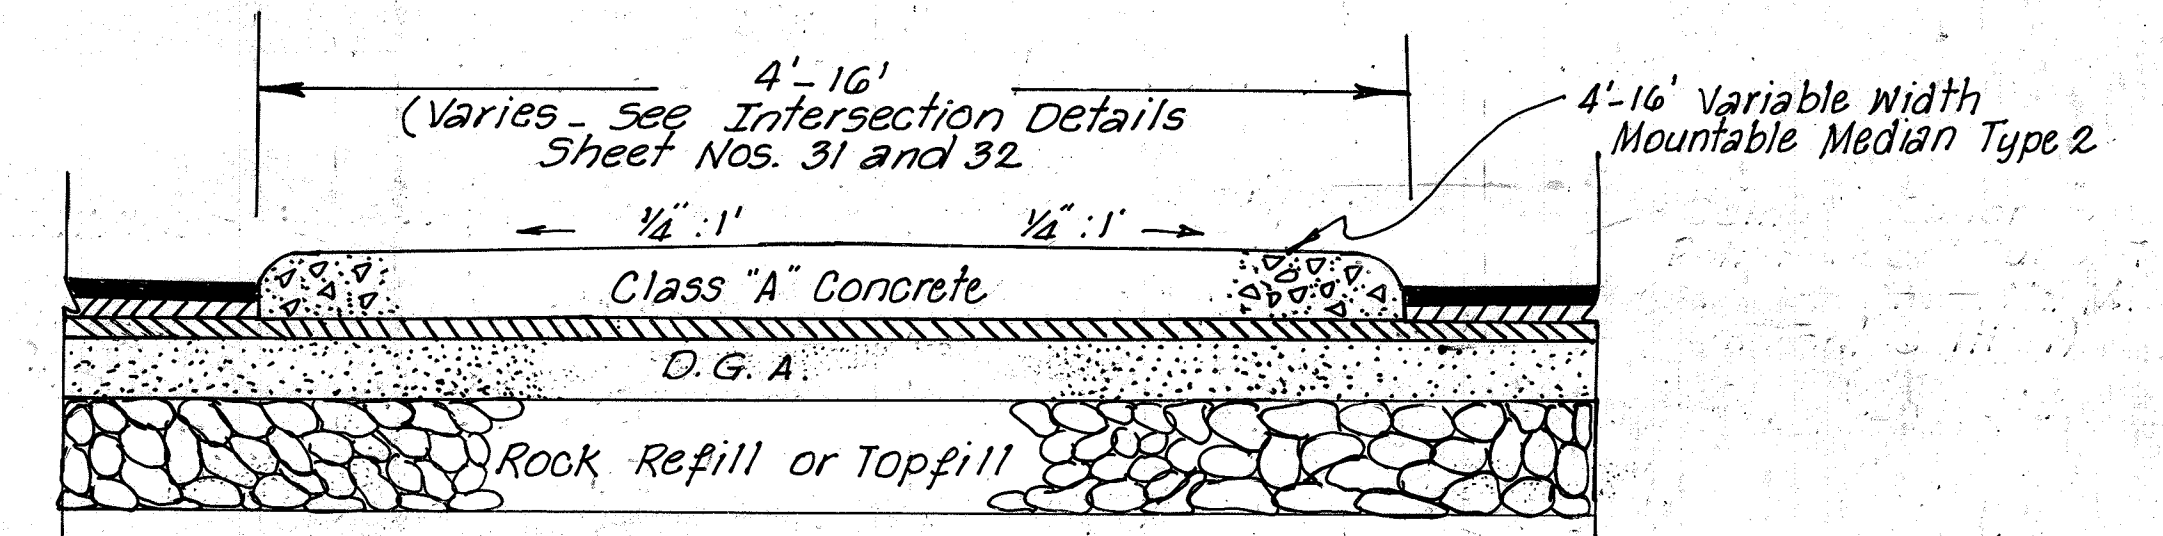

Note: Median as shown on Typical Sections shall govern over that shown on Cross-Sections.

TYPICAL

STA. 60+38- STA. 64+00
STA. 100+35- STA. 102+12

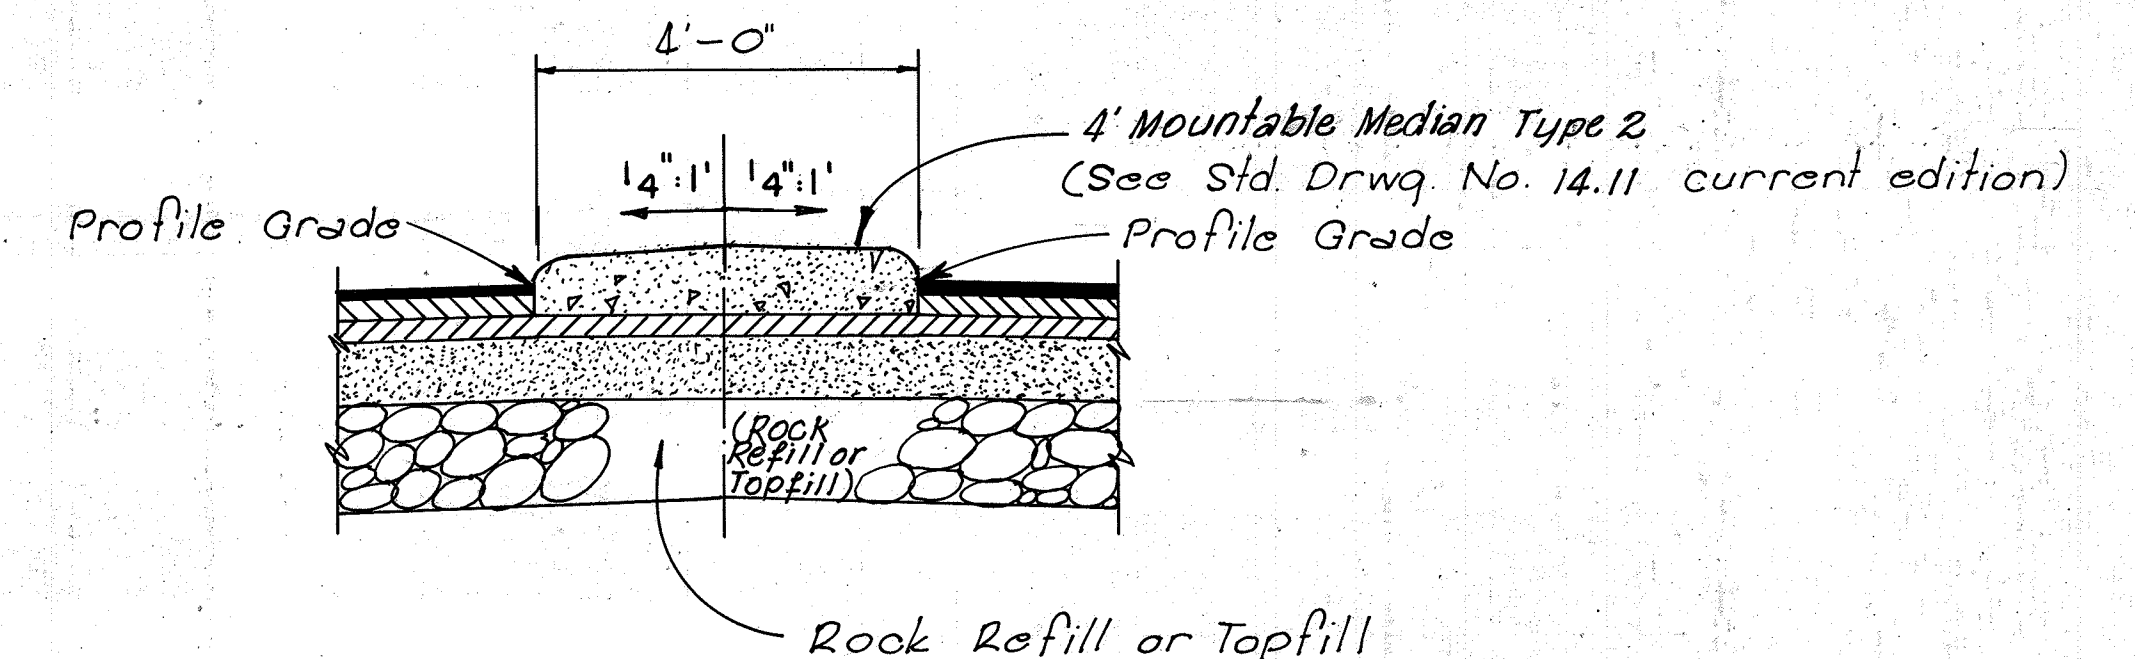

① River Gravel shall conform to Specification G12.4.2-B
River Gravel Maintenance Floater Course

② For Limits of Surfacing, See Std. Drwg. No. 14.03, Current Edition

See Cross-Sections for Slopes outside the limits of the Shoulder.