
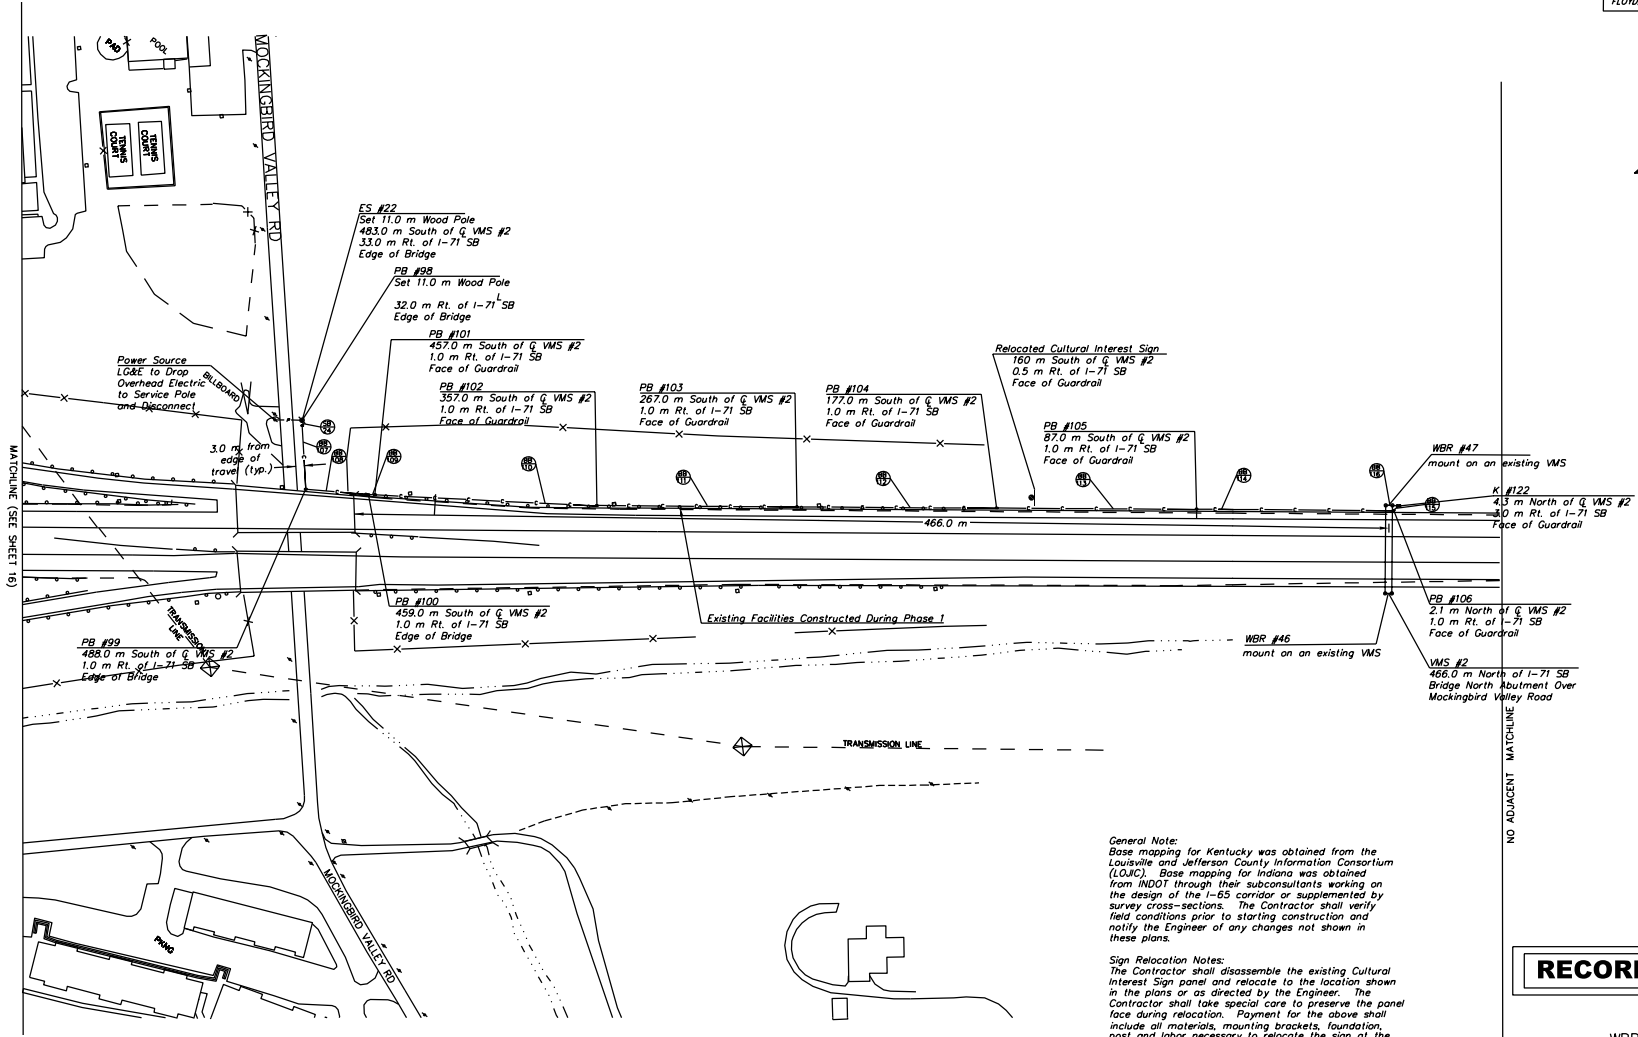



COUNTY OF	FISCAL YEAR	SHEET NO.	TOTAL SHEETS
JEFF. CO. KY CLARK CO. IN FLOYD, IN	1999	17	74

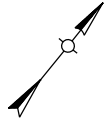

General Note:
Base mapping for Kentucky was obtained from the Louisville and Jefferson County Information Consortium (LJIC). Base mapping for Indiana was obtained from INDOT through their subconsultants working on the design of the I-65 corridor or supplemented by survey cross-sections. The Contractor shall verify field conditions prior to starting construction and notify the Engineer of any changes not shown in these plans.

Sign Relocation Notes:
The Contractor shall disassemble the existing Cultural Interest Sign panel and relocate to the location shown in the plans or as directed by the Engineer. The Contractor shall take special care to preserve the panel face during relocation. Payment for the above shall include all materials, mounting brackets, foundation, post and labor necessary to relocate the sign at the unit bid proceed. This is a non-participating item.

RECORD DRAWING

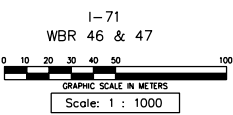

NO.	REVISIONS	BY	DATE
1	Record Drawing (Increment 1)		5/31/00

DATE: _____
CHECKED BY: _____
APPROVED BY: _____
SCALE: 1:1000
DATE: AUGUST 1999
DRAWING NAME: KYA4017D

TRW
08/1999
KYA4017D