


COUNTY OF	FISCAL YEAR	SHEET NO.	TOTAL SHEETS
JEFF. KY. CLARK, IN FLOYD, IN	1999	14	74

PREPARED BY: _____ DATE: _____
 CHECKED BY: _____ DATE: _____
 DRAWING NAME: KYA4017A


SCALE: 1"=1000'
 DATE: AUGUST, 1999
 DRAWING NAME: KYA4017A

081099
 KYA4017A

General Note:
 Base mapping for Kentucky was obtained from the
 Louisville and Jefferson County Information Consortium
 (LJIC). Base mapping for Indiana was obtained
 from INDOT through their subconsultants working on
 the design of the I-65 corridor or supplemented by
 survey cross-sections. The Contractor shall verify
 field conditions prior to starting construction and
 notify the Engineer of any changes not shown in
 these plans.

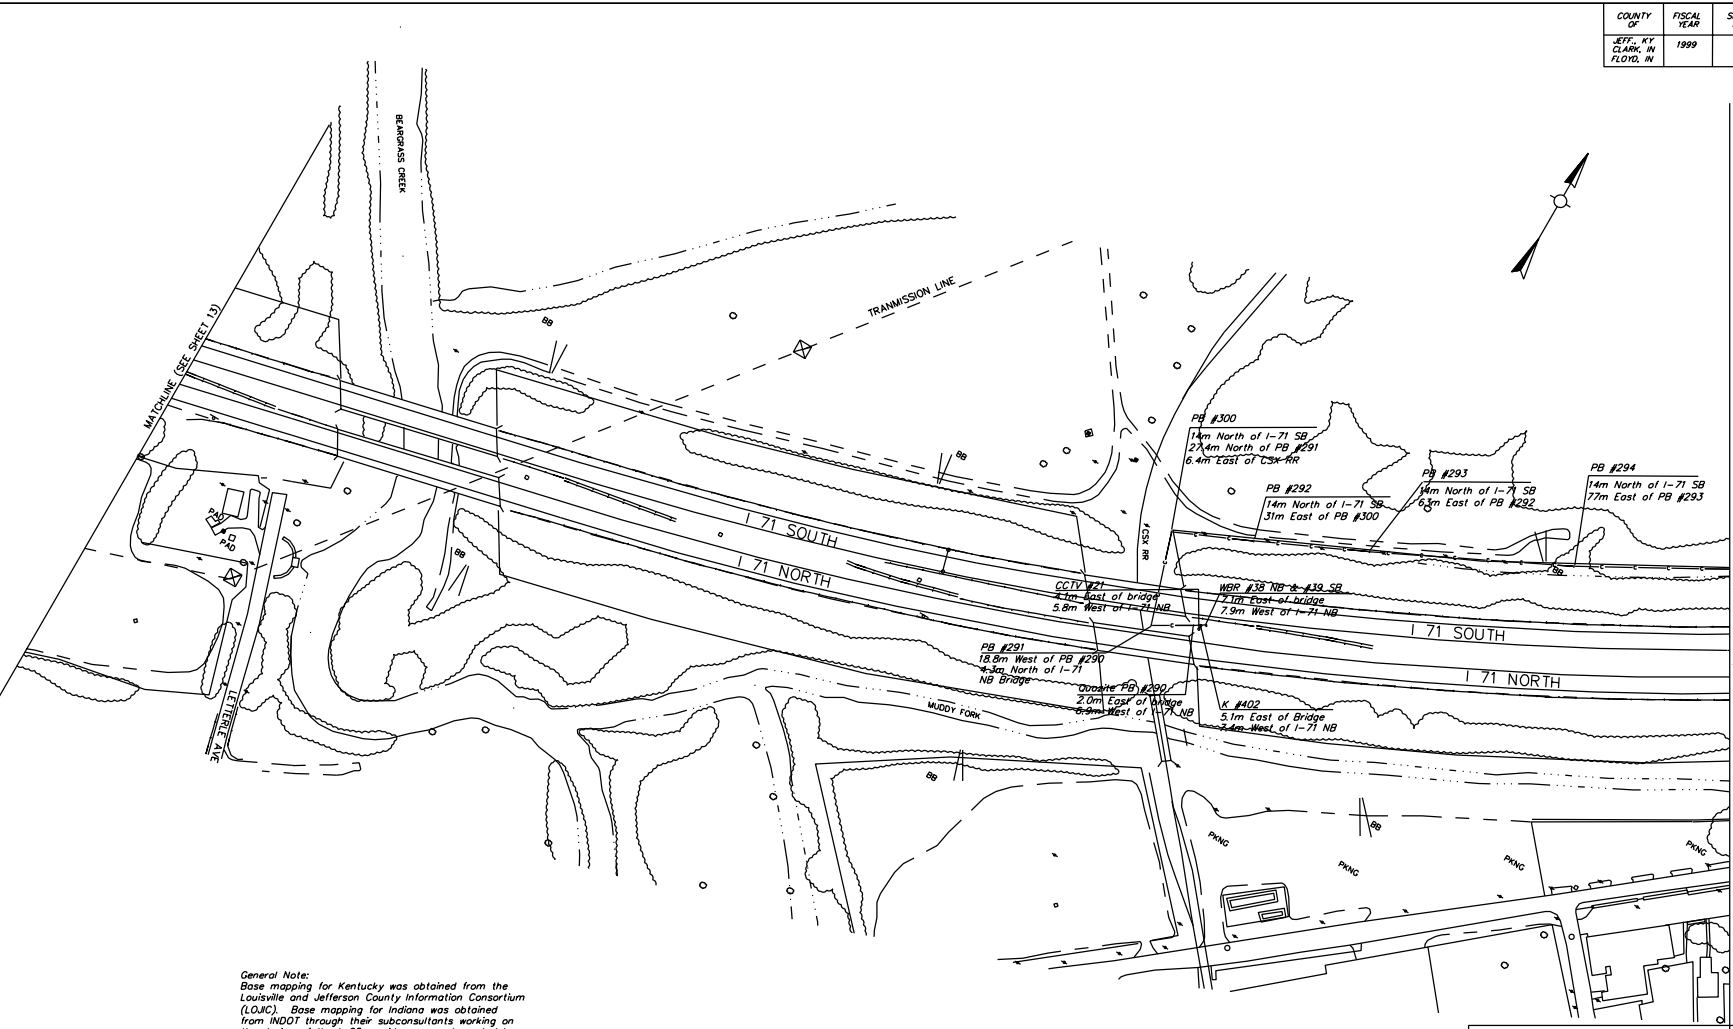

RECORD DRAWING

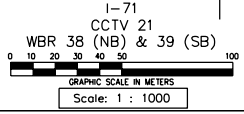

NO.	REVISIONS	BY	DATE
1	Record Drawing (Increment 1)		5/31/00

MATCHLINE (SEE SHEET 15)

MATCHLINE (SEE SHEET 13)