


COUNTY OF	ITEM NO.	SHEET NO.
JEFFERSON		178031

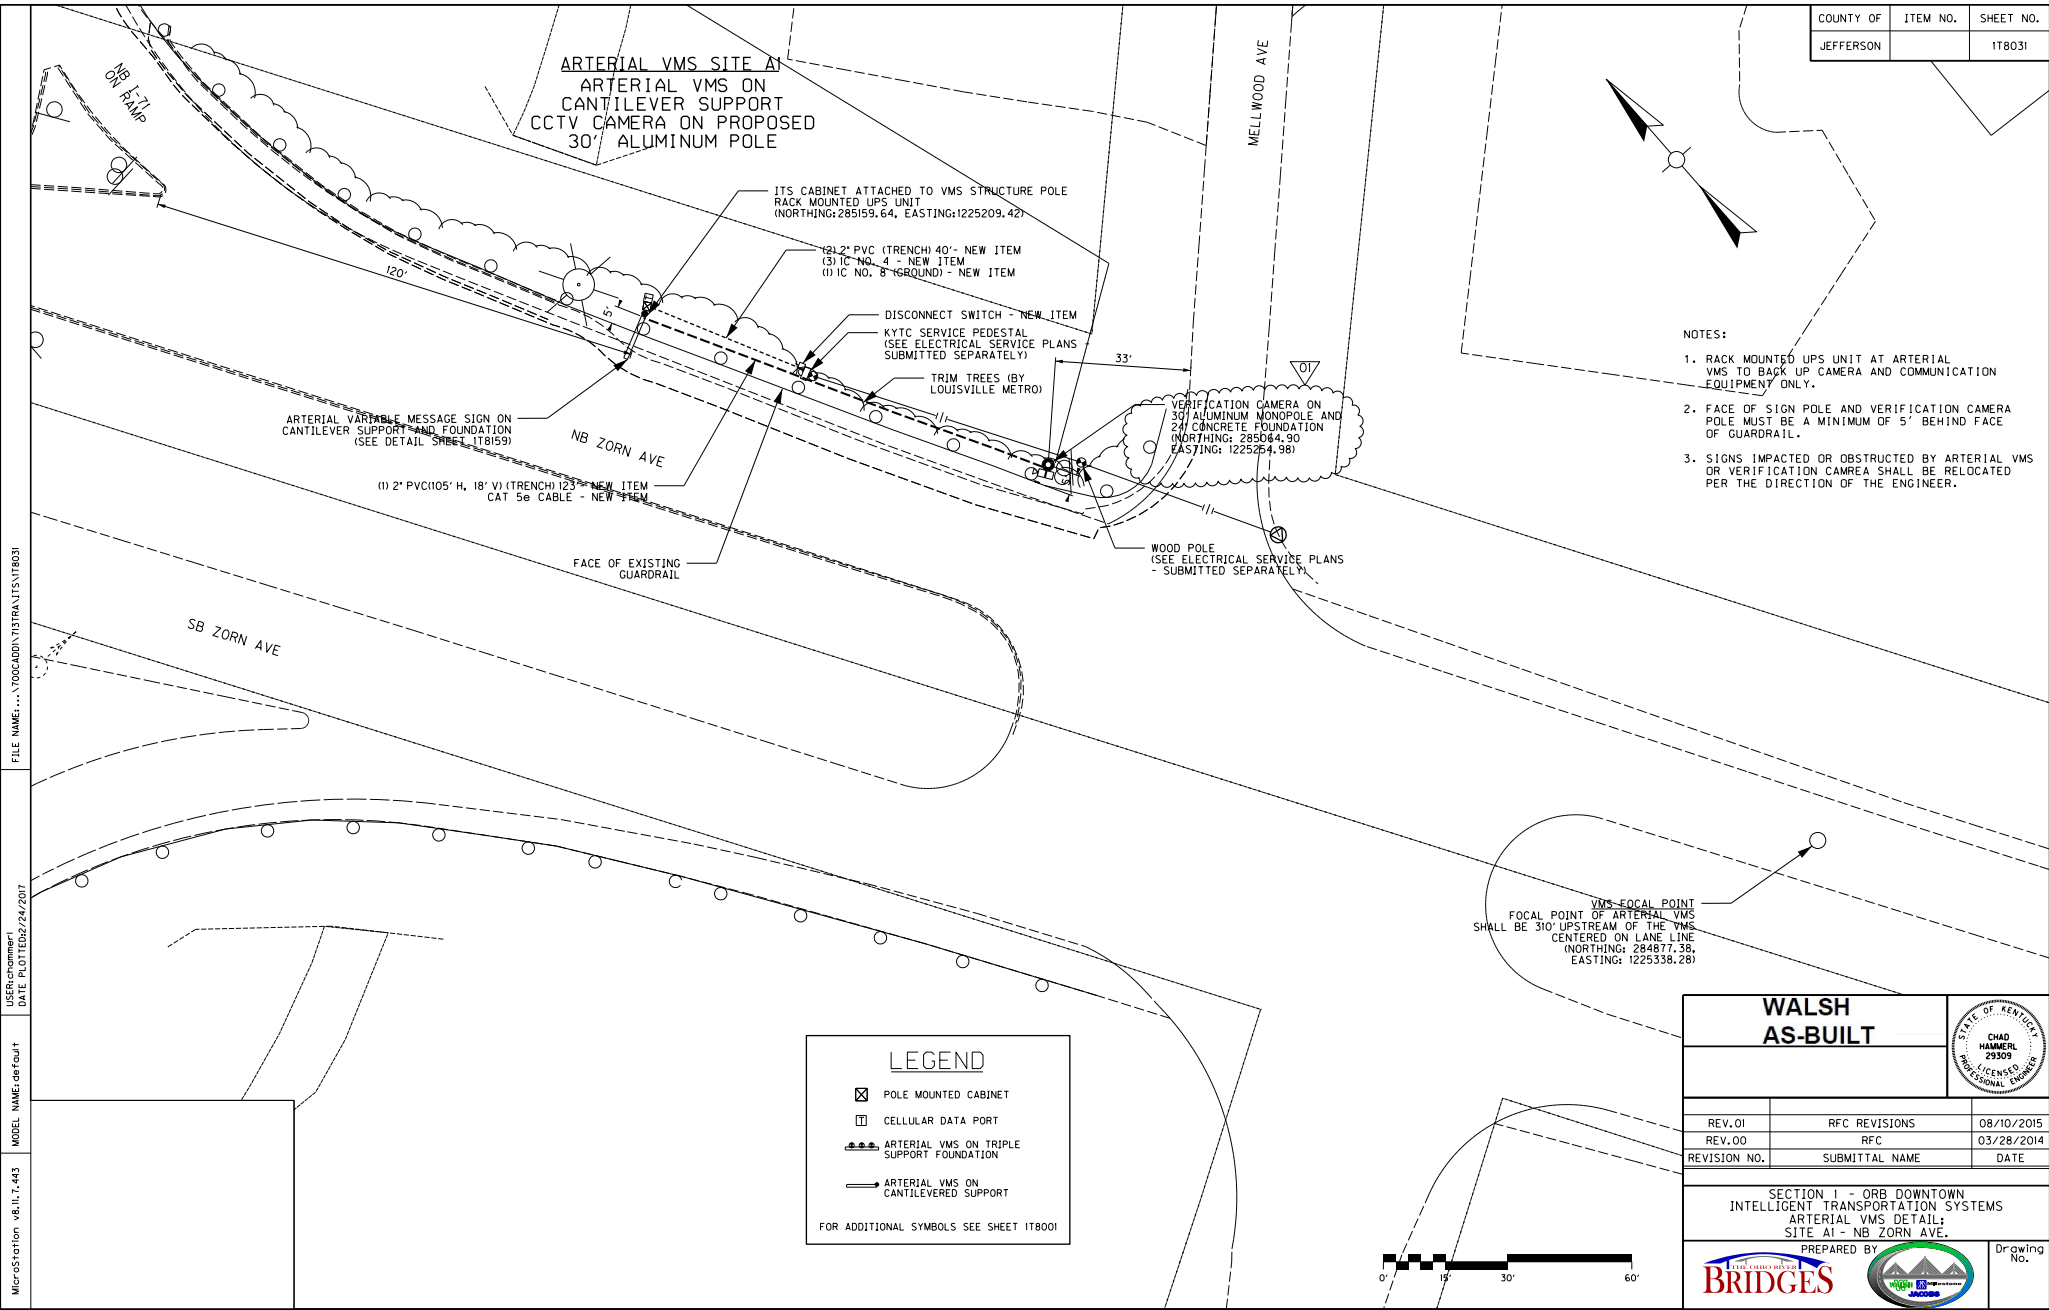

- NOTES:
1. RACK MOUNTED UPS UNIT AT ARTERIAL VMS TO BACK UP CAMERA AND COMMUNICATION EQUIPMENT ONLY.
 2. FACE OF SIGN POLE AND VERIFICATION CAMERA POLE MUST BE A MINIMUM OF 5' BEHIND FACE OF GUARDRAIL.
 3. SIGNS IMPACTED OR OBSTRUCTED BY ARTERIAL VMS OR VERIFICATION CAMERA SHALL BE RELOCATED PER THE DIRECTION OF THE ENGINEER.

LEGEND

- ☒ POLE MOUNTED CABINET
- CELLULAR DATA PORT
- ⋯ ARTERIAL VMS ON TRIPLE SUPPORT FOUNDATION
- ARTERIAL VMS ON CANTILEVERED SUPPORT

FOR ADDITIONAL SYMBOLS SEE SHEET 178001

WALSH AS-BUILT			
REV.01	RFC REVISIONS	08/10/2015	
REV.00	RFC	03/28/2014	
REVISION NO.	SUBMITTAL NAME	DATE	

SECTION 1 - ORB DOWNTOWN
 INTELLIGENT TRANSPORTATION SYSTEMS
 ARTERIAL VMS DETAIL:
 SITE A1 - NB ZORN AVE.

PREPARED BY

Drawing No.

FILE NAME: ... \700CADD\1718A\1718031
 USER: chhammer1
 DATE PLOTTED: 2/24/2017
 MODEL NAME: default
 MicroStation v8.i1.7.443