


COUNTY OF	FISCAL YEAR	SHEET NO.	TOTAL SHEETS
JEFF., KY CLARK, IN	1997	23B	107

TRW
R:\03701\devel\plan\kyaa017b.dwg
Oct 12, 1999

SCALE: 1:1000	PREPARED BY
DATE: AUGUST, 1999	CHECKED BY
DRAWING NAME: KYAA017B	APPROVED BY

MATCHLINE (SEE SHEET 23A)

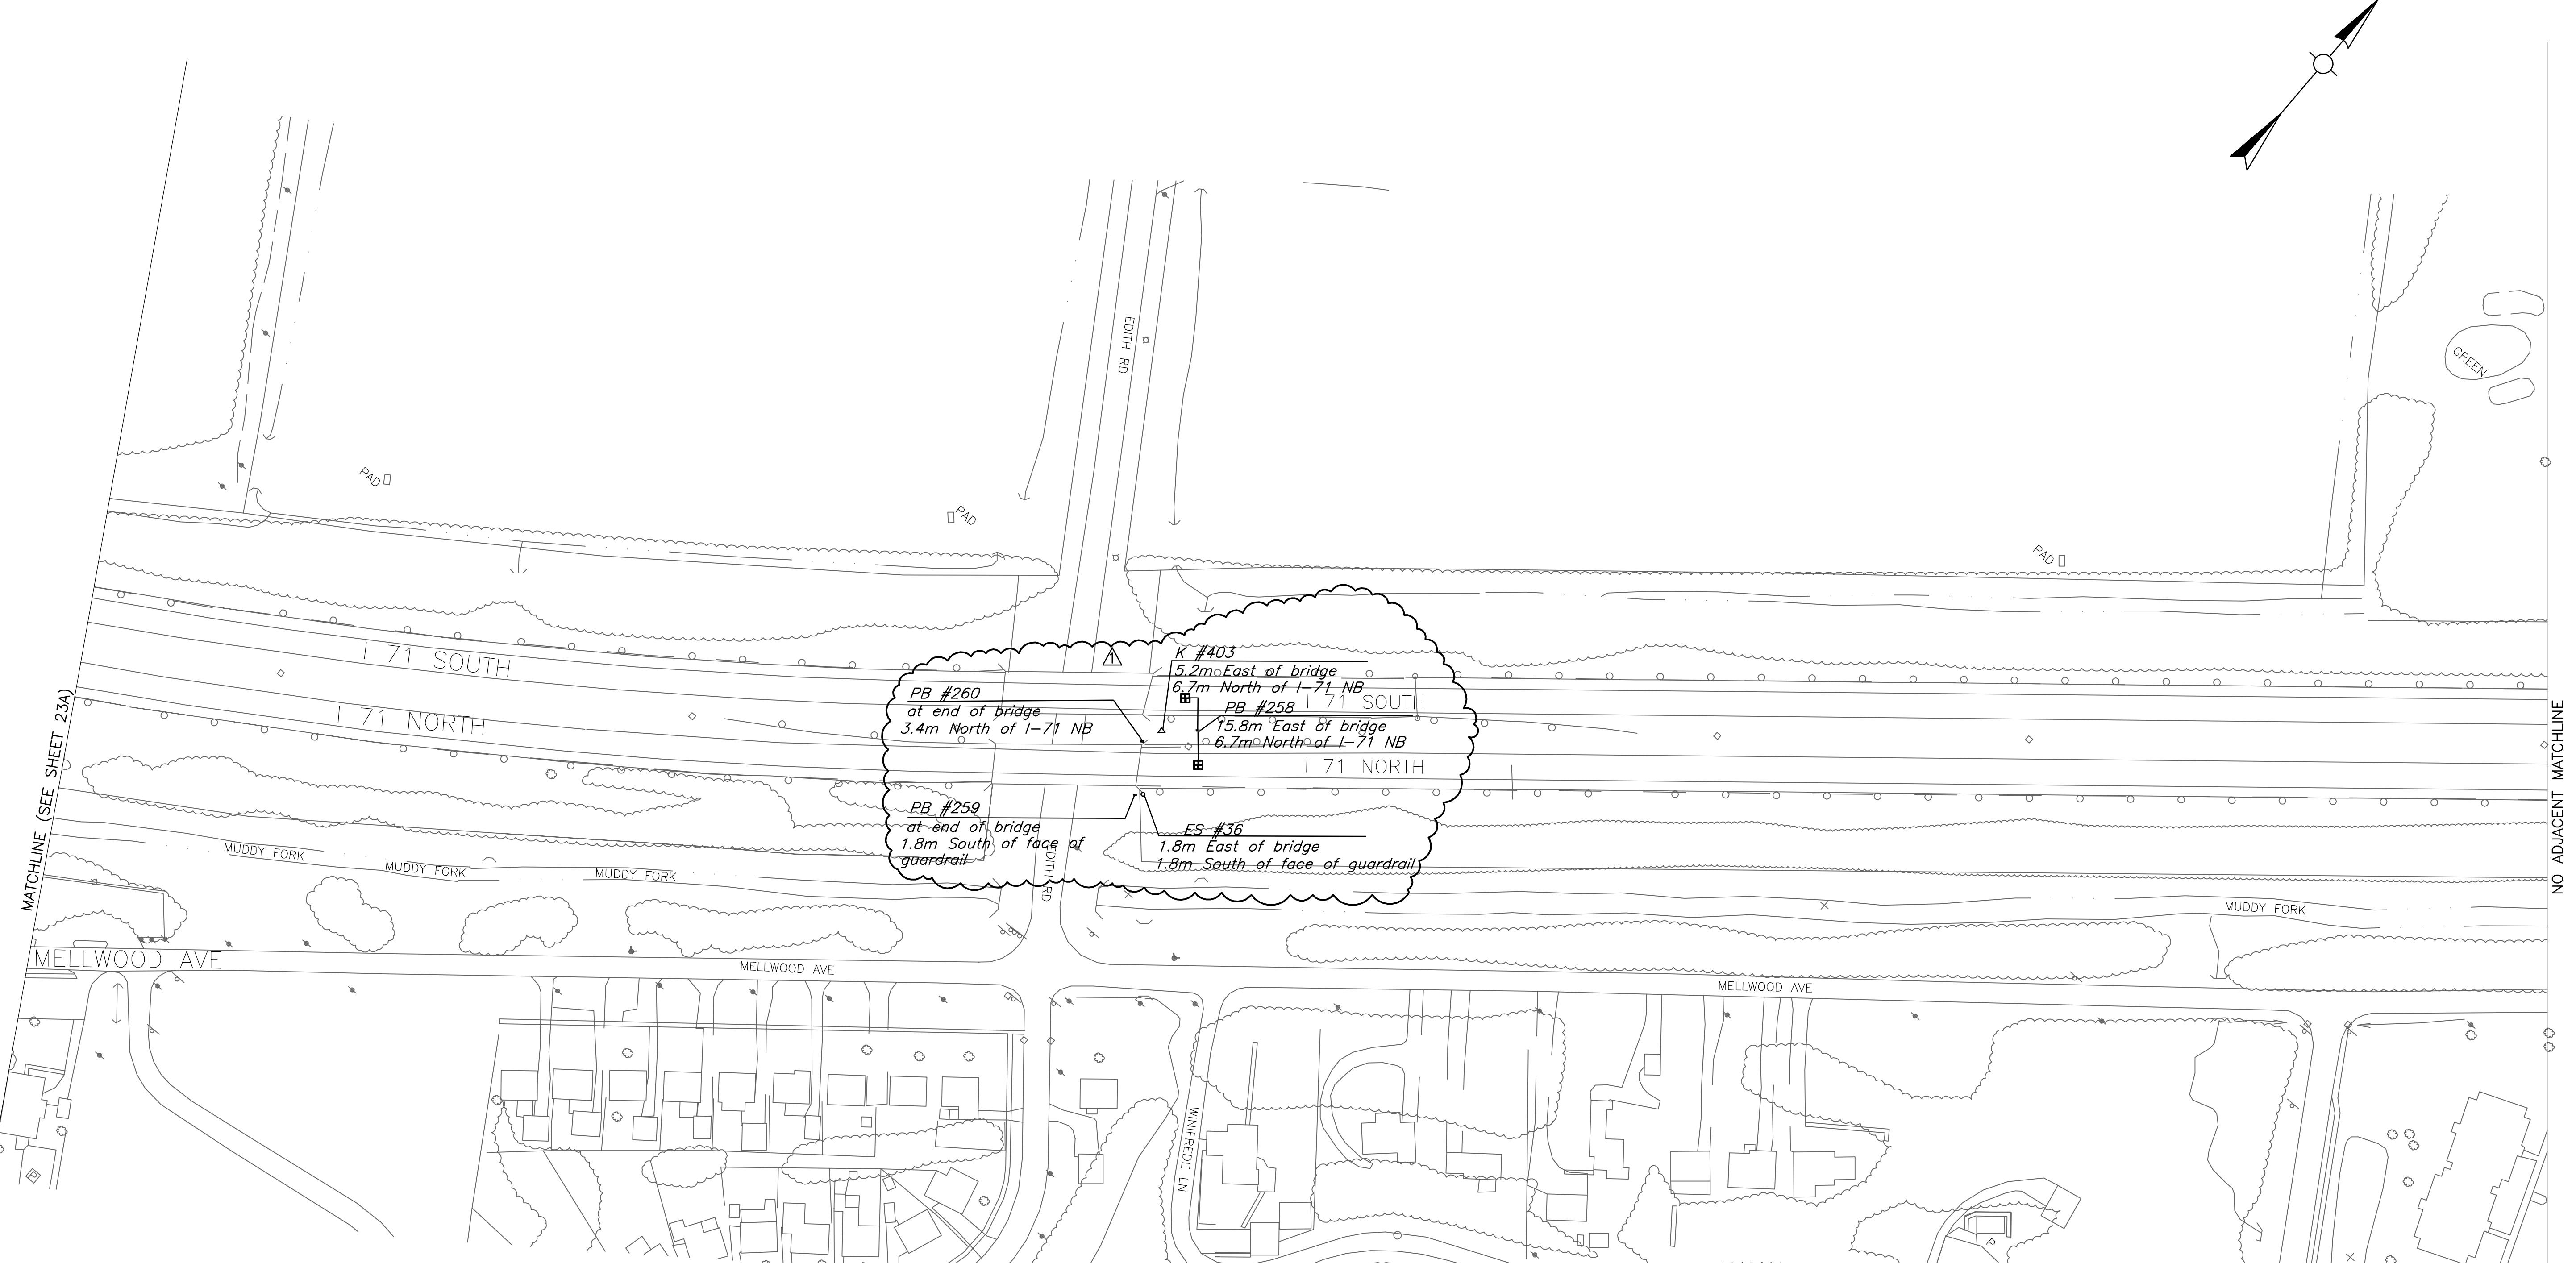

General Note:
Base mapping for Kentucky was obtained from the Louisville and Jefferson County Information Consortium (LOJIC). Base mapping for Indiana was obtained from INDOT through their subconsultants working on the design of the I-65 corridor or supplemented by survey cross-sections. The Contractor shall verify field conditions prior to starting construction and notify the Engineer of any changes not shown in these plans.

RECORD DRAWING

I-64
VCD/LD 470 & 471

0 10 20 30 40 50 100

GRAPHIC SCALE IN METERS

Scale: 1 : 1000

REVISIONS	BY	DATE
Record Drawing (Increment 1)		9/28/99