


PLAN
0 20 40 FT.

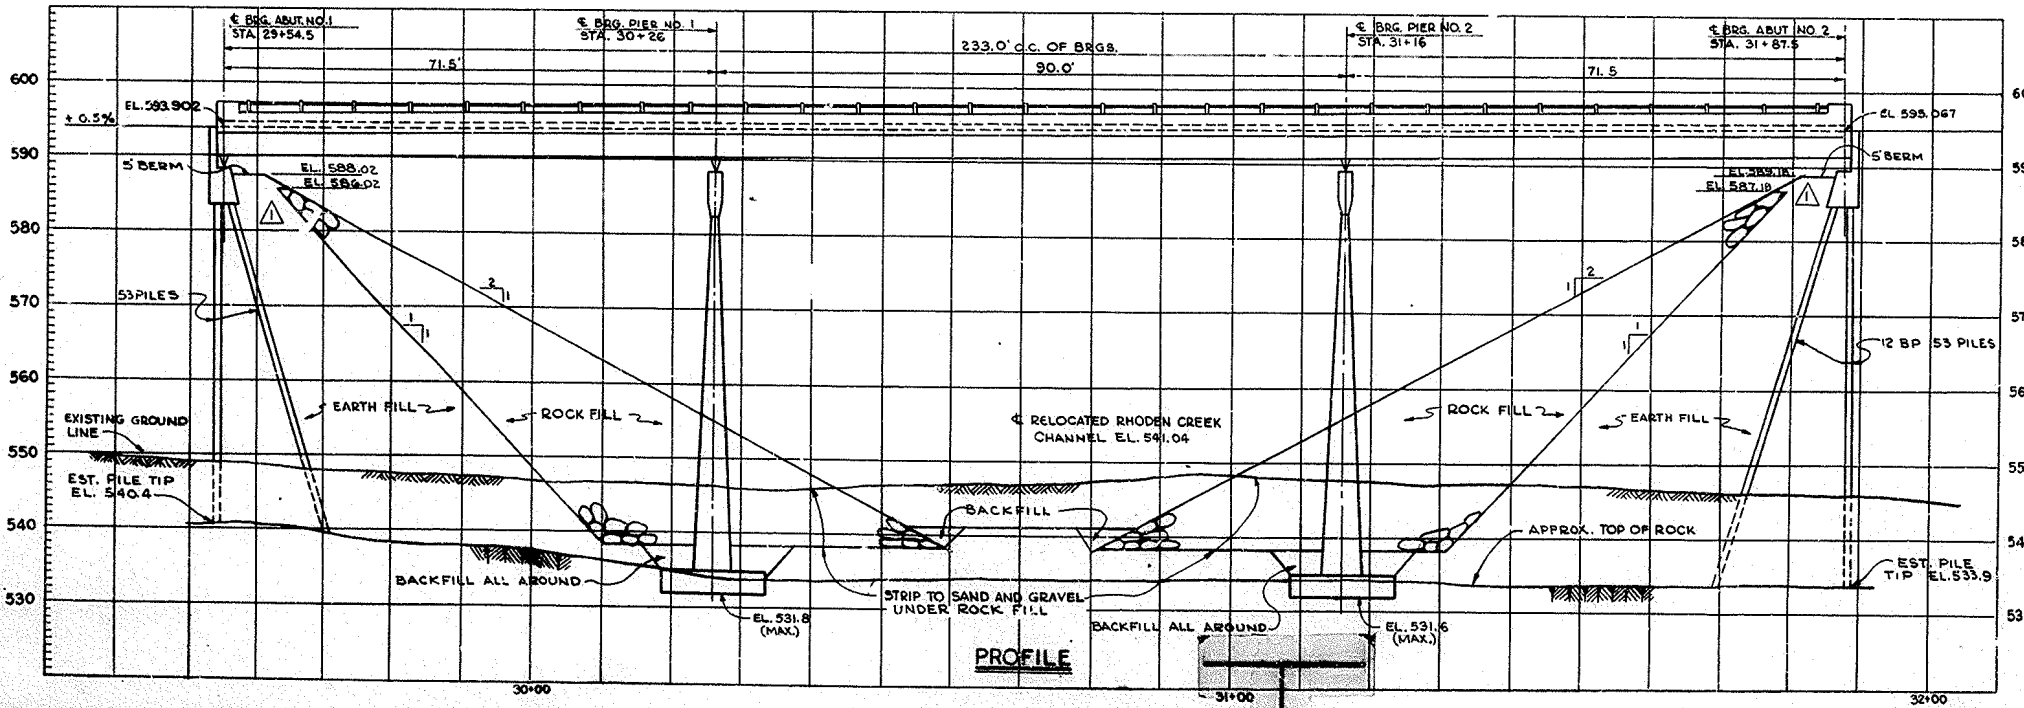

PROFILE

- NOTES:
 1. CONICAL TRANSITION FOR ROCK, PYRAMIDAL FOR EARTH.
 2. FLARE SHOULDERS IN 50'
 3. BORING SHOWN THUS: @, FOR BORING LOGS - SEE SHTS. 7, 8, 9, 10 & 11

ALLEN Co. Drawing No. 17552 SHEET 1 OF 6

REVISION	DATE	DESCRIPTION	BY
1	13 JULY 62	ELEVATION CHANGED, ELEVATIONS ADDED, NOTES ADDED (AMDT. 7 & 8 DTD. 12 7 IN JUNE 1962)	G.C.B.


U.S. ARMY ENGINEER DISTRICT, LOUISVILLE
 CORPS OF ENGINEERS
 LOUISVILLE, KENTUCKY

OHIO RIVER BASIN
 BARREN RIVER RESERVOIR
 SITE NO. 2 - RELOCATION STATE HWY. NO. 98


RHODEN CREEK BRIDGE
 PLAN & PROFILE

DESIGNED BY: W.E.R.
 DRAWN BY: W.E.R.
 TRACED BY: M.O.R.
 CHECKED BY: S.F.F.
 SUBMITTED BY: *[Signature]*
 APPROVED BY: *[Signature]*
 COL. CORPS OF ENGINEERS DISTRICT ENGINEER


RECORD DRAWING - AS BUILT

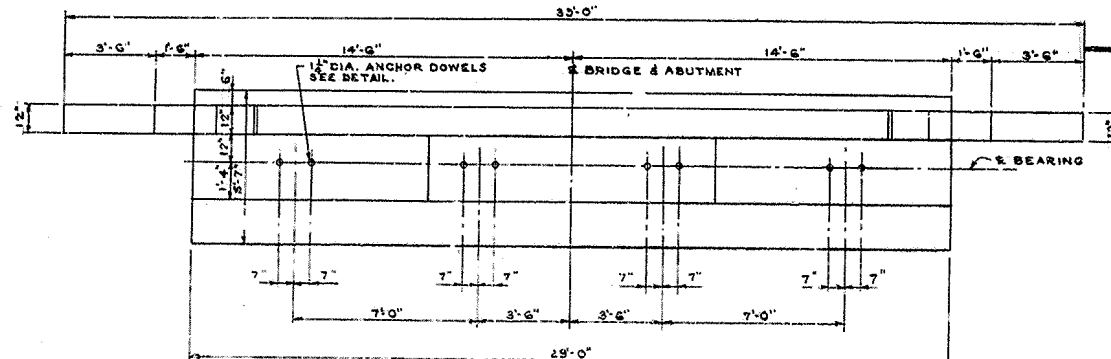


PLAN OF CAP

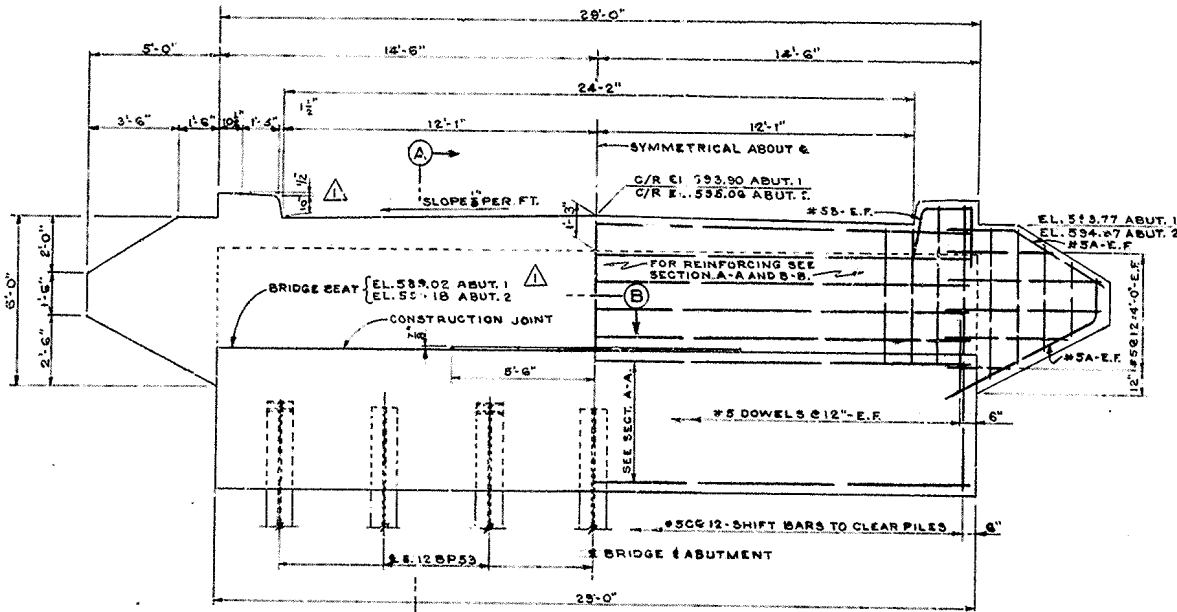


ELEVATION

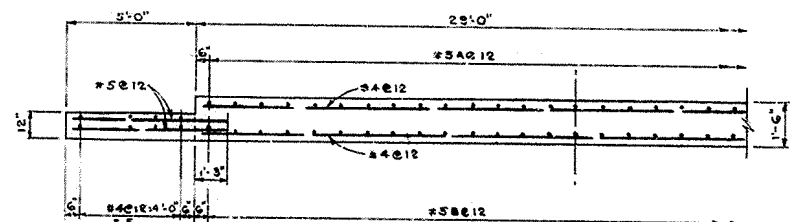


SECTION B-B

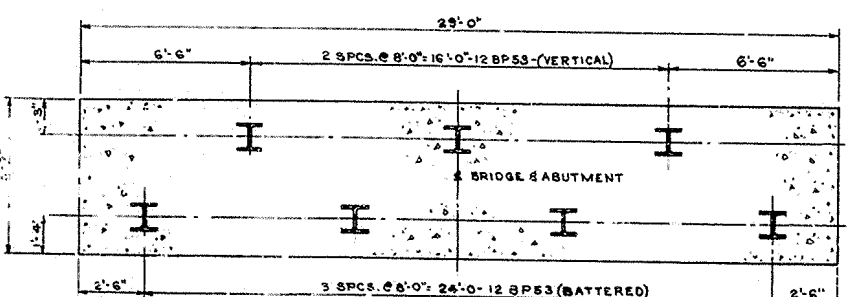


PLAN OF PILES

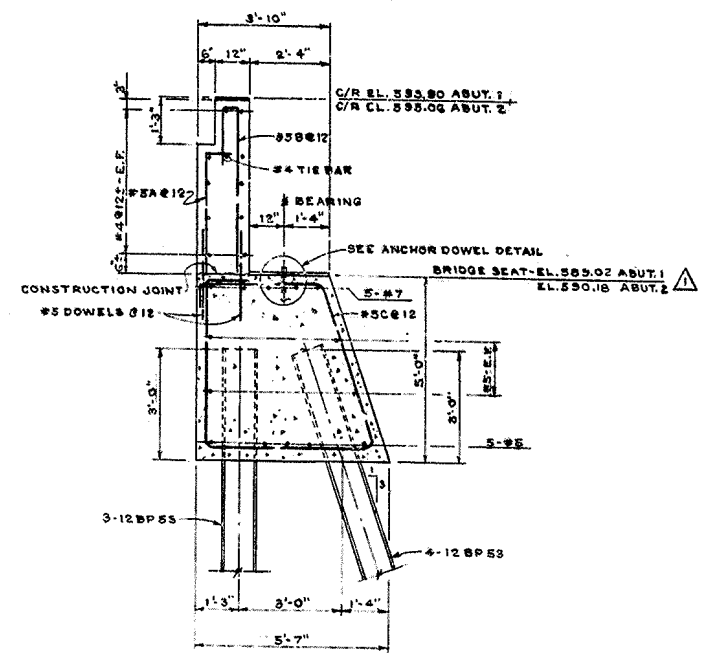


SECTION A-A

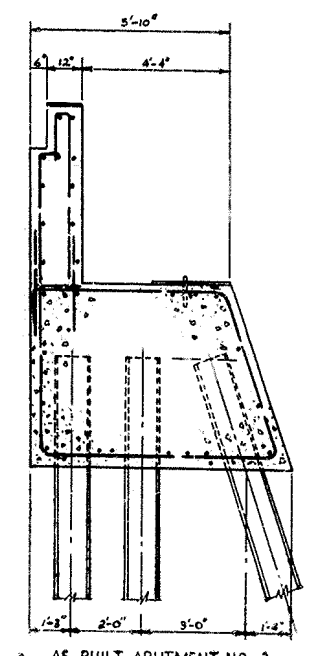

AS BUILT ABUTMENT NO. 2

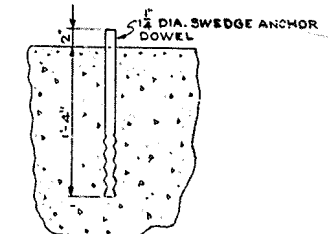

ANCHOR DOWEL DETAIL

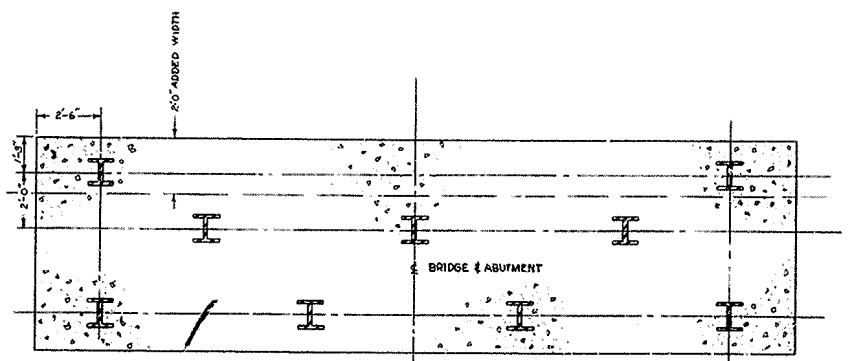

AS BUILT ABUTMENT NO. 2

- NOTES:
1. FOR REINFORCING NOTES & BAR BENDING SCHEDULE SEE SH. 13
 2. FOR GENERAL NOTES SEE SH. 13.

PLAN AND SECTION OF ABUTMENT NO. 2 ADDED ALLEN Co. DRAWING 17552 SHEET 2






REVISION	DATE	DESCRIPTION	BY
1	3 JULY 62	CHG. NO. CHANGES, ELEV. CHANGED, DIMENSIONS ADDED (NOT. 1, 10, 11, 12, 13) G.C.B.	

DESIGNED BY: R. T. T.
 DRAWN BY: E. R. S.
 TRACED BY: E. R. S.
 CHECKED BY: S.F.F.
 SUBMITTED: [Signature]
 DATE: [Signature]


U.S. ARMY ENGINEER DISTRICT, LOUISVILLE
 CORPS OF ENGINEERS
 LOUISVILLE, KENTUCKY

OHIO RIVER BASIN
 BARREN RIVER RESERVOIR
 SITE NO. 2 - RELOCATION STATE HWY. NO. 98


RHODEN CREEK BRIDGE
 ABUTMENTS

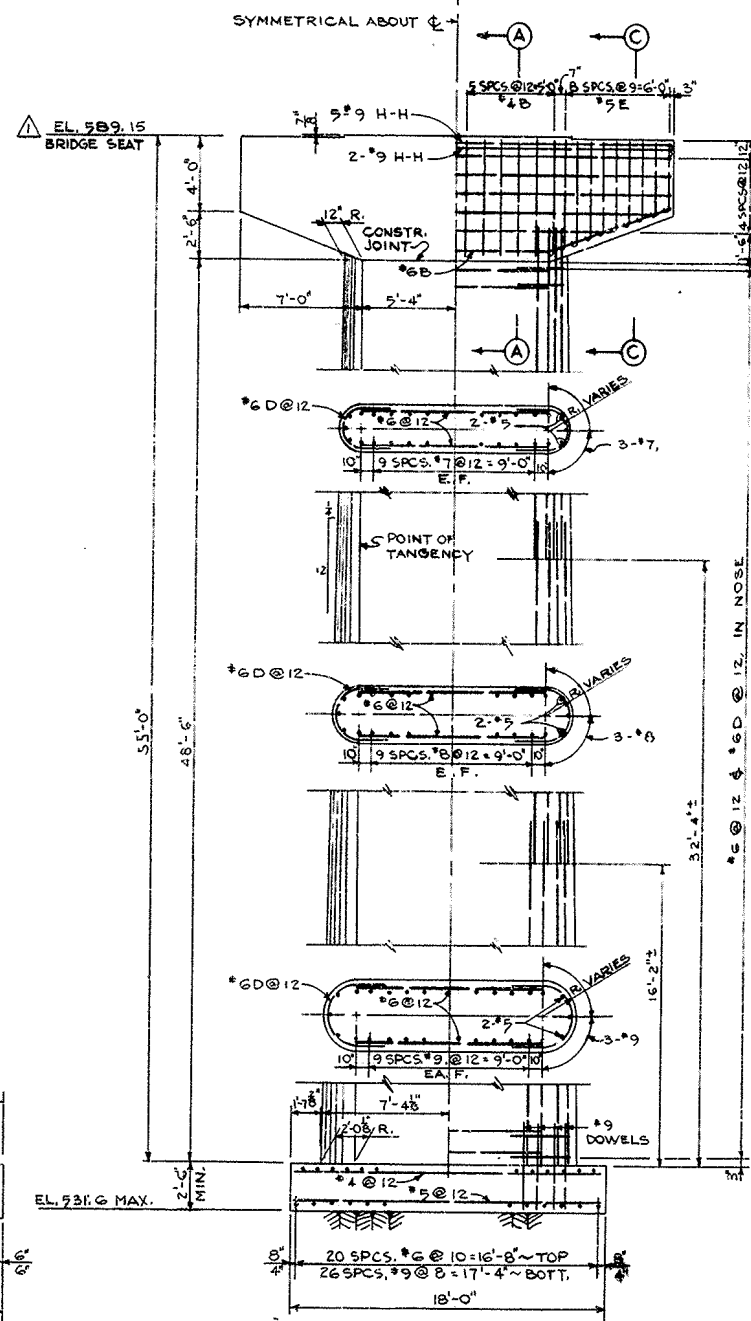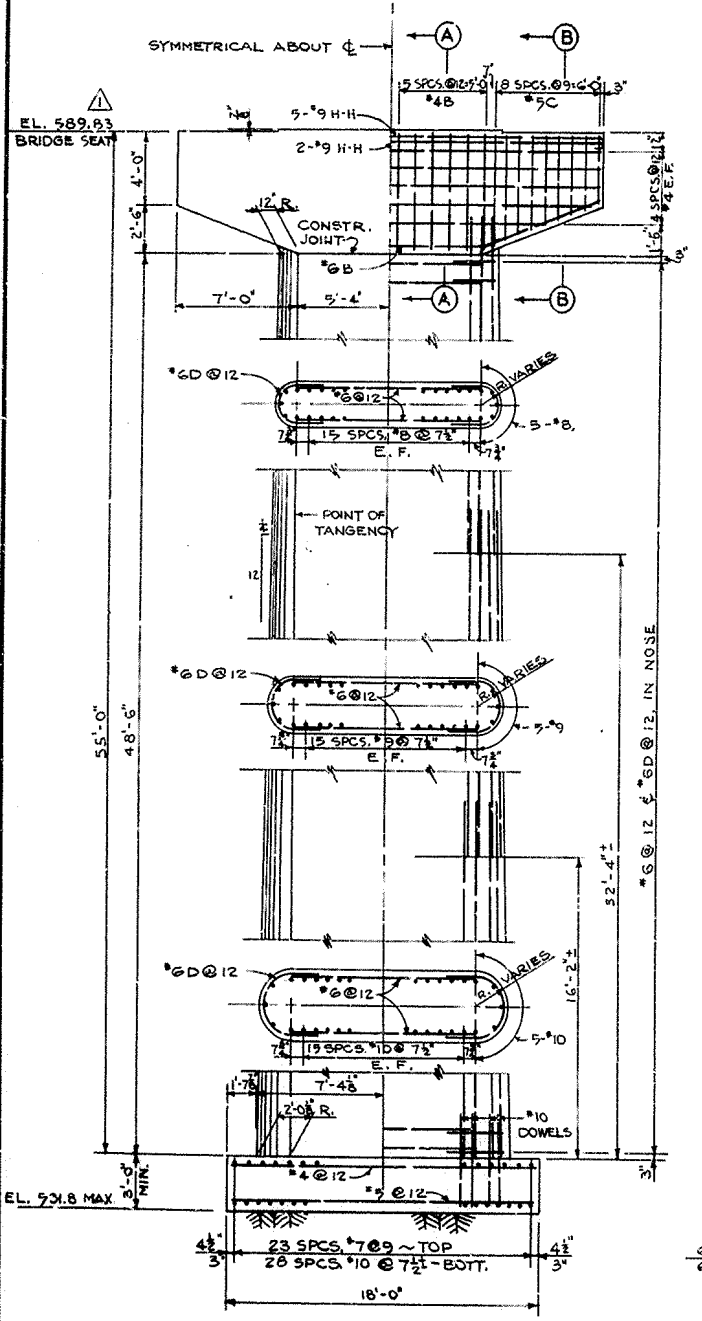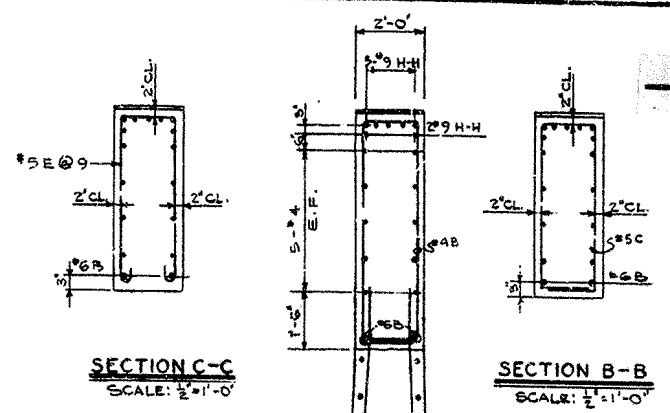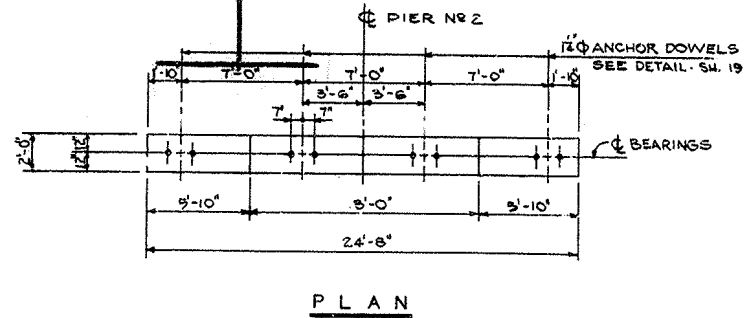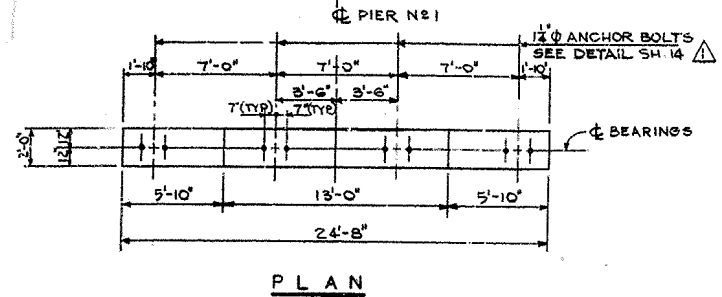


ALLEN Co. DRAWING No. 17352		SHEET 3	
DESIGNED BY: R.T.T.	DRAWN BY: V.H.P.	CHECKED BY: S.F.F.	SUBMITTED BY: <i>[Signature]</i>
OHIO RIVER BASIN BARREN RIVER RESERVOIR SITE NO. 2-RELOCATION STATE HWY. NO. 98 RHODEN CREEK BRIDGE PIERS			
APPROVED: <i>[Signature]</i>	DATE: 12/6/20	BY: BR 19-12-6/20	

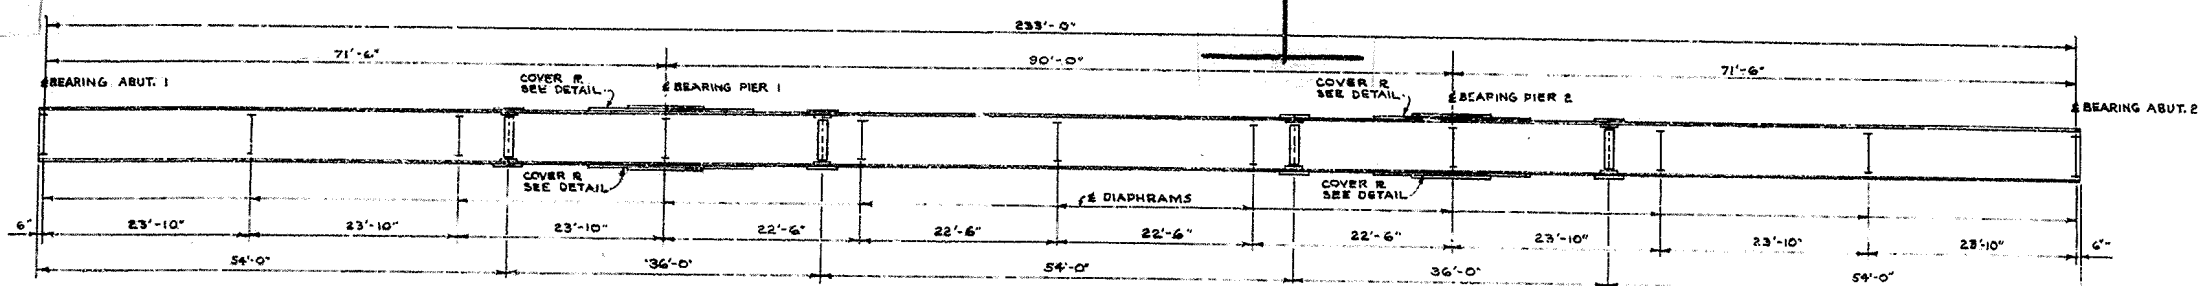


ELEVATION OF BEAMS
SCALE: HORIZ. $\frac{1}{8} = 1'-0"$
VERT. $\frac{1}{4} = 1'-0"$

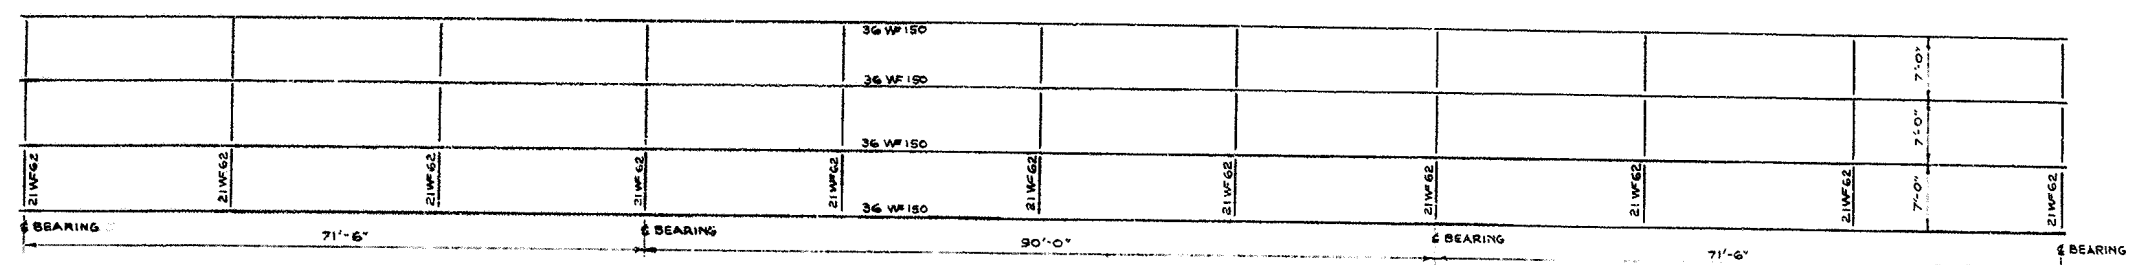


PLAN OF BEAMS
SCALE: $\frac{1}{8} = 1'-0"$

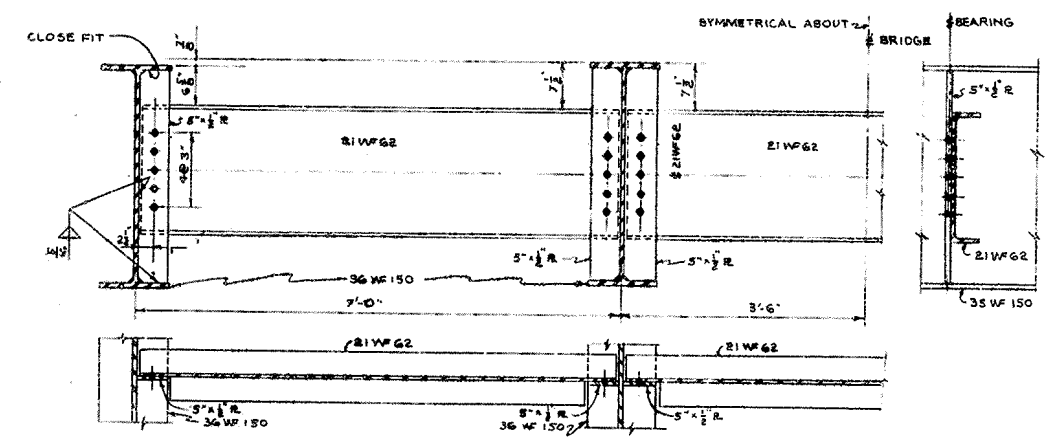


DIAPHRAM OVER PIERS 1 & 2
SCALE: $1" = 1'-0"$

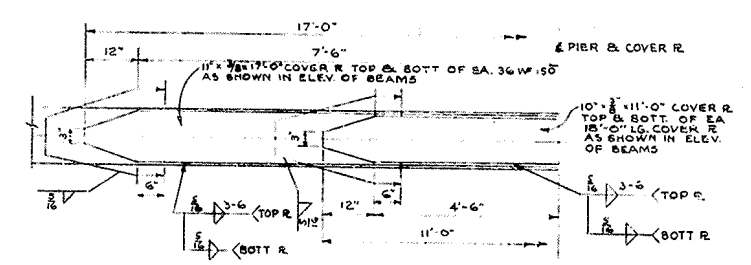


COVER PLATES
SCALE: $\frac{1}{2} = 1'-0"$

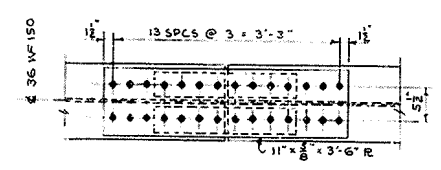

SPICE DETAIL
SCALE: $1" = 1'-0"$

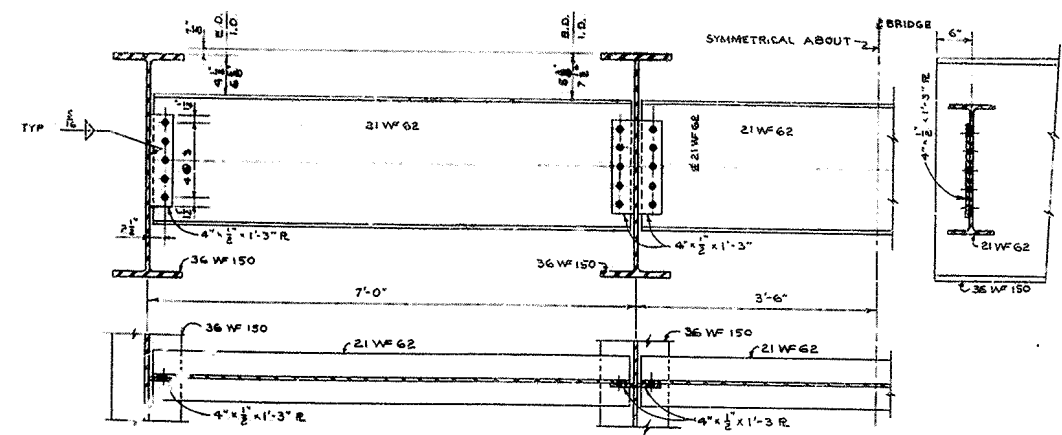

END & INTERMEDIATE DIAPHRAMS
SCALE: $1" = 1'-0"$


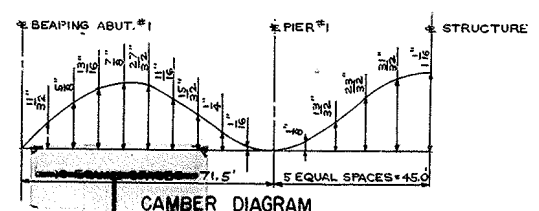


CAMBER DIAGRAM
TOTAL DEAD LOAD

- NOTES:
1. OPEN HOLES $\frac{1}{16}$ " ϕ , FOR $\frac{1}{8}$ " ϕ HIGH STRENGTH BOLTS OR RIVETS
 2. MATERIAL: BEAMS & COVER PL. ASTM-A-36
REMAINDER - ASTM-A-7
 3. FOR EXPANSION JOINT DETAILS, SEE SH. 23
 4. FOR BEARING DETAILS, SEE SH. 23
 5. BEAMS TO BE FABRICATED & ERECTED WITH THE NATURAL CAMBER OF BEAM UP.
 6. TOTAL DEAD LOAD INCLUDES CONC. DECK, HANDRAIL, FUTURE SURFACING & STRUCT. ST.

ALLEN Co. DRAWING No. 17552 SHEET 4

REVISION	DATE	DESCRIPTION	BY
U.S. ARMY ENGINEER DISTRICT, LOUISVILLE CORPS OF ENGINEERS LOUISVILLE, KENTUCKY			
DESIGNED BY:		OHIO RIVER BASIN	
DRAWN BY: T.P.M.		BARREN RIVER RESERVOIR	
TRACED BY:		SITE NO. 2-RELOCATION STATE HWY. NO. 98	
CHECKED BY: SFF		RHODEN CREEK BRIDGE	
SUBMITTED:		FRAMING	
APPROVED: [Signature]		DATE: [Blank]	





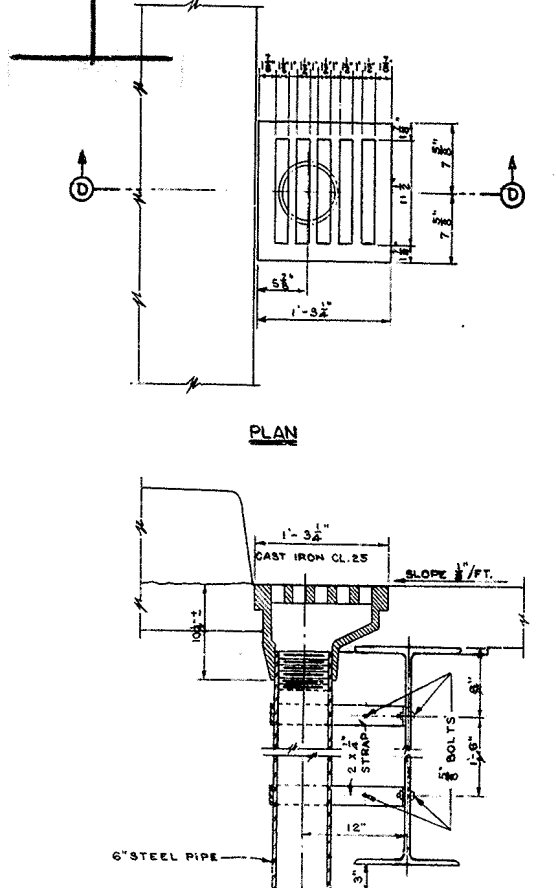
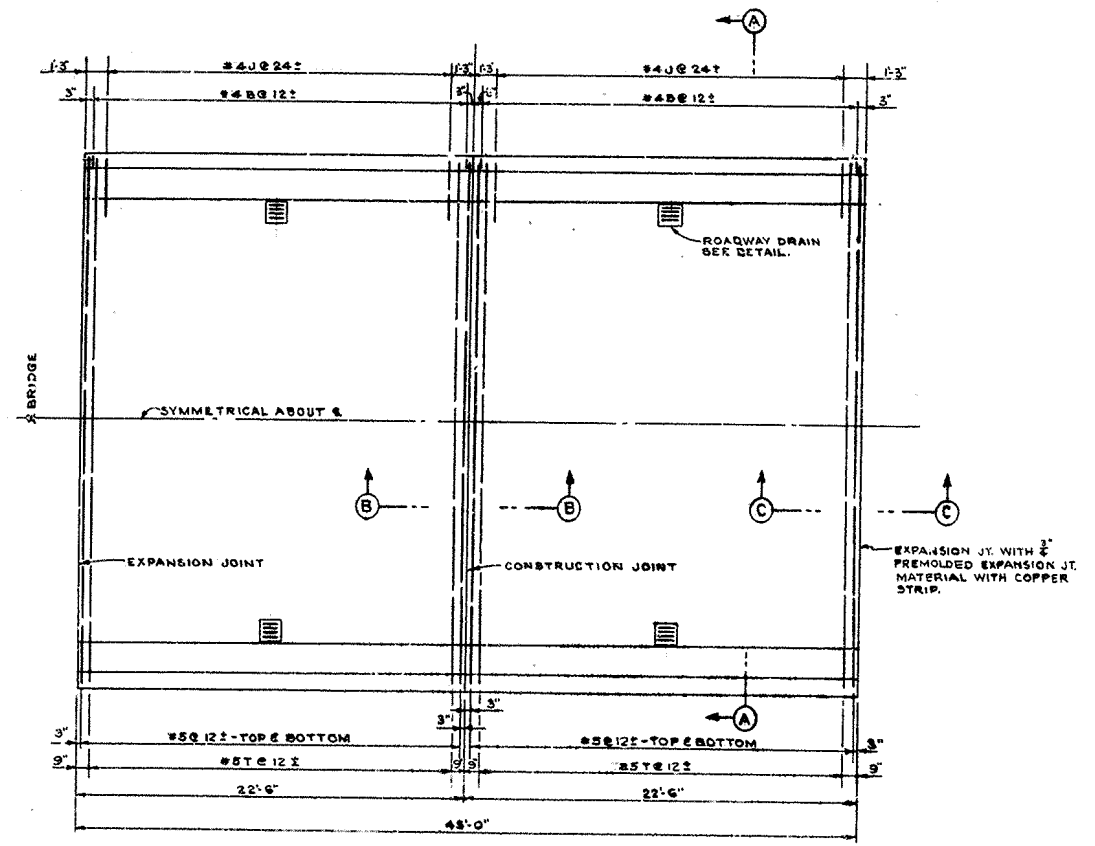


SCREED ELEVATION TABLE

STATION	PROFILE EL.	CONST. EL. "A" OR "D"	BEAM "A" TOP OF STEEL "X"	BEAM "D" TOP OF STEEL "X"	CONST. EL. "B" OR "C"	BEAM "B" TOP OF STEEL "X"	BEAM "C" TOP OF STEEL "X"
ABUTMENT NO. 1	29+54.60	593.8970	593.7881			593.0610	
	29+61.65	593.9233	593.8464			593.9229	
	29+68.80	593.9690	593.9009			593.9738	
	29+76.45	594.0048	593.9492			594.0221	
	29+83.10	594.0403	593.9896			594.0625	
	29+90.25	594.0763	594.0223			594.0982	
	29+97.40	594.1120	594.0480			594.1209	
	30+04.55	594.1478	594.0694			594.1423	
	30+11.70	594.1838	594.0897			594.1626	
	30+18.85	594.2193	594.1140			594.1849	
	30+26.00	594.2550	594.1456			594.2185	
ABUTMENT NO. 2	30+35.0	594.3000	594.1984			594.2718	
	30+44.0	594.3450	594.2620			594.3349	
	30+53.0	594.3900	594.3280			594.4009	
	30+62.0	594.4350	594.3887			594.4616	
	30+71.0	594.4800	594.4393			594.5124	
	30+80.0	594.5250	594.4787			594.5516	
	30+89.0	594.5700	594.5080			594.5804	
	30+98.0	594.6150	594.5320			594.6049	
	31+07.0	594.6600	594.5584			594.6313	
ABUTMENT NO. 2	31+16.0	594.7050	594.5956			594.6685	
	31+23.15	594.7408	594.6353			594.7084	
	31+30.30	594.7768	594.6827			594.7556	
	31+37.45	594.8123	594.7339			594.8046	
	31+44.60	594.8480	594.7840			594.8569	
	31+51.75	594.8838	594.8298			594.9027	
	31+58.90	594.9195	594.8686			594.9415	
	31+66.05	594.9553	594.8997			594.9726	
	31+73.20	594.9910	594.9229			594.9958	
	31+80.35	595.0268	594.9399			595.0128	
ABUTMENT NO. 2	31+87.50	595.0625	594.9551			595.0260	

NOTE: SCREED ELEVATIONS: SEE SECTION A-A, THIS SHEET, FOR MEANING OF "X" AND BEAM LETTERS. TO OBTAIN "X" TAKE ELEVATIONS ON TOP OF STEEL ON POINTS INDICATED AFTER ALL STEEL IS ERECTED, BUT BEFORE DECK FORMS ARE PLACED. ENTER THESE ELEVATIONS IN TABLE AND SUBTRACT FROM CONST. EL. SET TEMPLATES BY MEASURING "X" ABOVE TOP OF STEEL. DO NOT SET TEMPLATES BY ELEVATIONS.

NOTE: FOR REINFORCING STEEL COVERAGE NOTES AND BAR BENDING SCHEDULE SEE SH. 15.

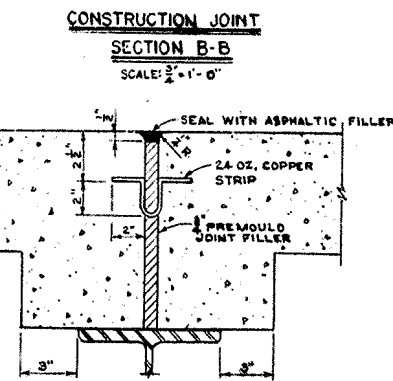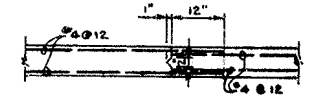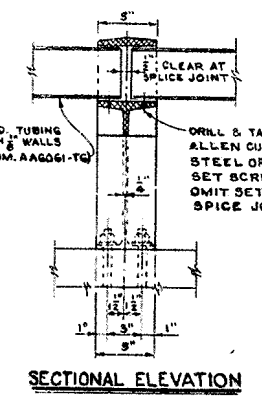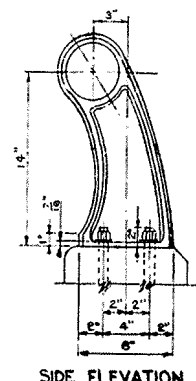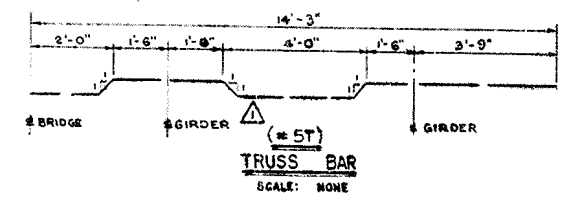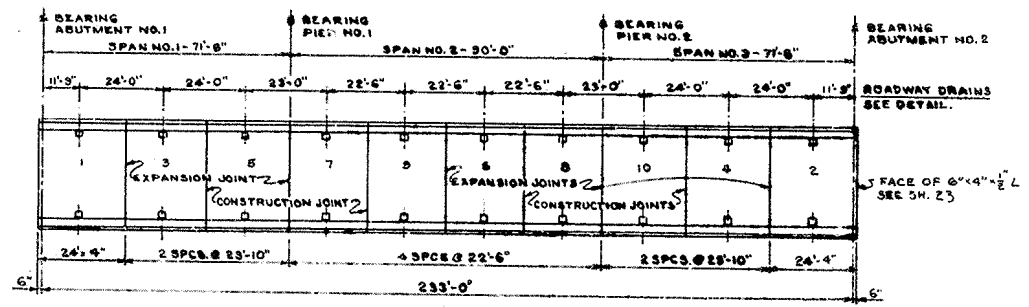

NOTES:
1. EXCEPT AS NOTED, ALL SECTIONS 1/2" THICK.
2. POST ALUMINUM CASTING 56-708-T-1.

ALLEN Co. Drawing No. 17552 SHEET 5




PROJECT	ROADWAY DRAIN REVISED (CONTRACT MOD.)	C.L.L.
DATE	12 JUL 12	G.C.B.
REVISION	DATE	DESCRIPTION


U.S. ARMY ENGINEER DISTRICT, LOUISVILLE
CORPS OF ENGINEERS
LOUISVILLE, KENTUCKY

DESIGNED BY: [Signature]
DRAWN BY: E.R.S.
TRACED BY: E.P.S.
CHECKED BY: S.F.F.
SUBMITTED BY: [Signature]
APPROVED BY: [Signature]


OHIO RIVER BASIN
BARREN RIVER RESERVOIR
SITE NO. 2-RELOCATION STATE HWY NO 98
RHODEN CREEK BRIDGE
DECK PLAN

DATE: 12/15/22

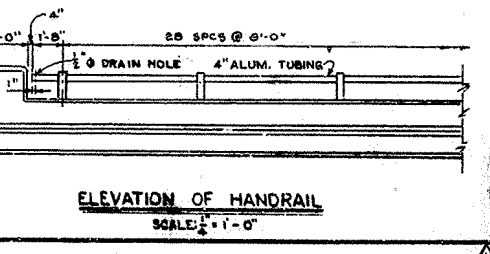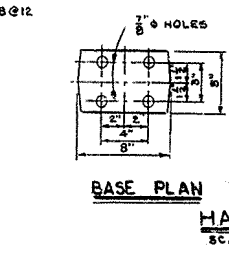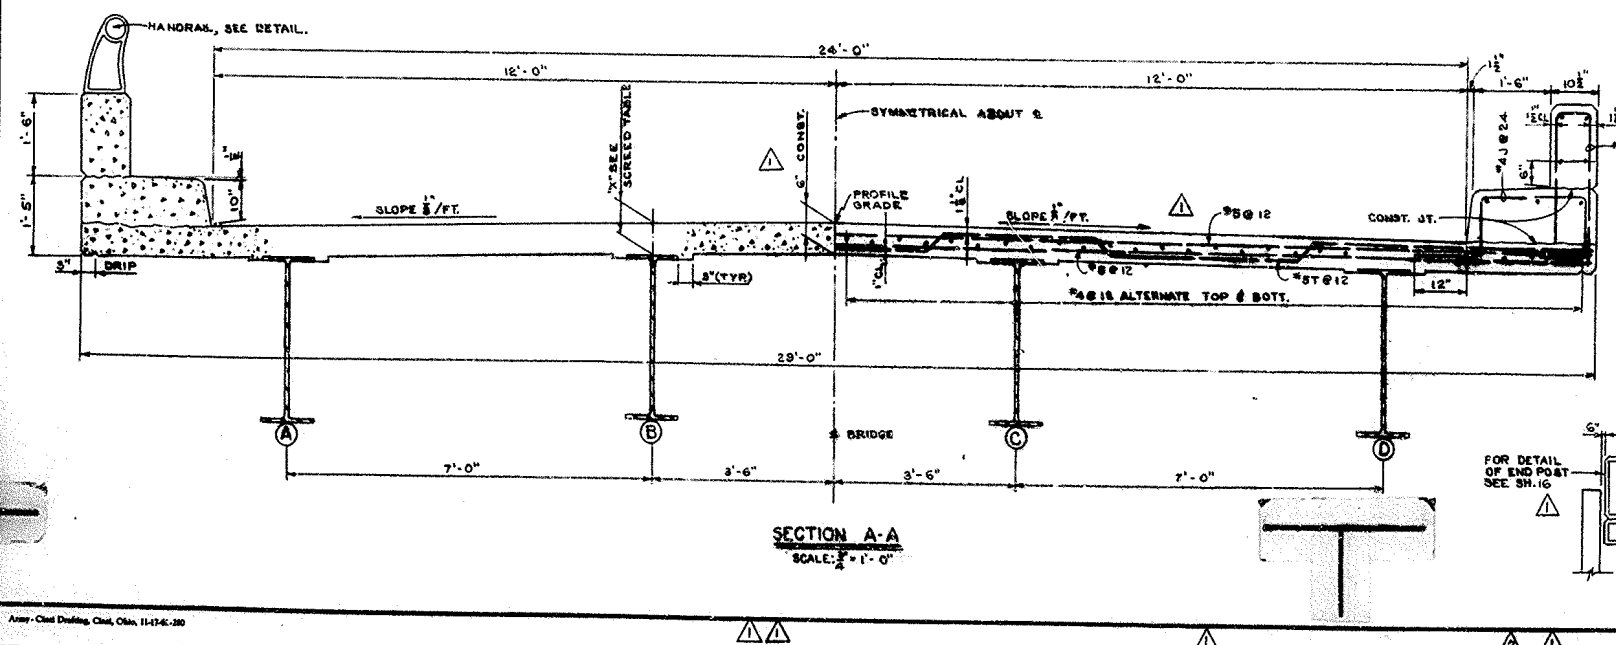


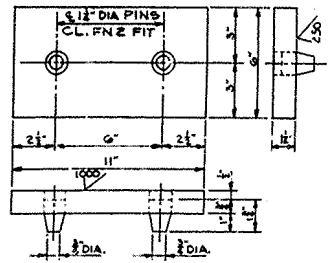


TOP SHOE
MAKE: 8 MATERIAL: STRUCT. STL. A 373

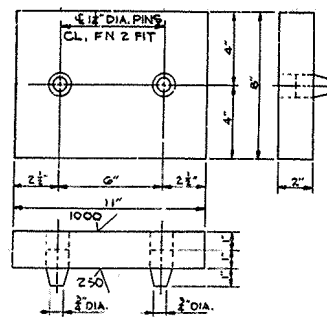


TOP SHOE
MAKE: 4 MATERIAL: STRUCT. STL. A 441

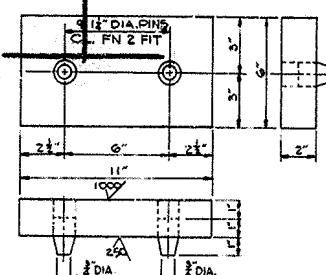


TOP SHOE
MAKE: 4 MATERIAL: STRUCT. STL. A 373

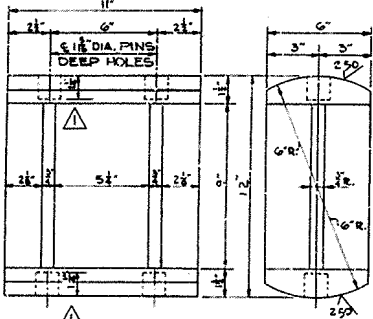


ROCKER
MAKE: 8 MATERIAL: STRUCT. STL. A 373

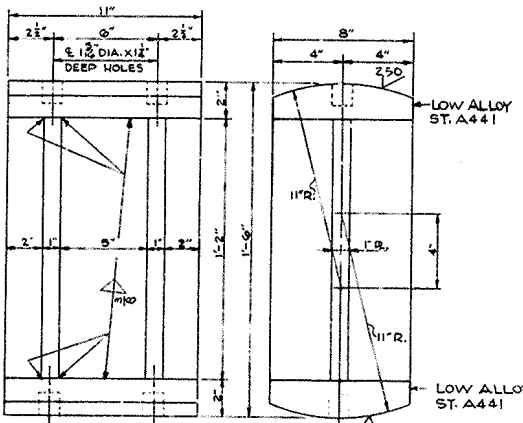


ROCKER
MAKE: 4 MATERIAL: STRUCT. STL. A 373 EXCEPT AS NOTED

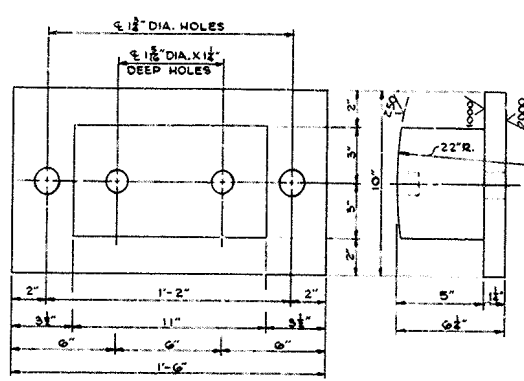


BOTTOM SHOE
MAKE: 4 MATERIAL: STRUCT. STL. A 373 SCALE: 3/4"=1'-0"

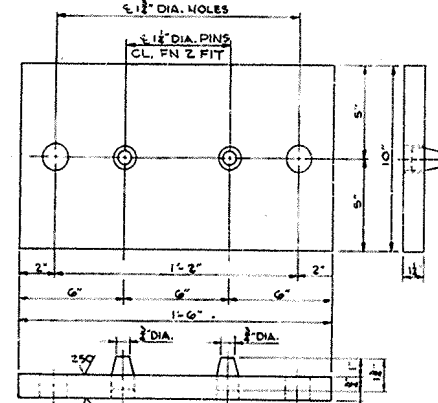


BOTTOM SHOE
MAKE: 8 MATERIAL: STRUCT. STL. A 7 SCALE: 3/4"=1'-0"

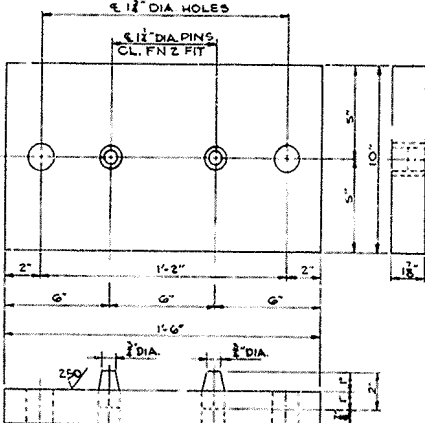


BOTTOM SHOE
MAKE: 4 MATERIAL: STRUCT. STL. A 441

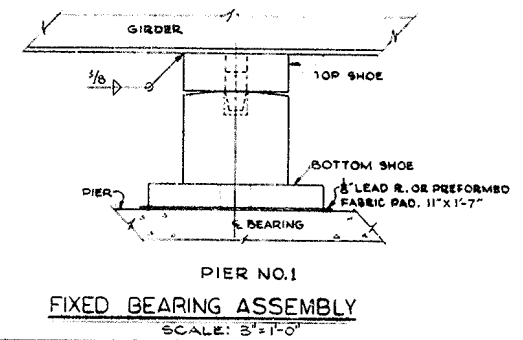

**PIER NO. 1
FIXED BEARING ASSEMBLY**
SCALE: 3/4"=1'-0"

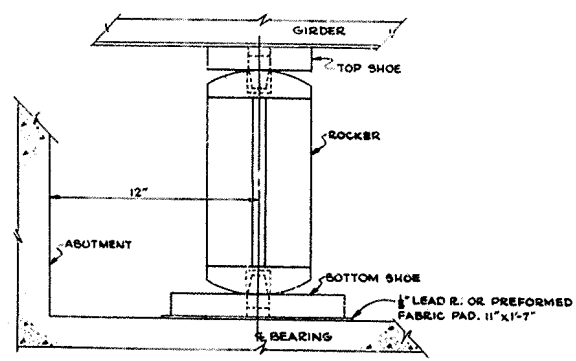

ABUTMENTS NO. 1 & 2

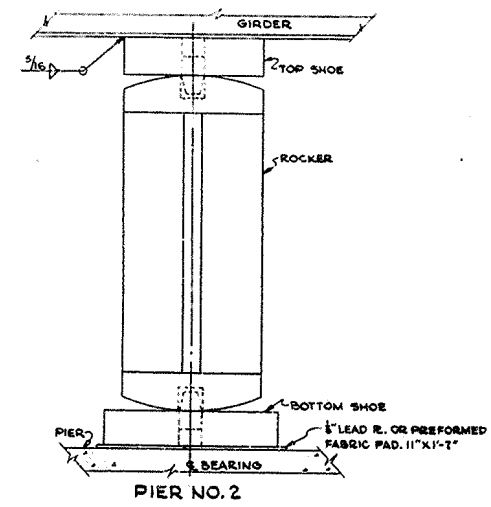


PIER NO. 2


NOTE:
AFTER THE BASE PLATES ARE PROPERLY SET IN POSITION ON DOWELS OR ANCHOR BOLTS, MOLTEN LEAD SHALL BE POURED IN THE HOLES AND CAULKED UNTIL THE HOLES ARE FILLED FLUSH TO TOP OF PLATE.

EXPANSION BEARING ASSEMBLIES


NOTE:
6" OPENING BETWEEN END OF DECK & BACKWALL AT 60'. FOR EACH 10" FALL IN TEMPERATURE INCREASE OPENING BY 1/8" ABUT. NO. 1 & 2. DECREASE OPENING SIMILARLY FOR TEMPERATURE RISE.

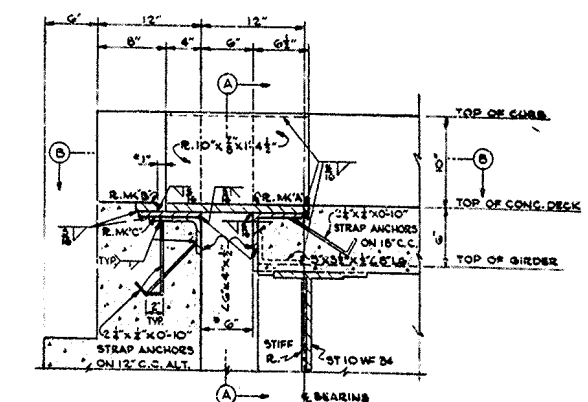


BARREN RIVER BRIDGE

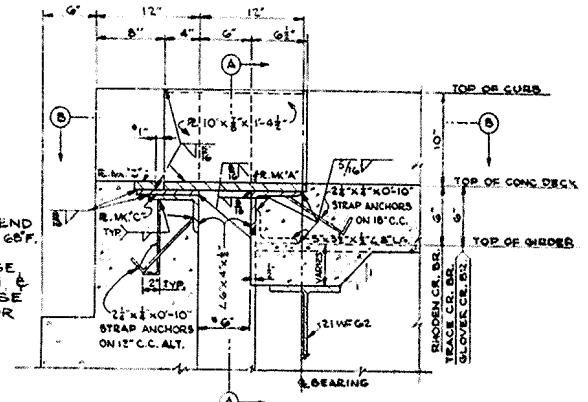

RHODEN, TRACE & GLOVER CREEK BRIDGES

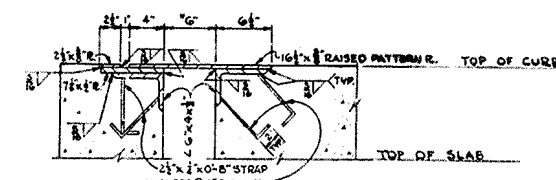

SECTION THRU SIDEWALK

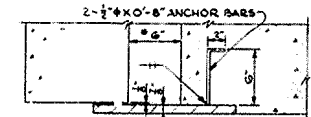


SECTION B-B

EXPANSION JOINT AT ABUTMENTS
SCALE: 1/2"=1'-0"

NOTE:
MATERIAL STEEL A 7

ALLEN Co. DRAWING No. 17552 SHEET 6

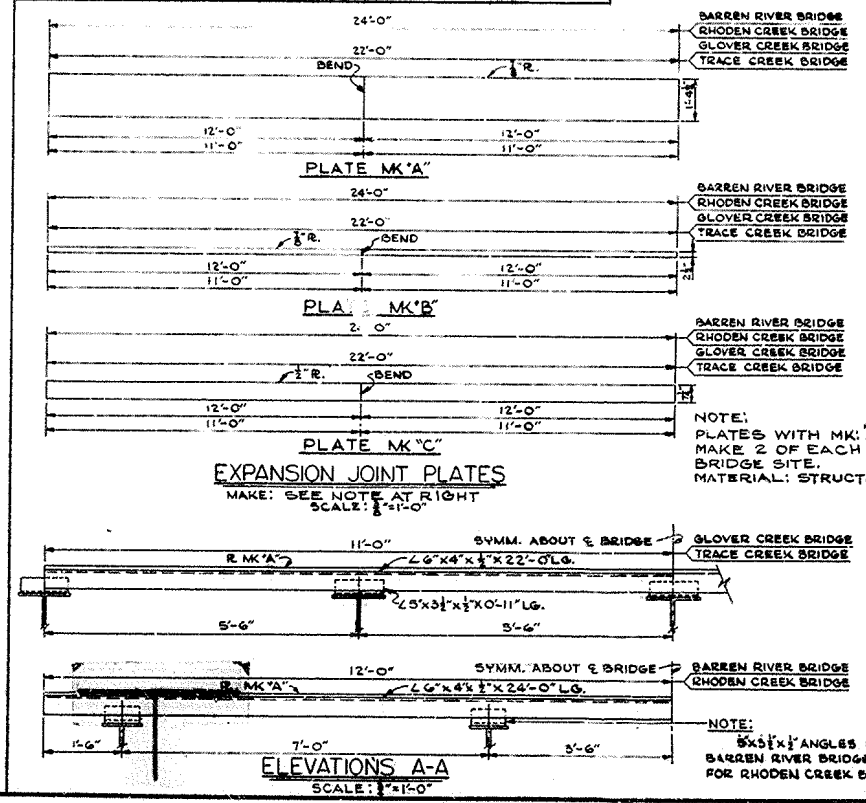

EXPANSION JOINT PLATES
MAKE: SEE NOTE AT RIGHT SCALE: 1/2"=1'-0"

ELEVATIONS A-A
SCALE: 1/2"=1'-0"

NOTE:
PLATES WITH MK 'A' 'B' & 'C' MAKE 2 OF EACH FOR EACH BRIDGE SITE.
MATERIAL: STRUCT. STL.

U.S. ARMY ENGINEER DISTRICT LOUISVILLE
CORPS OF ENGINEERS
LOUISVILLE KENTUCKY

OHIO RIVER BASIN
BARREN RIVER RESERVOIR
SITE NO. 2 - RELOCATION STATE HWY. NO. 98
RHODEN CREEK BRIDGE
BEARING & EXPANSION DEVICES

DESIGNED BY: R.T.T.
DRAWN BY: R.W.S.
CHECKED BY: S.F.F.
DATE: 11/11/52
APPROVED: [Signature]