



**TRANSPORTATION CABINET**

Frankfort, Kentucky 40622  
www.transportation.ky.gov/

**Steven L. Beshear**  
Governor

**Michael W. Hancock, P.E.**  
Secretary

November 7, 2013

CALL NO. 108  
CONTRACT ID NO. 131221  
ADDENDUM # 1

Subject: Perry County, STP BRZ 1003 (229)  
Letting November 22, 2013

- (1) Revised - Plan Sheets
- (2) Revised - Bid Items - Pages 188-189(c) of 189 (This is to replace the incorrect bid items that were included in the original proposal)

Proposal revisions are available at <http://transportation.ky.gov/Construction-Procurement/>.

Plan revisions are available at <http://www.lynnimaging.com/kytransportation/>.

If you have any questions, please contact us at 502-564-3500.

Sincerely,

A handwritten signature in blue ink that reads "Ryan Griffith".

Ryan Griffith  
Acting Director  
Division of Construction Procurement

RG:ks  
Enclosures




An Equal Opportunity Employer M/F/D

# GENERAL NOTES, LEGEND, & GENERAL SUMMARY, GLOMAWR BRIDGE REPLACEMENT GAS UTILITY RELOCATION

COUNTY OF	ITEM NO.	SHEET NO.
PERRY	10-1088	U1

## GENERAL SUMMARY, NEW GAS UTILITIES

KTC ITEM CODE	ITEM	UNIT	PLAN QTY.	AS-BUILT QTY.	REMARKS
21846EN	POLYETHYLENE GAS MAIN - 2 IN	LF	1,780		
22668EN	DIRECTIONAL BORE	LF	845		4" STEEL ENCASEMENT PIPE
21938EN	SERVICE BORE	LF	25		
21661ES706	BORE & JACK PIPE	LF	50		8" BORED ENCASEMENT PIPE
21788ED	OPEN CUT W/ STEEL ENCASEMENT	LF	12		4" OPEN CUT LINER PIPE
21772NN	VENT, COMPLETE	EA	9		
22093NN	TIES	EA	6		
23337EC	GAS VALVE - 2 IN	EA	6		INCLUDE BOX
21773NN	GAS LINE MARKERS	EA	13		
02460	REMOVE TREE	EA	3		
00461	15" CULVERT PIPE	LF	40		POLYETHYLENE PIPE
02220	FLOWABLE FILL	CU YD	25		
23340EC	PAVEMENT REPLACEMENT	TON	10		
02677	PAVEMENT MILLING & TEXTURING	TON	2		
23300ED	CRUSHED STONE	TON	100		
23341EC	GENERAL CONCRETE	CU YD	5		

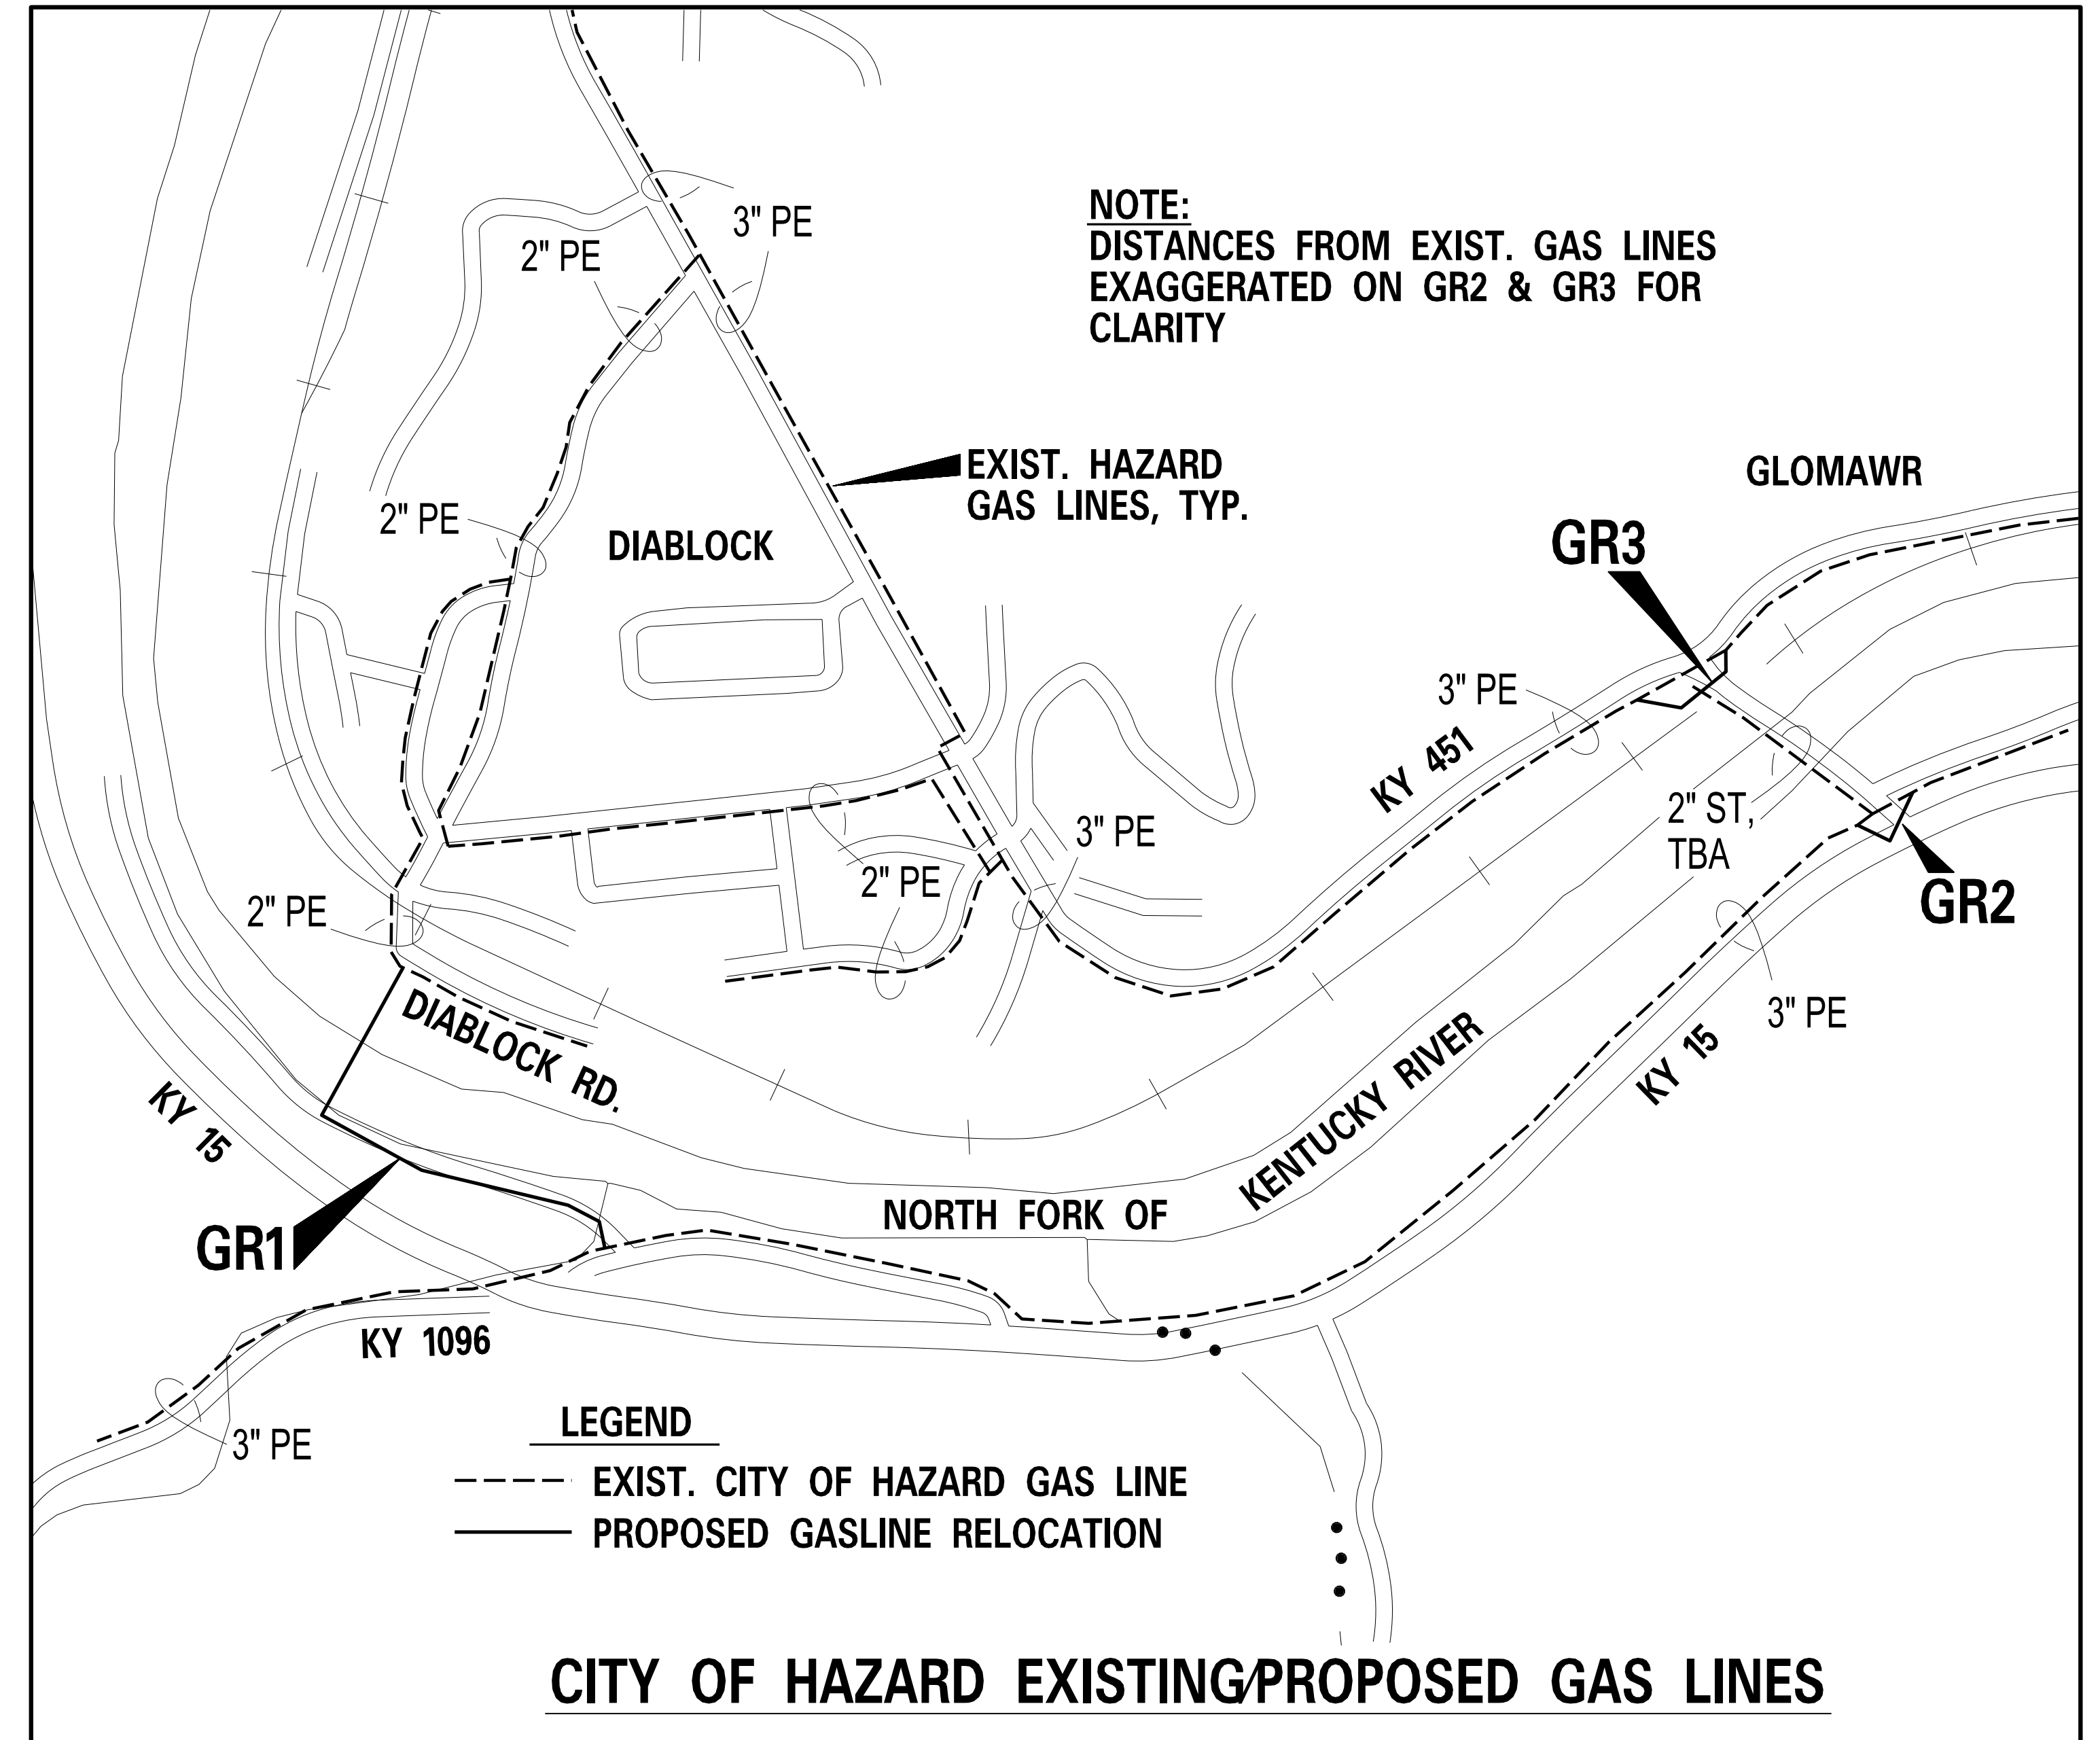

### U.S. D.O.T. NOTE

ALL GAS UTILITY WORK TO BE DONE IN STRICT ACCORDANCE WITH ALL U.S. D.O.T. REQUIREMENTS. SOME DETAILS NOT SHOWN ON DRAWINGS BUT SPECIFIED BY THE ABOVE REQUIREMENTS SHALL BE CONSIDERED INCIDENTAL TO OTHER WORK AND NO ADJUSTMENT TO UNIT PRICES WILL BE MADE. CONTRACTOR SHOULD ALSO REFERENCE "GUIDANCE MANUAL FOR OPERATORS OF SMALL GAS SYSTEMS": "PIPELINE SAFETY REGULATIONS", PARTS 190, 191, 192, 193, AND 195; BOTH FROM U.S. D.O.T., RESEARCH AND SPECIAL PROGRAMS ADMINISTRATION. THESE DOCUMENTS MAY BE REVIEWED AT THE OFFICE OF THE GAS RELO. ENGINEER PRIOR TO BID.

### ABANDONED GAS ITEMS

ITEM	UNITS	ABANDONED QTY.
3" P.E. GAS LINE	LF	596
2" P.E. GAS LINE	LF	534

### LEGEND (GAS RELOCATION ONLY)

- - - CM - - -	EXIST. GAS LINE, SIZE NOTED
GM	EXIST. GAS METER
o GM	EXIST. GASLINE MARKER
— GM —	NEW GAS LINE, SIZE NOTED
— ⊗ —	NEW GAS VALVE, SIZE NOTED
(GLM)	NEW GAS LINE MARKER
(V)	NEW GAS VENT LOCATION
— GM —	NEW LINER PIPE, SIZE AND LENGTH NOTED

### GENERAL NOTES

- 1) DO NO WORK IN ANY AREA OF THE PROJECT UNTIL CONTACTING MR. DARRELL CORNETT (606) 216-0621 (W/ CITY OF HAZARD GAS).
- 2) ALL LINE LOCATIONS ARE APPROXIMATE. THE ENGR. HAS USED HIS BEST EFFORT TO SHOW ACCURATE LOCATION OF LINES BUT ONLY ITEMS WHICH ARE ON THE SURFACE SHOULD BE CONSIDERED AS ACCURATELY PLACED ON THE PLANS - CONTRACTOR SHOULD CONSIDER THIS IN HIS BID.
- 3) ALL EXISTING LINE SIZES & TYPE SHALL BE FIELD CONFIRMED BY CONTRACTOR BEFORE ANY WORK OR ORDERING OF MATERIALS.
- 4) CONTRACTOR SHOULD PAY CAREFUL ATTENTION TO "SPECIAL NOTES" IN UTILITY RELOCATION SPECIFICATIONS.



*Hank A. Spaulding*

**U1**

RECORD DATE 11/01/13	GLOMAWR BRIDGE REPLACEMENT GAS UTILITY RELOCATION CITY OF HAZARD, KENTUCKY	
PROJECT NO. BRZ 1003 (170) ITEM NO. 10-1088.00	COMMONWEALTH OF KENTUCKY KENTUCKY DEPARTMENT OF HIGHWAYS FRANKFORT, KENTUCKY	
DRAWN BY: EH	H. A. SPALDING ENGINEERS 651 SKYLINE DRIVE HAZARD, KENTUCKY 41701 - 1664	
CHECKED BY: HAS		
SCALE: NOTED		




# GENERAL NOTES, LEGEND, & GENERAL SUMMARY, GLOMAWR BRIDGE REPLACEMENT GAS UTILITY RELOCATION

REVISED 11-6-13

COUNTY OF	ITEM NO.	SHEET NO.
PERRY	10-1088	U1

## GENERAL SUMMARY, NEW GAS UTILITIES

KTC ITEM CODE	ITEM	UNIT	PLAN QTY.	AS-BUILT QTY.	REMARKS
21846EN	POLYETHYLENE GAS MAIN - 2 IN	LF	1,780		
22668EN	DIRECTIONAL BORE	LF	845		4" STEEL ENCASEMENT PIPE
21938EN	SERVICE BORE	LF	25		
21661ES706	BORE & JACK PIPE	LF	50		8" BORED ENCASEMENT PIPE
21788ED	OPEN CUT W/ STEEL ENCASEMENT	LF	12		4" OPEN CUT LINER PIPE
21772NN	VENT, COMPLETE	EA	9		
22093NN	TIES	EA	6		
23337EC	GAS VALVE - 2 IN	EA	6		INCLUDE BOX
21773NN	GAS LINE MARKERS	EA	13		
02460	REMOVE TREE	EA	3		
00461	15" CULVERT PIPE	LF	40		POLYETHYLENE PIPE
02220	FLOWABLE FILL	CU YD	25		
23340EC	PAVEMENT REPLACEMENT	TON	10		
02677	PAVEMENT MILLING & TEXTURING	TON	2		
23300ED	CRUSHED STONE	TON	100		
23341EC	GENERAL CONCRETE	CU YD	5		

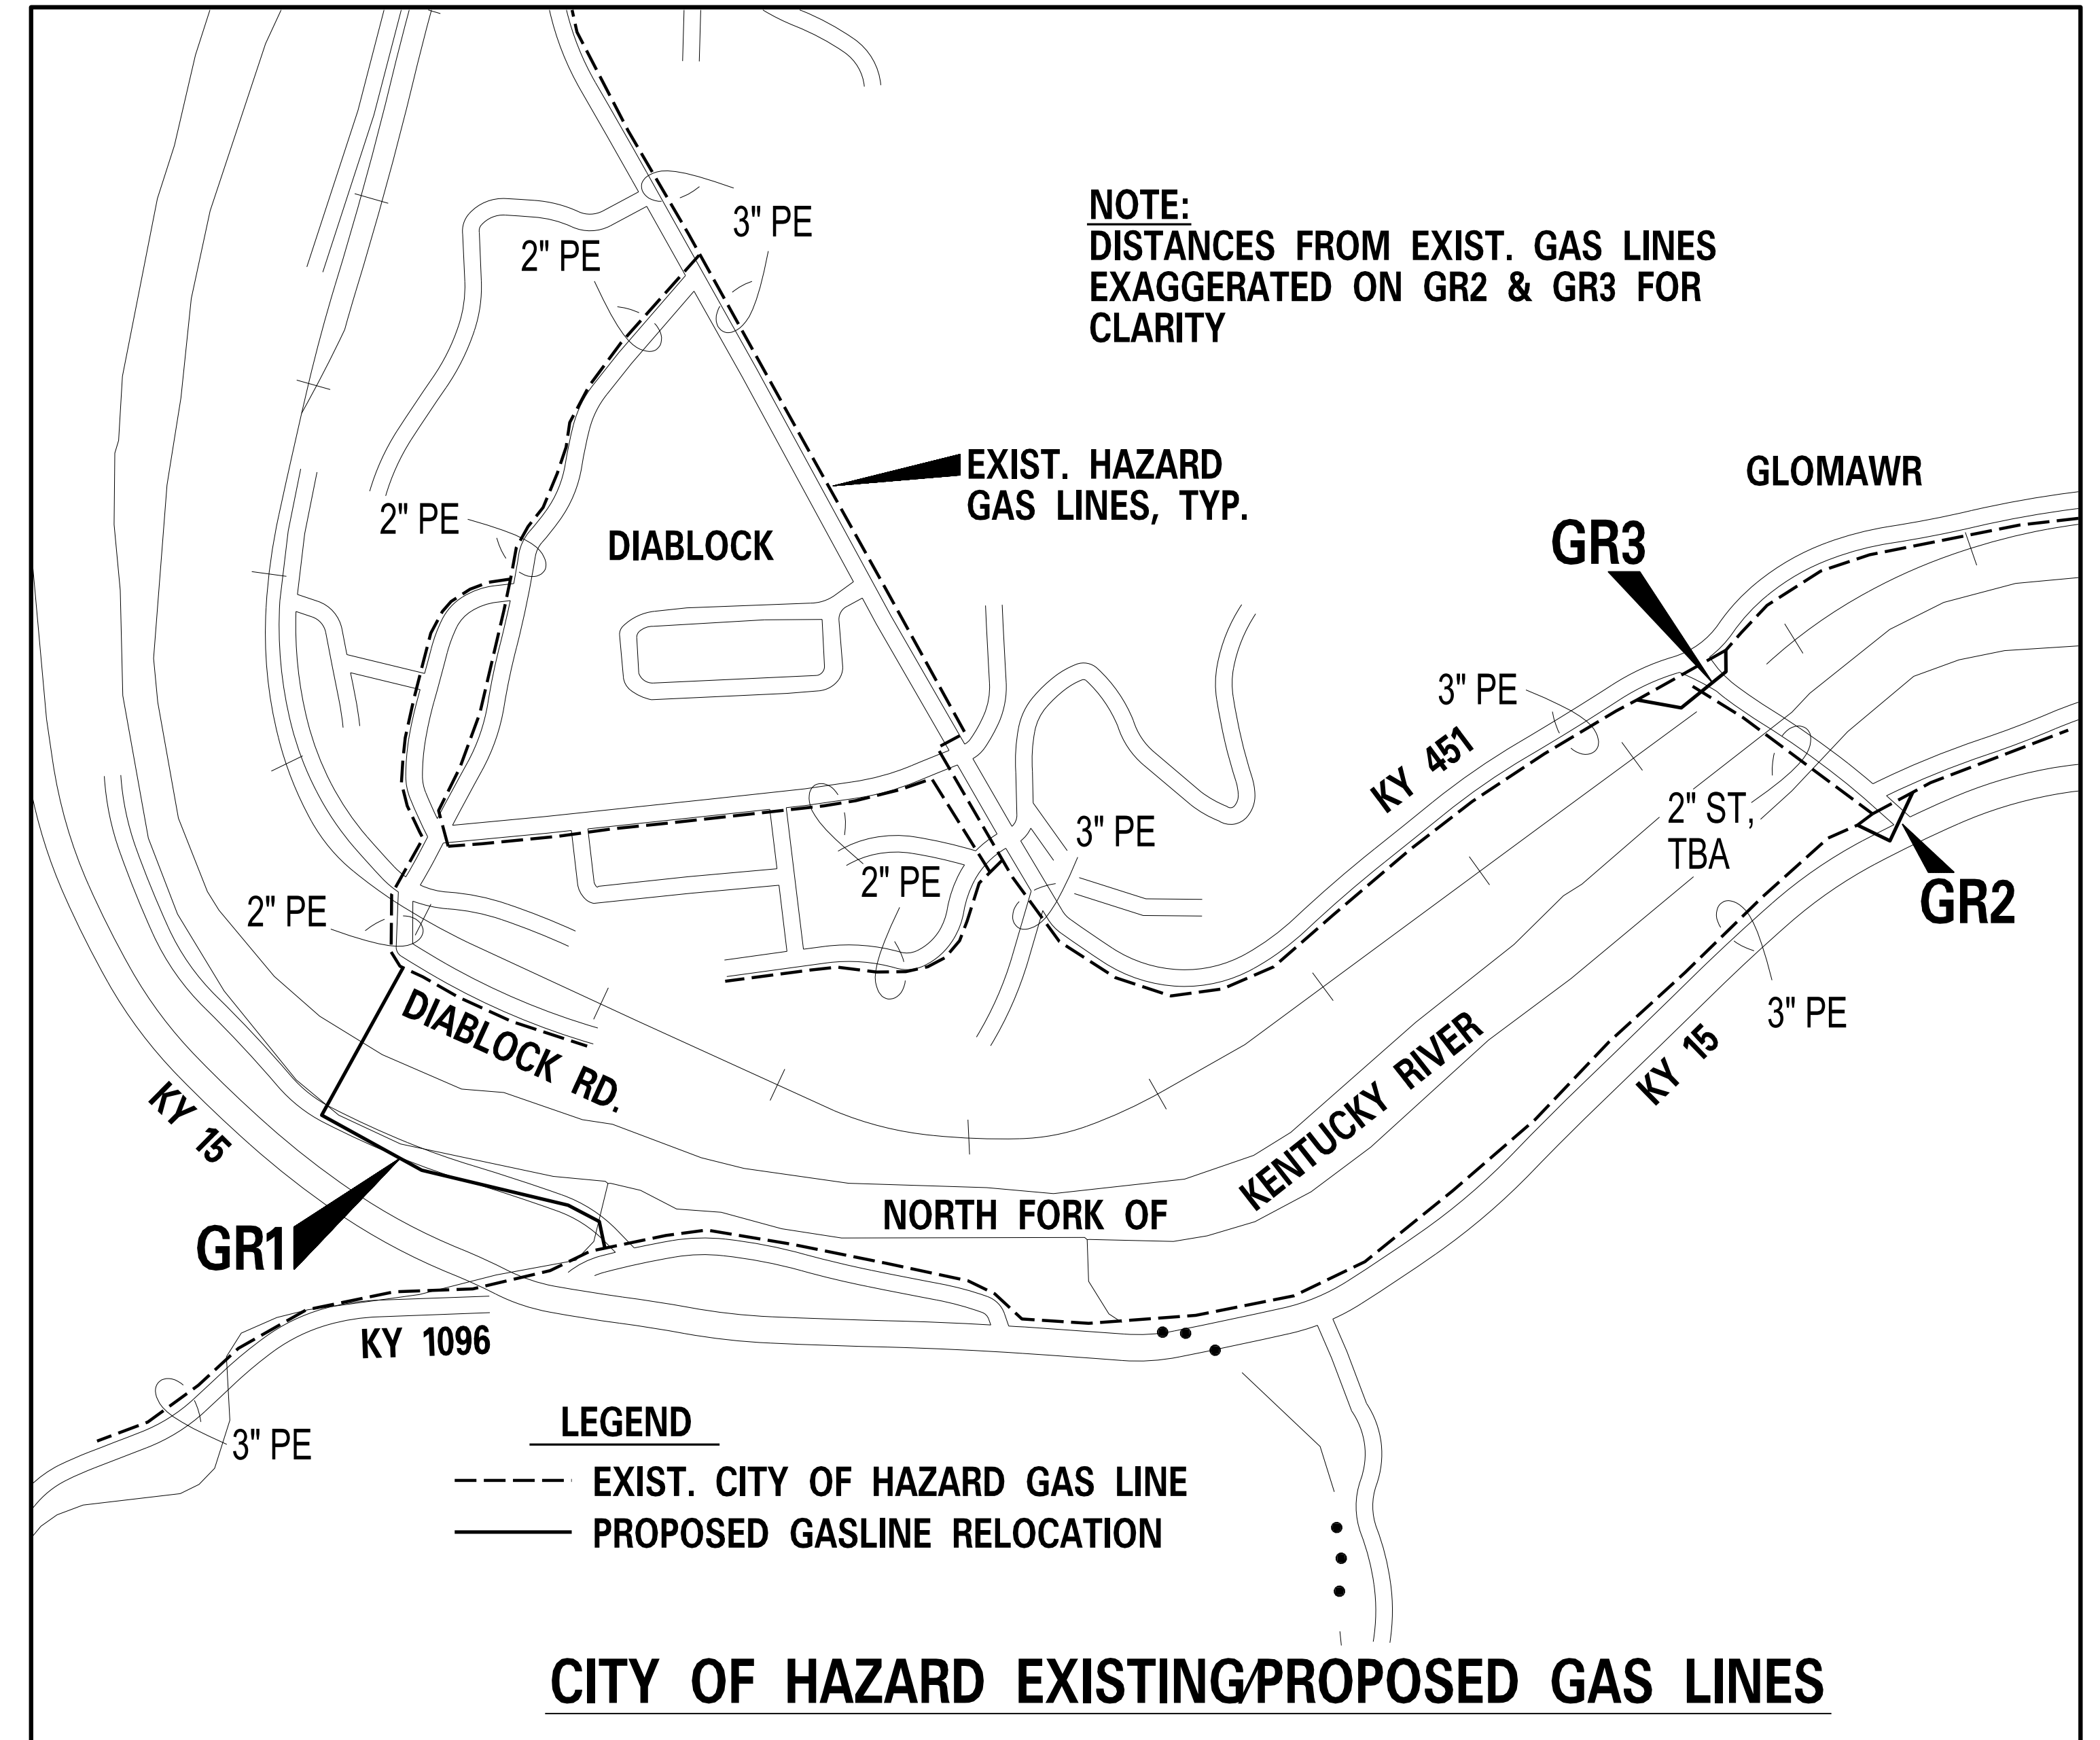

## U.S. D.O.T. NOTE

ALL GAS UTILITY WORK TO BE DONE IN STRICT ACCORDANCE WITH ALL U.S. D.O.T. REQUIREMENTS. SOME DETAILS NOT SHOWN ON DRAWINGS BUT SPECIFIED BY THE ABOVE REQUIREMENTS SHALL BE CONSIDERED INCIDENTAL TO OTHER WORK AND NO ADJUSTMENT TO UNIT PRICES WILL BE MADE. CONTRACTOR SHOULD ALSO REFERENCE "GUIDANCE MANUAL FOR OPERATORS OF SMALL GAS SYSTEMS": "PIPELINE SAFETY REGULATIONS", PARTS 190, 191, 192, 193, AND 195; BOTH FROM U.S. D.O.T., RESEARCH AND SPECIAL PROGRAMS ADMINISTRATION. THESE DOCUMENTS MAY BE REVIEWED AT THE OFFICE OF THE GAS RELO. ENGINEER PRIOR TO BID.

## ABANDONED GAS ITEMS


ITEM	UNITS	ABANDONED QTY.
3" P.E. GAS LINE	LF	596
2" P.E. GAS LINE	LF	534

## LEGEND (GAS RELOCATION ONLY)

--- GM ---	EXIST. GAS LINE, SIZE NOTED
GM	EXIST. GAS METER
o GM	EXIST. GASLINE MARKER
— GM —	NEW GAS LINE, SIZE NOTED
— ⊗ —	NEW GAS VALVE, SIZE NOTED
(GLM)	NEW GAS LINE MARKER
(V)	NEW GAS VENT LOCATION
— GM —	NEW LINER PIPE, SIZE AND LENGTH NOTED

## GENERAL NOTES

- DO NO WORK IN ANY AREA OF THE PROJECT UNTIL CONTACTING MR. DARRELL CORNETT (606) 216-0621 (W/ CITY OF HAZARD GAS).
- ALL LINE LOCATIONS ARE APPROXIMATE. THE ENGR. HAS USED HIS BEST EFFORT TO SHOW ACCURATE LOCATION OF LINES BUT ONLY ITEMS WHICH ARE ON THE SURFACE SHOULD BE CONSIDERED AS ACCURATELY PLACED ON THE PLANS - CONTRACTOR SHOULD CONSIDER THIS IN HIS BID.
- ALL EXISTING LINE SIZES & TYPE SHALL BE FIELD CONFIRMED BY CONTRACTOR BEFORE ANY WORK OR ORDERING OF MATERIALS.
- CONTRACTOR SHOULD PAY CAREFUL ATTENTION TO "SPECIAL NOTES" IN UTILITY RELOCATION SPECIFICATIONS.

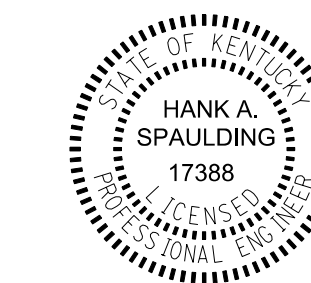

Hank C. Spaulding

U1




RECORD DATE 11/01/13	GLOMAWR BRIDGE REPLACEMENT GAS UTILITY RELOCATION CITY OF HAZARD, KENTUCKY
PROJECT NO. BRZ 1003 (170) ITEM NO. 10-1088.00	
DRAWN BY: EH	COMMONWEALTH OF KENTUCKY KENTUCKY DEPARTMENT OF HIGHWAYS FRANKFORT, KENTUCKY
CHECKED BY: HAS	
SCALE: NOTED	H. A. SPALDING ENGINEERS 651 SKYLINE DRIVE HAZARD, KENTUCKY 41701 - 1664



COUNTY OF	ITEM NO.	SHEET NO.
PERRY	10-1088	U2

**REVISED 11-6-13**

- SHEET NOTES:
- 1) INLET OF PIPE IS STEEL, OUTLET IS P.E.
  - 2) USE SPLICE BAND SPECIFICALLY MADE FOR THIS PIPE TYPE.
  - 3) BEGIN DIRECTIONAL BORE AT STA. 4+11 AND WORK BACK ACROSS RIVER.
  - 4) ALL TREES TO BE REMOVED TO WITHIN 3" OF GROUND. ALL TREE MATERIAL SHALL BECOME THE PROPERTY OF THE CONTRACTOR AND SHALL BE REMOVED OFF-SITE AND PROPERLY DISPOSED OF.
  - 5) PROVIDE SLIGHT UPSLOPE TOWARDS VENT END OF LINER PIPE.

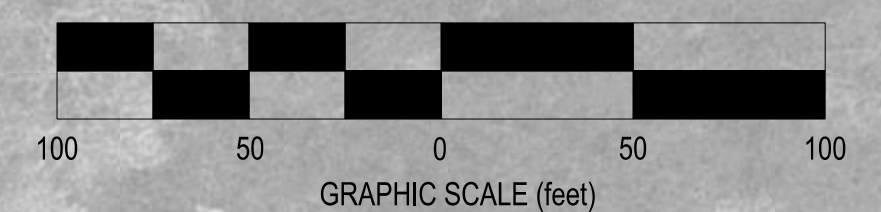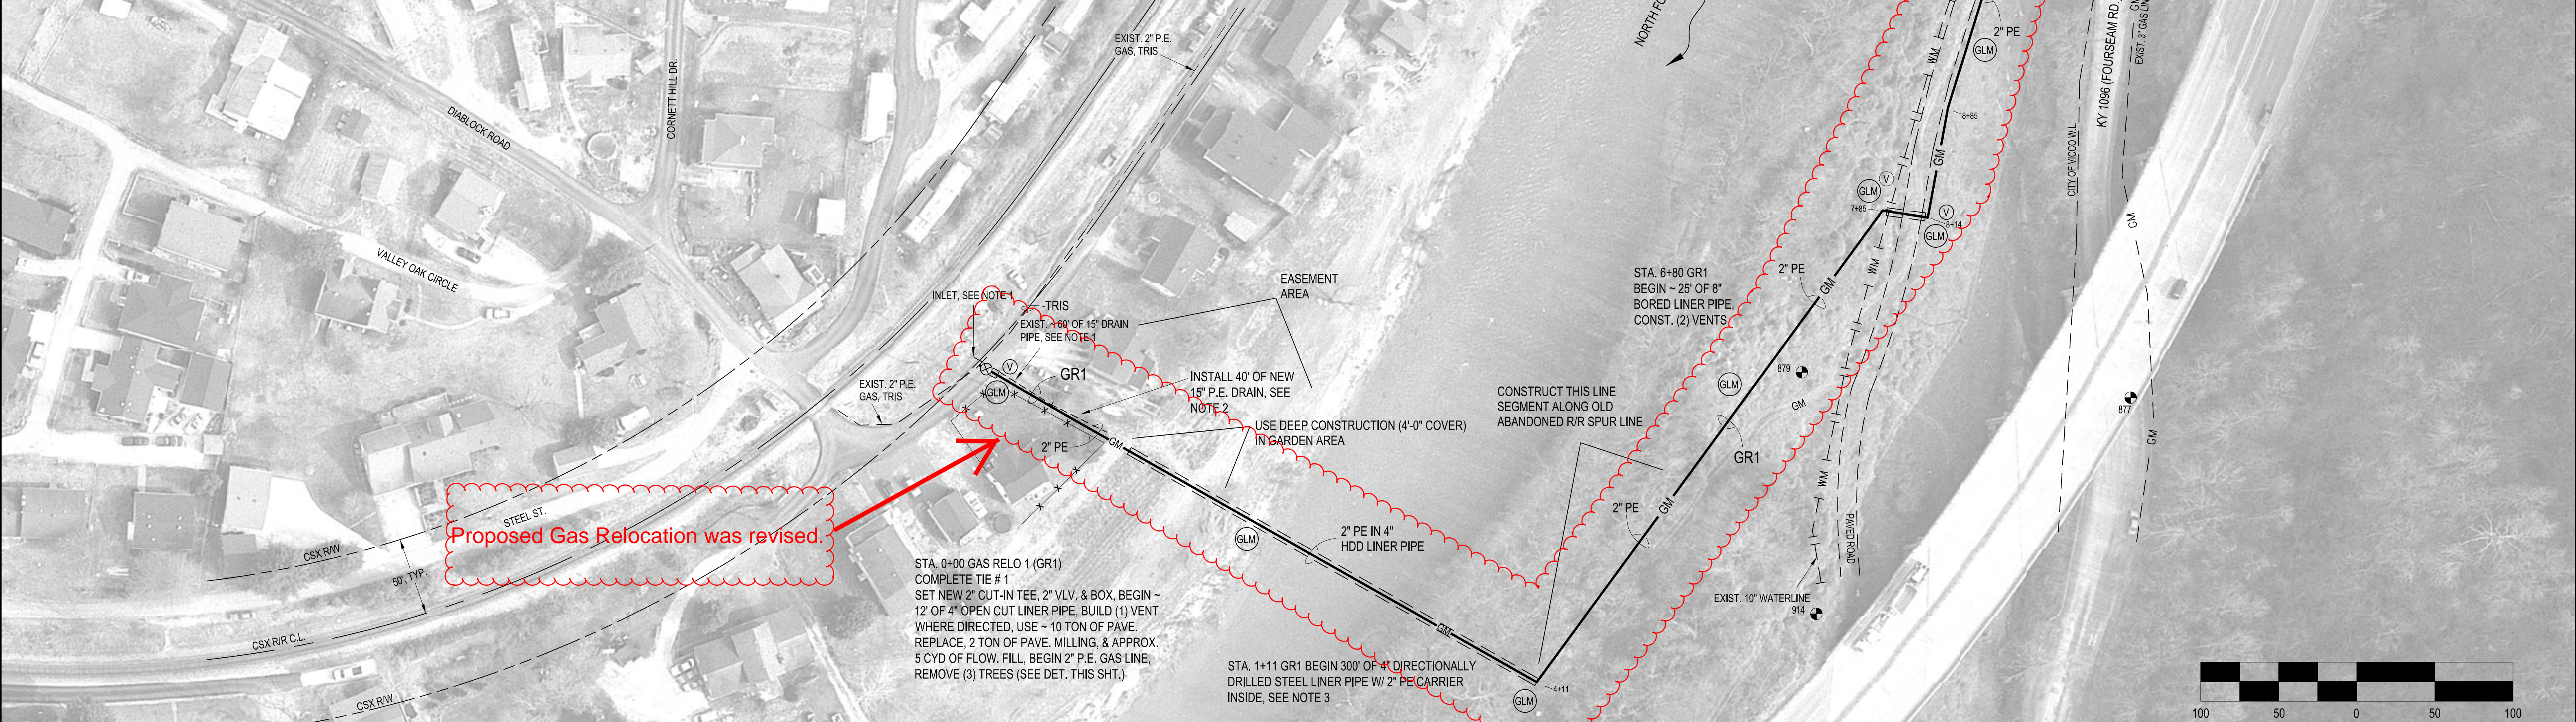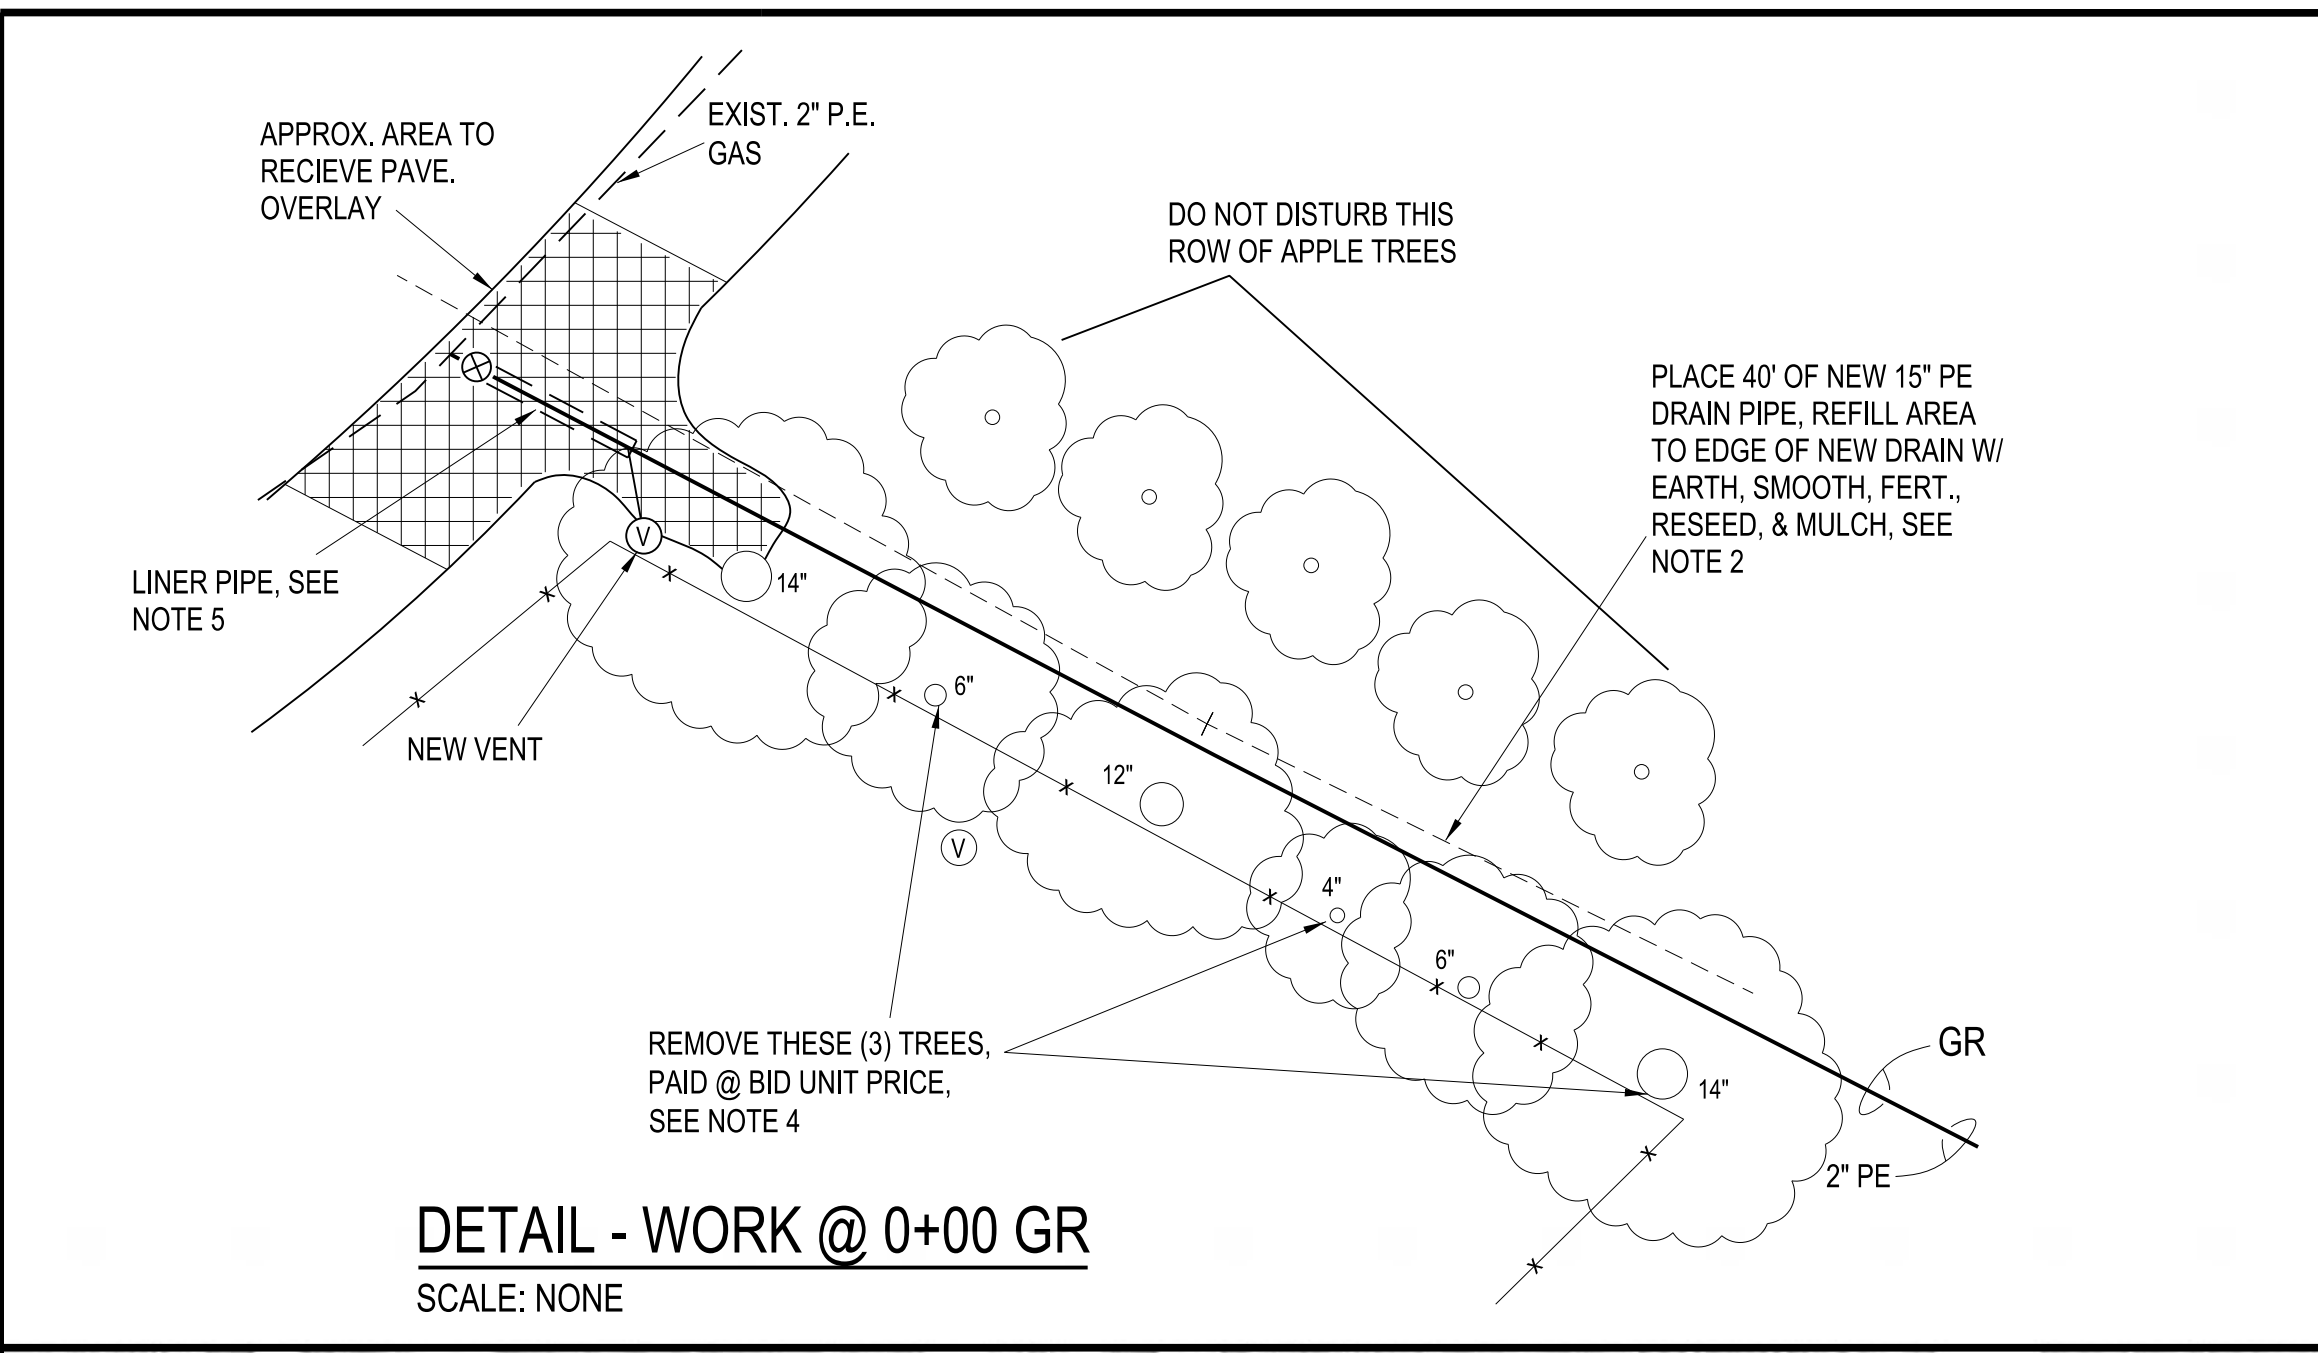

ALL GAS UTILITY WORK TO BE DONE IN STRICT ACCORDANCE WITH ALL U.S. D.O.T. REQUIREMENTS. SOME DETAILS NOT SHOWN ON DRAWINGS BUT SPECIFIED BY THE ABOVE REQUIREMENTS SHALL BE CONSIDERED INCIDENTAL TO OTHER WORK AND NO ADJUSTMENT TO UNIT PRICES WILL BE MADE. CONTRACTOR SHOULD REFERENCE "GUIDANCE MANUAL FOR OPERATORS OF SMALL GAS SYSTEMS": "PIPELINE SAFETY REGULATIONS", PARTS 190, 191, 192, 193, AND 195; BOTH FROM U.S. D.O.T., RESEARCH AND SPECIAL PROGRAMS ADMINISTRATION. THESE DOCUMENTS MAY BE REVIEWED AT THE OFFICE OF THE UTIL. RELO. ENGINEER PRIOR TO BID.

SEE SHT. U5 FOR PROFILE OF THIS LINE

TBA - TO BE ABANDONED


TRIS - TO REMAIN IN SERVICE



*Hank A. Spaulding*



**U2**

RECORD DATE 11/01/13	<b>GLOMAWR BRIDGE REPLACEMENT GAS UTILITY RELOCATION CITY OF HAZARD, KENTUCKY</b>
PROJECT NO. BRZ 1003 (170) ITEM NO. 10-1088.00	
DRAWN BY. EH	
CHECKED BY: HAS	<b>COMMONWEALTH OF KENTUCKY KENTUCKY DEPARTMENT OF HIGHWAYS FRANKFORT, KENTUCKY</b>
SCALE: NOTED	
<b>H. A. SPALDING ENGINEERS 651 SKYLINE DRIVE HAZARD, KENTUCKY 41701 - 1664</b>	

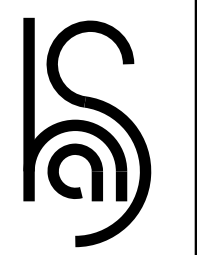

COUNTY OF	ITEM NO.	SHEET NO.
PERRY	10-1088	U2

- SHEET NOTES:
- 1) INLET OF PIPE IS STEEL, OUTLET IS P.E.
  - 2) USE SPLICE BAND SPECIFICALLY MADE FOR THIS PIPE TYPE.
  - 3) BEGIN DIRECTIONAL BORE AT STA. 4+11 AND WORK BACK ACROSS RIVER.
  - 4) ALL TREES TO BE REMOVED TO WITHIN 3" OF GROUND. ALL TREE MATERIAL SHALL BECOME THE PROPERTY OF THE CONTRACTOR AND SHALL BE REMOVED OFF-SITE AND PROPERLY DISPOSED OF.
  - 5) PROVIDE SLIGHT UPSLOPE TOWARDS VENT END OF LINER PIPE.

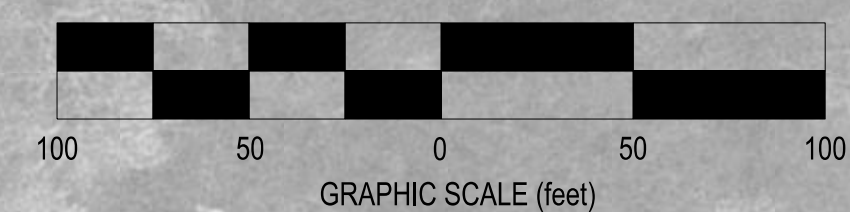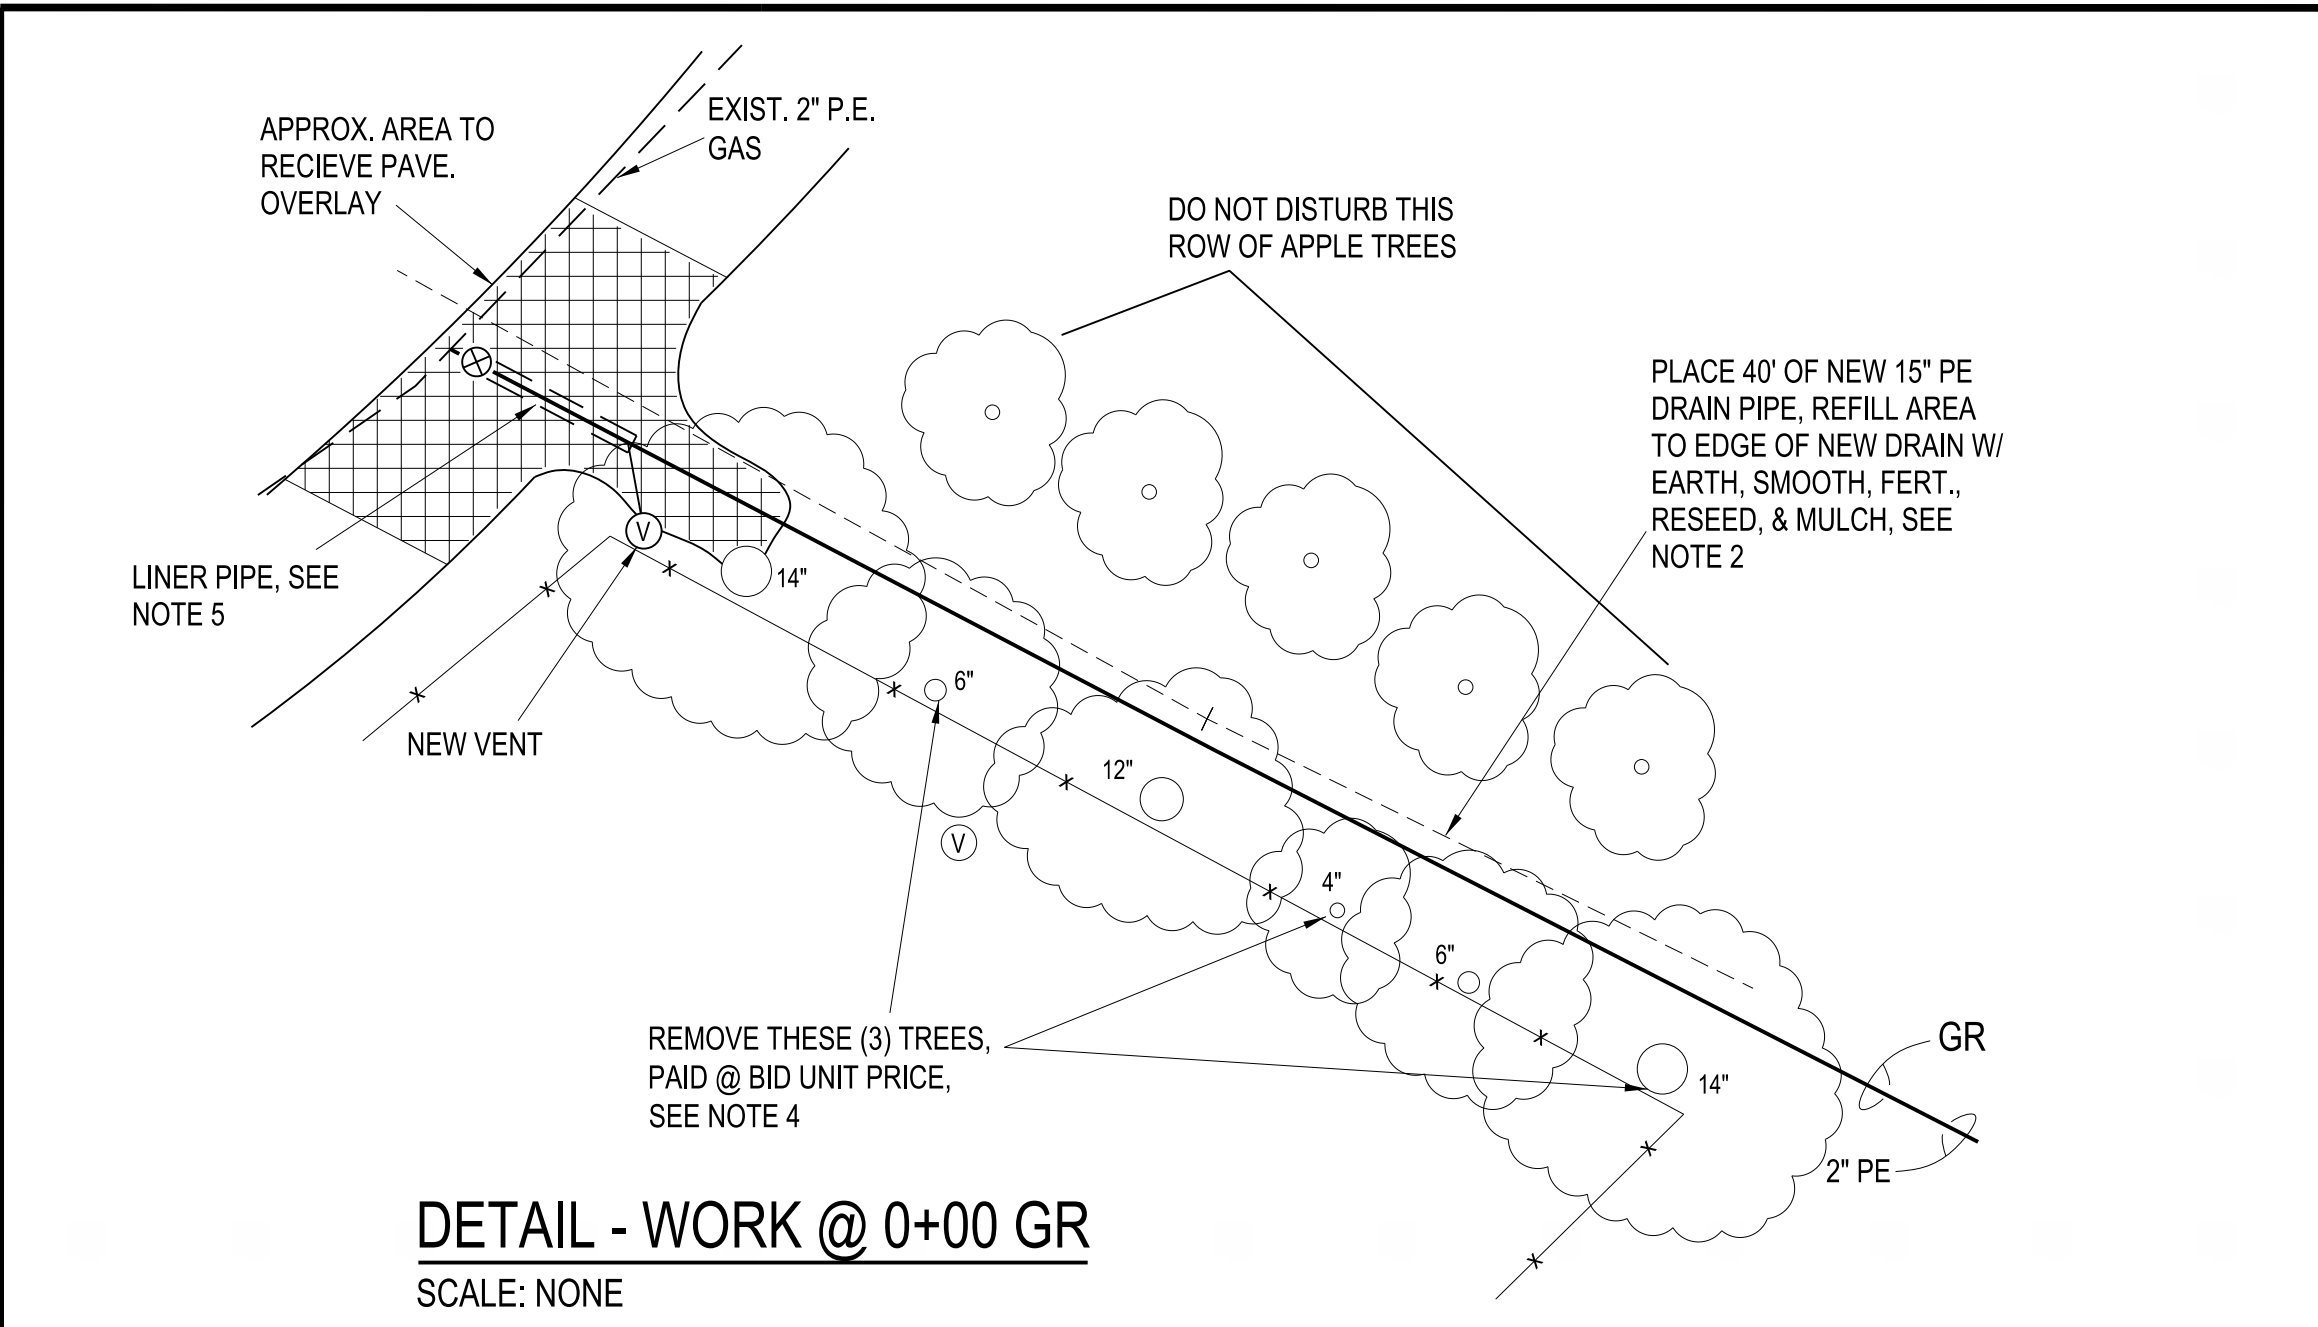

ALL GAS UTILITY WORK TO BE DONE IN STRICT ACCORDANCE WITH ALL U.S. D.O.T. REQUIREMENTS. SOME DETAILS NOT SHOWN ON DRAWINGS BUT SPECIFIED BY THE ABOVE REQUIREMENTS SHALL BE CONSIDERED INCIDENTAL TO OTHER WORK AND NO ADJUSTMENT TO UNIT PRICES WILL BE MADE. CONTRACTOR SHOULD REFERENCE "GUIDANCE MANUAL FOR OPERATORS OF SMALL GAS SYSTEMS": "PIPELINE SAFETY REGULATIONS", PARTS 190, 191, 192, 193, AND 195; BOTH FROM U.S. D.O.T., RESEARCH AND SPECIAL PROGRAMS ADMINISTRATION. THESE DOCUMENTS MAY BE REVIEWED AT THE OFFICE OF THE UTIL. RELO. ENGINEER PRIOR TO BID.

SEE SHT. U5 FOR PROFILE OF THIS LINE

TBA - TO BE ABANDONED


TRIS - TO REMAIN IN SERVICE



*Hank A. Spaulding*



**U2**

RECORD DATE 110113	<b>GLOMAWR BRIDGE REPLACEMENT GAS UTILITY RELOCATION CITY OF HAZARD, KENTUCKY</b>
PROJECT NO. BRZ 1003 (170) ITEM NO. 10-1088.00	
DRAWN BY. EH	
CHECKED BY: HAS	<b>COMMONWEALTH OF KENTUCKY KENTUCKY DEPARTMENT OF HIGHWAYS FRANKFORT, KENTUCKY</b>
SCALE: NOTED	<b>H. A. SPALDING ENGINEERS 651 SKYLINE DRIVE HAZARD, KENTUCKY 41701 - 1664</b>



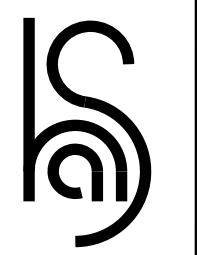


REVISED 11-6-13


USE DEEP CONST. (4'-0" MIN. COVER)  
IN GARDEN AREA

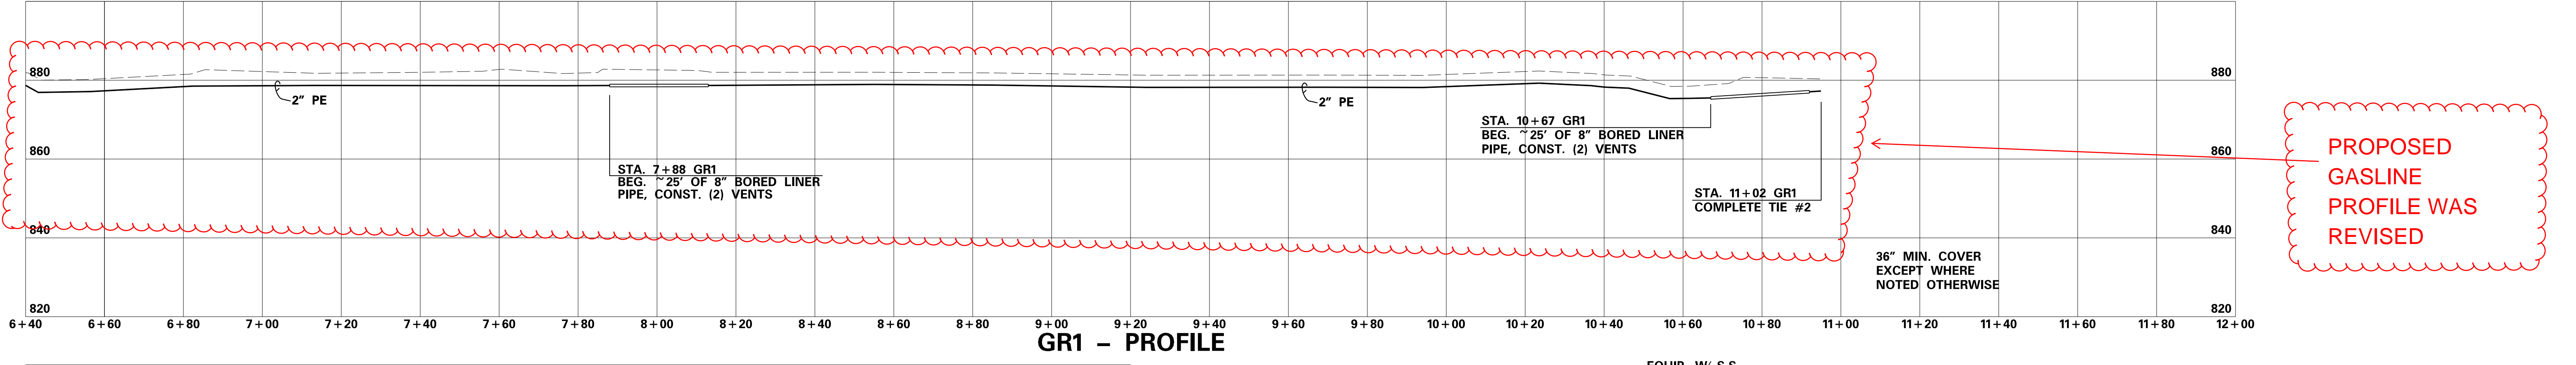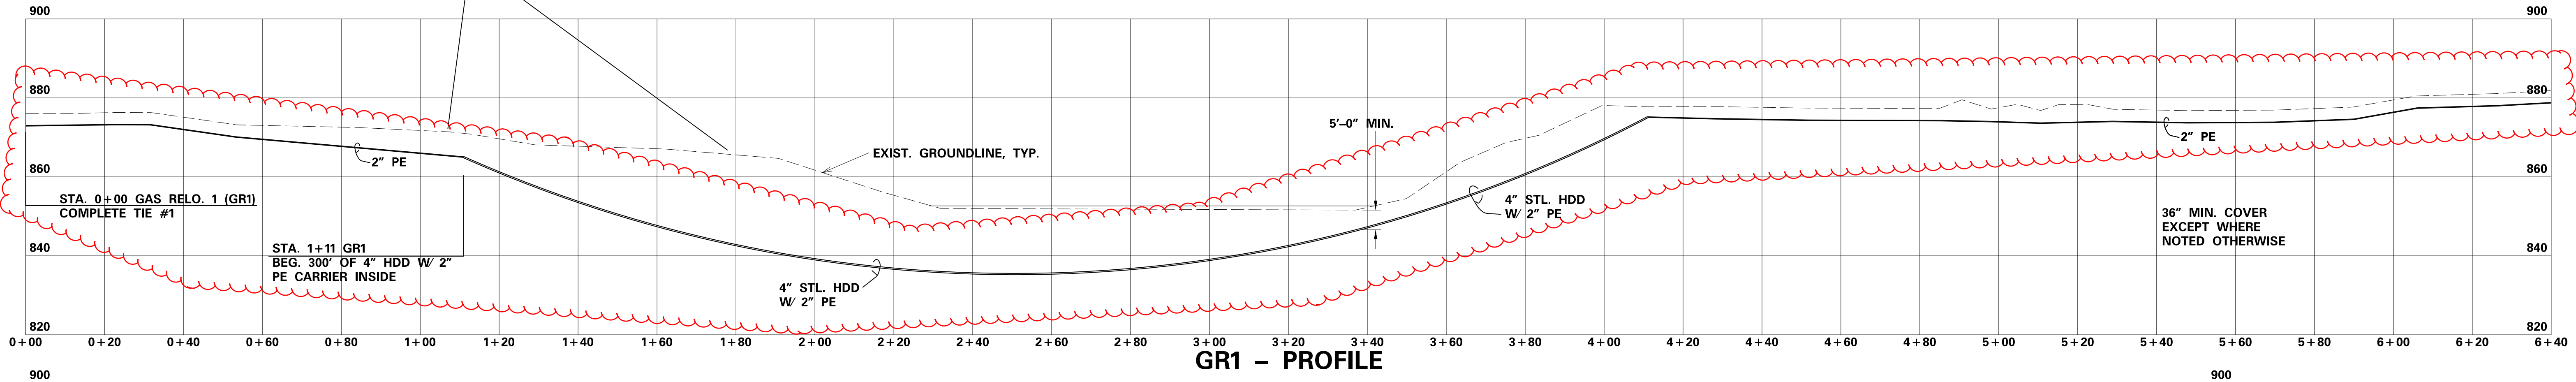

PROPOSED  
GASLINE  
PROFILE WAS  
REVISED

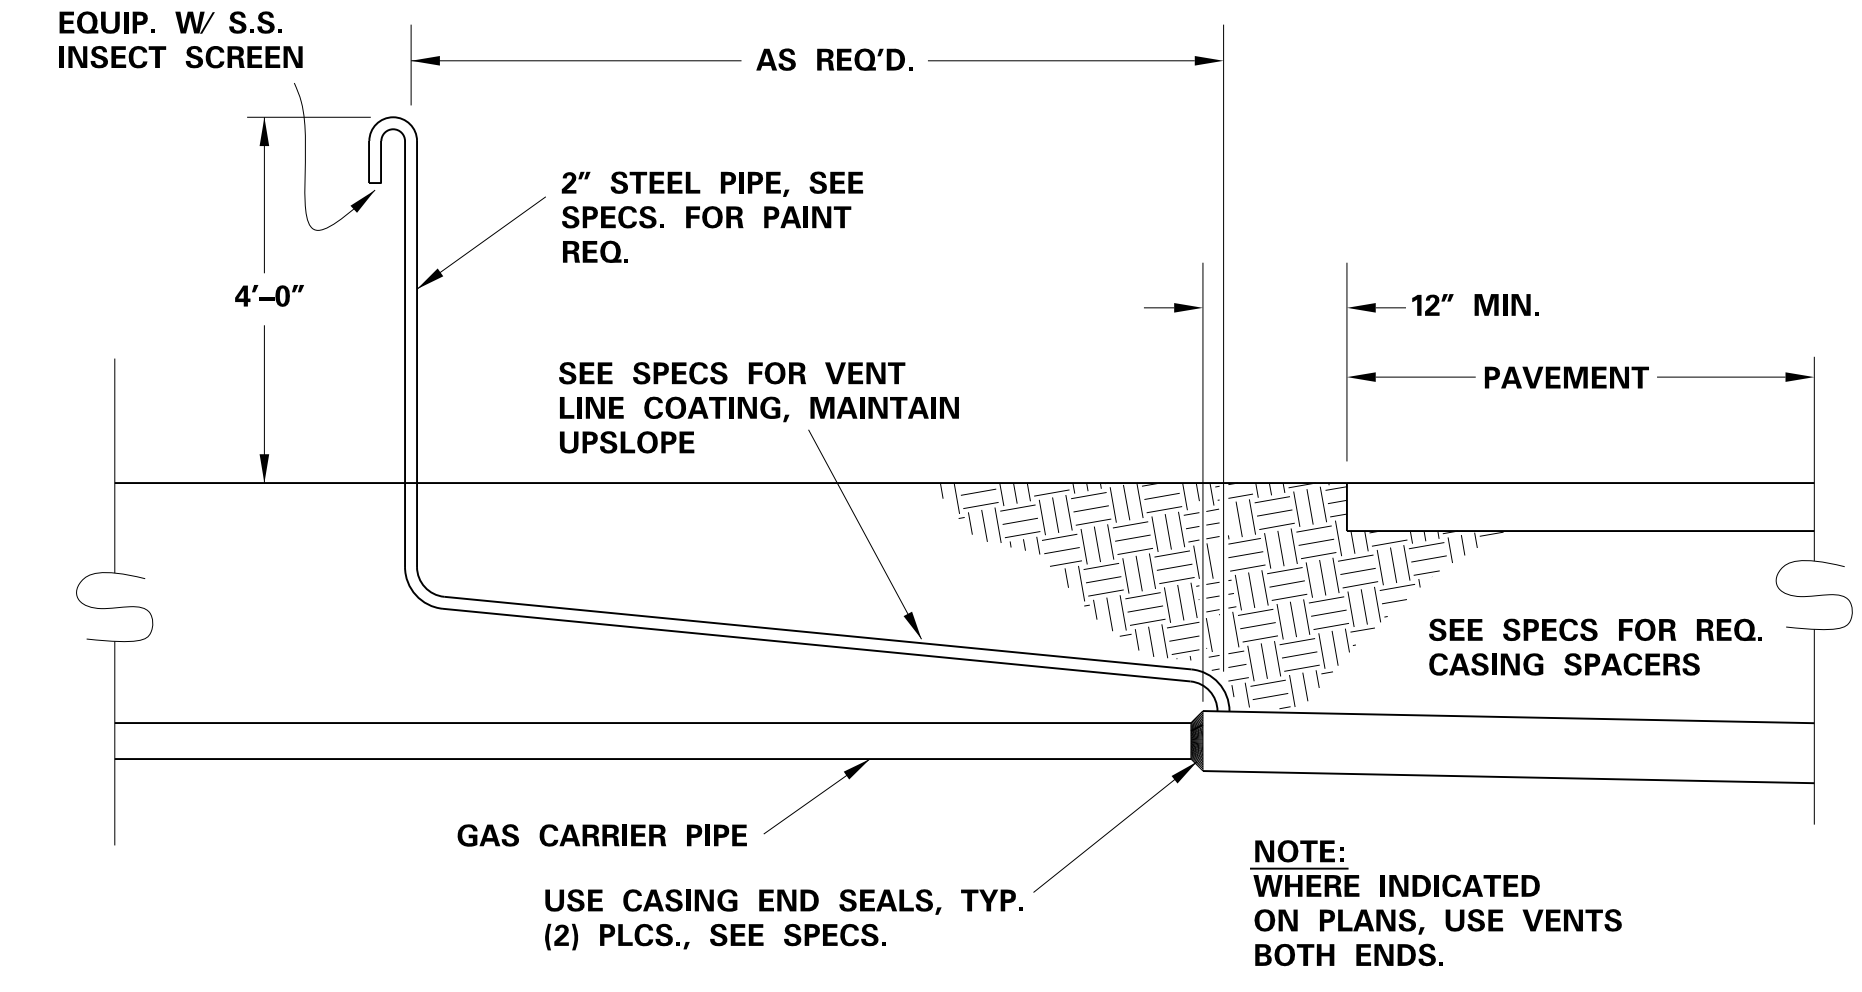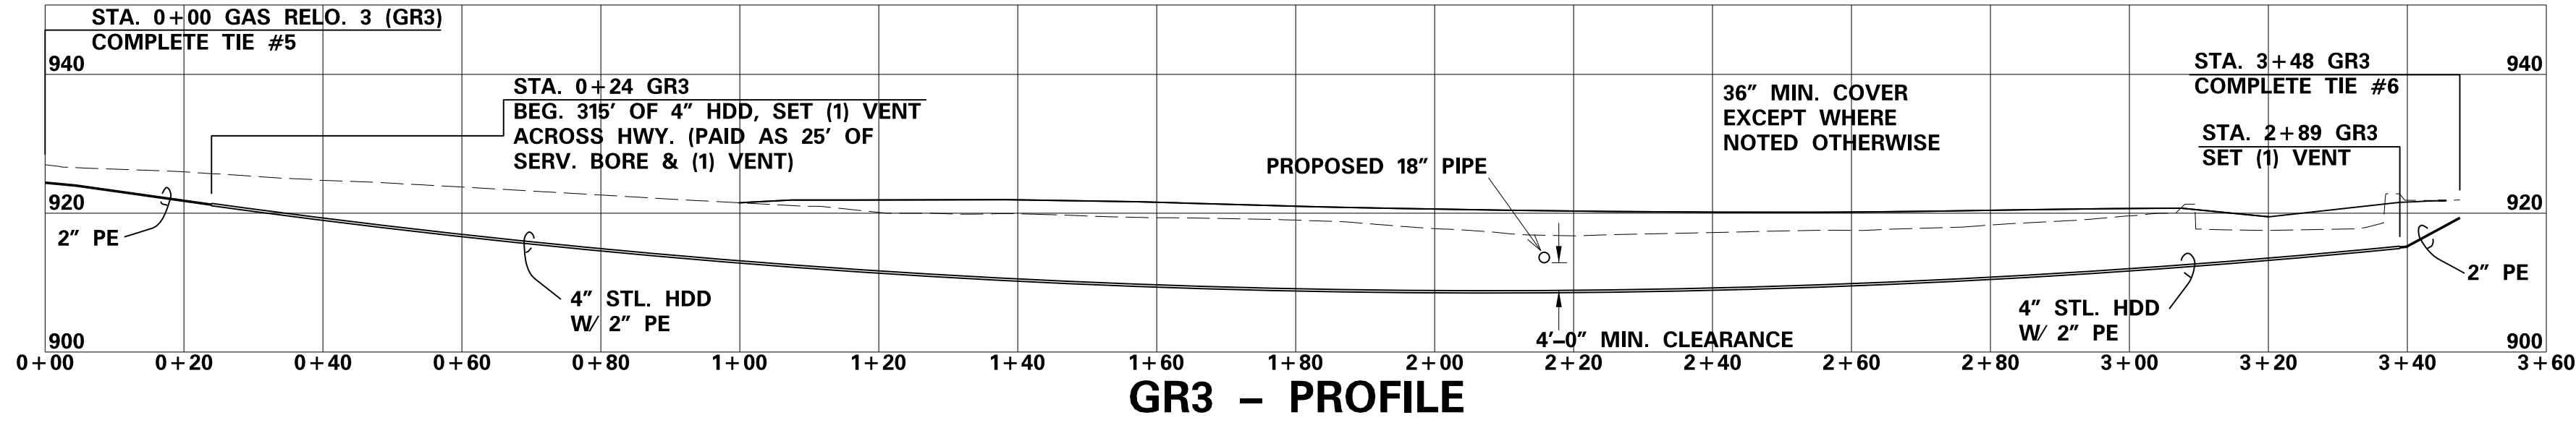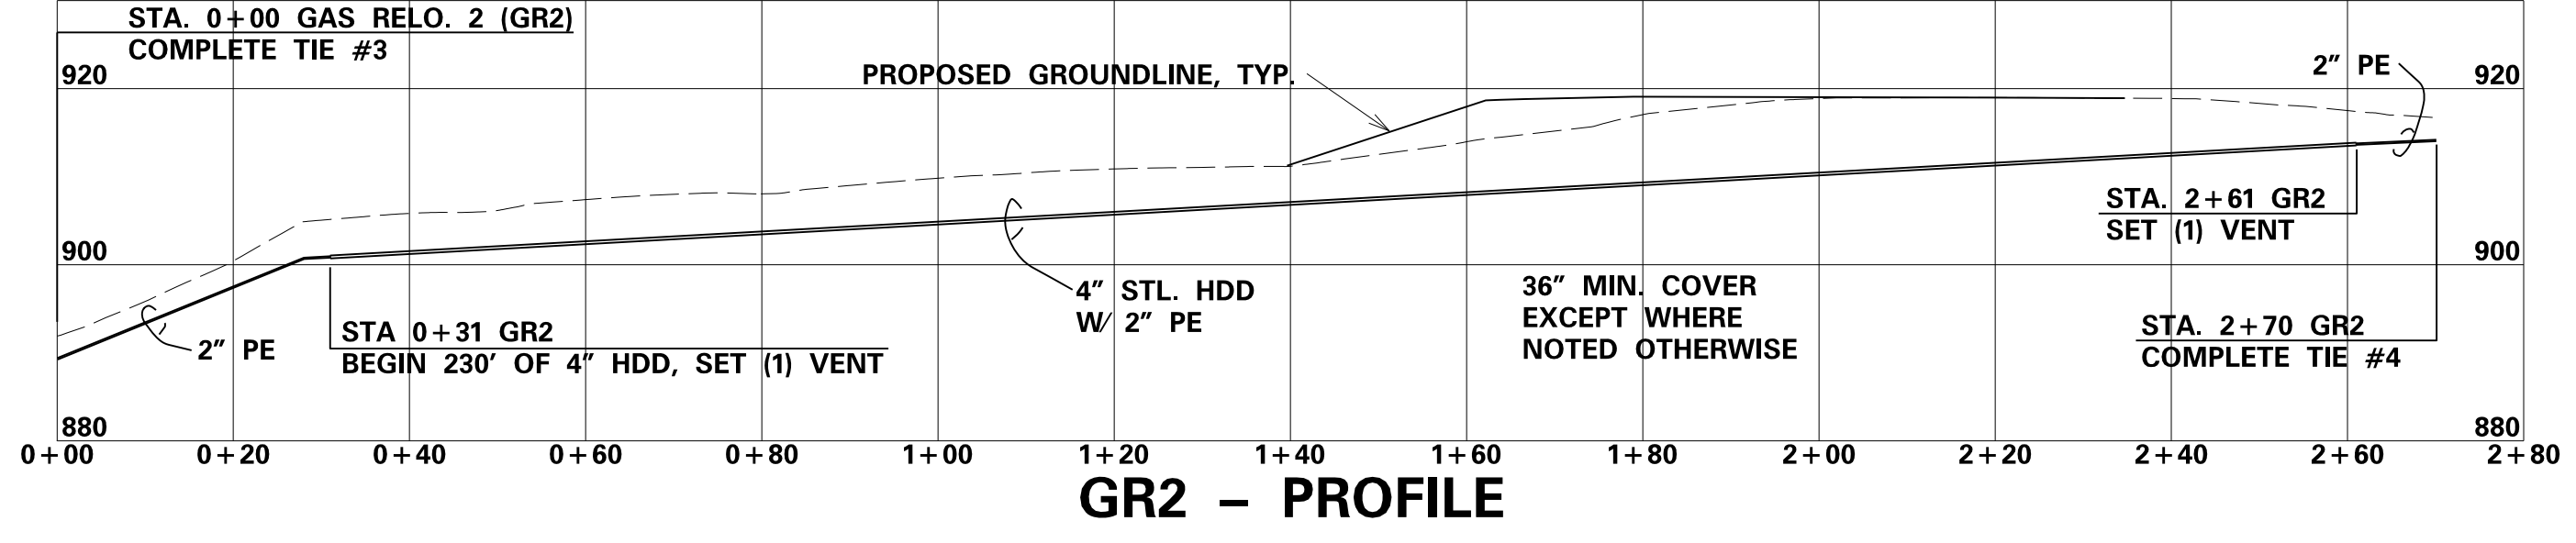


DETAIL - GAS VENT  
SCALE: NONE

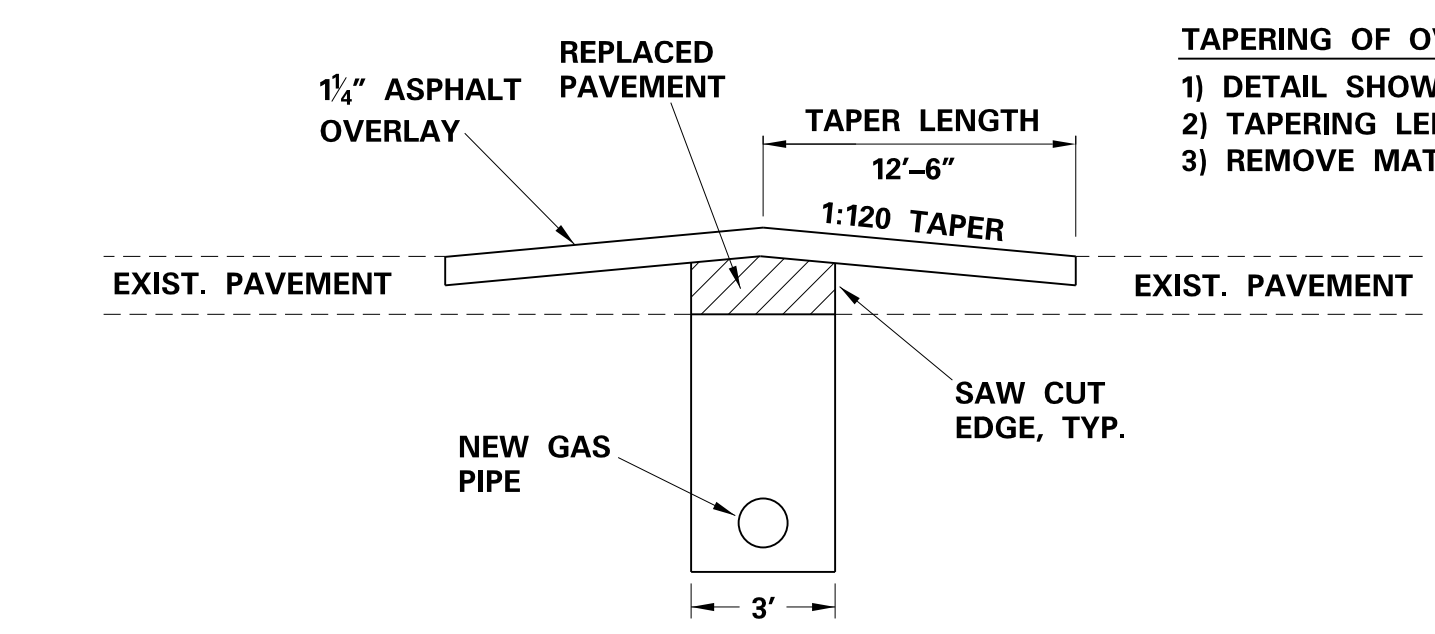

DETAIL - TAPERING OF OVERLAYS  
SCALE: NONE

- TAPERING OF OVERLAYS NOTES:
- 1) DETAIL SHOWN FOR LOW SPEED (<45 mph) ROADWAYS ONLY.
  - 2) TAPERING LENGTH FOR 1-1/4" DEPTH OVERLAY.
  - 3) REMOVE MATERIAL AT TAPER BY MILLING.

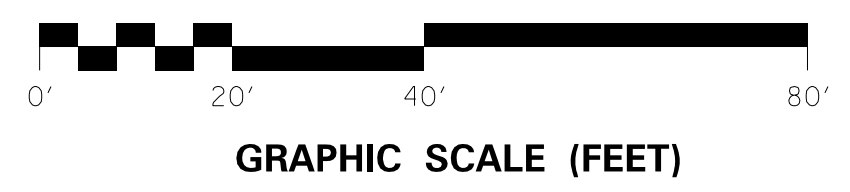

Hank A. Spaulding


U5









RECORD DATE	11/01/13
PROJECT NO.	BRZ 1003 (170)
ITEM NO.	10-1088.00
DRAWN BY.	EH
CHECKED BY.	HAS
SCALE.	NOTED

**GLOMAWR BRIDGE REPLACEMENT  
GAS UTILITY RELOCATION  
CITY OF HAZARD, KENTUCKY**

**COMMONWEALTH OF KENTUCKY  
KENTUCKY DEPARTMENT OF HIGHWAYS  
FRANKFORT, KENTUCKY**

**H. A. SPALDING ENGINEERS  
651 SKYLINE DRIVE  
HAZARD, KENTUCKY 41701 - 1664**

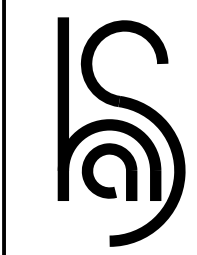


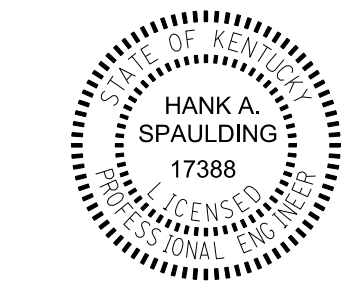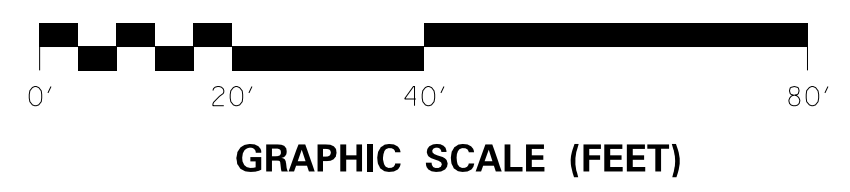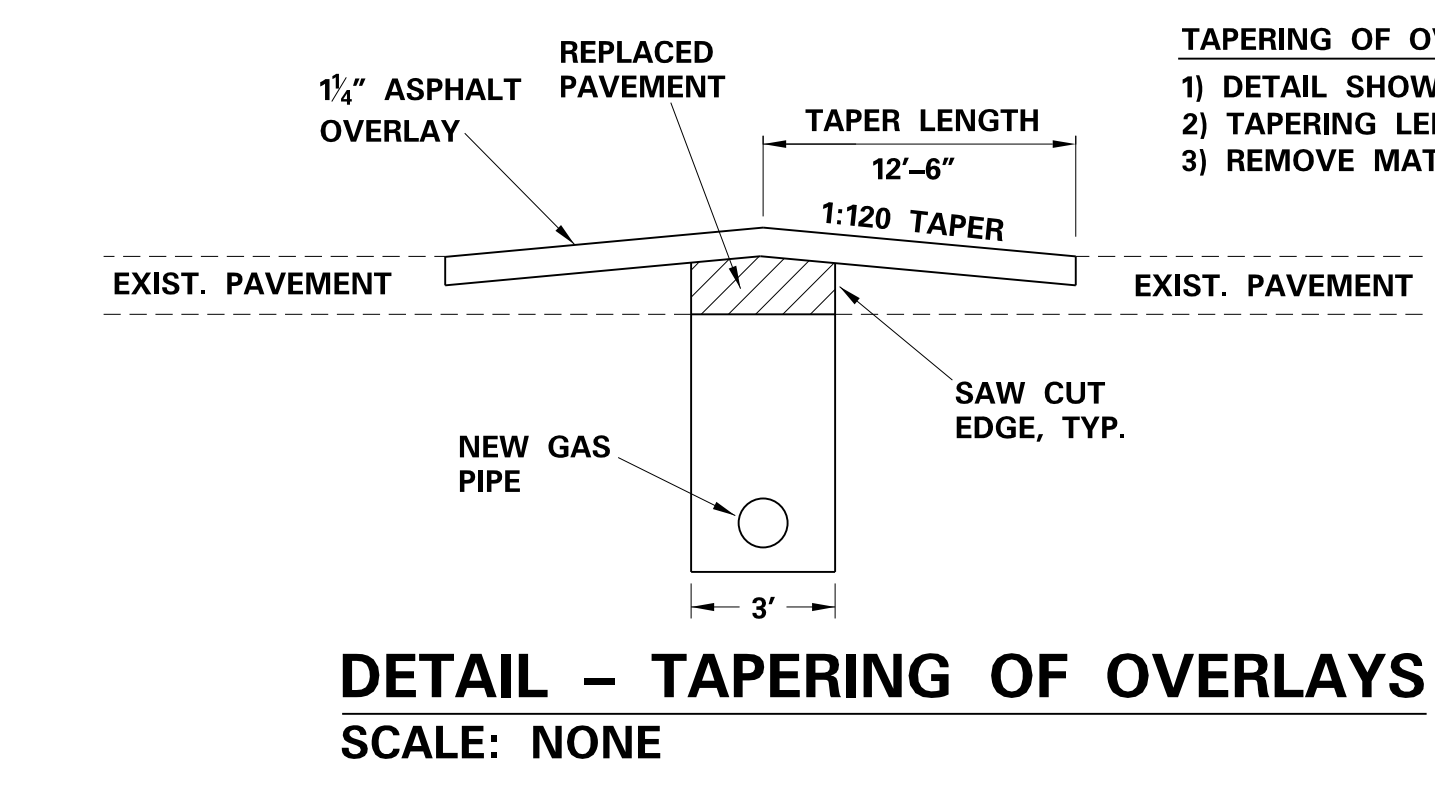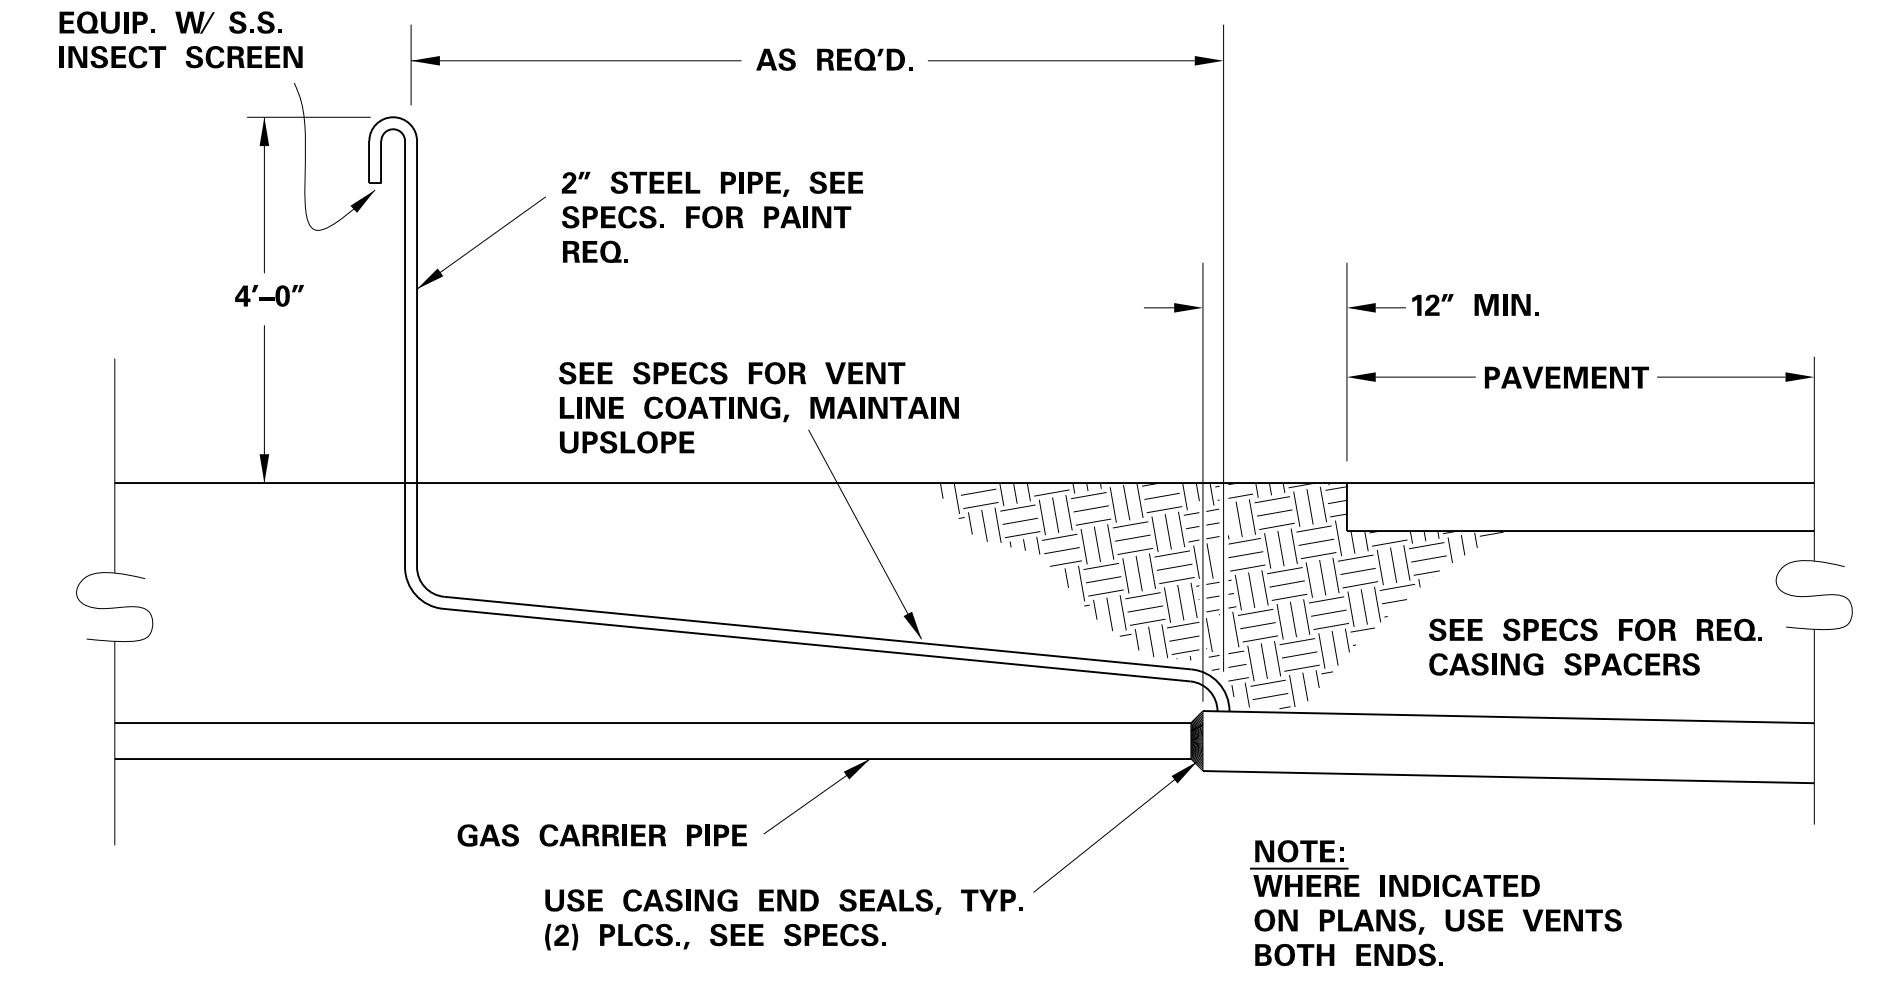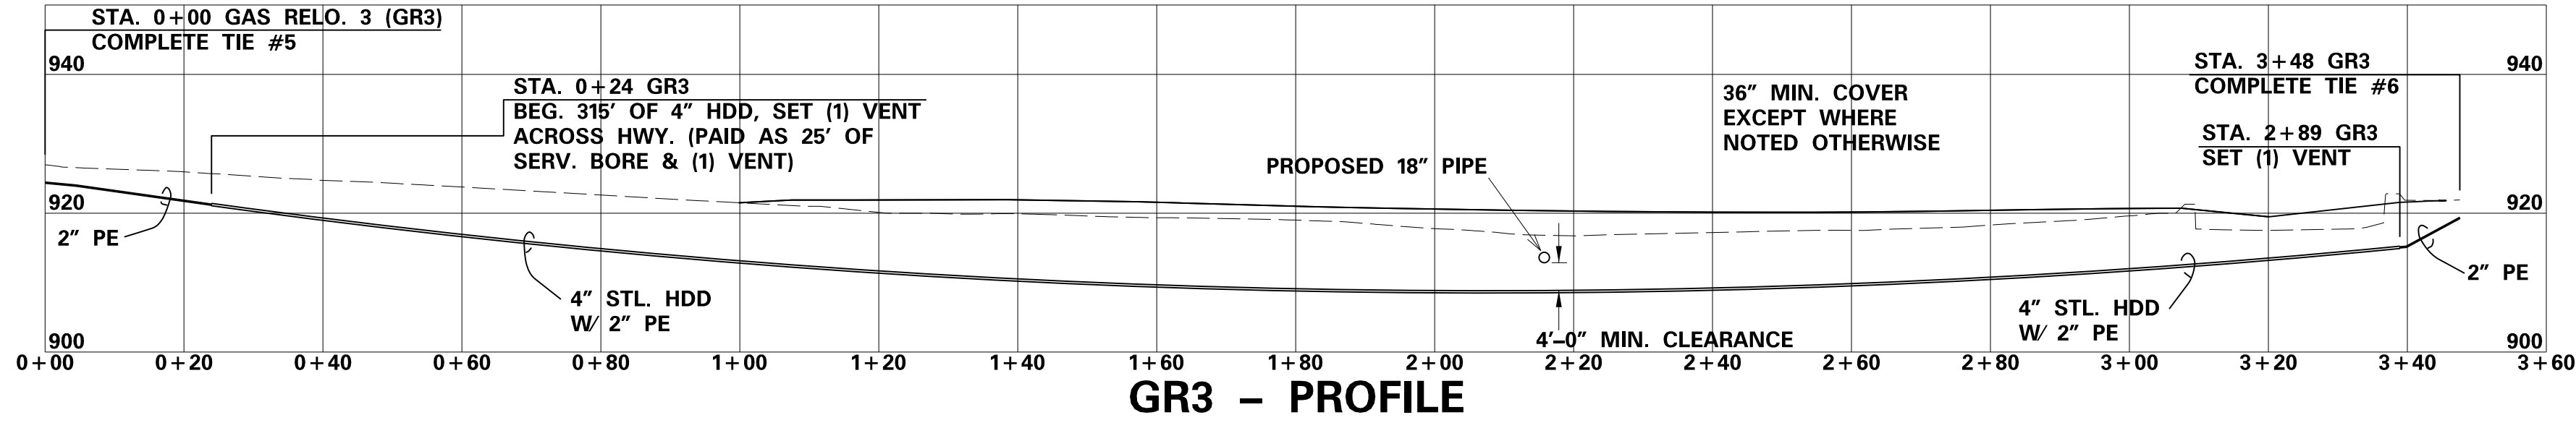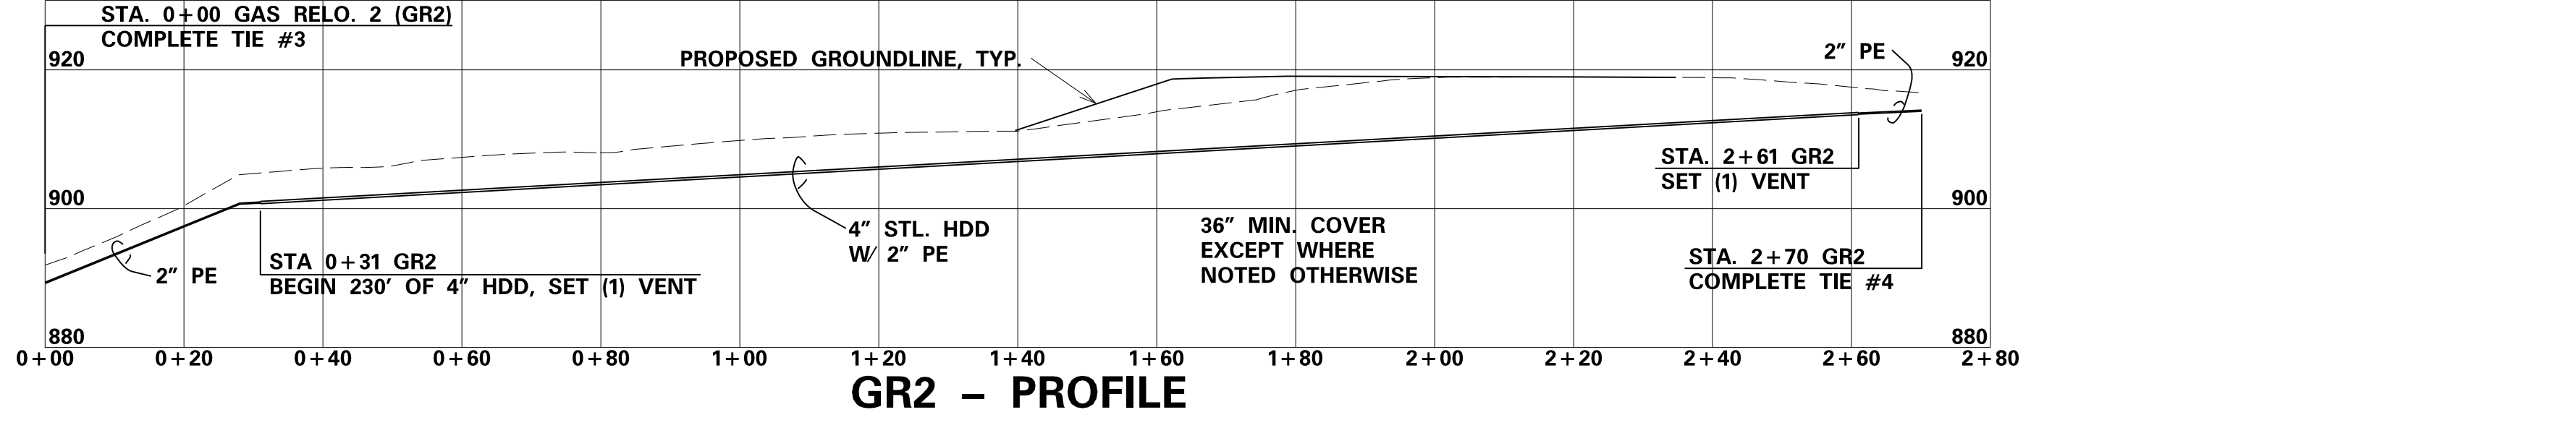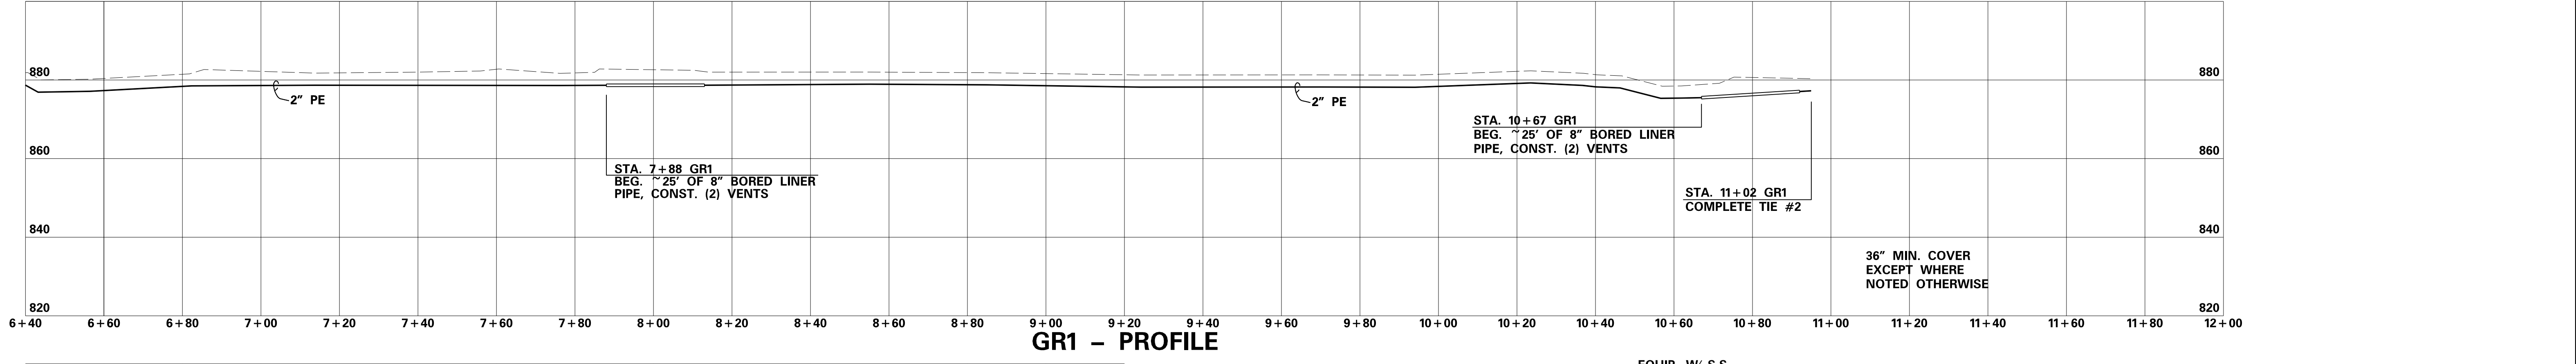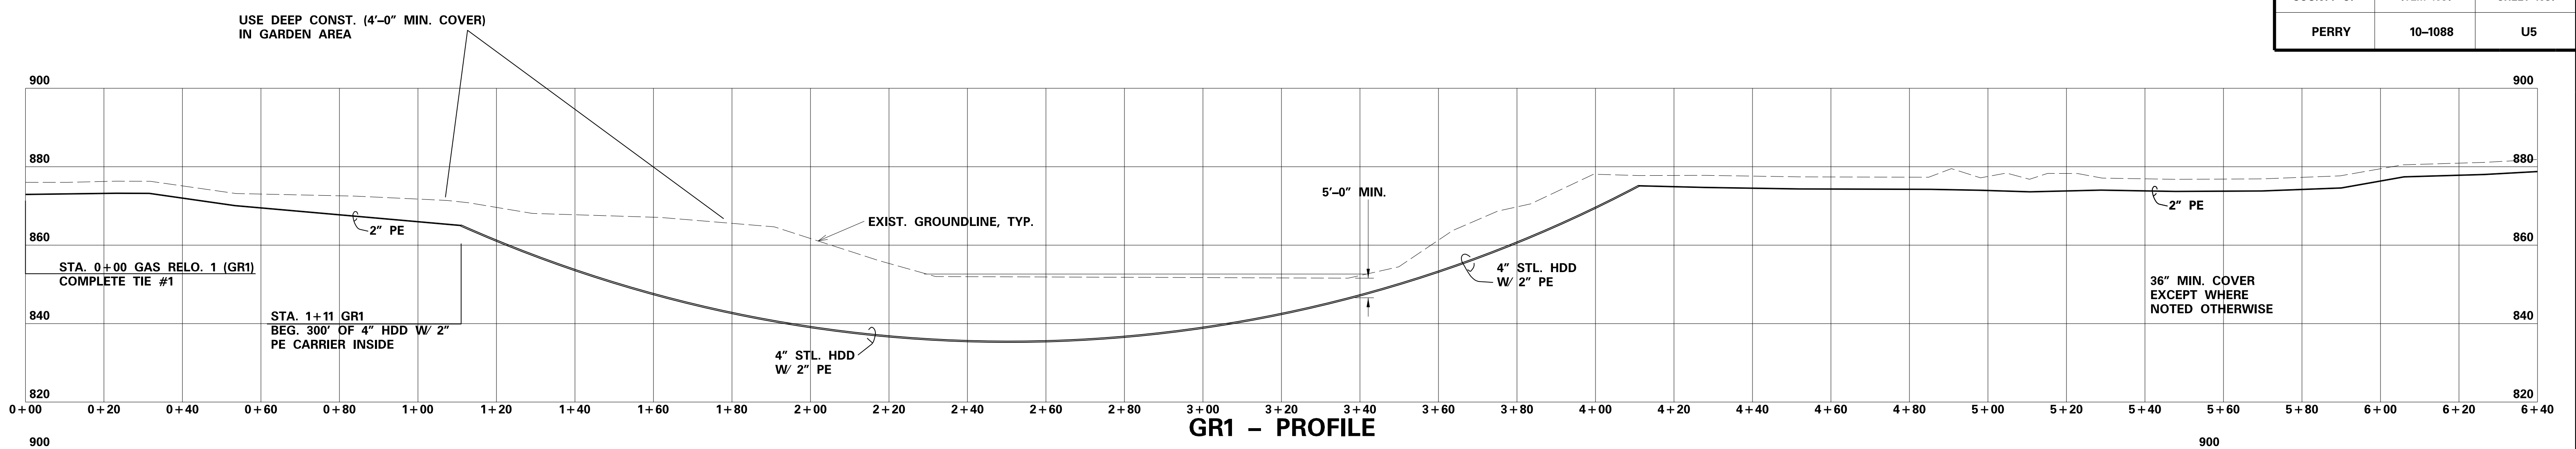

*Hank A. Spaulding*

**U5**

RECORD DATE 11/01/13	<b>GLOMAWR BRIDGE REPLACEMENT GAS UTILITY RELOCATION CITY OF HAZARD, KENTUCKY</b>
PROJECT NO. BRZ 1003 (170) ITEM NO. 10-1088.00	
DRAWN BY. EH	
CHECKED BY. HAS	<b>COMMONWEALTH OF KENTUCKY KENTUCKY DEPARTMENT OF HIGHWAYS FRANKFORT, KENTUCKY</b>
SCALE: NOTED	<b>H. A. SPALDING ENGINEERS 651 SKYLINE DRIVE HAZARD, KENTUCKY 41701 - 1664</b>

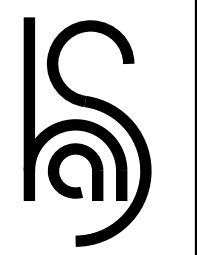

## PROPOSAL BID ITEMS

131221

Page 1 of 5

Report Date 11/7/13

### Section: 0001 - PAVING

LINE	BID CODE	ALT	DESCRIPTION	QUANTITY	UNIT	UNIT PRICE	FP	AMOUNT
0010	00001		DGA BASE	616.00	TON		\$	
0020	00020		TRAFFIC BOUND BASE	50.00	TON		\$	
0030	00078		CRUSHED AGGREGATE SIZE NO 2	25.00	TON		\$	
0040	00080		CRUSHED AGGREGATE SIZE NO 23	1,281.00	TON		\$	
0050	00100		ASPHALT SEAL AGGREGATE	5.00	TON		\$	
0060	00103		ASPHALT SEAL COAT	1.00	TON		\$	
0070	00214		CL3 ASPH BASE 1.00D PG64-22	499.00	TON		\$	
0080	00388		CL3 ASPH SURF 0.38B PG64-22	114.00	TON		\$	

### Section: 0002 - ROADWAY

LINE	BID CODE	ALT	DESCRIPTION	QUANTITY	UNIT	UNIT PRICE	FP	AMOUNT
0090	00080		CRUSHED AGGREGATE SIZE NO 23	1,205.00	TON		\$	
0100	01000		PERFORATED PIPE-4 IN	100.00	LF		\$	
0110	01890		ISLAND HEADER CURB TYPE 1	82.00	LF		\$	
0120	01982		DELINEATOR FOR GUARDRAIL MONO DIRECTIONAL WHITE	10.00	EACH		\$	
0130	02014		BARRICADE-TYPE III	4.00	EACH		\$	
0140	02091		REMOVE PAVEMENT	42.00	SQYD		\$	
0150	02099		CEM CONC ENT PAVEMENT-6 IN	10.00	SQYD		\$	
0160	02157		PAVED DITCH TYPE 1	37.00	SQYD		\$	
0170	02159		TEMP DITCH	1,425.00	LF		\$	
0180	02200		ROADWAY EXCAVATION	680.00	CUYD		\$	
0190	02242		WATER (FOR DUST CONTROL)	1.00	MGAL		\$	
0200	02351		GUARDRAIL-STEEL W BEAM-S FACE	525.00	LF		\$	
0210	02352		GUARDRAIL-STEEL W BEAM-D FACE	125.00	LF		\$	
0220	02360		GUARDRAIL TERMINAL SECTION NO 1	2.00	EACH		\$	
0230	02363		GUARDRAIL CONNECTOR TO BRIDGE END TY A	4.00	EACH		\$	
0240	02367		GUARDRAIL END TREATMENT TYPE 1	1.00	EACH		\$	
0250	02369		GUARDRAIL END TREATMENT TYPE 2A	1.00	EACH		\$	
0260	02371		GUARDRAIL END TREATMENT TYPE 7	1.00	EACH		\$	
0270	02381		REMOVE GUARDRAIL	223.00	LF		\$	
0280	02391		GUARDRAIL END TREATMENT TYPE 4A	1.00	EACH		\$	
0290	02429		RIGHT-OF-WAY MONUMENT TYPE 1	9.00	EACH		\$	
0300	02432		WITNESS POST	3.00	EACH		\$	
0310	02483		CHANNEL LINING CLASS II	147.00	TON		\$	
0320	02484		CHANNEL LINING CLASS III	24.00	TON		\$	
0330	02545		CLEARING AND GRUBBING (APPROXIMATELY 1.0 ACRE)	1.00	LS		\$	
0340	02562		TEMPORARY SIGNS	244.00	SQFT		\$	
0350	02585		EDGE KEY	53.00	LF		\$	
0360	02599		FABRIC-GEOTEXTILE TYPE IV	3,955.00	SQYD		\$	
0370	02650		MAINTAIN & CONTROL TRAFFIC	1.00	LS		\$	
0380	02671		PORTABLE CHANGEABLE MESSAGE SIGN	3.00	EACH		\$	
0390	02696		SHOULDER RUMBLE STRIPS-SAWED	200.00	LF		\$	
0400	02701		TEMP SILT FENCE	1,425.00	LF		\$	



### PROPOSAL BID ITEMS

131221

Report Date 11/7/13

LINE	BID CODE	ALT	DESCRIPTION	QUANTITY	UNIT	UNIT PRICE	FP	AMOUNT
0410	02703		SILT TRAP TYPE A	1.00	EACH		\$	
0420	02704		SILT TRAP TYPE B	3.00	EACH		\$	
0430	02705		SILT TRAP TYPE C	1.00	EACH		\$	
0440	02706		CLEAN SILT TRAP TYPE A	2.00	EACH		\$	
0450	02707		CLEAN SILT TRAP TYPE B	6.00	EACH		\$	
0460	02708		CLEAN SILT TRAP TYPE C	2.00	EACH		\$	
0470	02709		CLEAN TEMP SILT FENCE	1,425.00	LF		\$	
0480	02726		STAKING	1.00	LS		\$	
0490	02731		REMOVE STRUCTURE	1.00	LS		\$	
0500	05950		EROSION CONTROL BLANKET	300.00	SQYD		\$	
0510	05952		TEMP MULCH	8,600.00	SQYD		\$	
0520	05953		TEMP SEEDING AND PROTECTION	570.00	SQYD		\$	
0530	05966		TOPDRESSING FERTILIZER	.01	TON		\$	
0540	05985		SEEDING AND PROTECTION	1,145.00	SQYD		\$	
0550	06406		SBM ALUM SHEET SIGNS .080 IN	34.00	SQFT		\$	
0560	06407		SBM ALUM SHEET SIGNS .125 IN	126.50	SQFT		\$	
0570	06411		STEEL POST TYPE 2	315.00	LF		\$	
0580	06510		PAVE STRIPING-TEMP PAINT-4 IN	2,914.00	LF		\$	
0590	06514		PAVE STRIPING-PERM PAINT-4 IN	2,950.00	LF		\$	
0600	06568		PAVE MARKING-THERMO STOP BAR-24IN	83.00	LF		\$	
0610	06574		PAVE MARKING-THERMO CURV ARROW	4.00	EACH		\$	
0620	21289ED		LONGITUDINAL EDGE KEY	288.00	LF		\$	
0630	22664EN		WATER BLASTING EXISTING STRIPE	303.00	LF		\$	
0640	23394EC		CRASH CUSHION TY VI CLASS C TL3-1	1.00	EACH		\$	

#### Section: 0003 - DRAINAGE

LINE	BID CODE	ALT	DESCRIPTION	QUANTITY	UNIT	UNIT PRICE	FP	AMOUNT
0650	00462		CULVERT PIPE-18 IN	49.00	LF		\$	
0660	01490		DROP BOX INLET TYPE 1	1.00	EACH		\$	
0670	08100		CONCRETE-CLASS A	.93	CUYD		\$	
0680	08150		STEEL REINFORCEMENT	8.00	LB		\$	

#### Section: 0004 - BRIDGE

LINE	BID CODE	ALT	DESCRIPTION	QUANTITY	UNIT	UNIT PRICE	FP	AMOUNT
0690	02231		STRUCTURE GRANULAR BACKFILL	367.00	CUYD		\$	
0700	02998		MASONRY COATING	990.00	SQYD		\$	
0710	03299		ARMORED EDGE FOR CONCRETE	64.30	LF		\$	
0720	08001		STRUCTURE EXCAVATION-COMMON	714.00	CUYD		\$	
0730	08002		STRUCTURE EXCAV-SOLID ROCK	109.00	CUYD		\$	
0740	08019		CYCLOPEAN STONE RIP RAP	236.00	TON		\$	
0750	08020		CRUSHED AGGREGATE SLOPE PROT	191.00	TON		\$	
0760	08033		TEST PILES	148.00	LF		\$	
0770	08046		PILES-STEEL HP12X53	421.00	LF		\$	
0780	08094		PILE POINTS-12 IN	18.00	EACH		\$	
0790	08100		CONCRETE-CLASS A	516.80	CUYD		\$	
0800	08104		CONCRETE-CLASS AA	527.10	CUYD		\$	

**PROPOSAL BID ITEMS**

131221

Report Date 11/7/13

LINE	BID CODE	ALT	DESCRIPTION	QUANTITY	UNIT	UNIT PRICE	FP	AMOUNT
0810	08150		STEEL REINFORCEMENT	78,894.00	LB		\$	
0820	08151		STEEL REINFORCEMENT-EPOXY COATED	139,356.00	LB		\$	
0830	08160		STRUCTURAL STEEL (APPROXIMATELY 3,125 LBS., DRAINS)	1.00	LS		\$	
0840	08638		PRECAST PC I BEAM TYPE 8	1,737.30	LF		\$	
0850	08711		BRIDGE CHAIN LINK FENCE-6 FT	232.00	LF		\$	
0860	21532ED		RAIL SYSTEM TYPE III	876.90	LF		\$	
0870	24088EC		COFFERDAM ADJACENT TO RAILROAD	1.00	EACH		\$	

**Section: 0005 - GAS UTILITY RELOCATION**

LINE	BID CODE	ALT	DESCRIPTION	QUANTITY	UNIT	UNIT PRICE	FP	AMOUNT
0880	00461		CULVERT PIPE-15 IN (POLYETHYLENE PIPE)	40.00	LF		\$	
0890	02220		FLOWABLE FILL	25.00	CUYD		\$	
0900	02460		REMOVE TREES OR STUMPS	3.00	EACH		\$	
0910	02677		ASPHALT PAVE MILLING & TEXTURING	2.00	TON		\$	
0920	21661ES706		BORE AND JACK PIPE (8 INCH BORED LINER PIPE) REVISED: 11-7-13	50.00	LF		\$	
0930	21772NN		VENT- COMPLETE IN PLACE	9.00	EACH		\$	
0940	21773NN		GAS LINE MARKER	13.00	EACH		\$	
0950	21788ED		OPEN CUT W/ STEEL ENCASEMENT (4 INCH OPEN CUT LINER PIPE)	12.00	LF		\$	
0960	21846EN		POLYETHYLENE GAS MAIN-2 IN	1,780.00	LF		\$	
0970	21938EN		SERVICE BORE	25.00	LF		\$	
0980	22093NN		TIE IN TO GAS LINE	6.00	EACH		\$	
0990	22668EN		DIRECTIONAL BORE (4" STEEL ENCASEMENT PIPE) ADDED:11-7-13	845.00	LF		\$	
1000	23300ED		CRUSHED STONE	100.00	TON		\$	
1010	23337EC		GAS VALVE-2 IN (VALVE & BOX)	6.00	EACH		\$	
1020	23340EC		PAVEMENT REPLACEMENT	10.00	TON		\$	
1030	23341EC		GENERAL CONCRETE	5.00	CUYD		\$	

**Section: 0006 - LIGHTING**

LINE	BID CODE	ALT	DESCRIPTION	QUANTITY	UNIT	UNIT PRICE	FP	AMOUNT
1040	04701		POLE 40 FT MTG HT	2.00	EACH		\$	
1050	04724		BRACKET 12 FT	1.00	EACH		\$	
1060	04725		BRACKET 15 FT	1.00	EACH		\$	
1070	04740		POLE BASE	2.00	EACH		\$	
1080	04750		TRANSFORMER BASE	2.00	EACH		\$	
1090	04760		POLE W/SECONDARY CONTROL EQUIP	1.00	EACH		\$	
1100	04770		HPS LUMINAIRE	2.00	EACH		\$	
1110	04780		FUSED CONNECTOR KIT	4.00	EACH		\$	
1120	04793		CONDUIT-1 1/4 IN	60.00	LF		\$	
1130	04795		CONDUIT-2 IN	180.00	LF		\$	
1140	04820		TRENCHING AND BACKFILLING	60.00	LF		\$	
1150	04832		WIRE-NO. 12	140.00	LF		\$	

**PROPOSAL BID ITEMS**

131221

Report Date 11/7/13

LINE	BID CODE	ALT	DESCRIPTION	QUANTITY	UNIT	UNIT PRICE	FP	AMOUNT
1160	04833		WIRE-NO. 8	660.00	LF		\$	
1170	20391NS835		ELECTRICAL JUNCTION BOX TYPE A	3.00	EACH		\$	
1180	21543EN		BORE AND JACK CONDUIT	180.00	LF		\$	

**Section: 0007 - TRAFFIC SIGNALS**

LINE	BID CODE	ALT	DESCRIPTION	QUANTITY	UNIT	UNIT PRICE	FP	AMOUNT
1190	04792		CONDUIT-1 IN	30.00	LF		\$	
1200	04793		CONDUIT-1 1/4 IN	2,000.00	LF		\$	
1210	04795		CONDUIT-2 IN	80.00	LF		\$	
1220	04811		ELECTRICAL JUNCTION BOX TYPE B	9.00	EACH		\$	
1230	04820		TRENCHING AND BACKFILLING	2,020.00	LF		\$	
1240	04830		LOOP WIRE	815.00	LF		\$	
1250	04844		CABLE-NO. 14/5C	5,530.00	LF		\$	
1260	04850		CABLE-NO. 14/1 PAIR	1,150.00	LF		\$	
1270	04885		MESSENGER-10800 LB	830.00	LF		\$	
1280	04895		LOOP SAW SLOT AND FILL	275.00	LF		\$	
1290	04931		INSTALL CONTROLLER TYPE 170	1.00	EACH		\$	
1300	04932		INSTALL STEEL STRAIN POLE	8.00	EACH		\$	
1310	04950		REMOVE SIGNAL EQUIPMENT	1.00	EACH		\$	
1320	06472		INSTALL SPAN MOUNTED SIGN	1.00	EACH		\$	
1330	20094ES835		TEMP RELOCATION OF SIGNAL HEAD	6.00	EACH		\$	
1340	20188NS835		INSTALL LED SIGNAL-3 SECTION	9.00	EACH		\$	
1350	22939ND		INSTALL LUMINAIRE POLE	2.00	EACH		\$	
1360	23068NN		REMOVE & REINSTALL COORDINATING UNIT	1.00	EACH		\$	
1370	23157EN		TRAFFIC SIGNAL POLE BASE	36.90	CUYD		\$	
1380	24525EC		ADVANCE WARNING FLASHER	2.00	EACH		\$	

**Section: 0008 - WATERLINE UTILITY RELOCATION**

LINE	BID CODE	ALT	DESCRIPTION	QUANTITY	UNIT	UNIT PRICE	FP	AMOUNT
1390	03382		PVC PIPE-3 IN (SDR 17)	1,700.00	LF		\$	
1400	03460		TIE-IN TO WATER LINE	2.00	EACH		\$	
1410	20156EC		FIRE HYDRANT ASSEMBLY	1.00	EACH		\$	
1420	20186ED		REINFORCED CONCRETE SLAB	100.00	SQYD		\$	
1430	20582ND		PROPOSED WATER METER (5/8" X 3/4" METER, INDIVIDUAL PRV, S-BAR)	3.00	EACH		\$	
1440	21213ED		CONCRETE PAVING REPLACEMENT	25.00	LF		\$	
1450	21384ED		BORE AND JACK PIPE-6 IN (STEEL CASING PIPE)	140.00	LF		\$	
1460	21938EN		SERVICE BORE	50.00	LF		\$	
1470	22864NN		TIE-IN W/GATE VALVE-3 IN	3.00	EACH		\$	
1480	24441EC		GRAVEL REPLACEMENT DRIVEWAYS	10.00	LF		\$	
1490	24484ED		PE SERVICE TUBING (3/4 INCH SERVICE LINE)	175.00	LF		\$	

### PROPOSAL BID ITEMS

131221

Page 5 of 5

Report Date 11/7/13

#### Section: 0009 - MOBILIZATION AND DEMOBILIZATION

LINE	BID CODE	ALT	DESCRIPTION	QUANTITY	UNIT	UNIT PRICE	FP	AMOUNT
1500	02568		MOBILIZATION	1.00	LS		\$	
1510	02569		DEMOBILIZATION	1.00	LS		\$	