



TRANSPORTATION CABINET

Frankfort, Kentucky 40622
www.transportation.ky.gov/

Steven L. Beshear
Governor

Michael W. Hancock, P.E.
Acting Secretary

June 16, 2010

CALL NO. 405
CONTRACT ID NO. 102932
ADDENDUM # 1

Subject: Pendleton County, 096GR10M027-FE02
Letting June 25, 2010

- (1) Revised - Special Notes Bridge Cleaning & Painting - Page 6 of 90
- (2) Revised - Drawing - Page 45 of 90

Proposal revisions are available at <http://transportation.ky.gov/contract/>.

If you have any questions, please contact us at 502-564-3500.

Sincerely,

A handwritten signature in cursive script that reads "Ryan Griffith".

Ryan Griffith, P.E.
Director
Division of Construction Procurement

Enclosures
RG:ks



An Equal Opportunity Employer M/F/D

SPECIAL NOTES BRIDGE CLEANING AND PAINTING

PENDLETON COUNTY DISTRICT NO. 6

096GR10M027

FE02 096 0177 B00001N 4.91

KY 177 over South Fork of Licking River

Geographic Coordinates

Latitude – 38° 47' 23.40''

Longitude – 084° 22' 02.37''

Description:

84 ft Steel Girder Span ~ 3-150 ft Steel Through Truss Spans ~ 84 ft Steel Girder Span

FE02 096 1054 B00027N 3.49

KY 1054 over South Fork of Licking River

Geographic Coordinates

Latitude – 38° 36' 11.32''

Longitude – 084° 24' 01.07''

Description:

81 ft Steel ~ 100'-0" ft ~ 81 ft Steel Girder Span

FE02 096 0027 B00002N 8.21

US 27 over South Fork of Licking River

Geographic Coordinates

Latitude – 38° 40' 46.50''

Longitude – 084° 20' 45.14''

Description:

52 ft – 17 ft – 100 ft – 71 ft – 50 ft -50 ft -52 ft Steel Girder Spans

FE02 096 0027 B00018N 15.85

US 27 over CSX RR and CR 5011 (Hogback Ridge Road)

Geographic Coordinates



Latitude – 38° 46' 28.15''

Longitude – 084° 21' 05.92''

Description:

43 ft – 43 ft RCDG Spans ~ 71 ft -100 ft-71 ft Steel Girder Spans ~ 43 ft – 43 ft RCDG Spans

096B00002

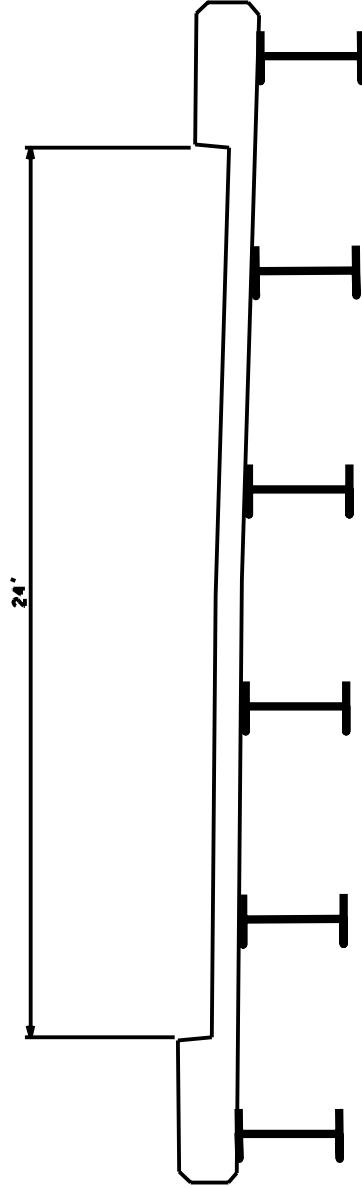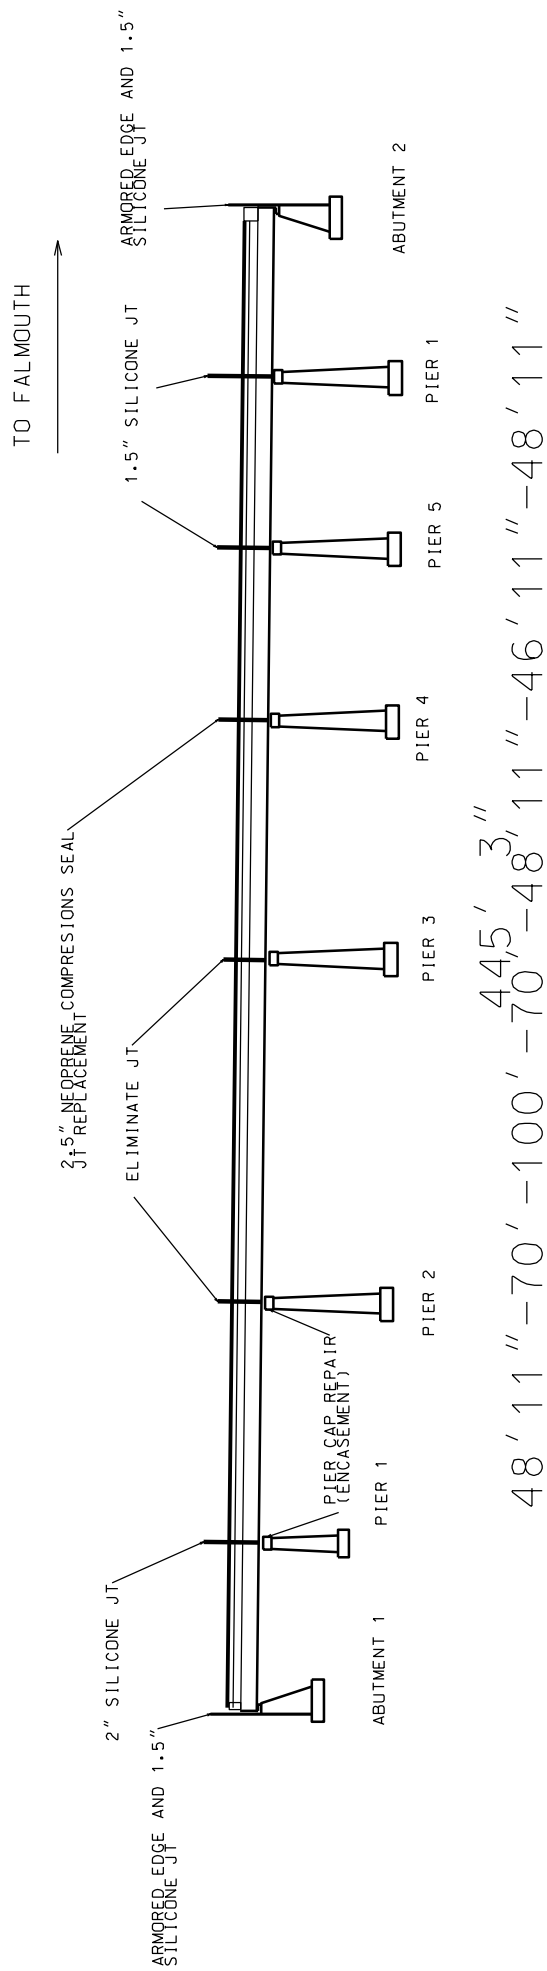

NOT TO SCALE