









APPENDIX A

EXHIBIT 1

ITEM NO. 11-147
PROJECT STUDY AREA

US-25
DNA PRE-DESIGN
SCOPING STUDY,
LAUREL COUNTY

Legend

-  Mardis St.
-  KY-229
-  Commercial Dr./James Lewis Dr.
-  Interstate
-  Parkway
-  US Highway
-  State Road
-  Local Road

510 255 0 510 1,020 Feet



Project Study Area (A) -
Mardis St & KY-229 from KY-192
(Bypass) to US-25 to include intersections

Project Study Area (B) -
Commercial Dr. & James Lewis Dr.
to include US-25 & KY-229 intersections



EXHIBIT 2

ITEM NO. 11-147
PROJECT TOPOGRAPHIC
AREA

US-25
DNA PRE-DESIGN
SCOPING STUDY:
LAUREL COUNTY

Legend

- Mardis St.
- KY-229
- Commercial Dr./James Lewis Dr.
- Interstate
- Parkway
- US Highway
- State Road
- Local Road

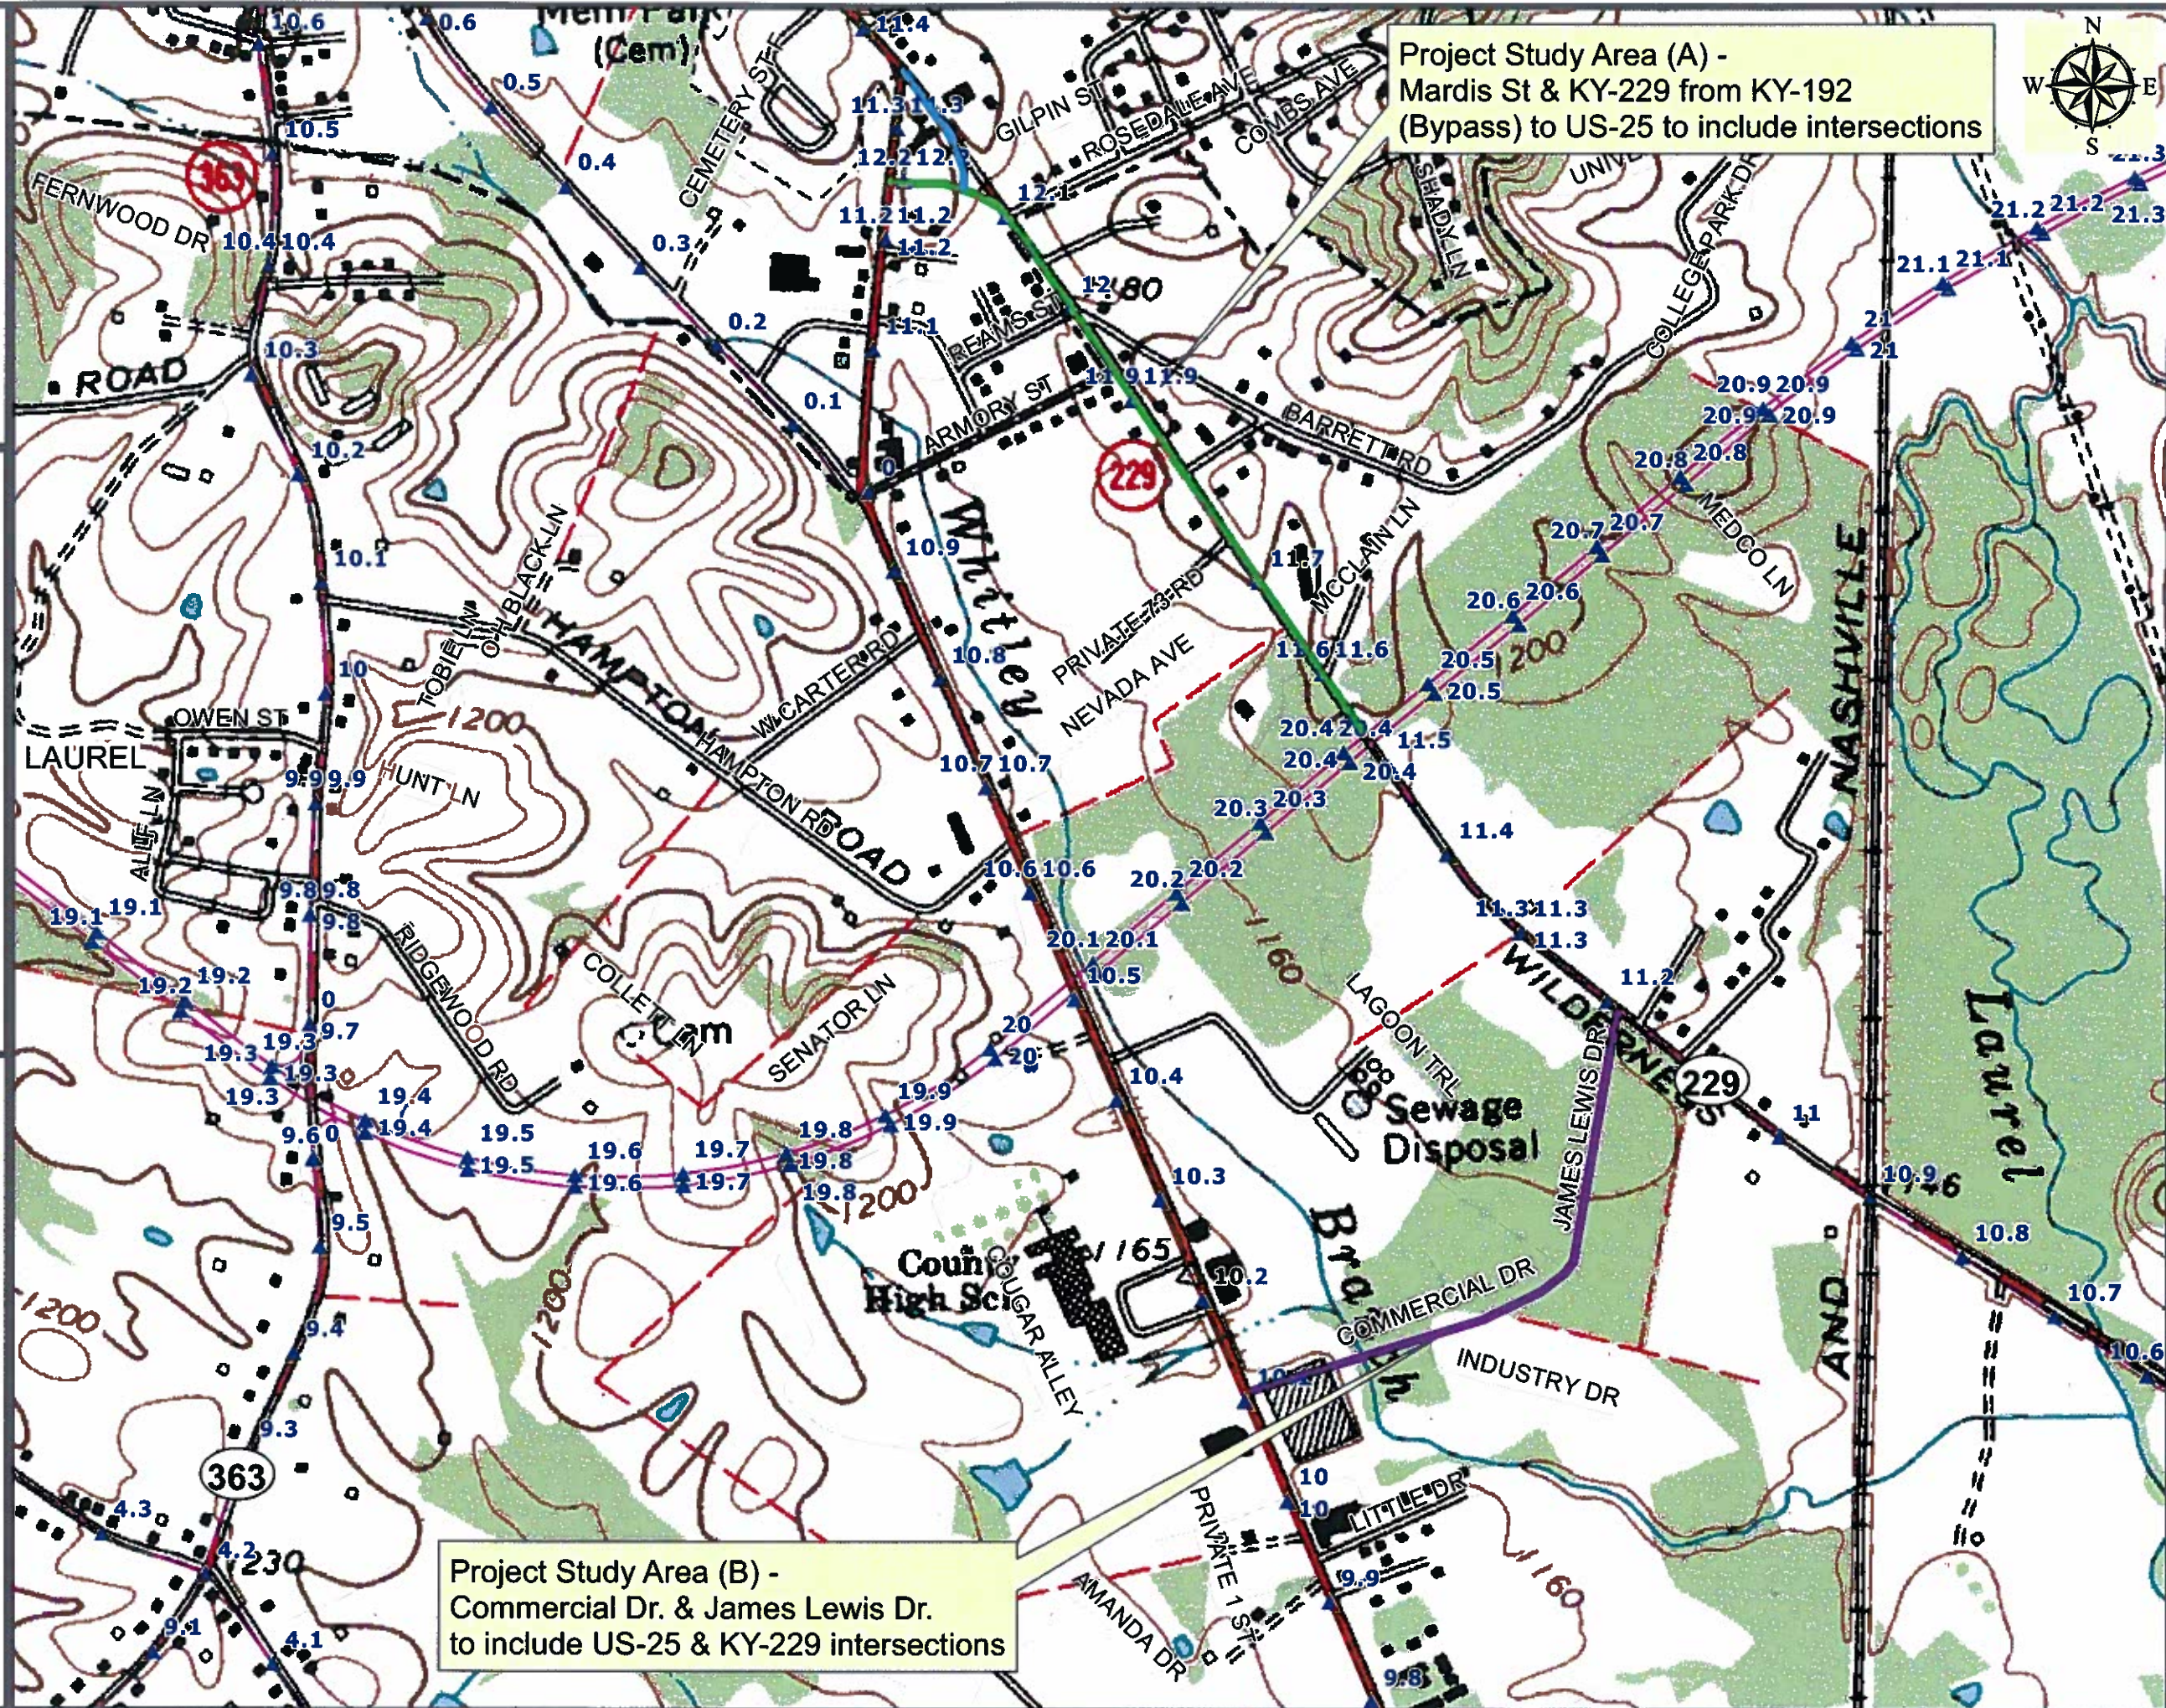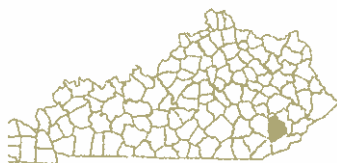

Project Study Area (A) -
Mardis St & KY-229 from KY-192
(Bypass) to US-25 to include intersections










Project Study Area (B) -
Commercial Dr. & James Lewis Dr.
to include US-25 & KY-229 intersections

EXHIBIT 3

ITEM NO. 11-147
PROJECT AREA UTILITY MAP

US-25
DNA PRE-DESIGN
SCOPING STUDY:
LAUREL COUNTY

Legend

-  Project Area A-KY-229
-  Project Area B-Commercial Dr./James Lewis Dr.
-  Interstate
-  US Highway
-  State Road
-  Local Road
-  Water Lines
-  Sewer Lines
-  Electric Power Lines
-  1/10th Mile Calculated Interval
-  Wastewater Treatment Plants

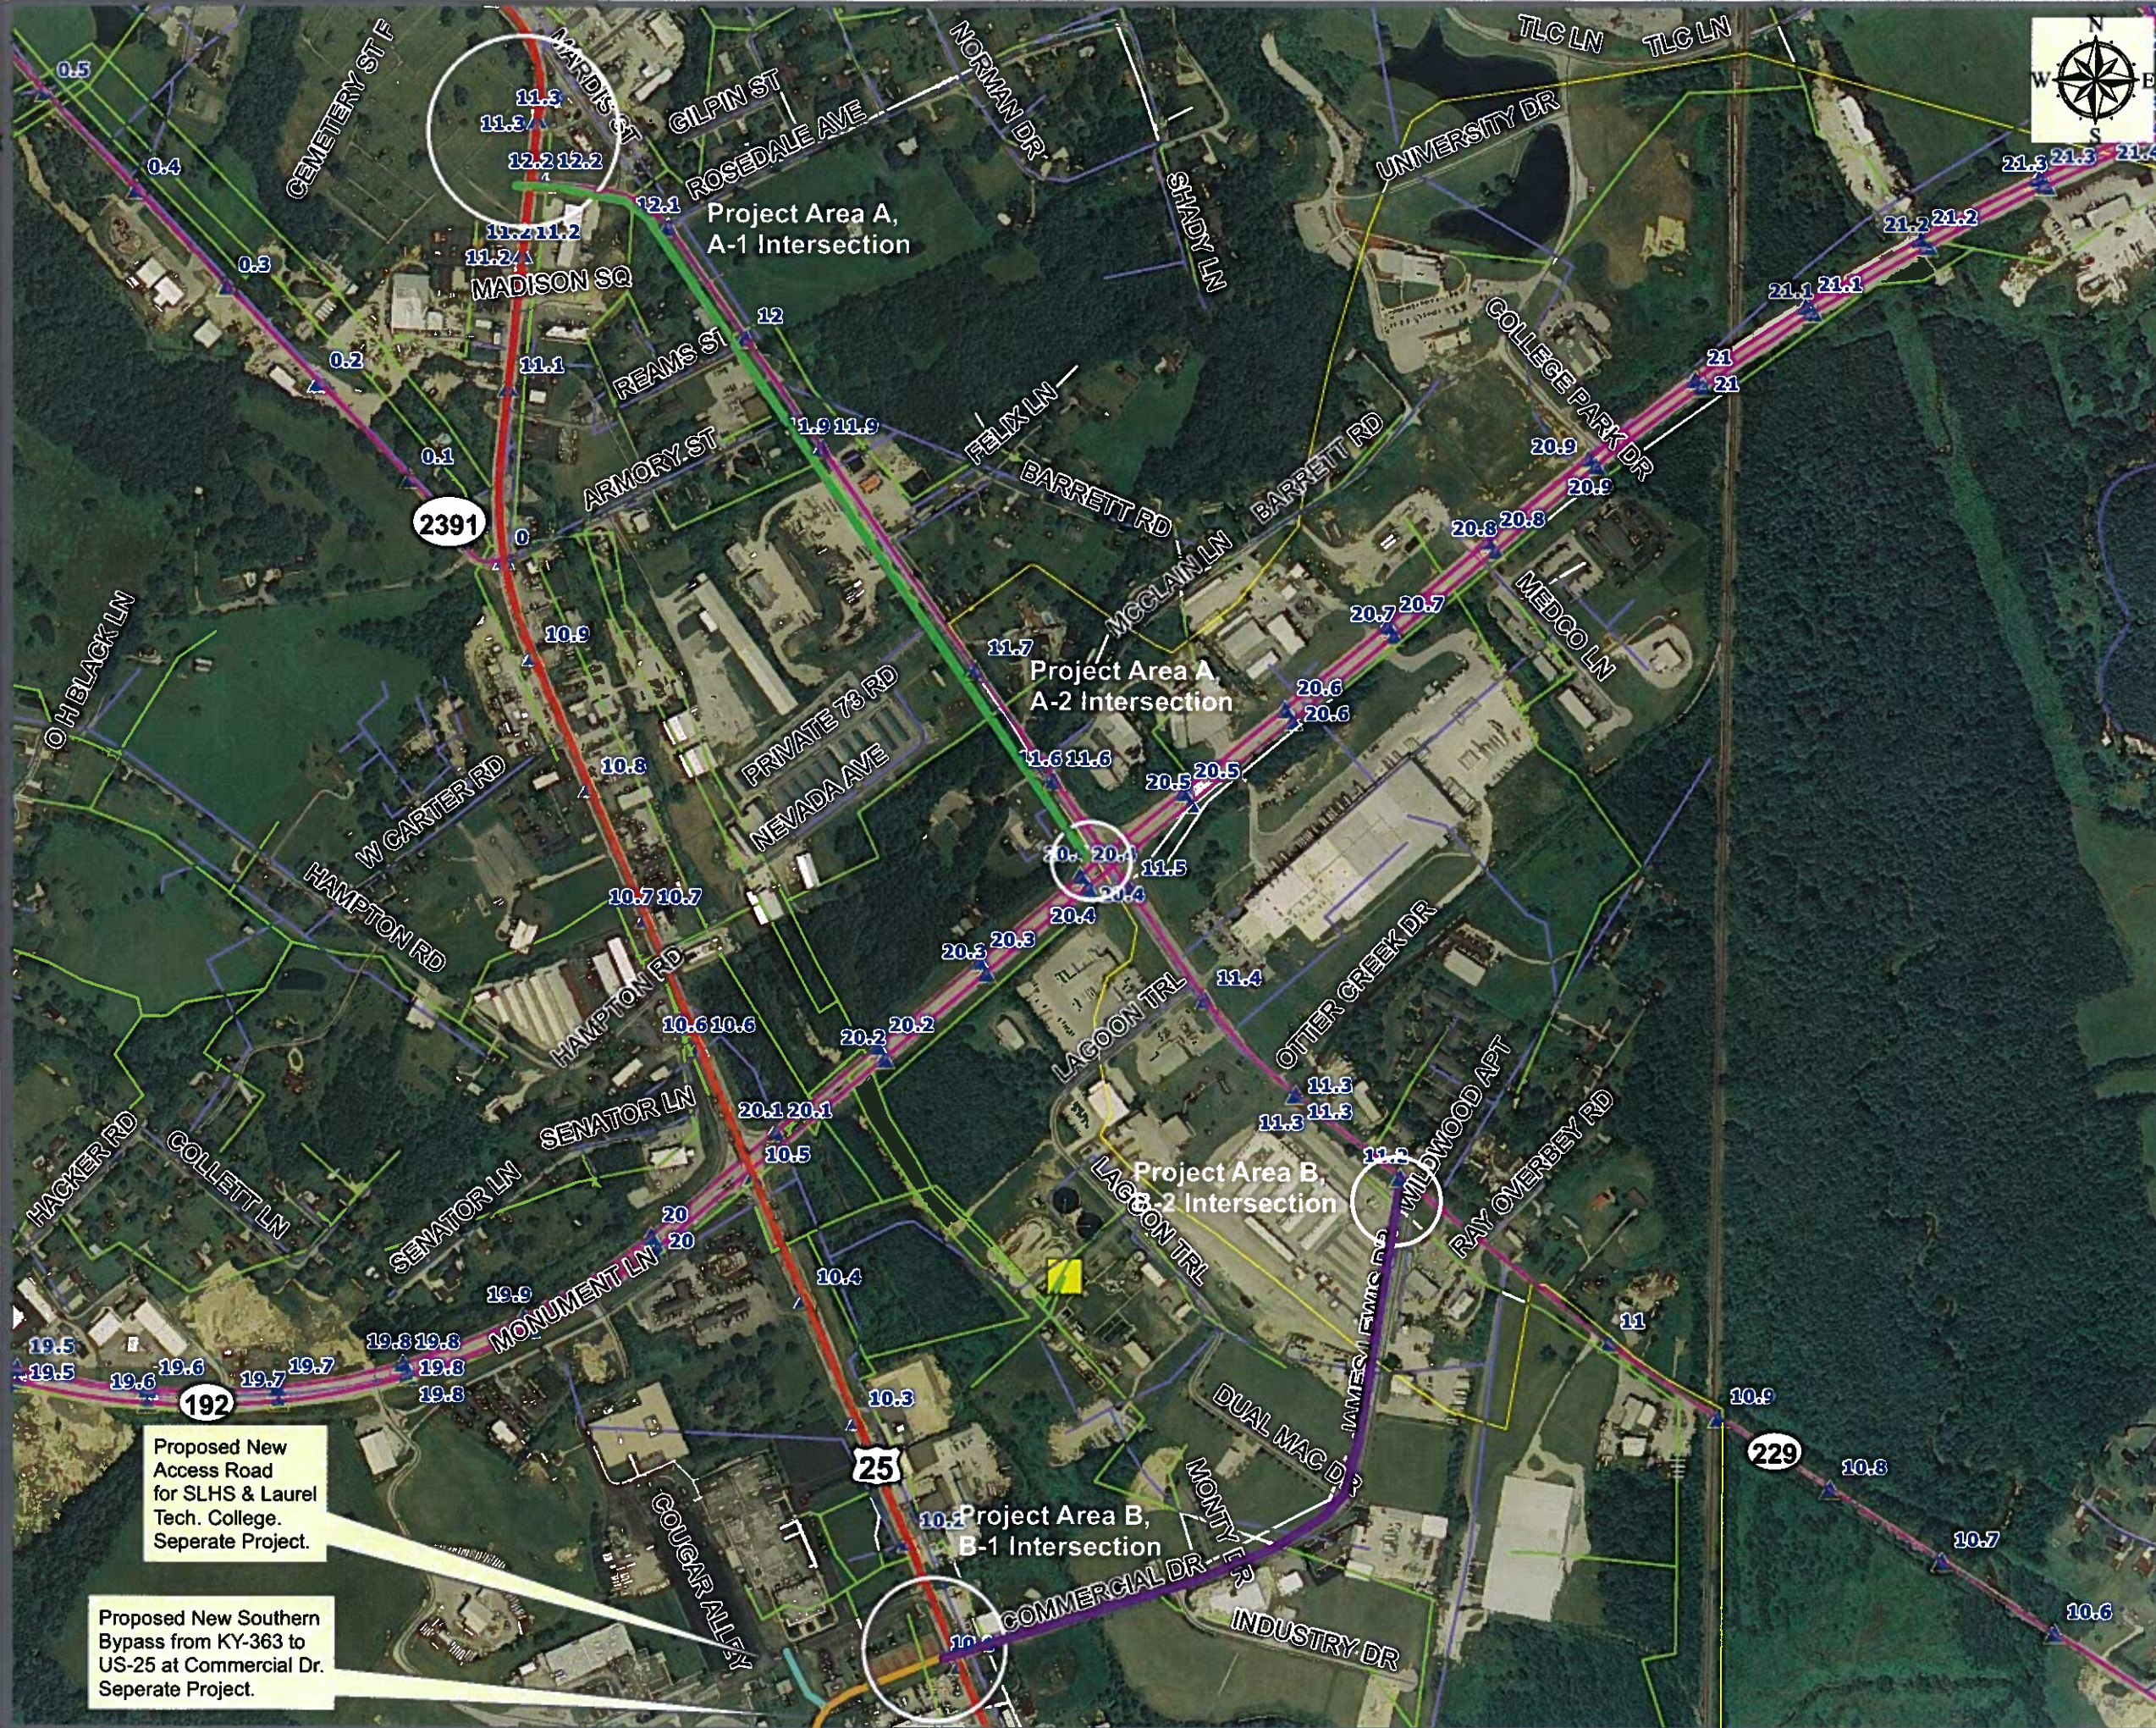
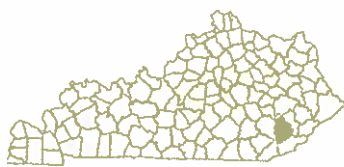


EXHIBIT 4


ITEM NO. 11-147.00
SYSTEM LINKAGE

US-25
DNA PRE-DESIGN
SCOPING STUDY:
LAUREL COUNTY

Legend

- Project Area A- KY-229
- Project Area B-Commercial & James Lewis Dr
- Interstate
- Parkway
- US Highway
- State Road
- County Boundary Polygons

4,500 2,500 0 4,500 9,000 Feet

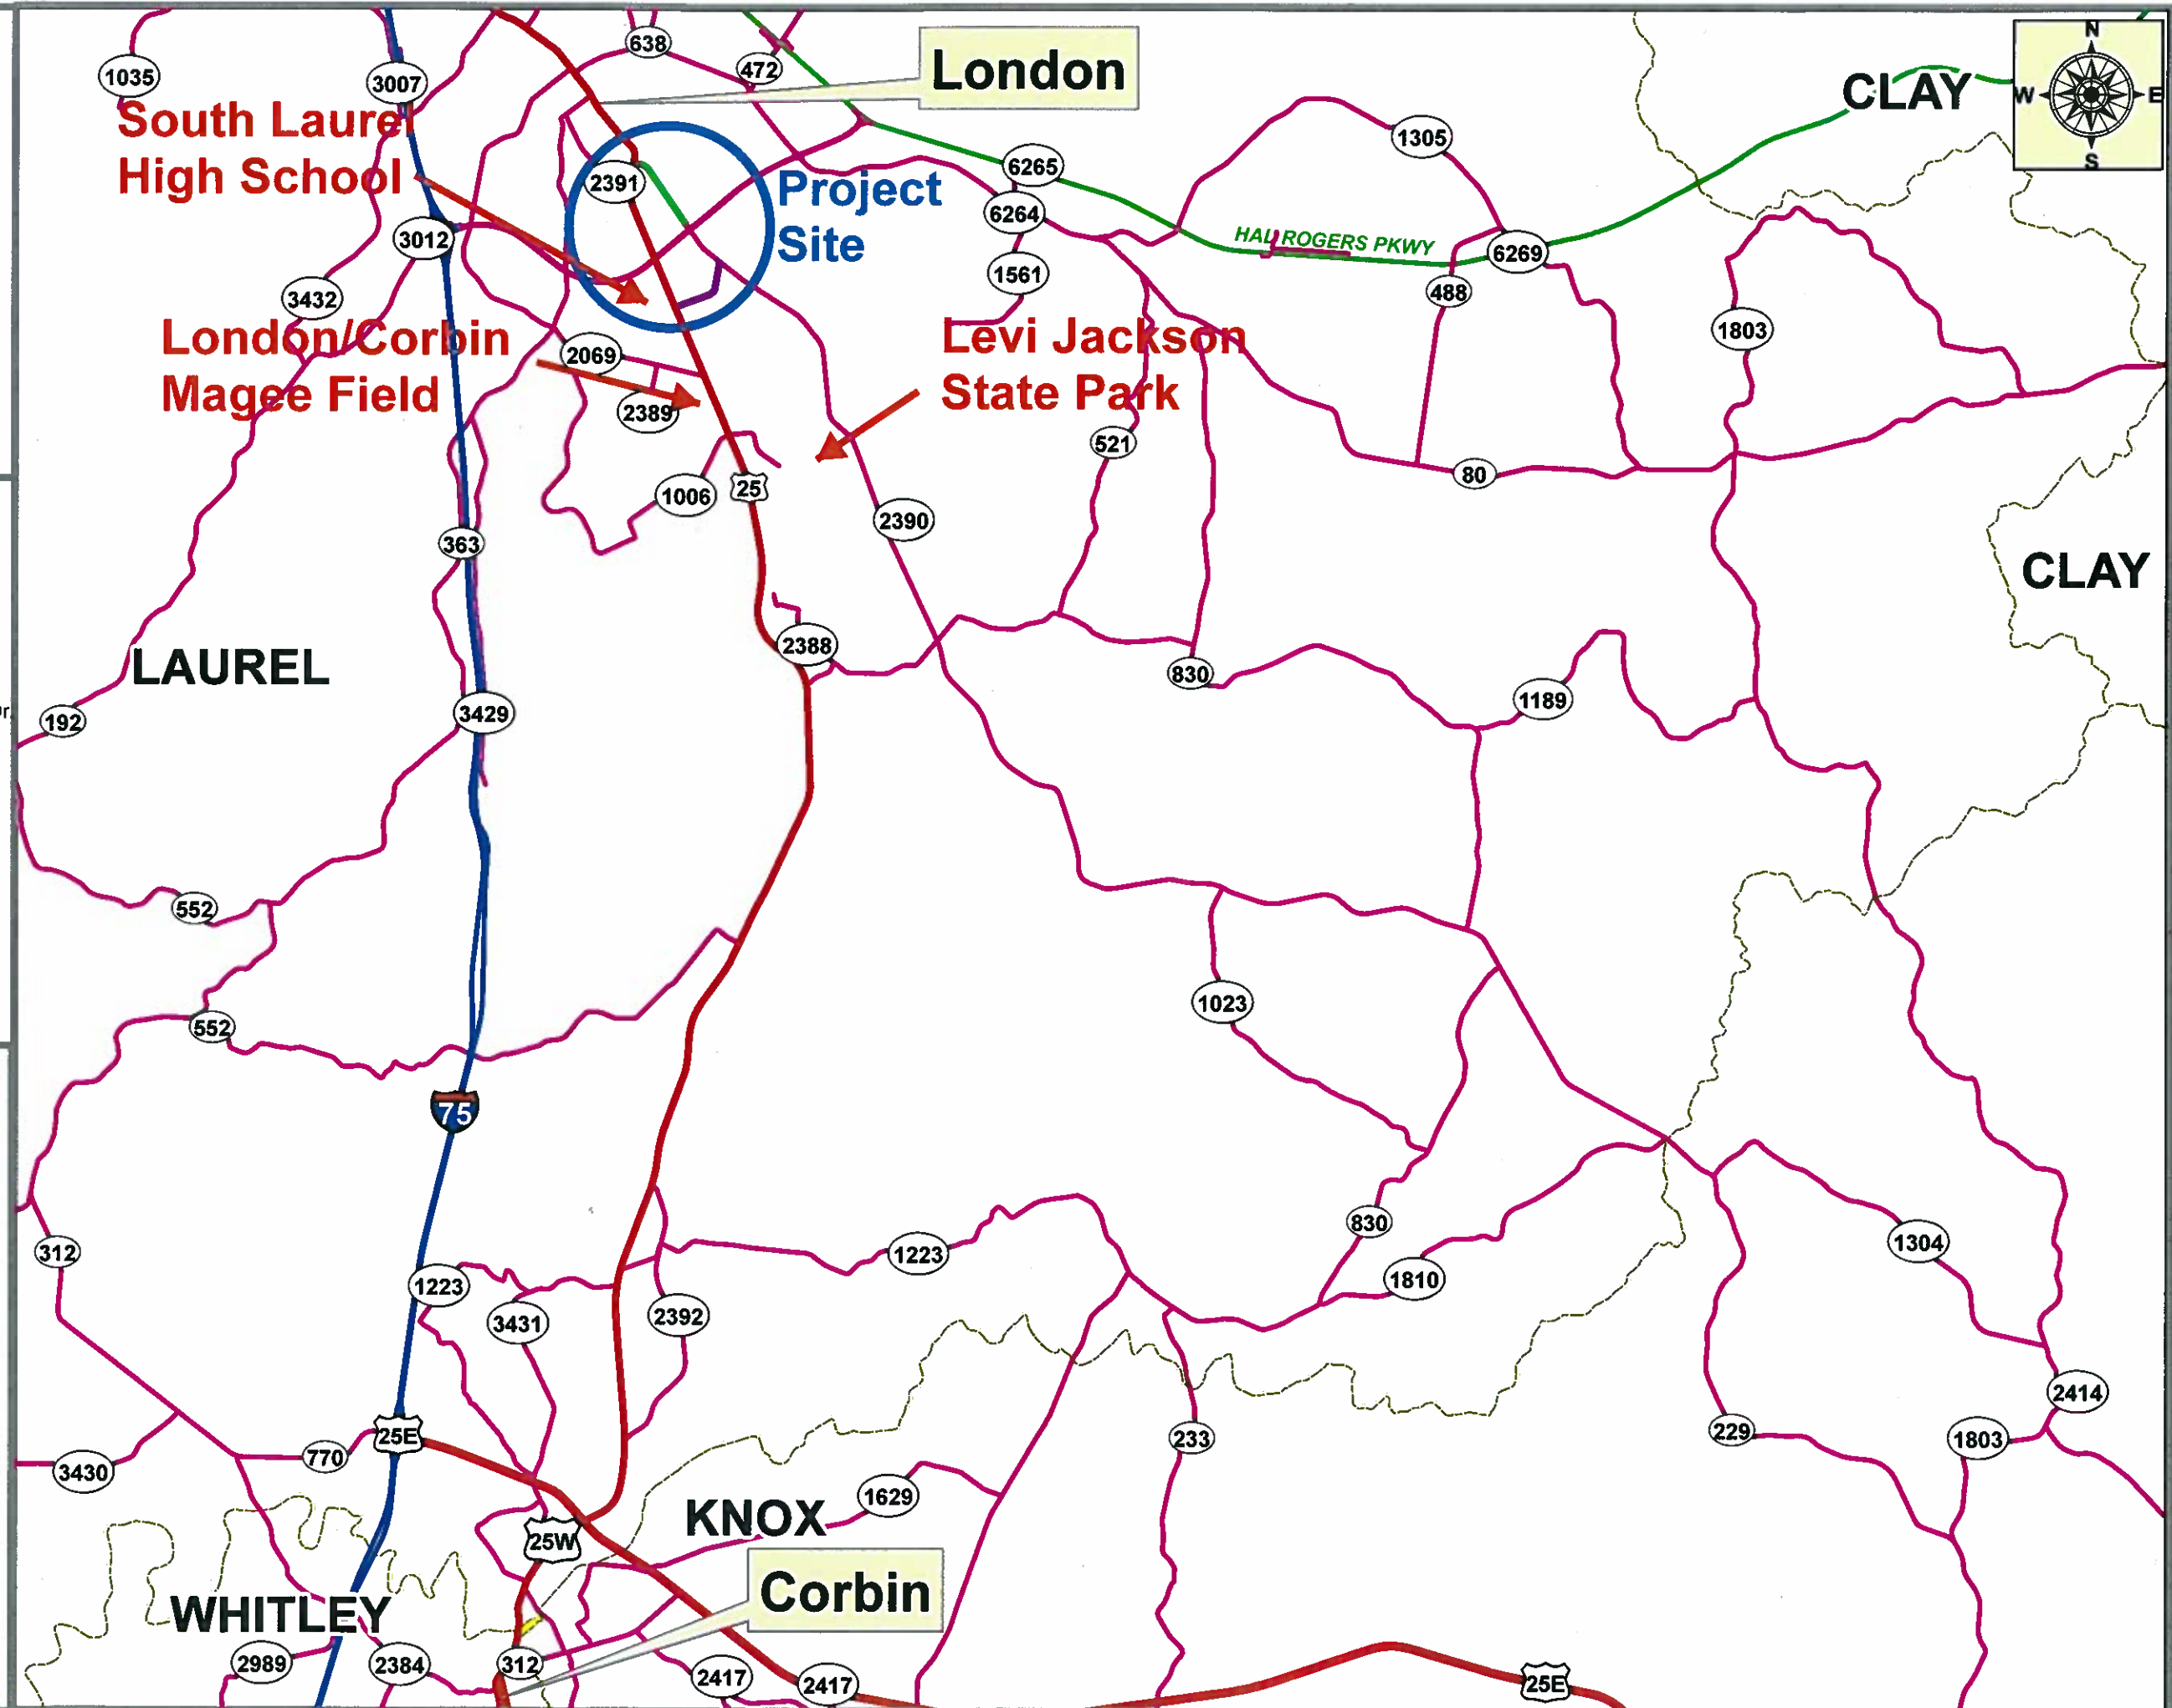

APPENDIX B



Photo 1 – Project Area A- A-1 Intersection between US-25, looking south, & end of KY-229



Photo 2 – Project Area A – KY-229, Looking west from intersection with US-25 onto Horizontal Curve



Photo 3- Project Area A – KY-229, Looking north from A-2 Intersection with KY-192 (Bypass)



Photo 4- Project Area A – A-2 Intersection, Looking South from KY-229 onto the intersection with KY-192



Photo 5 – Project Area B- B-1 Int. of US-25 and Commercial Dr., Looking west on Proposed New Southern Bypass



Photo 6 – Project Area B- Looking east on Commercial Drive from B-1 Intersection with US-25



Photo 7 – Project Area B – B-2 Intersection of James Lewis Drive and KY-229 looking east onto Gas Station



Photo 8- Project Area B – Looking West on James Lewis Drive from B-2 Intersection with KY-229

APPENDIX C

Meeting Minutes
Laurel County Item No. 11-0147.00
US 25-Congestion Relief-Pre-design Scoping Study
First Project Team Meeting – 10:15 a.m. E.S.T. on July 22, 2010

The 1st Project Team Meeting for US 25 Pre-design Scoping Study was held in the District-11, Manchester Office Conference Room on July 22, 2010. The meeting began at 10:15 a.m. and ended at 12:30 p.m. The following people attended the meeting:

Amy Collins	KYTC-D 11 Administration Staff
Dean Croft	KYTC-D 11 Environmental Coordinator
Greg Combs	KYTC-D 11 Right of Way
Jonathan Dobson	KYTC-D 11 Public Information Officer
David Fields	KYTC-D 11 Design
Christopher Harris	KYTC-D 11 Traffic
David Hensley	KYTC-D 11 Right of Way
Daniel Hoffman	KYTC-D 11 Project Delivery & Preservation
Joel Holcomb	KYTC-D 11 Engineering Support
Chris Jones	KYTC-D 11 Permits
James Loughan	KYTC-D 11 Utilities
Lonnie Morgan	KYTC-D 11 Project Delivery & Preservation
Joseph E. Mosley	KYTC-D 11 Planning Development
Cass T. Napier	KYTC-D 11 Chief District Engineer
Keith Damron	KYTC-CO Planning
Steve Ross	KYTC-CO Planning
Srinivasa Gutti	KYTC-CO Planning
Tonya Higdon	KYTC-CO Planning

Tonya Higdon began the meeting by thanking everyone for taking the time to attend. She noted this meeting is the 1st Project Team Meeting for the US-25 Pre-design Scoping Study of Item # 11-0147.00 in the 2010-2012 Kentucky Highway Plan.

After introductions were made, the purpose of a Pre-design Scoping Study was explained by Tonya to those in attendance. This study follows the Federal Highway Administration (FHWA) nine elements towards developing a purpose and need statement. These elements are intended to be a guide and are usually not all inclusive. The information collected through the review of these nine steps will help us also identify alternatives and all alternatives are welcome at this stage. By the end of the meeting, the goal will be to have a clearly defined Purpose and Need Statement as well as a list of alternatives to address in the study.

Tonya continued by discussing the current Legislation for Item # 11-0147.00. This project consists of \$3.13 Million in SB2 funds for design year of 2010 and SP funds for Right of Way of \$2.0 Million and Utilities of \$0.8 Million in year 2012. She also noted the new 2010-2012 Kentucky Highway Plan no longer includes those additional years beyond that of the first two years. As such, there is no date or dollar amount defined for construction of this project.

In regards to Project Status, Joey Mosley noted that a very detailed planning study was done for US 25 in 2006 under Item # 11-8201.00 with some recommended projects currently in Phase I and Phase II design. In the 2006 US-25 Laurel County Scoping Study, the following priorities were identified: Priority 1a & 1b-addressed the need for a back entrance to the South Laurel High School, Priority 2-provided a bypass from the east to help offload congestion from US-25 near the high school, and Priority 3-provided a through route south of the high school to US-25 along Hurley Lane. Of these priorities, only Priority 1 is still proceeding as recommended in the scoping study and is now entering Phase II Design. Priority 2, also known as the “New US-25”, involves the widening of US-25 beginning just south of KY-1006 before redirecting traffic northeast away from US-25 onto KY-229. Once the New US-25 joins KY-229 starting somewhere between the railroad tracks and James Lewis Drive, this portion of KY-229 will also be widened to include the intersection with KY-192 (Bypass). Due to a change in conditions, all other priorities are being addressed in a slightly different manner than identified in the 2006 US-25 Scoping Study.

These changes have lead to other concerns that will be identified and addressed through this Pre-design Scoping Study. To begin, Priority 1b has recently been removed from consideration by the Laurel County School Board, while Priority 1a is still a go in connecting to KY-363 (site of new Lowe’s location) but with a change in the eastern termini location. This change in termini for Priority 1a was due to the Laurel County School Board deciding to not allow public traffic through their South Laurel High School Campus. Instead, those representing the school have offered to provide land south of the football field to route traffic around the campus to the intersection of US-25 and Commercial Drive that is now known as the “New Route/New Southern Bypass”. Phase II design is now ready to begin for this approach and includes the completed Traffic Forecast Technical Report-Laurel County: New Connector to South Laurel High School. This change in route has also contributed to the desire to remove Priority 3 (Hurley Lane) from consideration as this new route will serve the purpose of access for the school as well as direct the majority of thru traffic away from the school to US-25. While Priority 2 is still moving forward, the 2006 US-25 study limited the review area to end at the intersection of KY-192 (Bypass) and KY-229/“New US-25”. As such, consideration was not given to the added demand of continued traffic north along KY-229 beyond this intersection to the intersection with US-25/Main Street in downtown London.

During the review of the proposed “New Route/New Southern Bypass” a question was raised as to why Connector A (Route between KY-192/Bypass and New Southern Bypass) was removed from the original Southern Bypass as part of Phase 1 design. Joey noted that the decision reached among the project team members was to direct the traffic onto KY-363 in an attempt to provide less interruption to traffic flow on KY-192 (Bypass) and the proposed New Southern Bypass by eliminating two intersections. Keith noted the need to have early public involvement on this project and to discuss with the School Board before hand.

The current status of these remaining priorities is the main reason for review of two new project areas due to the possible impacts from rerouted traffic. The new project limits to be considered are discussed as follows:

- Project Area A – is along KY-229 from MP 12.211 at Intersection A-1 (intersection of US-25 and KY-229) on south to MP 11.522 at Intersection A-2, (intersection of KY-192 to KY-229).
- Project Area B – runs along Commercial Drive/James Lewis Drive from MP 11.110 at Intersection B-1 (intersection of US-25 with Commercial Drive) on east along Commercial Drive/James Lewis Drive to MP 11.195 at Intersection B-2 (intersection of KY-229 with James Lewis Drive).

The focus of the presentation was then directed to primarily address the new project areas identified with the balance of the presentation focusing around the remaining nine points to be addressed in developing a purpose and need statement.

- A system linkage review was performed to help identify significant factors in this location. Key issues were noted as follows:
 - US-25 Connects London to Corbin
 - KY-229 Connects London to Barbourville
 - US-25 Designated an “Alternate Route” if emergency on Interstate-75
 - Levi Jackson State Park is located just off this route on KY-1006
 - South Laurel High School is off US-25
- Roadway classifications were discussed with US-25 having 14.3% truck traffic due in part to being in the Coal Haul Highway System.
- Modal relationships were also examined with CSX being identified to own the rail line that runs through this area parallel to Interstate-75.
- Social demands and economic development were considered.
- Traffic demands, crash data and roadway deficiencies were discussed through the remaining presentation. The two defined project areas were broken up into four sections relative to the information provided through the HIS and HPMS database systems. These sections were defined as follows:
 - Section 1- covers the area along US-25 around Project Area B - Intersection B-1 at the intersection of US-25 and Commercial Drive.
 - Section 2- includes the area along US-25 around Project Area A- Intersection A-1 at the intersection of US-25 and KY-229.
 - Section 3- consists of the area along KY-229 called Project Area A from the intersection with US-25 to and including the intersection with KY-192 (Bypass) also known as Intersection A-2.
 - Section 4- covers the area along KY-229 around Project Area B- Intersection B-1 at the intersection of KY-229 and James Lewis Drive.
- We first went over Transportation Demand and found a growth rate for each roadway based upon actual traffic counts. Of these locations, Section 4 was found to have the highest growth rate at 4.2%, which appeared very steady from mid 1960’s to present.
- Capacity was identified through volume to service flow ratio (VSF), Adequacy Rating (based on capacity, roughness and crashes) and Future ADTs for each section. US-25 in Section 1 was the only location where the VSF was greater than 0.70 with a value of 1.11. The adequacy rating for this section of roadway was also the lowest at

15.15%, which means out of 100 roadways of this same functional class in Kentucky, approximately 85% were rated better than this section.

- Safety was the next element of the purpose and need statement presented. The new crash data being utilized included collision data from January 1, 2006 through December 31, 2009. Crash locations were discussed for each of the four separate sections (previously identified) to include manner of collision and type of collision. Mapping was provided to show individual crash areas and locations of high CRFs along the corridor.
 - A significant number of Rear end and Angle Collisions were noted in Section 1 at the intersection of Commercial Drive and US-25 to result in a Critical Rate Factor (CRF) of 3.35. This location is approximately 100 ft from an existing signalized intersection with Laurel Technical College Street and the main entrance to South Laurel High School (SLHS) Campus. Concern was raised regarding the desire to relocate this traffic signal to the proposed intersection of the “New Route/New Southern Bypass” with US-25 and Commercial Drive due to the anticipated increased traffic demand. Along with the School Board proposing to provide right-of-way for a New Southern Bypass away from SLHS for added security reasons, a meeting attendee stated the School Board had requested the traffic signal at Laurel Technical College Street/SLHS Main Entrance be removed and relocated at the intersection of the New Southern Bypass with that of US-25 and Commercial Drive. It was noted that once the New Southern Bypass was complete, the School Board requested that the current SLHS Main Entrance at US-25 be closed to require school traffic to utilize the connectors to the New Southern Bypass. Tonya noted that traffic counts were requested for this intersection and will be performed after both the high school and technical college are back in session. Joey stated that the rest of the highly congested portion of US-25 identified in Section 1 not be proposed for improvements as Priority 2 (New US-25) was identified in the 2006 US-25 Study to offload congestion from this location.
 - Safety at Section 2 was discussed next as it also had a high CRF of 2.14 at the intersection of US-25 and KY-229. Lots of rear ends were reported there with most vehicles being hit from behind on US-25 traveling southbound. A signal is located at this intersection and a possible 1-way route was discussed some time ago. This intersection has been a problem per the District for some time and the other side roads were never closed to through traffic as originally intended. US-25 has two through lanes at this location with a two way left turn lane (TWLTL) in the middle.
 - Section 3 also had safety concerns with a high CRF of 1.22 at the intersection of KY-229 and KY-192(Bypass). Most accidents were rear ends as well with a near even split of rear end collisions from either direction along KY-229. The district noted that the intersection functions well during the weekdays, but becomes congested when the flea market is in operation during the weekends. Traffic speed through this location is approximately 45-55 mph. Keith noted that the left turn lanes appear to be

approximately 100 ft shorter than desired on KY-229 at the intersection with KY-192(Bypass).

- The last Section 4 had a concentrated area with a CRF of 1.68 at the intersection of KY-229 and James Lewis Drive. The District noted this portion of the KY-229 Corridor has significant traffic generators to include: the flea market (corner of KY-229 & James Lewis Drive), city public works facility, Laurel Grocery Distribution, FedEx Distributor, and other access points. The intersection of KY-229 and James Lewis Drive form a “Y” intersection and has an approximate 25 ft offset with that of Brown Lane. A railroad crossing is also located just south of this intersection that is known to cause gridlock in the area.
- During the Roadway Deficiencies review, it was noted that all sections did not meet current design standards and that the geometrics of the roadway was a significant issue. The listed deficiencies and significant traffic generators noted in the Safety discussion on Section 4 raised concern for increased traffic along Commercial Drive and James Lewis Drive as an eastwardly continuation of the New Southern Bypass. Joey inquired as to the need to include upgrades to Commercial Drive and James Lewis Drive as part of the 11-147.00 Project. Should the District include improvements to the intersections at Commercial Drive & US-25 with the New Southern Bypass as well as the intersection at KY-229 & James Lewis Drive? The District considered traffic from KY-229 to utilize Commercial Drive and the New Southern Bypass to gain access to KY-363 (new Lowe’s location). Keith asked what improvements would be needed along Commercial Drive and James Lewis Drive and Joey replied with the following list:
 - Geometry (Sharp curve)
 - Pavement Type (Asphalt Type)
 - Pavement Width
 - Shoulder Width

Keith then suggested getting cost estimates to determine money availability. If there is not enough money, spot improvements should be considered. Another approach could be to improve the intersection of the New Southern Bypass with US-25 and Commercial Drive as part of Priority 1 (New Southern Bypass) project and add improvements to the intersection of James Lewis Drive and KY-229 with Priority 2 (New US-25) project.

- Environmental Considerations were discussed for this area. An Environmental Overview was completed as part of the 2006 US-25 Scoping Study and includes all of Project Area A as well as the southernmost part of Project Area B that is the intersection of KY-229 and KY-192(Bypass). Tonya noted the need for Dean to provide an Overview for the balance of the project area. An Environmental Justice Report was also completed for the same study with 2000 Census Tract data covering the entire area for this study as well. As such, another Environmental Justice report may not be needed as the Project Areas are primarily commercial and industrial in nature with some apartments being located on the eastern side of KY-229. There is only one area known to have underground storage tanks (UST) in both project areas and is a gas station located on the eastern side of the KY-229 at the intersection with James Lewis Drive. The District noted that the local National Guard facility is for storage only with a few trenches.

- Utilities were also reviewed throughout an overall project area. Joey and district staff developed an overall aerial map showing topography, water and sewer utilities as well as schools, wetlands, churches, public activities and several other unique characteristics to the area. Tonya provided a list of potential conflicts and noted that telephone and cable lines should also be considered.

Once all four sections of roadway were reviewed individually, the meeting proceeded with a summary review to help clarify the desired alternatives for Project Areas A and B.

Project Area B was first reviewed at the intersection of US-25 and Commercial Drive. Joey then inquired if the District should decide which Project Area is the priority. It initially appeared that Project Area A was considered a greater concern. Keith followed by asking if these areas were scope creep or does traffic already following these routes? The District anticipated both areas to be of concern due to the future traffic impacts in these locations once Priority 1 and Priority 2 projects were implemented. A question was then raised regarding the potential redundancy in providing the US-25 Connector along with possible improvements on Commercial Drive. Following this thought, another option was presented to combine Commercial Drive and New US-25. Several team members responded that Priority 2 (New US-25) is primarily for traffic traveling north and south, to and from London to Corbin, while Priority 1 (New Southern Bypass) and Project Area A (Commercial Drive & James Lewis Drive) work together to provide a continuation of traffic flow east and west for more local and commercial traffic to get to and from KY-229 (New US-25) to KY-363. Also, the original idea behind all these priorities was to offload traffic from the heavily congested portion of the US-25 corridor and if you combine the New US-25 and Commercial Drive, traffic would be directed up to the very area where congestion relief is needed most.

Keith recommended Project Area B (Commercial Drive) be a part of this study but thought the District should look at traffic volumes coming from KY-363 before deciding if feasible to improve Commercial Drive. The project team agreed to review both options as follows:

- No build on Commercial Drive but Improve Intersection of proposed New Southern Bypass with US-25 and Commercial Drive.
- Improve Commercial Drive at a continuation of the New Southern Bypass to include intersections and the sharp curve at the transition point of Commercial Drive to James Lewis Drive by continuing Commercial Drive all the way to KY-229(New US-25). Traffic on James Lewis Drive would then be required to utilize Commercial Drive and the problem access point for James Lewis Drive to KY-229(New US-25) would be removed.

Keith noted that if the traffic volume is large enough on Commercial Drive, the District may want to consider improvements as part of Priority 1 (New Southern Bypass) and if not, the District may consider Commercial Drive to be a separate project. In order to get a more accurate representation of traffic patterns in the area, this Pre-design Scoping Study will recommend a traffic model be completed to cover both Project Area A and B or do Phase 1 Design after a model is done. Joey noted it will be six months or more before design starts as no consultant has been selected yet. David Fields noted that there

is currently a traffic model being created for the area and proceeded to check the status of the model. Upon David's return, he noted the traffic model must still be tweaked to account for Commercial Drive and Project Area A. Joey thought this could be done in a relatively short period of time. Keith noted that Priority 2 (New US-25) project should not stop for this process and worse case would be Commercial Drive would be a separate project. This should be discussed further in Program Review Meetings. Another team member suggested one way streets as an alternative. Keith noted that the traffic model could determine if this option is a viable alternative. Joey replied this subject was already brought up in the Public Involvement Meeting during the 2006 US-25 Planning Study and the public did not support.

Project Area A was discussed next as the area North of KY-192(Bypass) on KY-229. Given the short proximity and direct connection to downtown London, Keith confirmed that the Model should be used to help determine the possible improvements to this portion of roadway but agreed with Joey that this area should be a part of this Pre-design Scoping Study. Given the geometric limitations of Project Area A-Intersection A-1, improvements to US-25 and KY-229 would be required regardless. The following options were concluded:

- No build on KY-229 North of KY-192(Bypass). Revise intersection of US-25 and KY-229 only to allow for the main flow to proceed on to Main Street from KY-229.
- Improve KY-229 North of KY-192(Bypass) & revise the intersection of KY-229 and US-25 to accommodate anticipated growth along this corridor to allow for the main flow of traffic to continue onto Main Street directly from KY-229 (New US-25).

Discussion was raised as to where this project area should be included for funding. Keith considered Project Area A to be included in the 11-147.00 Project as a continuation of Priority 2 (New US-25). It was then noted that cost estimates for these options would also be needed from District-11 to provide more accurate information for these studies and future project costs.

The Purpose and Need Checklist was discussed once again as an essential aspect in developing a Purpose and Need Statement for the New Project. The draft Purpose and Need Statement was then presented to the project team for review and discussion.

The draft Purpose and Need Statement for the overall project was provided as follows:

“US-25 provides a significant connection between the city of London and Corbin as well as an alternate route during incidents or closures on Interstate 75. The purpose of this project is to reduce congestion and critical rate factors to provide safety, mobility, and connectivity for those traveling in London. These improvements should accommodate social demands for schools, residential, retail, industrial and recreational opportunities.”

The revised Purpose and Need Statement was concluded as follows:

“US-25 provides a significant connection between the cities of London and Corbin as well as an alternate route during incidents or closures on Interstate 75. The need for this

project is to reduce congestion and critical rate factors along US-25 for the purpose of reducing crashes, improving mobility, and connectivity in the area to accommodate social demands for schools, residential, retail, industrial and recreational opportunities.”

Upon completion of the Purpose and Need Statement, Tonya noted she will review notes from this meeting and provide minutes to all who attended.

The project team then proceeded to gather for a field visit of both Project Areas including the New Southern Bypass and New US-25 Route. This visit was intended to help the team members become more familiar with the site and more clearly understand the concerns along this corridor.

piF INSCHEDULEDNEEDS

Project Identification Form




NEW PIF <> SEARCH <> STATUS

DIVISION OF PLANNING

ADMIN <> HELP <> LOGOUT

GENERAL INFO ROW/UTIL ECO/SOCIAL ENV/AIRQLTY COST EST HIGHWAY ATT PIF STATUS RANKING

GENERAL INFORMATION

The PIF has an attachment. Click this image for PDF: 

Control No: 11 063 B0025 46.30

Requestor Name:

Requestor Title:

Requested By Date: 05/01/2006

Form Completed By: Clay McKnight

Title/Organization: Transportation Planner/C

Form Completed Date: 10/15/2004

District: 11

County: Laurel

Prefix: US

Route No: 25

Route Type: B

Suffix:

BMP : 9.028

Length: 1.477

Status: Active

Mode: Highways

Type: Major widening

ADD: CUMBERLAND VALLEY

MPO: Select

Urban Area: Rural

Parent Control No: 11 063 B0025 46.30

RSE Unique No: 063-US-0025 -000

State System:

BMP	EMP	SPRS
0	23.9490	State Secondary

Functional System:

BMP	EMP	FC
0.6770	9.0280	Rural Major Collector
9.0280	15.8210	Urban Minor Arterial Street

EMP: 10.505

Existing Studies: SEE US 25 SCOPING STUDY, ITEM NO 11-8201, PRIORITY

Project Description:

Address congestion and safety issues on US 25 from KY 1006 to KY 192 in London

Regional Goal:

1. Continue support for the development and/or expansion of significant regional corridors, including US 25. 2. Improve highway safety at locations and/or corridors where traffic crash data and analysis has yielded an identified solution. 3. Promote lane and intersection expansions to improve traffic flow in congested urban and rural areas.

Last Updated By: lesli.gill **Last Updated Date:** 11/11/2010 2:26:44 PM

Possible Funding source: IM NH HES BR STP SP TE CMAQ PLH

Other:

Highway Network: Non NHS NHS NN Scenic Way Coal Haul Bike Forest Strahnet Ext Weight ADHS

piF Project Identification Form UNSCHEDULED NEEDS

NEW PIF <> SEARCH <> STATUS

DIVISION OF PLANNING

ADMIN <> HELP <> LOGOUT

GENERAL INFO ROW/UTIL ECO/SOCIAL ENV/AIRQLTY COST EST HIGHWAY ATT PIF STATUS RANKING

RIGHT OF WAY

Avg. Width:

Source: HIS Plans Microfilm

Other:

Current Primary Use: Industrial Commercial Residential Farmland

Other:

Project may require additional R/W: False True

Possible Number of Relocations: Homes Businesses

Comments:

UTILITIES

Existing Utilities: Electrical Gas Telephone Cable
 Sewer Water ITS None

Other:

Project may require Utility Relocations: False True

Comments:



piF Project Identification Form



NEW PIF <> SEARCH <> STATUS

DIVISION OF PLANNING

ADMIN <> HELP <> LOGOUT

GENERAL INFO ROW/UTIL ECO/SOCIAL ENV/AIRQLTY COST EST HIGHWAY ATT PIF STATUS RANKING

ECONOMIC IMPACT

Planning/Zoning Reg exist in Community: False True

Project may affect established Business, Commercial or Industrial districts: False True

Economic impacts on regional/local economy: False True
 Development Tax Revenues Emp Opportunity
 Retail Sales Other

Comments: An expanded US 25 will improve access to existing commercial entities.

Direct access to major points of interest: False True
 Nat'l/St Parks Monuments Amusement Parks
 Historic Sites US Public Land Other

Comments: Levi Jackson State Park (including historic features and monuments)

Direct access to major traffic generators: False True
 Shopping Centers Schools Industries
 Military Installations Other

Comments: South Laurel High/Middle Schools, Laurel Co. Tech. College, London- Corbin Airport, Cookie Factory, ACS

MULTIMODAL

This Project is a candidate for:(Check all that apply): Bicycle Paths Sidewalks Shared-Use Paths Park/Ride Lots
 N/A

Project Improves direct access to:(Check all that apply): Airports Railways Riverports Trucking routes N/A

Type of Public Transportation Available: Fixed routes Demand Response

Comments: Sidewalks could be included in this project.

SOCIAL IMPACT

This Project May affect:(Check all that apply): Neighborhood/community Cohesion
 Travel Patterns (vehicular, commuter, bicycle, pedestrian)
 Household relocations
 Elderly, disabled, nondrivers, minorities, low-income persons
 No adverse effects to neighborhoods apparent

Comments: Due to the substantial size and scope of the project, social impacts may occur.





NEW PIF <> SEARCH <> STATUS

DIVISION OF PLANNING

ADMIN <> HELP <> LOGOUT

GENERAL INFO - ROW/UTIL ECO/SOCIAL ENV/AIRQLTY COST EST HIGHWAY ATT PIF STATUS RANKING

ENVIRONMENTAL IMPACT

- Environmental Impact:
- Blue Line Streams
 - Wetlands
 - Floodplain
 - Wildlife Managed Areas
 - Historic Properties
 - Cemeteries
 - Schools
 - Churches
 - Endangered species
 - Public land/Park
 - Noise impact
 - Arch. Sites
 - NR Properties
 - Potential NR Properties

Other:

- Potential Contaminated sites:
- Gas Stations
- Landfills
- Auto Repair
- Junkyards

Other:

Comments:

AIR QUALITY

- Maintenance or Nonattainment Area: False True Ozone PM
- Adds through Lane Capacity: False True
- Congestion Management Plan: False True
- Project is included in TIP/STIP: False True

Comments: Expanded lane structure will provide through lane capacity.





NEW PIF <> SEARCH <> STATUS

DIVISION OF PLANNING

ADMIN <> HELP <> LOGOUT

GENERAL INFO ROW/UTIL ECO/SOCIAL ENV/AIRQTY COST EST HIGHWAY ATT PIF STATUS RANKING

COST ESTIMATE

PIF #: 11 063 B0025 46,30
 Revision #: 0
 BMP: 9.028
 EMP: 10.505
 Last Updated By: 2/25/2010 4:51:20 PM
 Last Updated Date: sowjanya.burugupalli

Estimate Class: Requires Further Study

Per Mile

	BMP	EMP	TERRAIN
Terrain:	2.0980	9.0280	Rolling
	9.0280	10.5050	Flat
	10.5050	12.1630	Flat

Detailed Estimate with Calculations Attached

Estimate Assumptions:

- Planning: No Records
- Design: No Records
- Right of Way: No Records
- Utilities: No Records
- Construction: No Records

	Planning:	175,000.00
	Design:	1,750,000.00
Original Estimate:	Right of Way:	4,000,000.00
	Utilities:	1,500,000.00
	Construction:	7,000,000.00
	Total Cost:	14,425,000.00

Estimate Procedure Used:

Attachments: Location Map Photograph(s) Others: Sheet showing Cost Estimate

Comments:



PIF Project Identification Form INSCHEDULED NEEDS



NEW PIF <> SEARCH <> STATUS

DIVISION OF PLANNING

ADMIN <> HELP <> LOGOUT

GENERAL INFO ROW/UTIL ECO/SOCIAL ENV/AIRQLTY COST EST HIGHWAY ATT PIF STATUS RANKING

HIGHWAY ATTRIBUTES

PIF #: 11 063 B0025 46.30

BMP: 9.028

EMP: 10.505

Last Updated By: lesll.gill

Last Updated Date: 7/28/2010 8:49:24 AM

Adequacy Rating Range

	From	To	Problem Statement
Adequacy Rating:	44.50	96.50	This project is a part of an overall plan to expand US 25 from US 25E near Corbin to KY 192 in London. This particular section is composed of numerous commercial entities, adjacent residential developments, the entrance to the Laurel County Board of Education, Laurel County Technical College, and South Laurel High/Middle Schools. Congestion and safety have become an issue as ADT continues to increase.
CRF:	0.7860	1.62	
IRI:	No Records	No Records	
V/SF:	0.49	1.07	
ADT:	11400	23300	
% Trucks (Single):	6.60	6.70	
% Trucks (Combination):	3.80	7.60	
Speed Limit:	45	45	

ProjectedADT (HDO)/Year:

% Growth:

ProjectedADT:

Miscellaneous Roadway Conditions

Access Control:	BMP	EMP	TYPE
	0	23.9490	None

Proposed Access Control: *

Lane Width:	BMP	EMP	WIDTH	LANES
	2.0980	11.9780	11	2

Proposed Lane Width: *

Proposed Lanes: *

MedianType:	BMP	EMP	WIDTH	TYPE
	0	13.5050		None

Proposed Median Type: *

Proposed Median Width: *

Shoulders:	BMP	EMP	WIDTH	TYPE	X SECT
	2.0980	9.0280	4	Combination	CR
	2.0980	9.0280	4	Combination	NR
	9.0280	10.30	2	Curbed	CR
	9.0280	10.30	2	Curbed	NR
	10.30	10.5050	10	Stablized	CR

10.30	10.5050	10	Stablized	NR
10.5050	10.63	10	Combination	CR
10.5050	10.63	10	Combination	NR

Proposed Shoulder Type: Combination

Proposed Shoulder Width: 2

No. of Bridges: 0

Traffic Loop: Coming Soon

Other Improvement Projects in Area: None SYP Resurface Others

Comments:



piF Project Identification Form UNUS SCHEDULED NEEDS



NEW PIF <> SEARCH <> STATUS

DIVISION OF PLANNING

ADMIN <> HELP <> LOGOUT

GENERAL INFO ROW/UTIL ECO/SOCIAL ENV/AIRQLTY COST EST HIGHWAY ATT PIF STATUS RANKING

STATUS HISTORY

STATUS TYPE	STATUS UPDATED DATE	STATUS UPDATED BY
Active	2/22/2010 10:48:34 AM	sowjanya.buruugpalli
Active	7/28/2010 8:42:26 AM	lesli.gill
Active	11/11/2010 2:26:44 PM	lesli.gill





NEW PIF <> SEARCH <> STATUS

DIVISION OF PLANNING

ADMIN <> HELP <> LOGOUT

GENERAL INFO ROW/UTIL ECO/SOCIAL ENV/AIRQLTY COST EST HIGHWAY ATT PIF STATUS RANKING

RANKING

Click the 'Add Rank' button below to Rank this PIF

RANK TYPE	YEAR	PRIORITY	RANK	TIER	OVERALL	UPDATED BY	UPDATED DATE
LOCAL	2001	HIGH	0			sowjanya.burugupalli	3/10/2010 12:53:50 PM
REGIONAL	2001	HIGH	6			sowjanya.burugupalli	3/10/2010 12:54:17 PM
DISTRICT	2001	HIGH	0			sowjanya.burugupalli	3/10/2010 12:55:15 PM
LOCAL	2003	HIGH	0	3		sowjanya.burugupalli	3/10/2010 2:10:17 PM
REGIONAL	2003	HIGH	10	3		sowjanya.burugupalli	3/10/2010 2:26:12 PM
DISTRICT	2003	NONE	0	3		sowjanya.burugupalli	3/10/2010 2:29:01 PM
LOCAL	2005	HIGH	0			sowjanya.burugupalli	4/5/2010 11:21:25 AM
REGIONAL	2005	HIGH	0			sowjanya.burugupalli	4/5/2010 11:27:35 AM
DISTRICT	2005	MEDIUM	0			sowjanya.burugupalli	4/5/2010 12:37:55 PM
LOCAL	2007	NONE	19			sowjanya.burugupalli	4/5/2010 1:15:00 PM
REGIONAL	2007	MEDIUM	0			sowjanya.burugupalli	4/5/2010 1:29:02 PM
DISTRICT	2007	HIGH	1			sowjanya.burugupalli	4/5/2010 3:53:38 PM
LOCAL	2009	NONE	0			sowjanya.burugupalli	4/5/2010 4:29:45 PM
REGIONAL	2009	NONE	0			sowjanya.burugupalli	4/5/2010 4:30:32 PM
DISTRICT	2009	NONE	0			sowjanya.burugupalli	4/5/2010 4:31:01 PM




UPL 11 063 B0025 46.30
Laurel County, Kentucky



1 Traffic
Generator
Sites



Division of Planning

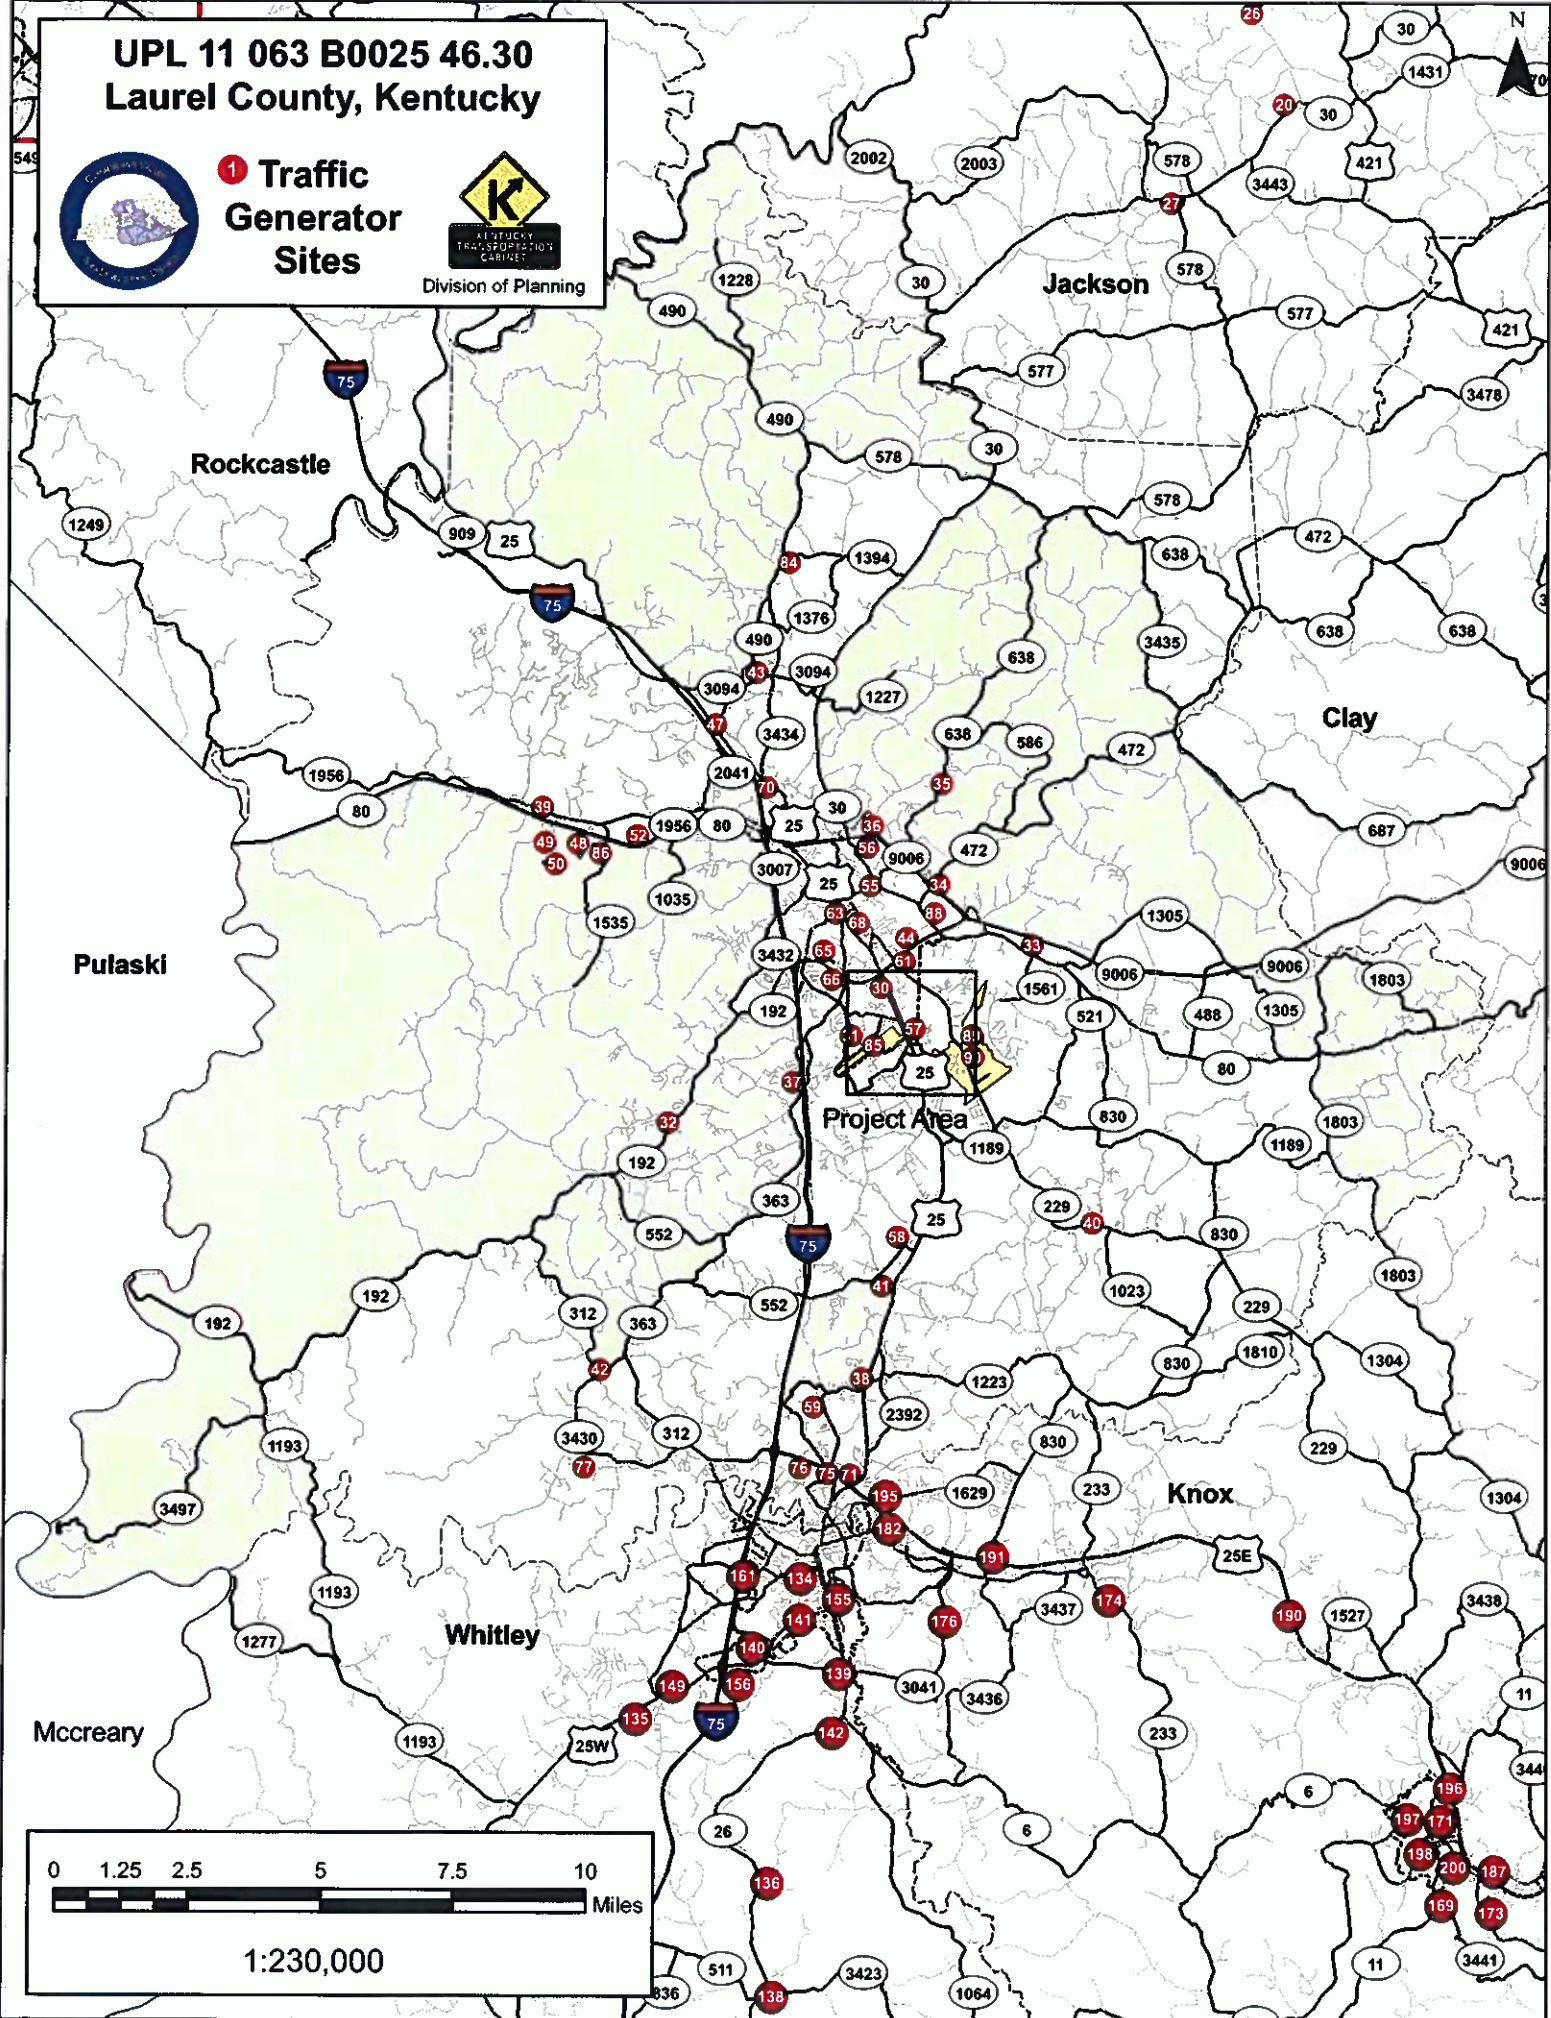



UPL 11 063 B0025 46.30
Laurel County, Kentucky



1 Traffic Generator Sites



Division of Planning

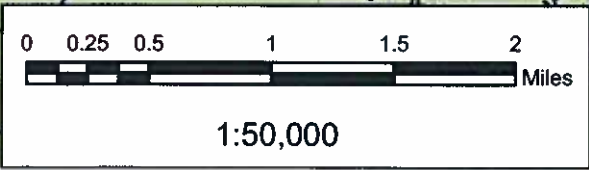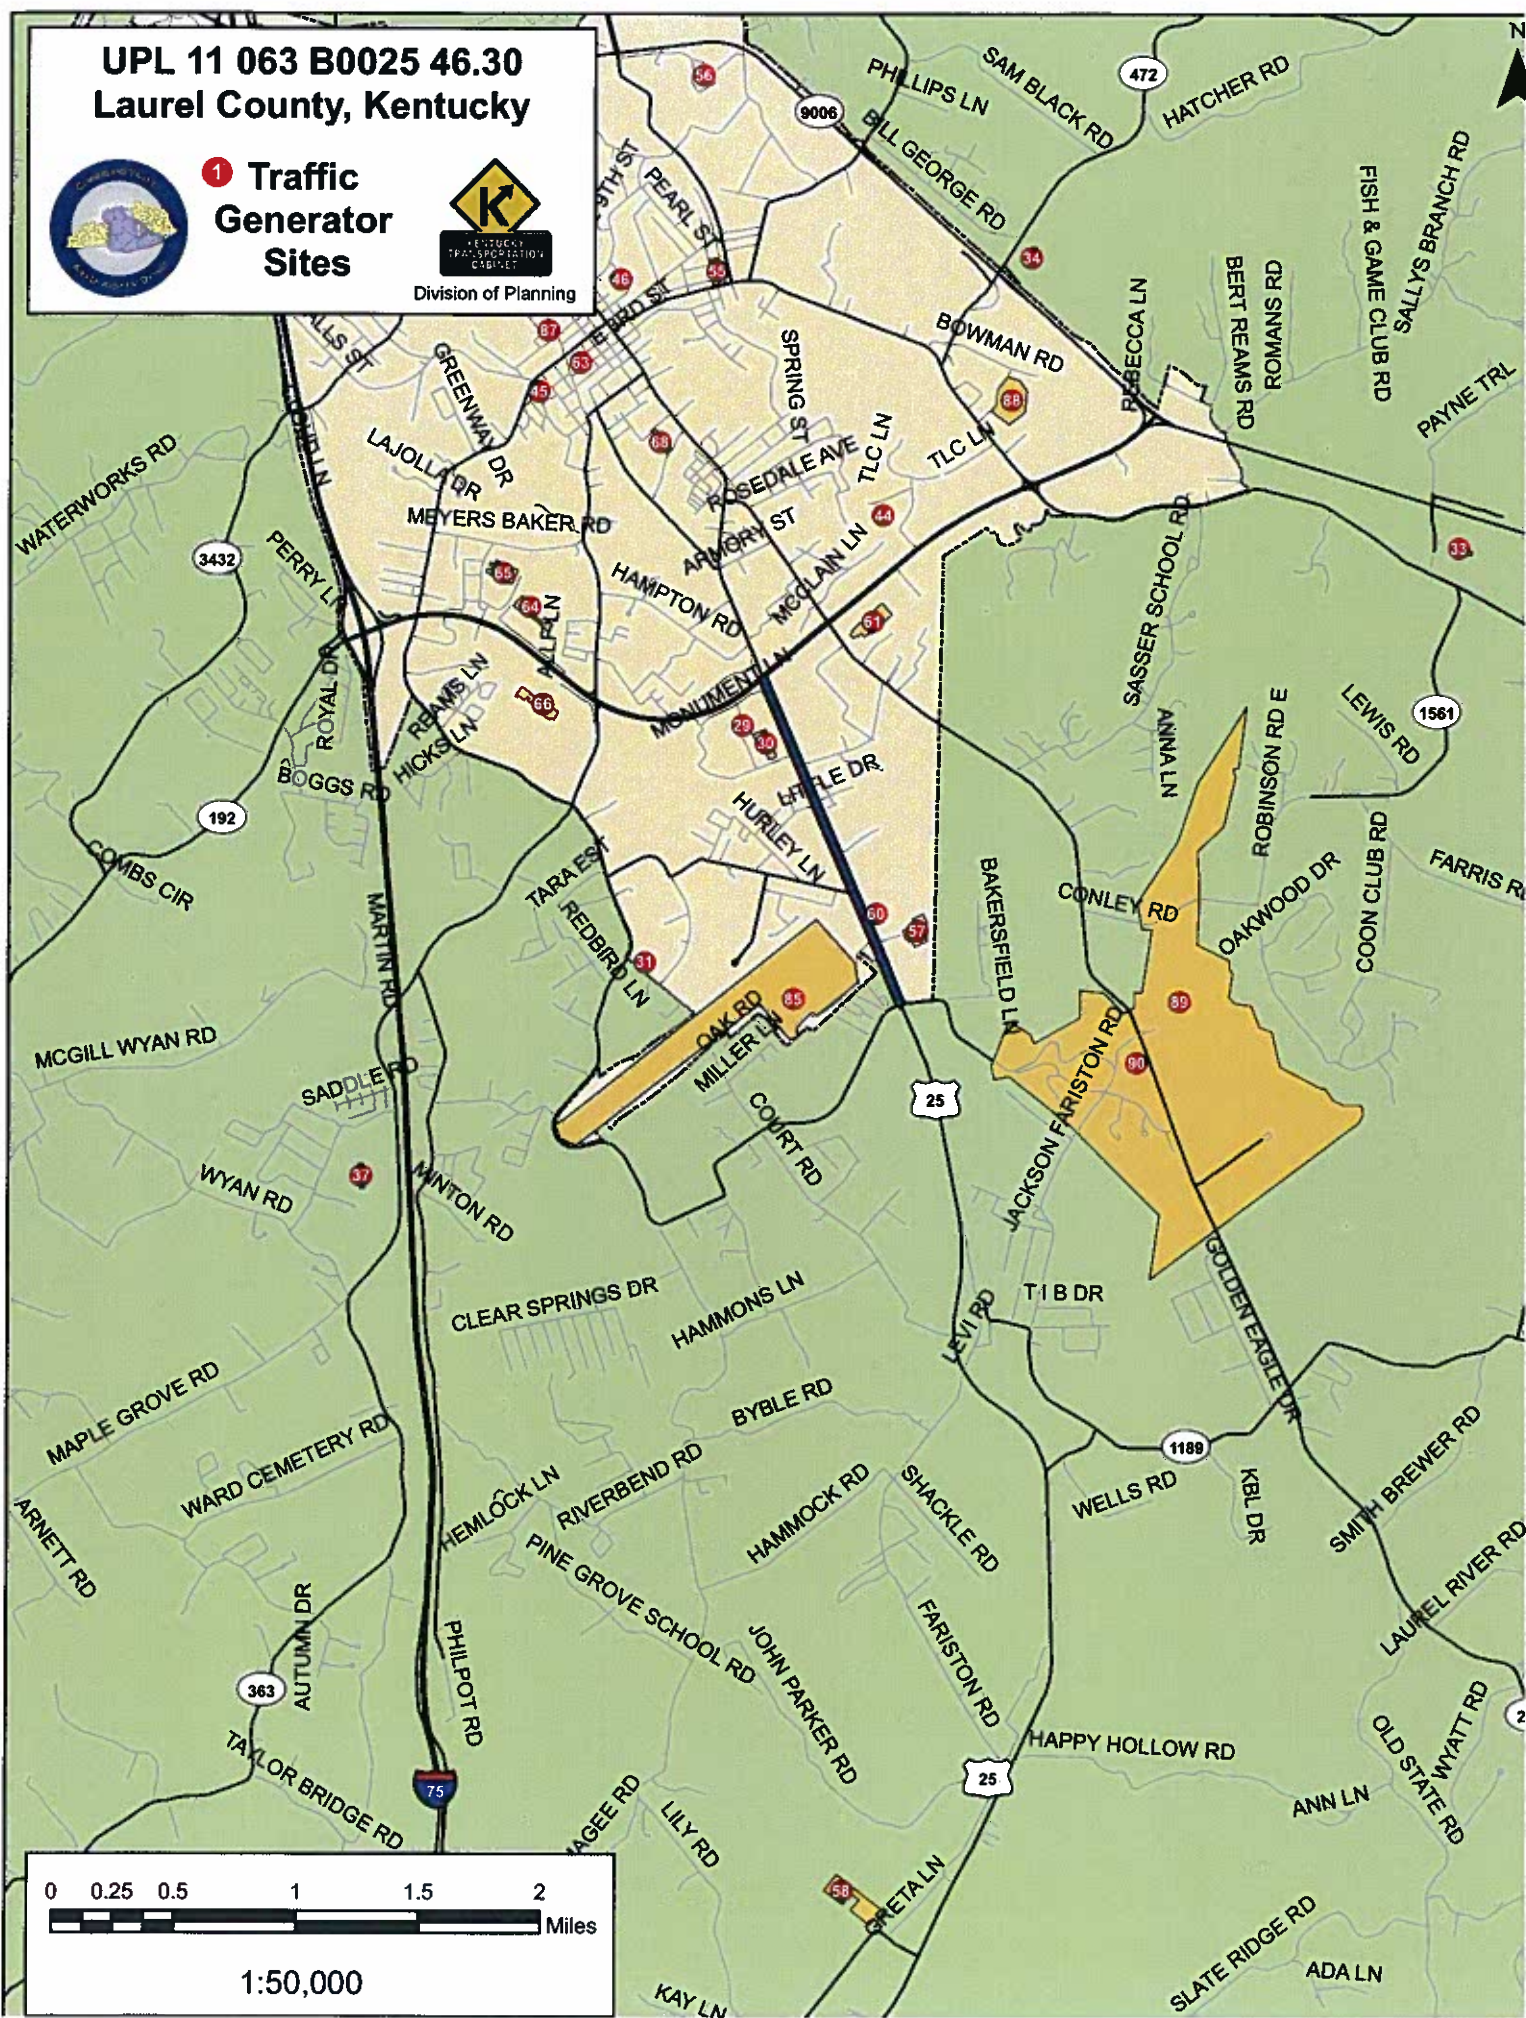

UPL # 11 063 B0025 46.30





NEW PIF <> SEARCH <> STATUS

DIVISION OF PLANNING

ADMIN <> HELP <> LOGOUT

GENERAL INFO ROW/UTIL ECO/SOCIAL ENV/AIRQLTY COST EST HIGHWAY ATT PIF STATUS RANKING

GENERAL INFORMATION

The PIF has an attachment. Click this Image for PDF:

Control No: 11 063 D0229 1.26

Requestor Name:

Requestor Title:

Requested By Date: 07/17/2008

Form Completed By: Clay McKnight

Title/Organization: Transportation Planner/C

Form Completed Date: 07/17/2008

District: 11

County: Laurel

Prefix: KY

Route No: 229

Route Type: D

Suffix:

BMP: 9.850

Length: 1.672

Status: Active

Mode: Highways

Type: Major widening

ADD: CUMBERLAND VALLEY

MPO: Select

Urban Area: London KY

Parent Control No:

RSE Unique No: 063-KY-0229 -000

BMP	EMP	SPRS
0	12.2110	State Secondary

BMP	EMP	FC
0	10.8880	Rural Major Collector
10.8880	12.2110	Urban Minor Arterial Street

EMP: 11.522

Existing Studies: NONE

Project Description:

ADDRESS ACCESS, SURFACE CONDITION, AND SAFETY ISSUES ALONG KY-229 FROM CONLEY RD TO KY-192 AT LONDON.

Regional Goal:

1. Develop and maintain existing primary systems that provide connections between cities and counties in the CVADD. 2.Promote lane and intersection expansions to improve traffic flow in congested urban and rural areas. 3.Improve highway safety at locations and/or corridors where traffic crash data has yielded an identified solution

Last Updated By: lesli.gill Last Updated Date: 7/29/2010 9:10:30 AM

Possible Funding source: IM NH HES BR STP SP TE CMAQ PLH

Other:

Highway Network: Non NHS NHS NN Scenic Way Coal Haul Bike Forest Strahnet Ext Weight ADHS

piF Project Identification Form UNRESCHEDULED NEEDS



NEW PIF <> SEARCH <> STATUS

DIVISION OF PLANNING

ADMIN <> HELP <> LOGOUT

GENERAL INFO ROW/UTIL ECO/SOCIAL ENV/AIRQLTY COST EST HIGHWAY ATT PIF STATUS RANKING

RIGHT OF WAY

Avg. Width:

Source: HIS Plans Microfilm

Other:

Current Primary Use: Industrial Commercial Residential Farmland

Other:

Project may require additional R/W: False True

Possible Number of Relocations: Homes Businesses

Comments:

UTILITIES

Existing Utilities: Electrical Gas Telephone Cable
 Sewer Water ITS None

Other:

Project may require Utility Relocations: False True

Comments:



Project Identification Form



NEW PIF <> SEARCH <> STATUS

DIVISION OF PLANNING

ADMIN <> HELP <> LOGOUT

GENERAL INFO ROW/UTIL ECO/SOCIAL ENV/AIRQLTY COST EST HIGHWAY ATT PIF STATUS RANKING

ECONOMIC IMPACT

Planning/Zoning Reg exist in Community: False True

Project may affect established Business, Commercial or Industrial districts: False True

Economic impacts on regional/local economy: False True Development Tax Revenues Emp Opportunity Retail Sales Other

Comments: Improved access will enhance commercial activity and promote development.

Direct access to major points of interest: False True Nat'l/St Parks Monuments Amusement Parks Historic Sites US Public Land Other

Comments: Levi Jackson State Park, Laurel County Fairgrounds, City of London

Direct access to major traffic generators: False True Shopping Centers Schools Industries Military Installations Other

Comments: City of London, Levi Jackson State Park, Laurel Grocery Inc., Flea Land Flea Market, etc.

MULTIMODAL

This Project is a candidate for:(Check all that apply): Bicycle Paths Sidewalks Shared-Use Paths Park/Ride Lots N/A

Project Improves direct access to:(Check all that apply): Airports Railways Riverports Trucking routes N/A

Type of Public Transportation Available: Fixed routes Demand Response

Comments: Provides direct access to NN route KY 192. KY 229 is used by bike club regularly.

SOCIAL IMPACT

This Project May affect:(Check all that apply): Neighborhood/community Cohesion Travel Patterns (vehicular, commuter, bicycle, pedestrian) Household relocations Elderly, disabled, nondrivers, minorities, low-income persons No adverse effects to neighborhoods apparent

Comments: Due to the size and scope of the project, social impacts may occur.



UNSCHEDULED NEEDS

NEW PIF <> SEARCH <> STATUS

DIVISION OF PLANNING

ADMIN <> HELP <> LOGOUT

GENERAL INFO ROW/UTIL ECO/SOCIAL ENV/AIRQLTY COST EST HIGHWAY ATT PIF STATUS RANKING

ENVIRONMENTAL IMPACT

- Environmental Impact:
- Blue Line Streams
 - Wetlands
 - Floodplain
 - Wildlife Managed Areas
 - Historic Properties
 - Cemeteries
 - Schools
 - Churches
 - Endangered species
 - Public land/Park
 - Noise Impact
 - Arch. Sites
 - NR Properties
 - Potential NR Properties

Other:

- Potential Contaminated sites:
- Gas Stations
- Landfills
- Auto Repair
- Junkyards

Other:

Comments:

AIR QUALITY

Maintenance or Nonattainment Area: False True Ozone PM

Adds through Lane Capacity: False True

Congestion Management Plan: False True

Project is included in TIP/STIP: False True

Comments: Expanded lane structure will provide through lane capacity.





NEW PIF <> SEARCH <> STATUS

DIVISION OF PLANNING

ADMIN <> HELP <> LOGOUT

GENERAL INFO ROW/UTIL ECO/SOCIAL ENV/AIRQLTY COST EST HIGHWAY ATT PIF STATUS RANKING

COST ESTIMATE

PIF #: 11 063 D0229 1.26

Revision #: 0

BMP: 9.850

EMP: 11.522

Last Updated By: 2/25/2010 4:51:20 PM

Last Updated Date: sowjanya.burugupalli

Estimate Class: Requires Further Study

Per Mile

	BMP	EMP	TERRAIN
Terrain:	2.3150	10.8880	Rolling
	10.8880	12.2110	Flat

Detailed Estimate with Calculations Attached

Estimate Assumptions:

Planning: No Records

Design: No Records

Right of Way: No Records

Utilities: No Records

Construction: No Records

	Planning:	00.00
	Design:	1,000,000.00
Original Estimate:	Right of Way:	3,000,000.00
	Utilities:	2,500,000.00
	Construction:	11,000,000.00
	Total Cost:	17,500,000.00

Estimate Procedure Used:

Attachments: Location Map Photograph(s) Others: Sheet showing Cost Estimate

Comments:



piF Project Identification Form UNSCHEDULED NEEDS



NEW PIF <> SEARCH <> STATUS

DIVISION OF PLANNING

ADMIN <> HELP <> LOGOUT

GENERAL INFO ROW/UTIL ECO/SOCIAL ENV/AIRQLTY COST EST HIGHWAY ATT PIF STATUS RANKING

HIGHWAY ATTRIBUTES

PIF #: 11 063 D0229 1.26

BMP: 9.850

EMP: 11.522

Last Updated By: lesli.gill

Last Updated Date: 8/4/2010 4:46:56 AM

Adequacy Rating Range

	From	To	Problem Statement
Adequacy Rating:	50.60	81.90	This project from Levi Jackson State Park entrance to KY 192 (London Bypass) was identified in the 2001 London-Laurel County Transportation Study to address access and safety issues. The project area has experienced industrial, commercial, and residential growth over the course of the past few years and provides direct access to KY 192 (London Bypass), Laurel County Fairgrounds, and the Levi Jackson State
CRF:	0.4810	0.9060	
IRI:	63.93	161.78	
V/SF:	0.36	0.69	
ADT:	4300	9510	
% Trucks (Single):	2.70	4.30	
% Trucks (Combination):	1.80	2.10	
Speed Limit:	55	55	

Projected ADT (HDO)/Year: % Growth: Projected ADT:

Miscellaneous Roadway Conditions

	BMP	EMP	TYPE
Access Control:	0	12.2110	None

Proposed Access Control: *

	BMP	EMP	WIDTH	LANES
Lane Width:	0	11.4470	10	2
	11.4470	11.60	11	2

Proposed Lane Width: *

Proposed Lanes: *

	BMP	EMP	WIDTH	TYPE
Median Type:	0	11.4470		None
	11.4470	11.60	12	Raised Non Mountable

Proposed Median Type: *

Proposed Median Width: *

	BMP	EMP	WIDTH	TYPE	X SECT
Shoulders:	7.84	11.33	2	Paved w/ Bituminous Material	CR
	7.84	11.33	2	Paved w/ Bituminous Material	NR
	11.33	11.66	4	Paved w/ Bituminous Material	CR

11.33	11.66	4	Paved w/ Bituminous Material	NR
11.4470	11.60	3	Curbed	CL
11.4470	11.60	3	Curbed	NL

Proposed Shoulder Type: Paved w/ Bituminous Material *

Proposed Shoulder Width: 10 *

No. of Bridges: 1

Traffic Loop:

Other Improvement Projects in Area: None SYP Resurface Others

Comments:



piF **UNRESCHEDULED NEEDS**
 Project Identification Form 

NEW PIF <> SEARCH <> STATUS

DIVISION OF PLANNING

ADMIN <> HELP <> LOGOUT

GENERAL INFO ROW/UTIL ECO/SOCIAL ENV/AIRQLTY COST EST HIGHWAY ATT PIF STATUS RANKING

STATUS HISTORY

STATUS TYPE	STATUS UPDATED DATE	STATUS UPDATED BY
Active	2/22/2010 10:48:34 AM	sowjanya.buruugpalli
Active	7/29/2010 9:10:30 AM	lesli.gill





NEW PIF <> SEARCH <> STATUS

DIVISION OF PLANNING

ADMIN <> HELP <> LOGOUT

GENERAL INFO ROW/UTIL ECO/SOCIAL ENV/AIRQTY COST EST HIGHWAY ATT PIF STATUS RANKING

RANKING

Click the 'Add Rank' button below to Rank this PIF


RANK TYPE	YEAR	PRIORITY	RANK	TIER	OVERALL	UPDATED BY	UPDATED DATE
LOCAL	2001	NONE	0			sowjanya.burugupalli	3/10/2010 12:53:50 PM
REGIONAL	2001	NONE	0			sowjanya.burugupalli	3/10/2010 12:54:17 PM
DISTRICT	2001	NONE	0			sowjanya.burugupalli	3/10/2010 12:55:15 PM
LOCAL	2003	NONE	0			sowjanya.burugupalli	3/10/2010 2:10:17 PM
REGIONAL	2003	NONE	0			sowjanya.burugupalli	3/10/2010 2:26:12 PM
DISTRICT	2003	NONE	0			sowjanya.burugupalli	3/10/2010 2:29:01 PM
LOCAL	2005	NONE	0			sowjanya.burugupalli	4/5/2010 11:21:25 AM
REGIONAL	2005	NONE	0			sowjanya.burugupalli	4/5/2010 11:27:35 AM
DISTRICT	2005	NONE	0			sowjanya.burugupalli	4/5/2010 12:37:55 PM
LOCAL	2007	NONE	0			sowjanya.burugupalli	4/5/2010 1:15:00 PM
REGIONAL	2007	NONE	0			sowjanya.burugupalli	4/5/2010 1:29:02 PM
DISTRICT	2007	NONE	0			sowjanya.burugupalli	4/5/2010 3:53:38 PM
LOCAL	2009	MEDIUM	0			sowjanya.burugupalli	4/5/2010 4:29:45 PM
REGIONAL	2009	MEDIUM	0			sowjanya.burugupalli	4/5/2010 4:30:32 PM
DISTRICT	2009	HIGH	0			sowjanya.burugupalli	4/5/2010 4:31:01 PM



UPL 11 063 D0229 1.26
Laurel County, Kentucky



1 Traffic
Generator
Sites

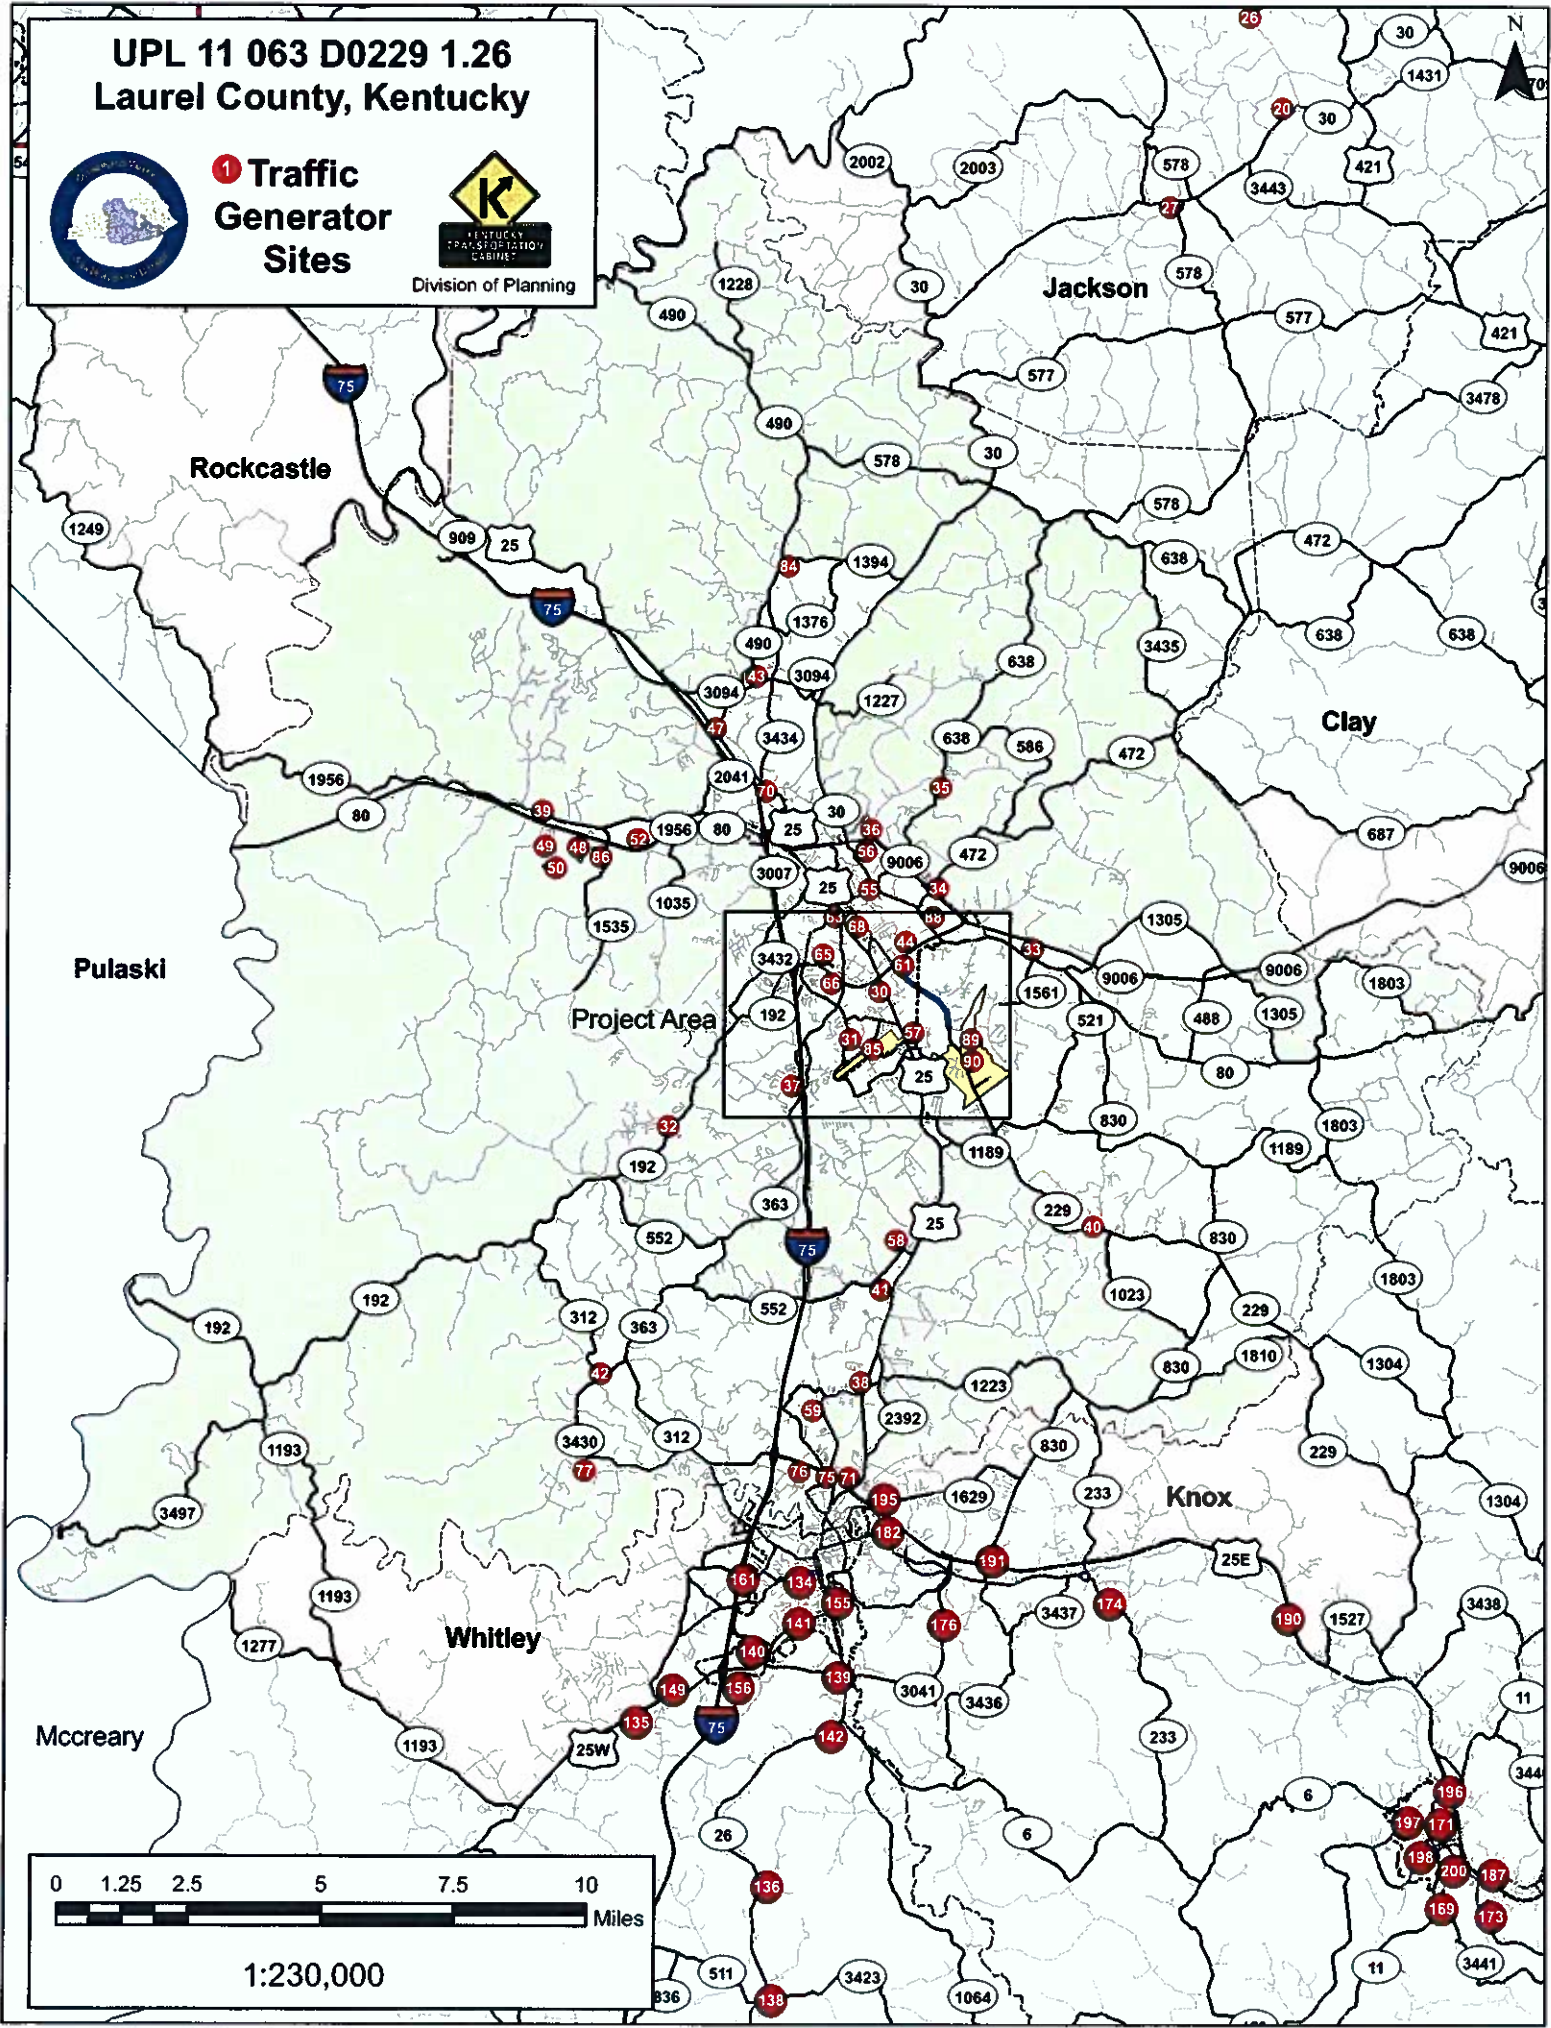



UPL 11 063 D0229 1.26
Laurel County, Kentucky



1 Traffic
Generator
Sites



KENTUCKY
TRANSPORTATION
CABINET
Division of Planning

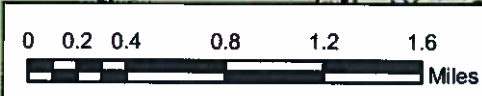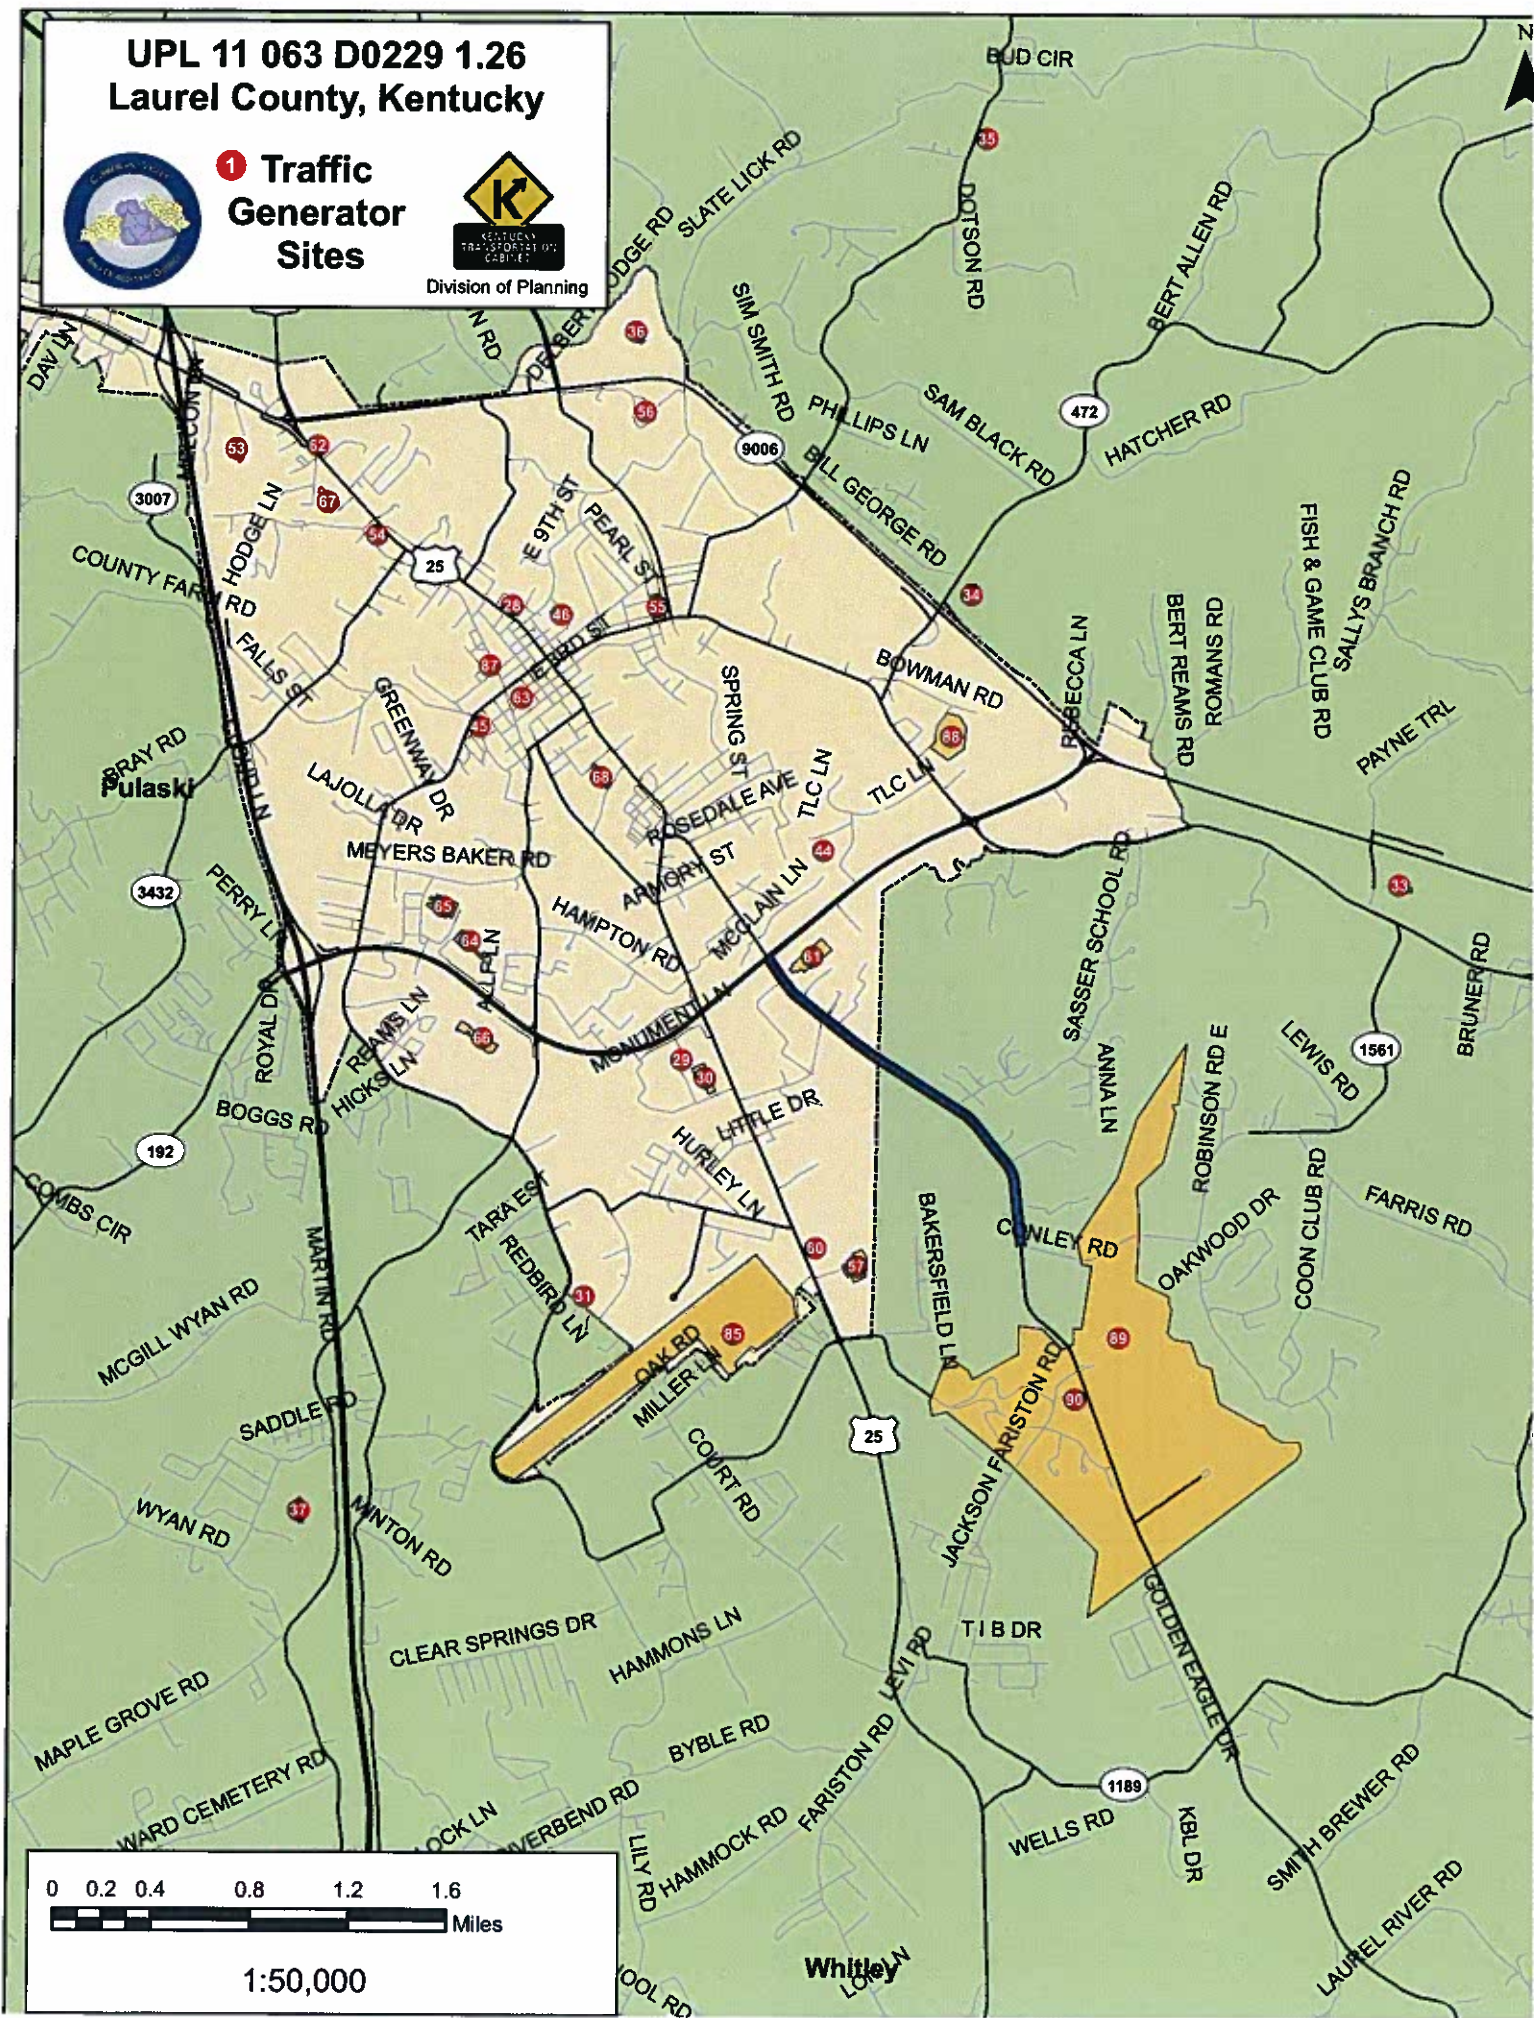

1:50,000

Whitley
Low

UPL # 11 063 D0229 1.26



COMMON GEOMETRIC PRACTICES URBAN ROADWAYS (OTHER THAN FREEWAYS)

(13)

		URBAN LOCAL STREETS	URBAN COLLECTOR STREETS	URBAN ARTERIAL STREETS											
DESIGN SPEED (14)		20 M.P.H. - 30 M.P.H.	MIN. 30 M.P.H.	30 M.P.H. - 60 M.P.H.											
NUMBER OF LANES		MINIMUM 2	MINIMUM 2 (4)	MINIMUM 2 (4)											
LANE WIDTH	RESIDENTIAL	MIN. 10' (1)	MIN. 10' (2)	12' FREE FLOW CONDITION (2) 11' MIN. INTERRUPTED FLOW CONDITION											
	COMMERCIAL	MIN. 11'	MIN. 11'												
	INDUSTRIAL	MIN. 12' (3)	MIN. 12' (3)												
SIDEWALK	RESIDENTIAL COMMERCIAL	MINIMUM 4' DESIRABLE 8' (16)													
MINIMUM CLEAR ROADWAY WIDTH OF NEW AND (11) RECONSTRUCTED BRIDGES		MINIMUM CURB TO CURB WIDTH													
BERM AREA (5)		10' TYPICAL													
MINIMUM RADIUS (FEET)		(6)													
MAXIMUM GRADE (PERCENT)	- R) - MAX. 15% - C) - MAX. 8% (12) - I) - MAX. 8%	M.P.H.	30	35	40	45	50	(9) M.P.H.	30	35	40	45	50	55	60
		LEVEL	9			8	7	LEVEL	8	7	6	5			
		ROLLING	11	10	9	8	ROLLING	9	8	7	6				
		MOUNTAIN	12			11	10	MOUNTAIN	11	10	9	8			
NORMAL PAVEMENT CROSS SLOPE (8)		RATE OF CROSS SLOPE = 2%													
NORMAL SHOULDER CROSS SLOPE		EARTH - 8%						PAVED - 4%							
SUPERELEVATION		(10) 4% MAX.	4% MAX.				4% - 6% MAX.								
MINIMUM STOPPING SIGHT DISTANCE (FEET) (7)	M.P.H.	20	25	30	35	40	45	50	55	60					
	MIN.	115	155	200	250	305	360	425	495	570					

- R) = RESIDENTIAL

- C) = COMMERCIAL

- I) = INDUSTRIAL

- ① TURNING LANES : 9' MINIMUM - 12' DESIRABLE; PARKING LANES : RESIDENTIAL - 7' MINIMUM - 10' DESIRABLE; COMMERCIAL & INDUSTRIAL - 9' MINIMUM - 12' DESIRABLE.
- ② TURNING LANES : 10' MINIMUM - 12' DESIRABLE; PARKING LANES : 9' MINIMUM - 12' DESIRABLE.
- ③ VERTICAL CURBS WITH HEIGHTS OF 6" OR GREATER ADJACENT TO TRAVELED WAY SHOULD BE OFFSET A MINIMUM OF 1 FOOT. WHEN A CURB AND GUTTER SECTION IS PROVIDED, THE GUTTER PAN WIDTH, NORMALLY 2 FEET, SHOULD BE USED AS THE OFFSET DISTANCE.
- ④ THE NUMBER OF LANES TO BE PROVIDED ON STREETS WITH A CURRENT ADT OF 2000 OR GREATER SHOULD BE DETERMINED BY A HIGHWAY CAPACITY ANALYSIS OF THE DESIGN TRAFFIC VOLUMES. SUCH ANALYSIS SHOULD BE MADE FOR FUTURE DESIGN TRAFFIC. (DESIRABLE)
- ⑤ THE BERM AREA IS TYPICALLY FROM FACE OF CURB TO 2 FEET BEHIND BACK OF SIDEWALK.
- ⑥ REFER TO CHAPTER 3 OF AASHTO'S "A POLICY ON GEOMETRIC DESIGN OF HIGHWAYS AND STREETS" CURRENT EDITION.
- ⑦ MINIMUM STOPPING SIGHT DISTANCES ARE BASED ON HEIGHT OF EYE 3.5 FT. & HEIGHT OF OBJECT OF 2.0 FT. BOTH HORIZONTAL & VERTICAL ALIGNMENTS CONSIDERED.
- ⑧ NORMAL PAVEMENT CROSS SLOPES ON BRIDGES SHALL BE 2 PERCENT.
- ⑨ ARTERIALS WITH LARGE NUMBERS OF TRUCKS AND OPERATING NEAR CAPACITY SHOULD CONSIDER GRADES FLATTER THAN THOSE IN RURAL SECTIONS TO AVOID UNDESIRABLE REDUCTIONS IN SPEEDS.
- ⑩ SUPERELEVATION MAY NOT BE REQUIRED ON LOCAL STREETS IN RESIDENTIAL AND COMMERCIAL AREAS.
- ⑪ THE BRIDGE WIDTH FOR URBAN ROADWAYS WITH SHOULDERS AND NO CURBS SHOULD NOT BE LESS THAN WIDTHS SHOWN FOR RURAL ROADS APPROVED ROADWAY WIDTHS.
- ⑫ MAXIMUM GRADES OF SHORT LENGTHS (LESS THAN 500') AND ON ONE-WAY DOWN GRADES MAY BE ONE PERCENT STEEPER.
- ⑬ FOR GUIDANCE ON FREEWAYS, REFER TO AASHTO, "A POLICY ON GEOMETRIC DESIGN OF HIGHWAYS AND STREETS."
- ⑭ INTERMEDIATE DESIGN SPEEDS (5 M.P.H. INCREMENTS) MAY BE APPROPRIATE WHERE TERRAIN AND OTHER ENVIRONMENTAL CONDITIONS DICTATE.
- ⑮ REFER TO AASHTO'S "GUIDE FOR THE DEVELOPMENT OF BICYCLE FACILITIES", CURRENT EDITION, WHEN COMBINING A PEDESTRIAN SIDEWALK WITH A BICYCLE PATH.

APPENDIX D

MASTER FILE NUMBER	ROADWAY NUMBER	MILEPOINT DERIVED	COLLISION DATE	COLLISION TIME	UNITS INVOLVED	KILLED	INJURED	WEATHER	ROADWAY CONDITION	MANNER OF COLLISION	ROADWAY CHARACTER	LIGHT CONDITION
70516239	US0025	10.08	03-Dec-07	0830	2	0	0	CLOUDY	DRY	SIDESWIPE-SAME DIRECTION	STRAIGHT & LEVEL	DAYLIGHT
70534716	US0025	10.082	23-Jan-08	1223	2	0	2	CLOUDY	DRY	REAR END	STRAIGHT & LEVEL	DAYLIGHT
70649966	US0025	10.085	30-Dec-08	0950	2	0	0	CLEAR	DRY	HEAD ON	STRAIGHT & LEVEL	DAYLIGHT
70785150	US0025	10.09	01-Dec-09	1351	2	0	0	CLOUDY	DRY	REAR END	STRAIGHT & LEVEL	DAYLIGHT
70588321	US0025	10.091	20-Jun-08	1325	2	0	0	CLEAR	DRY	REAR END	STRAIGHT & LEVEL	DAYLIGHT
70780271	US0025	10.095	18-Nov-09	1042	3	0	0	CLOUDY	WET	SIDESWIPE-OPPOSITE	STRAIGHT & LEVEL	DAYLIGHT
70456237	US0025	10.101	04-Jun-07	1628	2	0	0	RAINING	WET	REAR END	STRAIGHT & LEVEL	DAYLIGHT
70433281	US0025	10.104	14-Apr-07	1307	2	0	2	RAINING	WET	ANGLE	STRAIGHT & LEVEL	DAYLIGHT
70462942	US0025	10.105	19-Jul-07	1802	2	0	0	CLEAR	DRY	REAR END	STRAIGHT & LEVEL	DAYLIGHT
70544198	US0025	10.107	18-Feb-08	0424	1	0	0	CLOUDY	WET	SINGLE VEHICLE	STRAIGHT & LEVEL	DARK-HWY LIGHTED/ON
70736365	US0025	10.107	04-Aug-09	1554	2	0	0	CLEAR	DRY	ANGLE	STRAIGHT & LEVEL	DAYLIGHT
70786269	US0025	10.107	03-Dec-09	1708	2	0	0	CLEAR	DRY	ANGLE	STRAIGHT & LEVEL	DUSK
70456256	US0025	10.107	07-Jun-07	1710	2	0	2	CLEAR	DRY	ANGLE	STRAIGHT & LEVEL	DAYLIGHT
70675266	US0025	10.107	11-Feb-09	1525	2	0	1	RAINING	WET	ANGLE	STRAIGHT & LEVEL	DAYLIGHT
70759758	US0025	10.107	06-Oct-09	1457	2	0	0	RAINING	WET	ANGLE	STRAIGHT &	DAYLIGHT
70442643	US0025	10.109	22-May-07	0814	2	0	0	CLEAR	DRY	ANGLE	STRAIGHT & LEVEL	DAYLIGHT
70784752	US0025	10.112	30-Nov-09	0705	2	0	0	RAINING	WET	ANGLE	STRAIGHT & LEVEL	DARK-HWY NOT LIGHTED
70456246	US0025	10.127	07-Jun-07	1413	2	0	0	CLEAR	DRY	REAR END	STRAIGHT & LEVEL	DAYLIGHT
70663880	US0025	10.132	28-Jan-09	1115	2	0	0	BLOWING	SNOW/SLU	REAR END	STRAIGHT & LEVEL	DAYLIGHT
70500155	US0025	10.137	13-Nov-07	0752	2	0	0	RAINING	WET	REAR END	STRAIGHT & LEVEL	DAYLIGHT
70550034	US0025	10.141	21-Mar-08	1101	2	0	0	CLEAR	DRY	SIDESWIPE-SAME DIRECTION	STRAIGHT & LEVEL	DAYLIGHT
70695725	US0025	10.143	17-Apr-09	0742	2	0	0	CLEAR	DRY	ANGLE	STRAIGHT & LEVEL	DAYLIGHT
70516215	US0025	10.153	05-Dec-07	0748	2	0	0	CLOUDY	DRY	ANGLE	STRAIGHT & LEVEL	DAYLIGHT
70433275	US0025	10.153	10-Apr-07	1325	2	0	1	CLEAR	DRY	REAR END	STRAIGHT & LEVEL	DAYLIGHT
70494892	US0025	10.153	11-Oct-07	1445	3	0	0	CLEAR	DRY	REAR END	STRAIGHT & LEVEL	DAYLIGHT
70462814	US0025	10.154	10-Jul-07	1343	2	0	0	CLOUDY	DRY	SIDESWIPE-OPPOSITE	STRAIGHT & LEVEL	DAYLIGHT
70550023	US0025	10.162	24-Mar-08	2042	2	0	0	CLEAR	DRY	REAR END	STRAIGHT & LEVEL	DARK-HWY LIGHTED/ON
70698620	US0025	10.162	04-May-09	1103	2	0	0	CLOUDY	WET	ANGLE	STRAIGHT & LEVEL	DAYLIGHT
70571012	US0025	10.162	13-May-08	1347	2	0	0	CLEAR	DRY	REAR END	STRAIGHT & LEVEL	DAYLIGHT
70409454	US0025	10.162	31-Jan-07	1449	2	0	0	CLEAR	DRY	ANGLE	STRAIGHT & LEVEL	DAYLIGHT
70687316	US0025	10.163	10-Mar-09	2155	2	0	0	CLEAR	DRY	REAR END	STRAIGHT & LEVEL	DARK-HWY LIGHTED/ON
70404535	US0025	10.163	04-Jan-07	0752	2	0	2	CLEAR	DRY	ANGLE	STRAIGHT & LEVEL	DAYLIGHT
70494882	US0025	10.164	29-Sep-07	1244	2	0	0	CLEAR	DRY	REAR END	STRAIGHT & LEVEL	DAYLIGHT
70570293	US0025	10.165	01-May-08	1458	2	0	0	CLEAR	DRY	SIDESWIPE-SAME DIRECTION	STRAIGHT & LEVEL	DAYLIGHT

MASTER FILE NUMBER	ROADWAY NUMBER	MILEPOINT DERIVED	COLLISION DATE	COLLISION TIME	MOTOR VEHICLES INVOLVED	KILLED	INJURED	WEATHER	ROADWAY CONDITION	MANNER OF COLLISION	ROADWAY CHARACTER	LIGHT CONDITION
70426195	US0025	11.2	19-Feb-07	0948	2	0	1	CLEAR	DRY	ANGLE	STRAIGHT & LEVEL	DAYLIGHT
70544183	US0025	11.216	12-Mar-08	1502	3	0	1	CLEAR	DRY	REAR END	STRAIGHT & LEVEL	DAYLIGHT
70736359	US0025	11.22	07-Aug-09	1510	2	0	0	CLEAR	DRY	ANGLE	STRAIGHT & LEVEL	DAYLIGHT
70452332	US0025	11.223	13-Jun-07	1448	3	0	0	CLEAR	DRY	REAR END	STRAIGHT & LEVEL	DAYLIGHT
70706534	US0025	11.24	19-May-09	1203	2	0	0	CLEAR	DRY	BACKING	STRAIGHT & LEVEL	DAYLIGHT
70494909	US0025	11.254	22-Oct-07	1100	2	0	0	CLOUDY	WET	REAR END	STRAIGHT & GRADE	DAYLIGHT
70729682	US0025	11.255	17-Jul-09	1432	2	0	0	CLEAR	DRY	REAR END	STRAIGHT & LEVEL	DAYLIGHT
70462872	US0025	11.255	08-Jun-07	1538	2	0	0	RAINING	WET	REAR END	STRAIGHT & LEVEL	DAYLIGHT
70736976	US0025	11.255	10-Aug-09	1725	3	0	0	CLEAR	DRY	REAR END	STRAIGHT & LEVEL	DAYLIGHT
70426213	US0025	11.255	26-Feb-07	1320	2	0	0	CLOUDY	DRY	SIDESWIPE	STRAIGHT & GRADE	DAYLIGHT
70426207	US0025	11.264	20-Mar-07	1115	2	0	0	CLOUDY	WET	REAR END	STRAIGHT & LEVEL	DAYLIGHT
70404506	US0025	11.3	04-Jan-07	1535	2	0	0	CLEAR	DRY	REAR END	STRAIGHT & LEVEL	DAYLIGHT

MASTER FILE NUMBER	ROADWAY NUMBER	MILEPOINT DERIVED	COLLISION DATE	COLLISION TIME	UNITS INVOLVED	KILLED	INJURED	WEATHER	ROADWAY CONDITION	MANNER OF COLLISION	ROADWAY CHARACTER	LIGHT CONDITION
70409474	US0025	9.028	12-Feb-07	1850	2	0	0	RAINING	WET	ANGLE	STRAIGHT & LEVEL	DARK-HWY NOT LIGHTED
70412809	US0025	9.028	22-Feb-07	1448	3	0	1	CLEAR	DRY	REAR END	STRAIGHT & LEVEL	DAYLIGHT
70650017	US0025	9.029	17-Dec-08	1757	2	0	2	RAINING	WET	REAR END	STRAIGHT & LEVEL	DARK-HWY LIGHTED/OFF
70426222	US0025	9.037	28-Feb-07	1618	3	0	1	CLEAR	DRY	REAR END	STRAIGHT & LEVEL	DAYLIGHT
70462868	US0025	9.047	12-Jul-07	1644	2	0	1	CLEAR	DRY	REAR END	STRAIGHT & LEVEL	DAYLIGHT
70786273	US0025	9.051	03-Dec-09	1748	2	0	1	CLOUDY	WET	REAR END	STRAIGHT & LEVEL	DARK-HWY NOT LIGHTED
70800184	US0025	9.071	21-Dec-09	1836	2	0	0	CLEAR	DRY	ANGLE	STRAIGHT & LEVEL	DARK-HWY NOT LIGHTED
70776955	US0025	9.073	09-Nov-09	1747	2	0	3	CLOUDY	DRY	REAR END	STRAIGHT & LEVEL	DARK-HWY NOT LIGHTED
70560374	US0025	9.082	24-Apr-08	1713	2	0	1	CLEAR	DRY	REAR END	STRAIGHT & LEVEL	DAYLIGHT
70570997	US0025	9.122	30-May-08	1649	2	0	0	CLEAR	DRY	REAR END	STRAIGHT & LEVEL	DAYLIGHT
70776948	US0025	9.123	09-Nov-09	1411	2	0	0	CLOUDY	DRY	REAR END	STRAIGHT & LEVEL	DAYLIGHT
70510857	US0025	9.134	07-Dec-07	0925	2	0	0	CLOUDY	DRY	SIDESWIPE-SAME DIRECTION	STRAIGHT & LEVEL	DAYLIGHT
70622745	US0025	9.145	07-Oct-08	1944	2	0	0	CLEAR	DRY	REAR END	STRAIGHT & LEVEL	DARK-HWY LIGHTED/ON
70571009	US0025	9.148	06-May-08	1208	2	0	0	CLEAR	DRY	ANGLE	STRAIGHT & LEVEL	DAYLIGHT
70698638	US0025	9.165	01-May-09	1511	4	0	0	CLOUDY	WET	REAR END	STRAIGHT & LEVEL	DAYLIGHT
70556337	US0025	9.169	04-Apr-08	1532	2	0	0	RAINING	WET	REAR END	STRAIGHT & LEVEL	DAYLIGHT
70759745	US0025	9.188	29-Sep-09	0930	2	0	0	CLEAR	DRY	REAR END	STRAIGHT & LEVEL	DAYLIGHT
70649987	US0025	9.197	12-Dec-08	1655	2	0	0	BLOWING	WET	REAR END	STRAIGHT & LEVEL	DUSK
70724551	US0025	9.226	11-Jun-09	1430	2	0	0	RAINING	WET	REAR END	STRAIGHT & LEVEL	DAYLIGHT
70649991	US0025	9.231	19-Dec-08	1540	2	0	4	CLEAR	DRY	REAR END	STRAIGHT & LEVEL	DAYLIGHT
70788294	US0025	9.288	04-Dec-09	1624	2	0	0	CLOUDY	DRY	REAR END	STRAIGHT & LEVEL	DAYLIGHT
70494796	US0025	9.307	19-Sep-07	0700	2	0	0	CLEAR	DRY	ANGLE	STRAIGHT & LEVEL	DAWN
70462877	US0025	9.317	12-Jul-07	1710	2	0	0	CLEAR	DRY	REAR END	STRAIGHT & LEVEL	DAYLIGHT
70698632	US0025	9.321	27-Apr-09	0924	2	0	0	CLEAR	DRY	SIDESWIPE-SAME DIRECTION	STRAIGHT & LEVEL	DAYLIGHT
70456261	US0025	9.427	01-Jun-07	1514	2	0	0	CLOUDY	DRY	REAR END	STRAIGHT & LEVEL	DAYLIGHT
70781709	US0025	9.43	18-Nov-09	1045	2	0	1	RAINING	WET	ANGLE	STRAIGHT & LEVEL	DAYLIGHT
70729681	US0025	9.437	17-Jul-09	1332	2	0	0	CLEAR	DRY	SIDESWIPE-OPPOSITE DIRECTION	STRAIGHT & LEVEL	DAYLIGHT
70570998	US0025	9.456	30-May-08	1636	2	0	0	CLEAR	DRY	REAR END	STRAIGHT & LEVEL	DAYLIGHT
70550020	US0025	9.464	17-Mar-08	1743	2	0	0	CLEAR	DRY	BACKING	STRAIGHT & LEVEL	DAYLIGHT
70735573	US0025	9.467	06-Aug-09	1624	2	0	0	CLEAR	DRY	REAR END	STRAIGHT & LEVEL	DAYLIGHT
70705261	US0025	9.482	15-May-09	1600	2	0	0	RAINING	WET	REAR END	STRAIGHT & LEVEL	DAYLIGHT
70404552	US0025	9.501	16-Jan-07	0635	2	0	0	CLOUDY	WET	ANGLE	STRAIGHT & LEVEL	DARK-HWY LIGHTED/OFF
70436056	US0025	9.528	02-May-07	1659	2	0	0	RAINING	WET	REAR END	STRAIGHT & LEVEL	DAYLIGHT
70544176	US0025	9.529	10-Mar-08	1148	2	0	0	CLEAR	DRY	ANGLE	STRAIGHT & LEVEL	DAYLIGHT
70494863	US0025	9.532	04-Sep-07	1523	2	0	0	CLEAR	DRY	REAR END	STRAIGHT & LEVEL	DAYLIGHT
70521314	US0025	9.542	01-Jan-08	1844	2	0	0	SNOWING	ICE	REAR END	STRAIGHT & LEVEL	DARK-HWY LIGHTED/ON
70494780	US0025	9.549	21-Sep-07	1719	2	0	0	CLOUDY	DRY	ANGLE	STRAIGHT & LEVEL	DAYLIGHT
70494854	US0025	9.549	12-Sep-07	0900	2	0	0	CLEAR	DRY	SIDESWIPE-SAME DIRECTION	STRAIGHT & LEVEL	DAYLIGHT
70650015	US0025	9.56	18-Dec-08	1135	2	0	2	RAINING	WET	ANGLE	STRAIGHT & LEVEL	DAYLIGHT
70409452	US0025	9.568	01-Feb-07	1859	3	0	0	CLOUDY	WET	ANGLE	STRAIGHT & LEVEL	DARK-HWY NOT LIGHTED
70516213	US0025	9.573	05-Dec-07	1615	2	0	0	SLEET/HAI	WET	REAR END	STRAIGHT & LEVEL	DAYLIGHT
70288014	US0025	9.577	21-Jan-06	1811	2	0	1	CLOUDY	DRY	HEAD ON	STRAIGHT & LEVEL	DUSK
70516246	US0025	9.586	01-Dec-07	1205	2	0	1	CLEAR	DRY	ANGLE	STRAIGHT & LEVEL	DAYLIGHT
70598051	US0025	9.592	01-Aug-08	1500	2	0	0	CLEAR	DRY	REAR END	STRAIGHT & LEVEL	DAYLIGHT
70521326	US0025	9.6	05-Jan-08	1525	2	0	0	CLOUDY	DRY	ANGLE	STRAIGHT & LEVEL	DAYLIGHT
70604994	US0025	9.611	08-Sep-08	1645	2	0	0	CLEAR	DRY	BACKING	STRAIGHT & LEVEL	DAYLIGHT
70740666	US0025	9.626	10-Aug-09	1536	2	0	0	RAINING	WET	REAR END	STRAIGHT & LEVEL	DAYLIGHT
70588970	US0025	9.628	07-Jul-08	1605	2	0	0	RAINING	WET	REAR END	STRAIGHT & LEVEL	DAYLIGHT
70462901	US0025	9.63	24-Jul-07	1629	2	0	0	RAINING	WET	REAR END	STRAIGHT & LEVEL	DAYLIGHT
70534733	US0025	9.635	08-Jan-08	1627	2	0	0	CLOUDY	DRY	SIDESWIPE-SAME DIRECTION	STRAIGHT & LEVEL	DAYLIGHT
70695791	US0025	9.637	22-Apr-09	1540	2	0	0	CLEAR	DRY	ANGLE	STRAIGHT & LEVEL	DAYLIGHT
70534713	US0025	9.645	22-Jan-08	0918	2	0	0	CLOUDY	WET	REAR END	STRAIGHT & LEVEL	DAYLIGHT
70534673	US0025	9.649	09-Jan-08	1146	2	0	0	CLOUDY	DRY	REAR END	STRAIGHT & LEVEL	DAYLIGHT
70698289	US0025	9.66	26-Apr-09	1744	2	0	0	CLEAR	DRY	ANGLE	STRAIGHT & LEVEL	DAYLIGHT
70788285	US0025	9.681	04-Dec-09	1604	2	0	0	CLEAR	DRY	REAR END	STRAIGHT & LEVEL	DAYLIGHT
70698631	US0025	9.698	01-May-09	1511	2	0	0	RAINING	WET	ANGLE	STRAIGHT & LEVEL	DAYLIGHT
70550035	US0025	9.699	17-Mar-08	1606	2	0	0	CLEAR	DRY	ANGLE	STRAIGHT & LEVEL	DAYLIGHT
70649998	US0025	9.699	23-Dec-08	1545	2	0	1	RAINING	WET	REAR END	STRAIGHT & LEVEL	DAYLIGHT
70438163	US0025	9.7	19-Apr-07	2108	2	0	0	CLEAR	DRY	REAR END	STRAIGHT & GRADE	DARK-HWY NOT LIGHTED
70521240	US0025	9.725	21-Dec-07	1357	2	0	0	CLOUDY	DRY	REAR END	STRAIGHT & LEVEL	DAYLIGHT
70604988	US0025	9.761	05-Sep-08	1532	3	0	1	CLEAR	DRY	REAR END	STRAIGHT & LEVEL	DAYLIGHT
70544190	US0025	9.764	21-Feb-08	1120	2	0	0	CLOUDY	DRY	REAR END	STRAIGHT & LEVEL	DAYLIGHT
70734074	US0025	9.765	30-Jul-09	1528	3	0	0	RAINING	WET	REAR END	STRAIGHT & LEVEL	DAYLIGHT
70457063	US0025	9.8	22-May-07	1555	2	0	0	CLEAR	DRY	REAR END	STRAIGHT & GRADE	DAYLIGHT
70635845	US0025	9.807	07-Nov-08	1437	2	0	1	RAINING	WET	REAR END	STRAIGHT & LEVEL	DAYLIGHT
70695787	US0025	9.808	03-Apr-09	1741	2	0	0	CLOUDY	DRY	ANGLE	STRAIGHT & LEVEL	DAYLIGHT
70789494	US0025	9.814	07-Dec-09	1715	2	0	0	CLEAR	DRY	REAR END	STRAIGHT & LEVEL	DUSK
70456249	US0025	9.832	11-Jun-07	1242	2	0	0	CLEAR	DRY	SIDESWIPE-SAME DIRECTION	STRAIGHT & GRADE	DAYLIGHT
70570280	US0025	9.834	27-May-08	1110	2	0	0	CLOUDY	DRY	REAR END	STRAIGHT & LEVEL	DAYLIGHT
70798231	US0025	9.839	22-Dec-09	1404	2	0	0	CLEAR	DRY	REAR END	STRAIGHT & LEVEL	DAYLIGHT
70534681	US0025	9.841	08-Feb-08	1520	2	0	0	CLEAR	DRY	REAR END	STRAIGHT & LEVEL	DAYLIGHT
70470324	US0025	9.862	10-Aug-07	1443	3	0	0	CLEAR	DRY	REAR END	STRAIGHT & LEVEL	DAYLIGHT
70476481	US0025	9.899	12-Aug-07	2305	1	0	0	CLOUDY	DRY	SINGLE VEHICLE	STRAIGHT & LEVEL	DARK-HWY LIGHTED/OFF
70438164	US0025	9.9	24-Apr-07	1438	2	0	0	CLEAR	DRY	ANGLE	STRAIGHT & LEVEL	DAYLIGHT
70426220	US0025	9.908	13-Feb-07	0808	3	0	0	CLOUDY	WET	REAR END	STRAIGHT & LEVEL	DAWN
70569527	US0025	9.932	21-May-08	0800	2	0	0	CLEAR	DRY	REAR END	STRAIGHT & LEVEL	DAYLIGHT

70695740	US0025	10.365	18-Apr-09	1351	2	0	0 CLEAR	DRY	SIDESWIPE-SAME DIRECTION	STRAIGHT & LEVEL	DAYLIGHT
70550033	US0025	10.367	03-Mar-08	1216	2	0	0 CLEAR	DRY	REAR END	STRAIGHT & LEVEL	DAYLIGHT
70544719	US0025	10.373	10-Jan-08	1749	3	0	3 RAINING	WET	REAR END	STRAIGHT & LEVEL	DARK-HWY LIGHTED/ON
70695738	US0025	10.381	07-Apr-09	1328	2	0	0 CLOUDY	WET	REAR END	STRAIGHT & LEVEL	DAYLIGHT
70544180	US0025	10.384	07-Mar-08	1633	2	0	0 RAINING	WET	REAR END	STRAIGHT & LEVEL	DAYLIGHT
70521221	US0025	10.387	14-Dec-07	0816	2	0	0 CLOUDY	DRY	ANGLE	STRAIGHT & LEVEL	DAYLIGHT
70687328	US0025	10.39	01-Apr-09	1242	3	0	0 CLEAR	DRY	REAR END	STRAIGHT & LEVEL	DAYLIGHT
70695729	US0025	10.393	27-Apr-09	1449	2	0	0 CLEAR	DRY	REAR END	STRAIGHT & LEVEL	DAYLIGHT
70516265	US0025	10.394	19-Dec-07	1530	2	0	0 CLEAR	DRY	REAR END	STRAIGHT & LEVEL	DAYLIGHT
70534709	US0025	10.394	04-Feb-08	1358	3	0	2 CLOUDY	WET	ANGLE	STRAIGHT & LEVEL	DAYLIGHT
70426237	US0025	10.405	03-Mar-07	1802	2	0	0 CLEAR	DRY	SIDESWIPE-SAME DIRECTION	STRAIGHT & LEVEL	DAYLIGHT
70441115	US0025	10.405	23-May-07	1526	2	0	0 CLEAR	DRY	ANGLE	STRAIGHT & LEVEL	DAYLIGHT
70494769	US0025	10.405	20-Sep-07	1215	2	0	0 CLEAR	DRY	BACKING	STRAIGHT & LEVEL	DAYLIGHT
70433299	US0025	10.41	14-Apr-07	1350	2	0	0 RAINING	WET	SIDESWIPE-SAME DIRECTION	STRAIGHT & LEVEL	DAYLIGHT
70709883	US0025	10.412	29-May-09	1445	2	0	0 CLEAR	DRY	OPPOSING LEFT TURN	STRAIGHT & LEVEL	DAYLIGHT
70622810	US0025	10.416	23-Oct-08	1814	2	0	0 CLOUDY	DRY	REAR END	STRAIGHT & LEVEL	DAYLIGHT
70744436	US0025	10.422	26-Aug-09	0746	2	0	0 CLOUDY	DRY	ANGLE	STRAIGHT & LEVEL	DAYLIGHT
70442640	US0025	10.429	18-May-07	1615	3	0	2 CLEAR	DRY	ANGLE	STRAIGHT & LEVEL	DAYLIGHT
70695716	US0025	10.444	10-Apr-09	1834	2	0	0 RAINING	WET	ANGLE	STRAIGHT & LEVEL	DAYLIGHT
70698290	US0025	10.447	28-Apr-09	1845	2	0	0 CLOUDY	DRY	REAR END	STRAIGHT & LEVEL	DAYLIGHT
70409466	US0025	10.448	01-Feb-07	0608	2	0	0 CLOUDY	WET	REAR END	STRAIGHT & LEVEL	DARK-HWY LIGHTED/ON
70470344	US0025	10.448	06-Aug-07	1240	2	0	0 CLEAR	DRY	REAR END	STRAIGHT & LEVEL	DAYLIGHT
70321483	US0025	10.448	12-May-06	1730	2	0	0 CLEAR	DRY	REAR END	STRAIGHT & LEVEL	DAYLIGHT
70641728	US0025	10.452	01-Dec-08	1300	2	0	0 BLOWING	WET	BACKING	STRAIGHT & LEVEL	DAYLIGHT
70588324	US0025	10.46	03-Jul-08	1135	2	0	0 CLEAR	DRY	REAR END	STRAIGHT & LEVEL	DAYLIGHT
70695722	US0025	10.464	26-Mar-09	1100	2	0	0 RAINING	WET	REAR END	STRAIGHT & LEVEL	DAYLIGHT
70702444	US0025	10.465	11-May-09	1632	2	0	0 CLEAR	DRY	ANGLE	STRAIGHT & GRADE	DARK-HWY LIGHTED/OFF
70494902	US0025	10.467	11-Sep-07	1513	3	0	0 CLOUDY	DRY	ANGLE	STRAIGHT & LEVEL	DAYLIGHT
70442625	US0025	10.467	26-May-07	1254	2	0	0 CLOUDY	DRY	ANGLE	STRAIGHT & LEVEL	DAYLIGHT
70504340	US0025	10.471	18-Nov-07	1324	2	0	0 CLEAR	DRY	REAR END	STRAIGHT & LEVEL	DAYLIGHT
70635828	US0025	10.484	20-Nov-08	1748	2	0	0 CLOUDY	DRY	REAR END	STRAIGHT & LEVEL	DARK-HWY LIGHTED/ON
70470331	US0025	10.486	13-Aug-07	1529	2	0	0 CLEAR	DRY	ANGLE	STRAIGHT & LEVEL	DAYLIGHT
70752518	US0025	10.49	15-Sep-09	2017	3	0	0 CLEAR	DRY	REAR END	STRAIGHT & LEVEL	DARK-HWY LIGHTED/ON
70404553	US0025	10.491	03-Jan-07	1124	2	0	0 CLEAR	DRY	REAR END	STRAIGHT & LEVEL	DAYLIGHT
70470363	US0025	10.496	14-Aug-07	0915	2	0	0 CLEAR	DRY	SIDESWIPE-SAME DIRECTION	STRAIGHT & LEVEL	DAYLIGHT
70494911	US0025	10.497	24-Oct-07	0815	3	0	0 RAINING	WET	REAR END	STRAIGHT & LEVEL	DAYLIGHT
70516233	US0025	10.498	06-Nov-07	1120	2	0	0 CLEAR	DRY	REAR END	CURVE & LEVEL	DAYLIGHT
70426201	US0025	10.5	01-Apr-07	1255	2	0	0 CLEAR	DRY	REAR END	STRAIGHT & LEVEL	DAYLIGHT
70470345	US0025	10.5	07-Aug-07	1029	2	0	0 CLEAR	DRY	REAR END	CURVE & GRADE	DAYLIGHT
70509230	US0025	10.5	20-Nov-07	1508	2	0	2 CLEAR	DRY	REAR END	CURVE & LEVEL	DAYLIGHT
70396861	US0025	10.5	05-Jan-07	1500	3	0	1 CLOUDY	DRY	REAR END	CURVE & GRADE	DAYLIGHT
70452330	US0025	10.502	12-Jun-07	1521	2	0	0 CLEAR	DRY	REAR END	CURVE & LEVEL	DAYLIGHT
70660432	US0025	10.502	26-Jan-09	0845	2	0	0 CLOUDY	DRY	REAR END	CURVE & GRADE	DAYLIGHT
70409444	US0025	10.503	31-Jan-07	1244	2	0	0 CLEAR	DRY	SIDESWIPE-SAME DIRECTION	CURVE & GRADE	DAYLIGHT
70736370	US0025	10.504	02-Aug-09	2320	2	0	0 CLEAR	DRY	BACKING	STRAIGHT & LEVEL	DARK-HWY LIGHTED/ON
70588967	US0025	10.505	21-Jul-08	1221	2	0	0 CLEAR	DRY	REAR END	STRAIGHT & LEVEL	DAYLIGHT
70415776	US0025	10.505	26-Feb-07	1548	2	0	2 CLEAR	DRY	ANGLE	STRAIGHT & LEVEL	DAYLIGHT
70433552	US0025	10.505	16-Apr-07	1750	2	0	0 CLEAR	DRY	REAR END	CURVE & LEVEL	DAYLIGHT
70433300	US0025	10.505	14-Apr-07	1356	2	0	3 RAINING	WET	ANGLE	STRAIGHT & GRADE	DAYLIGHT
70409460	US0025	10.505	03-Feb-07	1425	3	0	5 CLEAR	DRY	ANGLE	STRAIGHT & LEVEL	DAYLIGHT
70588346	US0025	10.505	14-Jul-08	1503	2	0	0 CLEAR	DRY	REAR END	STRAIGHT & LEVEL	DAYLIGHT
70775997	US0025	10.505	04-Nov-09	1142	2	0	0 CLEAR	DRY	REAR END	STRAIGHT & LEVEL	DAYLIGHT
70516244	US0025	10.505	29-Nov-07	1654	2	0	0 CLOUDY	DRY	REAR END	CURVE & LEVEL	DAYLIGHT
70743613	US0025	10.505	25-Aug-09	2033	2	0	0 CLEAR	DRY	REAR END	CURVE & LEVEL	DARK-HWY LIGHTED/ON
70470342	US0025	10.505	17-Aug-07	1624	3	0	0 CLEAR	DRY	REAR END	STRAIGHT & LEVEL	DAYLIGHT
70500165	US0025	10.505	12-Nov-07	1518	3	0	0 CLOUDY	DRY	REAR END	STRAIGHT & LEVEL	DAYLIGHT
70649999	US0025	10.505	24-Dec-08	1842	2	0	0 RAINING	WET	REAR END	CURVE & LEVEL	DARK-HWY LIGHTED/ON
70534685	US0025	10.505	15-Feb-08	1313	2	0	0 CLOUDY	DRY	REAR END	STRAIGHT & LEVEL	DAYLIGHT
70534700	US0025	10.505	09-Jan-08	1009	2	0	0 CLEAR	WET	REAR END	CURVE & LEVEL	DAYLIGHT
70780276	US0025	10.505	13-Nov-09	1553	2	0	1 CLOUDY	DRY	ANGLE	STRAIGHT & LEVEL	DAYLIGHT
70409445	US0025	10.506	01-Feb-07	0815	2	0	0 CLOUDY	DRY	REAR END	CURVE & GRADE	DAYLIGHT
70509228	US0025	10.506	26-Nov-07	1706	2	0	0 RAINING	WET	REAR END	STRAIGHT & LEVEL	DUSK
70426276	US0025	10.506	19-Mar-07	2204	2	0	1 RAINING	WET	ANGLE	STRAIGHT & LEVEL	DARK-HWY NOT LIGHTED
70752523	US0025	10.508	16-Sep-09	0637	2	0	0 CLEAR	DRY	ANGLE	STRAIGHT & LEVEL	DARK-HWY LIGHTED/ON
70409451	US0025	10.509	11-Feb-07	1705	2	0	1 CLEAR	DRY	REAR END	STRAIGHT & LEVEL	DAYLIGHT
70705247	US0025	10.511	20-May-09	1515	2	0	0 CLEAR	DRY	REAR END	CURVE & HILLCREST	DAYLIGHT
70544713	US0025	10.515	01-Feb-08	1433	2	0	0 CLOUDY	DRY	REAR END	CURVE & GRADE	DAYLIGHT
70706536	US0025	10.515	15-May-09	1205	2	0	0 CLEAR	DRY	REAR END	CURVE & LEVEL	DAYLIGHT
70784760	US0025	10.515	24-Nov-09	1517	2	0	0 CLOUDY	DRY	REAR END	CURVE & GRADE	DAYLIGHT
70650010	US0025	10.515	26-Dec-08	1250	2	0	0 CLOUDY	WET	REAR END	CURVE & GRADE	DAYLIGHT
70561977	US0025	10.515	27-Apr-08	2301	2	0	0 CLOUDY	WET	SIDESWIPE-SAME DIRECTION	CURVE & LEVEL	DARK-HWY LIGHTED/ON
70649973	US0025	10.515	19-Dec-08	1241	2	0	0 RAINING	WET	REAR END	CURVE & GRADE	DAYLIGHT
70521229	US0025	10.516	04-Dec-07	1614	2	0	0 CLOUDY	DRY	REAR END	CURVE & HILLCREST	DAYLIGHT
70784767	US0025	10.516	28-Nov-09	1103	2	0	0 CLEAR	DRY	REAR END	CURVE & GRADE	DAYLIGHT
70650007	US0025	10.517	27-Dec-08	1446	2	0	0 CLEAR	DRY	REAR END	CURVE & GRADE	DAYLIGHT
70769665	US0025	10.518	19-Oct-09	1217	2	0	0 CLEAR	DRY	REAR END	CURVE & GRADE	DAYLIGHT
70769679	US0025	10.519	15-Oct-09	1836	2	0	0 RAINING	WET	REAR END	CURVE & GRADE	DUSK
70534729	US0025	10.519	02-Feb-08	1357	2	0	0 CLEAR	DRY	REAR END	CURVE & GRADE	DAYLIGHT
70687317	US0025	10.521	24-Mar-09	1700	2	0	0 CLEAR	DRY	REAR END	CURVE & GRADE	DAYLIGHT

70462833	US0025	12	25-Jul-07	1255	3	0	0	CLOUDY	DRY	REAR END	STRAIGHT & LEVEL	DAYLIGHT
70784753	US0025	12.005	24-Nov-09	1619	2	0	0	CLEAR	DRY	REAR END	STRAIGHT & LEVEL	DAYLIGHT
70724525	US0025	12.015	09-Jun-09	1239	2	0	0	CLEAR	DRY	REAR END	STRAIGHT & LEVEL	DAYLIGHT
70494760	US0025	12.019	09-Oct-07	1134	2	0	0	RAINING	WET	REAR END	STRAIGHT & LEVEL	DAYLIGHT
70721595	US0025	12.02	22-Jun-09	1533	2	0	0	CLOUDY	DRY	ANGLE	STRAIGHT & LEVEL	DAYLIGHT
70470357	US0025	12.024	02-Aug-07	1222	2	0	0	CLEAR	DRY	SIDESWIPE-SAME DIRECTION	STRAIGHT & LEVEL	DAYLIGHT
70726346	US0025	12.044	03-Jul-09	1509	3	0	1	CLEAR	DRY	REAR END	STRAIGHT & LEVEL	DAYLIGHT
70622753	US0025	12.05	07-Oct-08	1430	2	0	0	CLEAR	DRY	REAR END	STRAIGHT & LEVEL	DAYLIGHT
70556366	US0025	12.051	16-Apr-08	0940	2	0	0	CLEAR	DRY	BACKING	STRAIGHT & LEVEL	DAYLIGHT
70409462	US0025	12.061	06-Feb-07	1254	2	0	0	CLEAR	DRY	ANGLE	STRAIGHT & LEVEL	DAYLIGHT
70675304	US0025	12.061	16-Jan-09	1513	2	0	0	CLOUDY	DRY	REAR END	STRAIGHT & LEVEL	DAYLIGHT
70650013	US0025	12.061	09-Dec-08	1430	2	0	0	CLOUDY	DRY	OPPOSING LEFT TURN	STRAIGHT & LEVEL	DAYLIGHT
70550021	US0025	12.061	19-Mar-08	1548	2	0	0	CLOUDY	DRY	REAR END	STRAIGHT & LEVEL	DAYLIGHT
70426178	US0025	12.063	15-Feb-07	1205	2	0	0	CLEAR	DRY	REAR END	STRAIGHT & LEVEL	DAYLIGHT
70426194	US0025	12.1	15-Feb-07	1300	2	0	0	CLEAR	DRY	REAR END	STRAIGHT & LEVEL	DAYLIGHT
70470325	US0025	12.114	11-Aug-07	1429	3	0	0	CLEAR	DRY	REAR END	STRAIGHT & LEVEL	DAYLIGHT
70516257	US0025	12.117	28-Nov-07	1558	2	0	0	CLEAR	DRY	REAR END	STRAIGHT & LEVEL	DAYLIGHT
70600518	US0025	12.119	25-Aug-08	1957	2	0	0	RAINING	WET	ANGLE	STRAIGHT & LEVEL	DUSK
70675951	US0025	12.119	23-Jan-09	0655	2	0	0	CLEAR	DRY	OPPOSING LEFT TURN	STRAIGHT & LEVEL	DAYLIGHT
70698628	US0025	12.119	28-Apr-09	0835	2	0	1	CLEAR	DRY	SINGLE VEHICLE	STRAIGHT & GRADE	DAYLIGHT
70521217	US0025	12.119	26-Dec-07	1133	2	0	0	CLEAR	DRY	SIDESWIPE-SAME DIRECTION	STRAIGHT & LEVEL	DAYLIGHT
70588335	US0025	12.12	10-Jul-08	2142	2	0	0	CLEAR	DRY	HEAD ON	STRAIGHT & LEVEL	DARK-HWY LIGHTED/ON
70544321	US0025	12.125	12-Mar-08	0701	2	0	0	CLEAR	DRY	ANGLE	STRAIGHT & LEVEL	DARK-HWY LIGHTED/ON
70521233	US0025	12.127	03-Dec-07	1415	2	0	0	CLEAR	DRY	SIDESWIPE-SAME DIRECTION	STRAIGHT & LEVEL	DAYLIGHT
70747303	US0025	12.129	03-Sep-09	1500	2	0	0	CLOUDY	DRY	BACKING	STRAIGHT & LEVEL	DAYLIGHT
70494782	US0025	12.159	10-Oct-07	1715	2	0	0	CLOUDY	DRY	REAR END	STRAIGHT & GRADE	DAYLIGHT
70739826	US0025	12.161	14-Aug-09	1050	3	0	0	CLEAR	DRY	ANGLE	STRAIGHT & LEVEL	DAYLIGHT
70534679	US0025	12.163	04-Feb-08	0948	2	0	1	CLOUDY	DRY	SINGLE VEHICLE	STRAIGHT & LEVEL	DAYLIGHT
70534726	US0025	12.163	10-Feb-08	1634	2	0	0	CLEAR	DRY	ANGLE	STRAIGHT & LEVEL	DAYLIGHT
70665964	US0025	12.163	06-Jan-09	1734	2	0	0	RAINING	WET	ANGLE	STRAIGHT & LEVEL	DARK-HWY LIGHTED/ON
70756547	US0025	12.163	23-Sep-09	1808	2	0	0	CLOUDY	DRY	ANGLE	STRAIGHT & GRADE	DAYLIGHT
70425365	US0025	12.163	16-Mar-07	1348	1	1	0	CLOUDY	DRY	SINGLE VEHICLE	STRAIGHT & LEVEL	DAYLIGHT

MASTER FILE NUMBER	ROADWAY NUMBER	MILEPOINT DERIVED	COLLISION DATE	COLLISION TIME	UNITS INVOLVED	KILLED	INJURED	WEATHER	ROADWAY CONDITION	MANNER OF COLLISION	ROADWAY CHARACTER	LIGHT CONDITION
70494805	KY0229	10.94	28-Aug-07	1300	2	0	1	CLEAR	DRY	ANGLE	STRAIGHT & LEVEL	DAYLIGHT
70494812	KY0229	11.091	06-Sep-07	1709	2	0	0	CLEAR	DRY	SIDESWIPE-SAME	STRAIGHT & LEVEL	DAYLIGHT
70665973	KY0229	11.14	09-Jan-09	0742	2	0	0	CLEAR	ICE	ANGLE	STRAIGHT & LEVEL	DAYLIGHT
70649985	KY0229	11.173	10-Dec-08	2122	2	0	5	RAINING	WET	ANGLE	STRAIGHT & LEVEL	DARK-HWY LIGHTED/OFF
70456248	KY0229	11.178	09-Jun-07	1256	2	0	0	CLEAR	DRY	REAR END	STRAIGHT & GRADE	DAYLIGHT
70516140	KY0229	11.186	05-Dec-07	1435	1	0	0	RAINING	WET	SINGLE VEHICLE	STRAIGHT & LEVEL	DAYLIGHT
70494816	KY0229	11.187	25-Aug-07	1058	3	0	0	CLEAR	DRY	ANGLE	STRAIGHT & LEVEL	DAYLIGHT
70494868	KY0229	11.187	17-Sep-07	1824	2	0	0	CLEAR	DRY	ANGLE	STRAIGHT & LEVEL	DAYLIGHT
70695793	KY0229	11.187	23-Mar-09	1807	2	0	0	CLOUDY	DRY	REAR END	STRAIGHT & LEVEL	DAYLIGHT
70433310	KY0229	11.187	29-Apr-07	1705	2	0	0	CLEAR	DRY	ANGLE	STRAIGHT & LEVEL	DAYLIGHT
70426275	KY0229	11.191	17-Mar-07	1659	2	0	2	CLEAR	DRY	ANGLE	STRAIGHT & LEVEL	DAYLIGHT
70404537	KY0229	11.192	03-Jan-07	1706	2	0	0	CLEAR	DRY	ANGLE	STRAIGHT & LEVEL	DAYLIGHT
70521222	KY0229	11.193	17-Dec-07	0801	3	0	1	CLOUDY	DRY	ANGLE	STRAIGHT & LEVEL	DAYLIGHT
70724534	KY0229	11.193	19-Jun-09	2311	2	0	1	CLEAR	DRY	ANGLE	STRAIGHT & LEVEL	DARK-HWY NOT LIGHTED
70500154	KY0229	11.218	14-Nov-07	1759	2	0	0	RAINING	WET	ANGLE	STRAIGHT & LEVEL	DARK-HWY LIGHTED/ON
70571000	KY0229	11.294	03-May-08	1215	2	0	0	RAINING	WET	REAR END	STRAIGHT & LEVEL	DAYLIGHT
70675284	KY0229	11.313	13-Feb-09	1017	2	0	0	CLOUDY	DRY	REAR END	STRAIGHT & LEVEL	DAYLIGHT
70649996	KY0229	11.349	22-Dec-08	1450	2	0	0	CLEAR	DRY	BACKING	CURVE & LEVEL	DAYLIGHT
70442622	KY0229	11.397	22-May-07	1625	2	0	3	CLEAR	DRY	REAR END	STRAIGHT & LEVEL	DAYLIGHT
70752519	KY0229	11.491	16-Sep-09	1533	2	0	0	CLOUDY	DRY	BACKING	STRAIGHT & LEVEL	DAYLIGHT
70462929	KY0229	11.513	23-Jun-07	1240	2	0	0	CLEAR	DRY	REAR END	CURVE & GRADE	DAYLIGHT
70516261	KY0229	11.518	09-Dec-07	1547	2	0	0	RAINING	WET	REAR END	CURVE & HILLCREST	DAYLIGHT
70676062	KY0229	11.518	02-Mar-09	0640	2	0	0	CLOUDY	DRY	REAR END	STRAIGHT & LEVEL	DAWN
70571016	KY0229	11.519	29-May-08	0940	2	0	0	CLEAR	DRY	REAR END	CURVE & LEVEL	DAYLIGHT
70665957	KY0229	11.52	23-Jan-09	1940	2	0	0	CLOUDY	DRY	REAR END	CURVE & LEVEL	DAYLIGHT
70622799	KY0229	11.52	10-Sep-08	0752	2	0	0	CLOUDY	DRY	REAR END	STRAIGHT & GRADE	DAYLIGHT
70588319	KY0229	11.521	18-Jul-08	1635	2	0	0	CLEAR	DRY	REAR END	CURVE & LEVEL	DAYLIGHT
70635841	KY0229	11.521	16-Nov-08	1102	2	0	0	CLOUDY	WET	ANGLE	STRAIGHT & GRADE	DAYLIGHT
70598058	KY0229	11.522	27-Jul-08	1737	2	0	0	CLEAR	DRY	REAR END	STRAIGHT & LEVEL	DAYLIGHT
70752503	KY0229	11.532	10-Sep-09	1906	2	0	0	RAINING	WET	ANGLE	STRAIGHT & GRADE	DAYLIGHT
70579265	KY0229	11.534	15-Jun-08	1839	2	0	0	CLEAR	DRY	REAR END	STRAIGHT & LEVEL	DAYLIGHT
70675306	KY0229	11.539	01-Jan-09	0452	2	0	2	CLEAR	DRY	ANGLE	STRAIGHT & LEVEL	DARK-HWY LIGHTED/OFF
70788374	KY0229	11.539	05-Dec-09	1745	2	0	0	CLOUDY	WET	REAR END	STRAIGHT & LEVEL	DUSK
70516222	KY0229	11.549	13-Dec-07	1524	2	0	0	CLOUDY	WET	REAR END	STRAIGHT & LEVEL	DAYLIGHT
70724552	KY0229	11.614	04-Jul-09	2226	3	0	0	RAINING	WET	REAR END	STRAIGHT & GRADE	DARK-HWY NOT LIGHTED
70414966	KY0229	11.722	02-Mar-07	0645	2	0	0	CLEAR	DRY	SIDESWIPE-OPPOSITE	STRAIGHT & GRADE	DAWN
70743605	KY0229	11.951	24-Aug-09	1251	2	0	0	CLEAR	DRY	REAR END	STRAIGHT & LEVEL	DAYLIGHT
70481455	KY0229	12.053	06-Sep-07	0851	2	0	2	CLEAR	DRY	SIDESWIPE-OPPOSITE	STRAIGHT & LEVEL	DAYLIGHT
70509233	KY0229	12.093	23-Nov-07	1913	1	0	0	CLEAR	DRY	SINGLE VEHICLE	STRAIGHT & GRADE	DARK-HWY LIGHTED/ON
70641727	KY0229	12.204	28-Nov-08	1320	2	0	0	CLEAR	DRY	REAR END	STRAIGHT & GRADE	DAYLIGHT
70588334	KY0229	12.208	28-Jun-08	1457	2	0	0	CLEAR	DRY	REAR END	STRAIGHT & LEVEL	DAYLIGHT

Accident Calculations for Segments

ROADWAY	US-25 & KY-229
COUNTY	Laurel
PERIOD	1/1/2007-12/31/2009

The procedure used below is from The Kentucky Transportation Center, University of Kentucky, College of Engineering, Research Report KTC-06-29/KSP2--06-1F titled "Analysis of Traffic Crash Data in Kentucky (2002-2006).

Last updated for 2007-2009

$$HMVM = \text{Hundred Million Vehicle Miles} = \frac{\text{Segment Length in miles} \times \text{AADT} \times (\text{No. of Years (usually = 3)}) \times (365 \text{ days/yr.})}{(10^8)}$$

Functional Class Rate (See table Below) - from Report KTC-00-17, "Analysis of Traffic Crash Data in Kentucky (2003-2007).

$$RC = \text{Critical Accident Rate} = (\text{Functional Class Rate}) + (K) \left(\frac{\text{Functional Class Rate}}{HMVM} \right)^{0.5} + \left(\frac{1}{2 \times HMVM} \right)$$

$$\text{Total Accident Rate} = \frac{\text{Total Number of Accidents}}{HMVM}$$

$$\text{Critical Rate Factor} = \frac{\text{Total Accident Rate}}{RC}$$

INPUT

Number of Years = 3

K = 2.576

Functional Class Rates are for 2007 thru 2009

Highway Type	Rural Acc. Rates	Urban Acc. Rates
One-Lane	235	
Two-Lane	210	311
Three-Lane	139	444
Four-Lane Divided	99	275
Four-Lane Undivided	206	485
Interstate	51	97
Parkway	61	100
All	144	289

Functional Class Rates are for 2005 thru 2009

Highway Type	Rural Acc. Rates	Urban Acc. Rates
One-Lane	247	
Two-Lane	213	294
Three-Lane	122	455
Four-Lane Divided	103	275
Four-Lane Undivided	226	473
Interstate	51	97
Parkway	60	105
All	146	259

Check KTC Website Report - Bookmarked, Table A-1.

INPUT								OUTPUT				
Roadway	Route	County	Begin Milepoint	End Milepoint	AADT	Functional Class Rate	Total No. Accidents	Segment Length (miles)	HMVM	Critical Accident Rate	Total Accident Rate	Critical Rate Factor
US 25	*	Laurel	9.028	10.505	25,300	311	215	1.477	0.41	383.2	525.4	1.371
	*		10.505	10.972	11,400	311	43	0.467	0.06	507.7	737.6	1.453
			10.972	11.255	11,600	311	17	0.283	0.04	564.5	472.9	0.838
			11.255	12.163	14,200	311	70	0.908	0.14	435.4	495.8	1.139
KY 229		Laurel	10.888	11.447	9,510	311	19	0.559	0.06	507.9	326.4	0.643
	**		11.447	11.522	9,510	311	10	0.075	0.01	889.1	1280.4	1.440
	**		11.522	11.600	5,260	311	6	0.078	0.00	1100.1	1335.5	1.214
			11.600	12.211	5,260	311	7	0.611	0.04	567.4	198.9	0.351

* Note: High CRF at segment on either side of US-25 and KY-192 (Bypass) Intersection.

** Note: High CRF at segment on either side of KY-229 and KY-192 (Bypass) Intersection.

Crash Calculations for 0.3 mile Spots

County:	Laurel
Route:	US-25 & KY-229
Period:	1/1/2007 - 12/31/2009

The procedure used below is from The Kentucky Transportation Center, University of Kentucky, College of Engineering, Research Report KTC-06-29/KSP2--06-1F titled "Analysis of Traffic Crash Data in Kentucky (2002-2006).

$$MV = \text{Million Vehicles} = \frac{(AADT) * (\text{No. of Years}) * (365 \text{ days/yr.})}{(10^6)}$$

Functional Class Rate (See table Below)

$$RC = \text{Critical Accident Rate} = (\text{Functional Class Rate}) + K * \sqrt{\frac{(\text{Functional Class Rate})}{(MV)}} + 1/(2 * (MV))$$

$$\text{Total Accident Rate} = \frac{\text{Total Number of Accidents}}{MVM}$$

$$\text{Critical Rate Factor} = \frac{\text{Total Accident Rate}}{RC}$$

INPUT

Number of Years = 3

K = 2.576

Functional Class Rates are for 2007 thru 2009

Highway Type	Rural Acc. Rates	Urban Acc. Rates
One-Lane	0.70	
Two-Lane	0.63	0.93
Three-Lane	0.42	1.33
Four-Lane Divided	0.30	0.82
Four-Lane Undivided	0.62	1.45
Interstate	0.15	0.29
Parkway	0.18	0.30
All	0.43	0.81

Note: Crash rates are in terms of crashes per million vehicles.

INPUT							OUTPUT			
Route	County	Begin Milepoint	End Milepoint	AADT*	Functional Class Rate*	Total No. Accidents	MV	RC	Total Acc. Rate	Critical Rate Factor
US-25	Laurel	10.000	10.300	25300	0.93	62	27.70	1.42	2.2	1.58
US-25	Laurel	11.100	11.400	14,200	0.93	22	15.55	1.59	1.4	0.89
KY-229	Laurel	11.147	11.447	9,510	0.93	16	10.41	1.75	1.5	0.88
		11.522	11.822	5,260	0.93	8	5.76	2.05	1.4	0.68
		11.911	12.211	5,260	0.93	5	5.76	2.05	0.9	0.42

*Input may be based on weighted averages of smaller segments within length of analyzed segment.

Crash Calculations for 0.1 mile Spots

County:	Laurel
Route:	US-25 & KY-229
Period:	1/1/2007 - 12/31/2009

The procedure used below is from The Kentucky Transportation Center, University of Kentucky, College of Engineering, Research Report KTC-06-29/KSP2--06-1F titled "Analysis of Traffic Crash Data in Kentucky (2002-2006). Last updated for 2007-2009

$$MV = \text{Million Vehicles} = \frac{(\text{AADT}) * (\text{No. of Years}) * (365 \text{ days/yr.})}{(10^6)}$$

Functional Class Rate (See table Below)

$$RC = \text{Critical Accident Rate} = (\text{Functional Class Rate}) + K * \sqrt{(\text{Functional Class Rate}) / (MV)} + 1 / (2 * (MV))$$

$$\text{Total Accident Rate} = \frac{\text{Total Number of Accidents}}{MVM}$$

$$\text{Critical Rate Factor} = \frac{\text{Total Accident Rate}}{RC}$$

INPUT

Number of Years = 3

K = 2.576

Functional Class Rates are for 2007 thru 2009

Highway Type	Rural Acc. Rates	Urban Acc. Rates
One-Lane	0.23	
Two-Lane	0.21	0.31
Three-Lane	0.14	0.44
Four-Lane Divided	0.10	0.27
Four-Lane Undivided	0.21	0.48
Interstate	0.05	0.10
Parkway	0.06	0.10
All	0.14	0.27

INPUT							OUTPUT			
County	Route	Begin Milepoint	End Milepoint	AADT*	Functional Class Rate*	Total No. Accidents	MV	RC	Total Acc. Rate	Critical Rate Factor
Laurel	US 25	10.08	10.18	25300	0.31	34	27.70	0.60	1.2	2.04
Laurel	US 25	11.2	11.3	14,200	0.31	12	15.55	0.71	0.8	1.09
Laurel	KY 229	11.14	11.24	9,510	0.31	13	10.41	0.80	1.2	1.56
		11.422	11.522	9,510	0.31	9	10.41	0.80	0.9	1.08
		11.522	11.622	5,260	0.31	7	5.76	0.99	1.2	1.22
		12.108	12.208	5,260	0.31	2	5.76	0.99	0.3	0.35

APPENDIX E


INDEX OF SHEETS	
SHEET NO.	DESCRIPTION
1	LAYOUT SHEET
2	TYPICAL SECTIONS - SUMMARY OF QUANTITIES
3 & 3A	STANDARD DRAWING SHEETS

**COMMONWEALTH OF KENTUCKY
DEPARTMENT OF HIGHWAYS**

CRAFT	DATE	SECTION	SCALE	DATE	SCALE
LAUREL	144	A-5	1938	1	1

**PLAN AND PROFILE OF PROPOSED
STATE HIGHWAY**

**LAUREL COUNTY
S.P. 144 A-S**
SCALES
PLAN 1 INCH = 100 FEET
PROFILE VIEW 1 INCH = 10 FEET
CROSS SECTION 1 INCH = 5 FEET

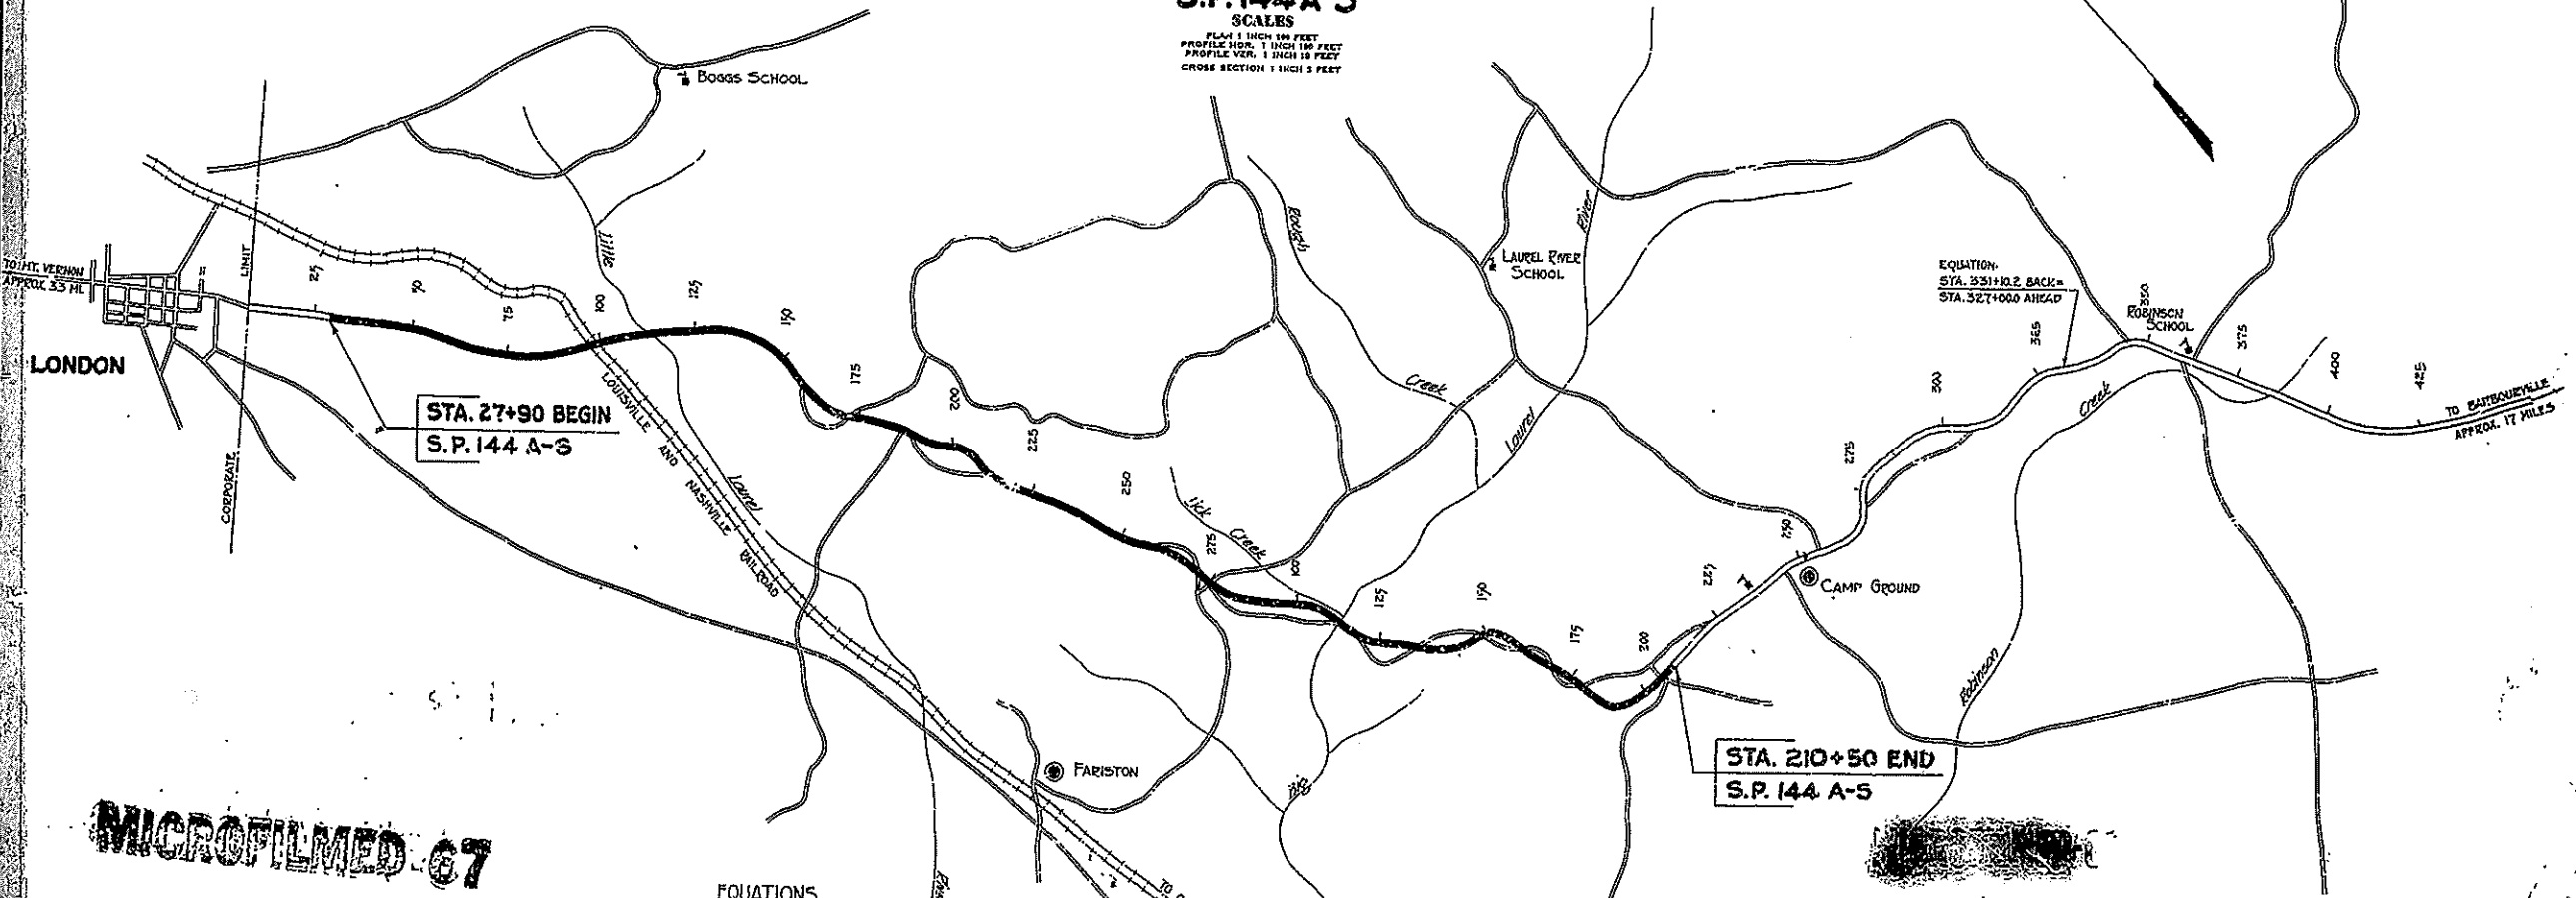

MICROFILMED 67

EQUATIONS			
STA. BACK	STA. AHEAD	PLUS	MINUS
34+04.0	34+00.0	4.0	
276+03.0	277+00.0		97.0
281+06.4	83+87.0	20297.4	
151+63.8	153+00.0		136.2
TOTAL		20301.4	233.2
DIFFERENCE		20278.0	

CONVENTIONAL SIGNS	
COUNTY LINE	
CORPORATE LIMITS	
SURVEY LINE	
PROPOSED RIGHT OF WAY	
GRADE LINE	
ROAD LINE	
TRAVELER'S WAY	
RAILROAD	
FENCE (EXCEPT STONE CHECKED)	
STONE FENCE	
BRIDGE	
TRUCK STOP	
PIPE CULVERT	
CONCRETE CULVERT & BRIDGE	
LARGE STREAM	
SMALL STREAM	
ROAD CROSSING	
RAILROAD CROSSING	
BUILDINGS	
UNIMPROVED ROAD	
GRADED SANDY ROAD	
IMPROVED ROAD	

LAYOUT MAP
SCALE 1 INCH = 2000 FEET
GRID LENGTH 88,500.0 LIN. FT. 7301.0 MILES
FOR EQUATIONS 20278.0 LIN. FT.
KEY LENGTH 33,200.0 LIN. FT. 7234.0 MILES
NOT INCLUDED
RAILROAD CROSSINGS 75.2 LIN. FT.
BRIDGES 367.0 LIN. FT.

**KENTUCKY
DEPARTMENT OF HIGHWAYS
COUNTY OF
LAUREL
LONDON - BARBOURVILLE
ROAD**

STATE PROJECT No. 144 SECTION A-S DATE 1938

SURVEYED BY H. B. BEUCHAMP DISTRICT ENGINEER
PLANS CHECKED BY H. J. [Signature] DISTRICT ENGINEER
SURVEY AND PLANS APPROVED BY [Signature] DISTRICT ENGINEER
SURVEY AND PLANS APPROVED BY [Signature] DISTRICT ENGINEER
SURVEY AND PLANS APPROVED BY [Signature] DISTRICT ENGINEER

SP 144 A-3


INDEX OF SHEETS	
1	LAYOUT SHEET
2	TYPICAL SECTIONS—SUMMARY OF QUANTITIES
3	STANDARD DRAWINGS SHEETS
4	PLANS AND PROFILES SHEETS
5	PROVISIONS SHEETS
6	CROSS SECTION SHEETS
7	BRIDGE SHEETS

COMMONWEALTH OF KENTUCKY
STATE HIGHWAY DEPARTMENT

PLAN AND PROFILE OF PROPOSED
STATE HIGHWAY

LAUREL COUNTY
STATE PROJECT No. 144 SEC. A-G


SCALES
PLAN 1" = 100' FEET
PROFILES 1" = 10' FEET
VERTICAL 1" = 10' FEET
HORIZONTAL 1" = 100' FEET
CROSS SECTION 1" = 1' FEET

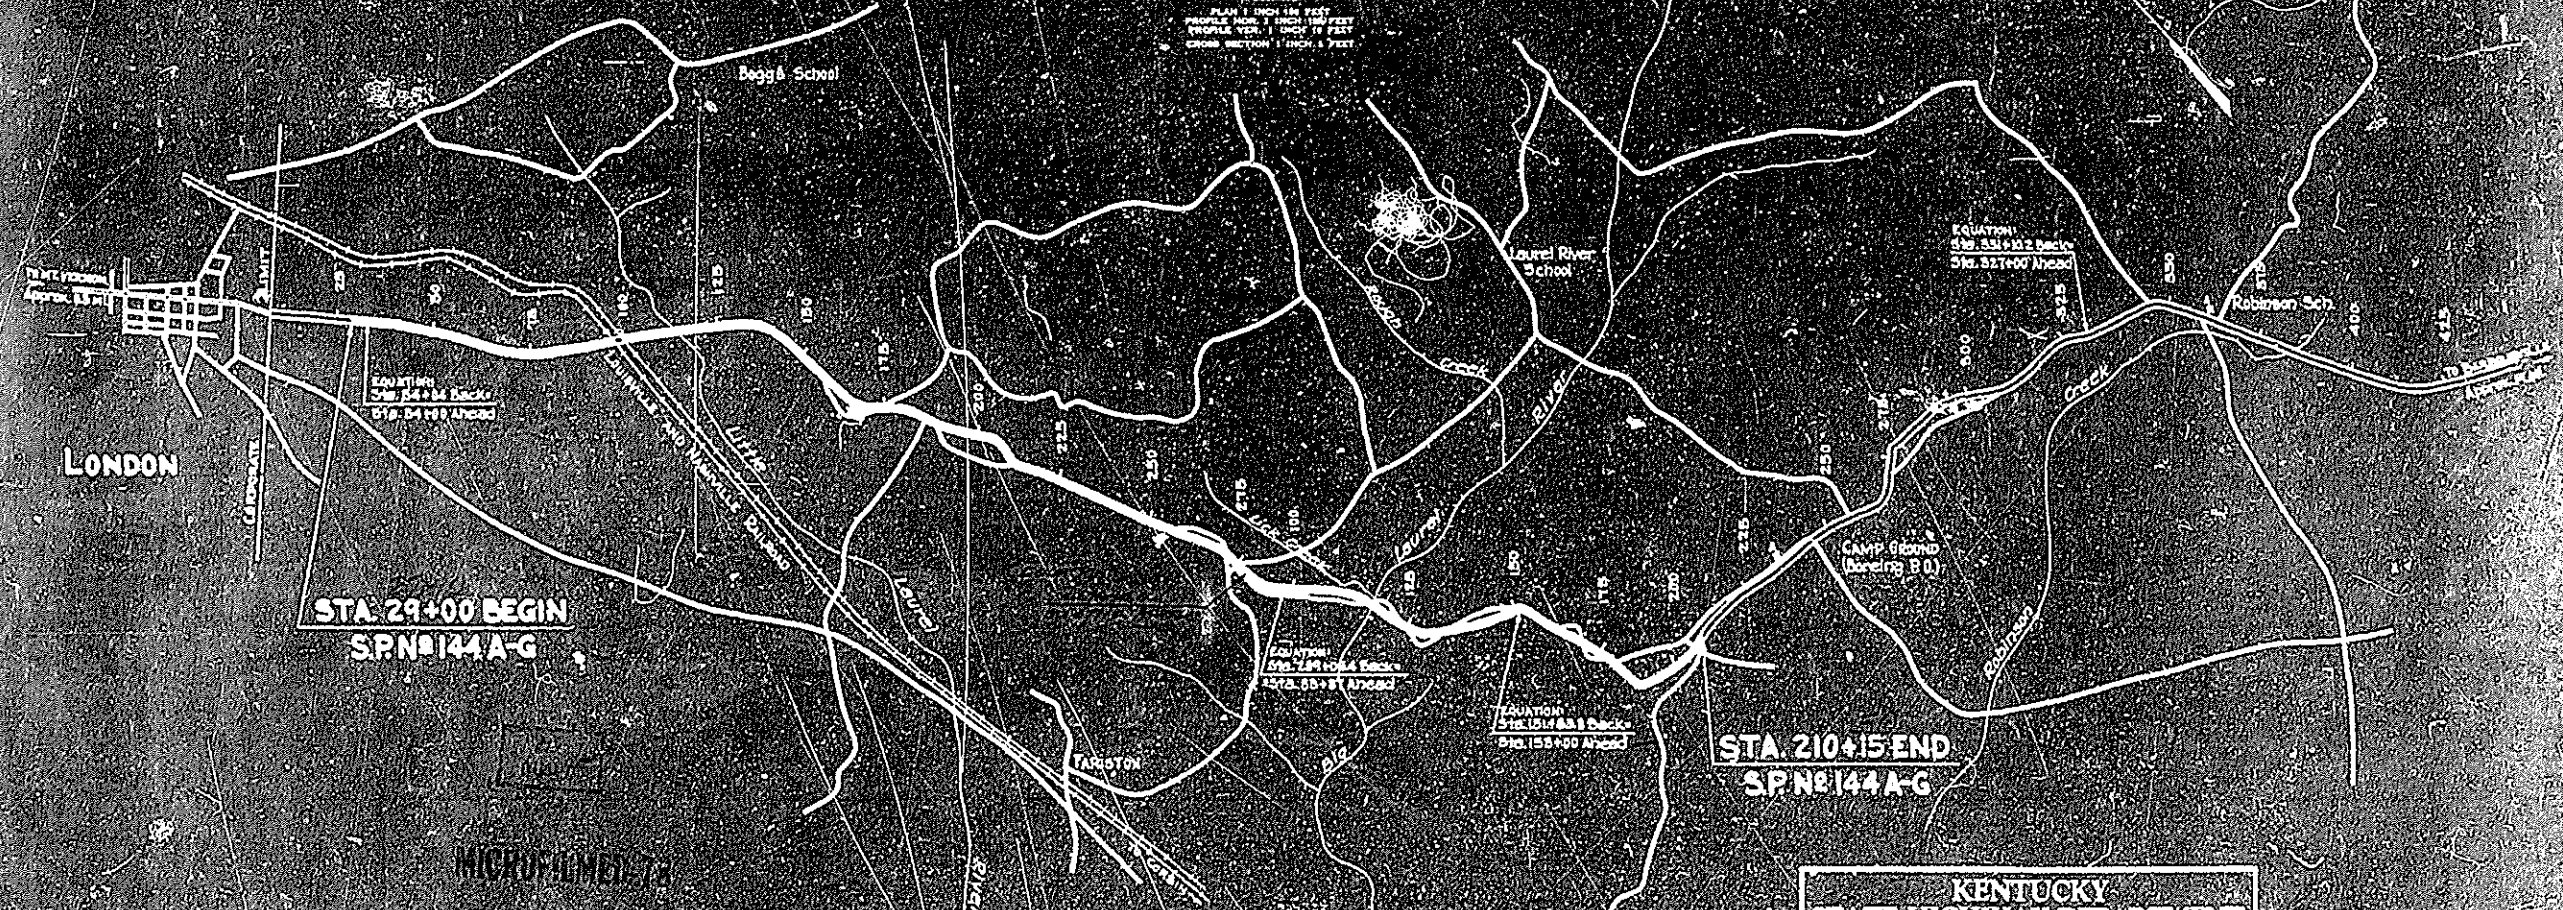

CONVENTIONAL SIGNS	
Warning Signs	[Sign symbols]
Regulatory Signs	[Sign symbols]
Informational Signs	[Sign symbols]
Construction Signs	[Sign symbols]
Other Signs	[Sign symbols]


LAYOUT MAP

KENTUCKY STATE HIGHWAY DEPARTMENT		
COUNTY OF LAUREL		
LONDON - BARBOURVILLE ROAD		
STATE PROJECT No. 144	SECTION A-G	DATE 1934
DESIGNED BY <i>[Signature]</i>	CHECKED BY <i>[Signature]</i>	APPROVED BY <i>[Signature]</i>
[Blank lines for notes]		

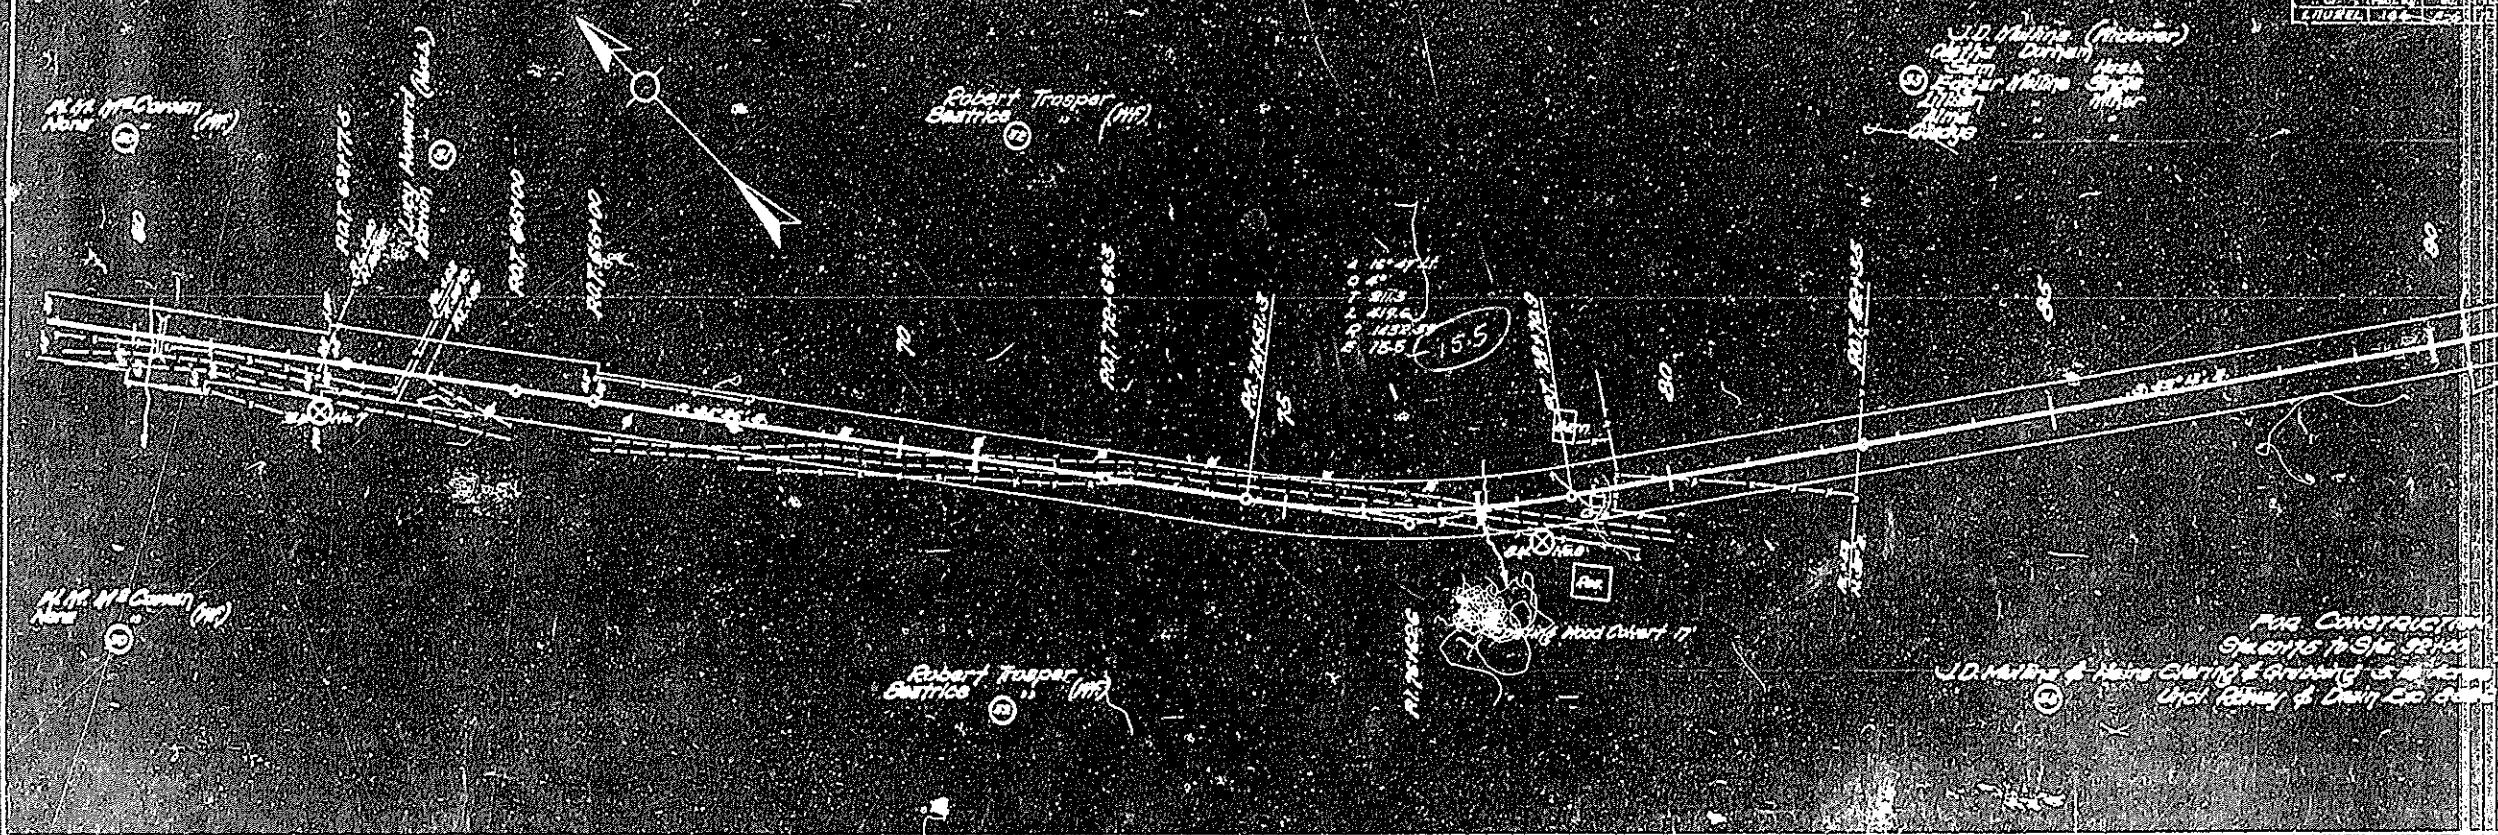

Lot No.	Area	Volume	Date	Owner
107-25-16-10	100	100	100	100
107-25-16-11	100	100	100	100
107-25-16-12	100	100	100	100
107-25-16-100	100	100	100	100

6

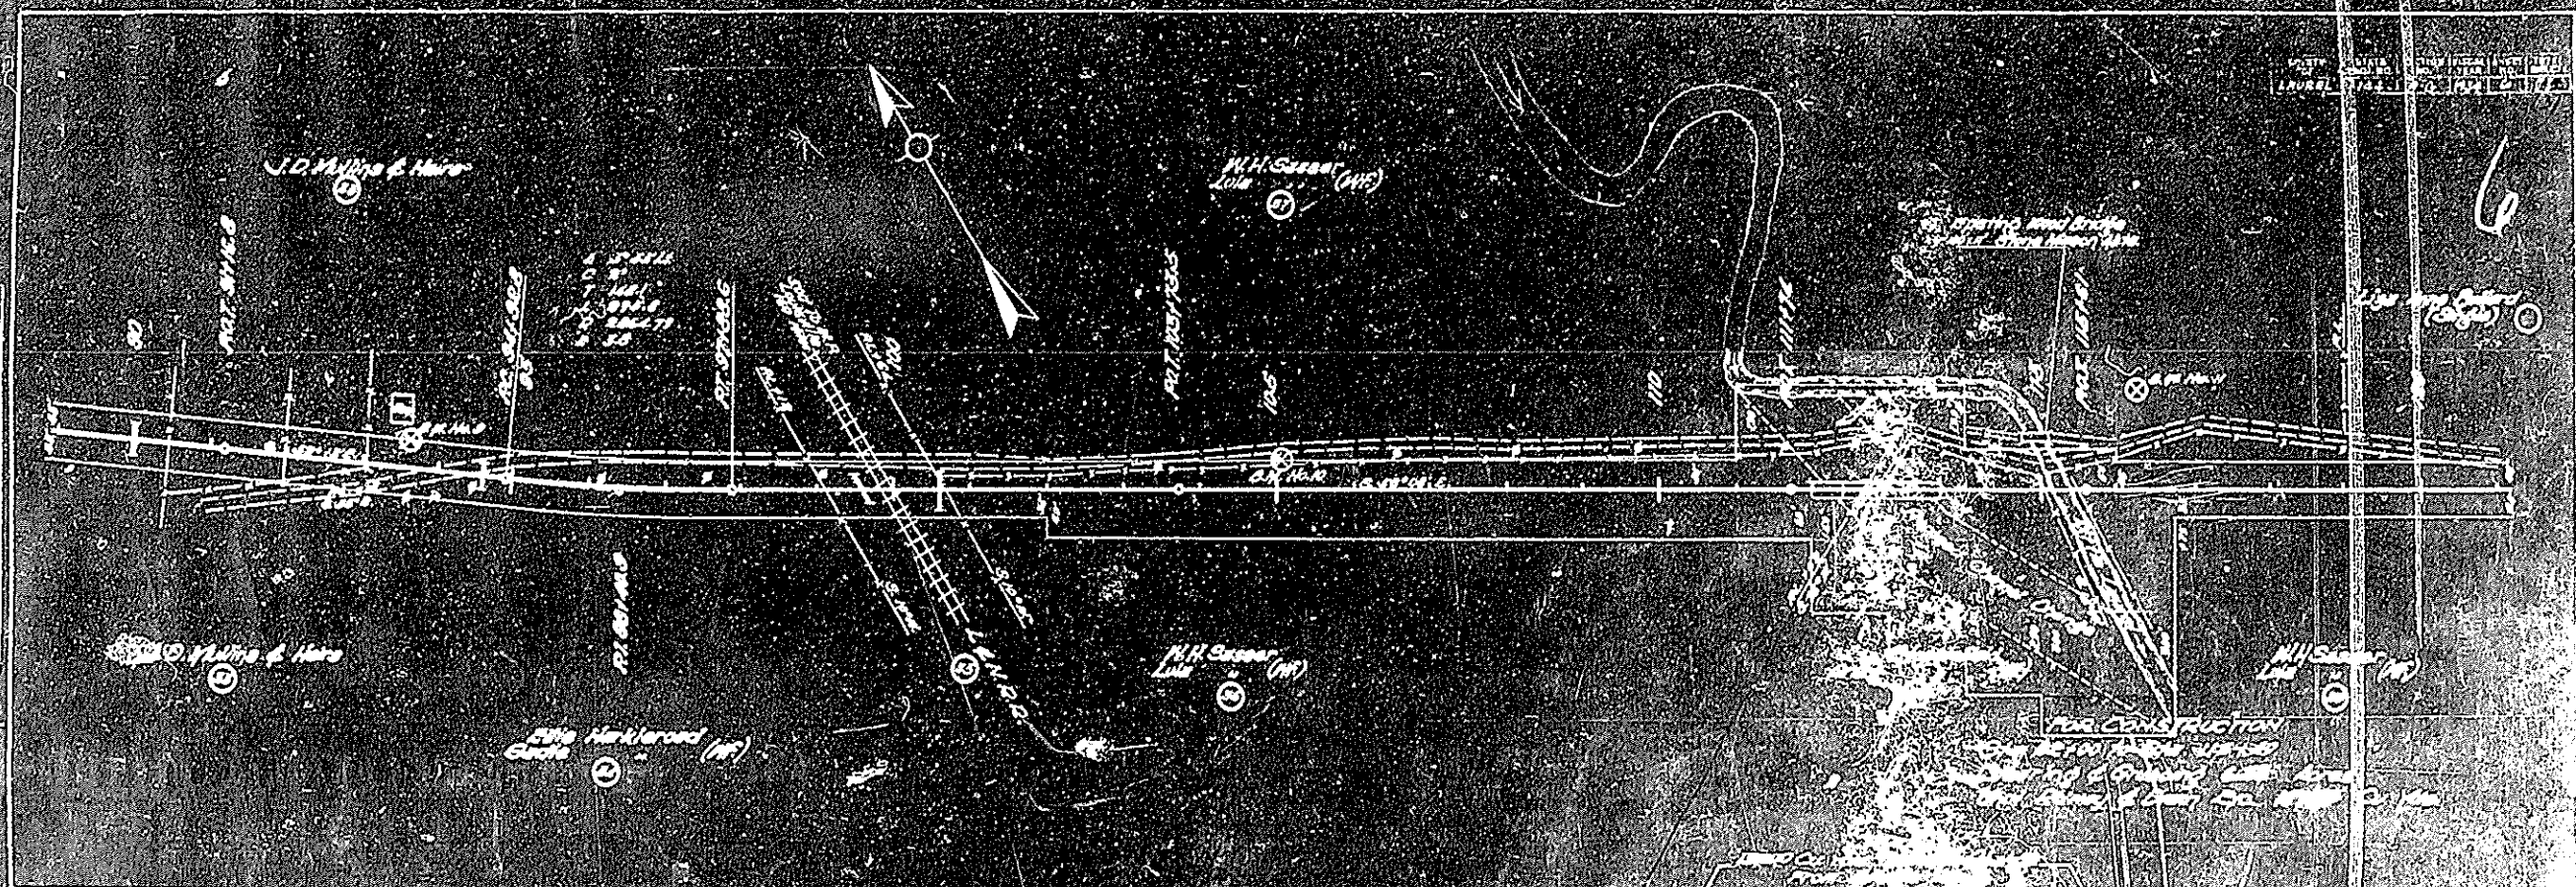

COMMONWEALTH OF KENTUCKY DEPARTMENT OF HIGHWAYS


COUNTY OF	FISCAL YEAR	SHEET NO.	TOTAL SHEETS
LAUREL		1	160

RS 5203 (12)
FSP 063 0025 012-013

PLANS OF PROPOSED PROJECT

LAUREL COUNTY
CORBIN - LONDON ROAD (US 25)
RS 5203 (12)

THESE PLANS ARE FOR
GRADE, DRAIN AND SURFACING

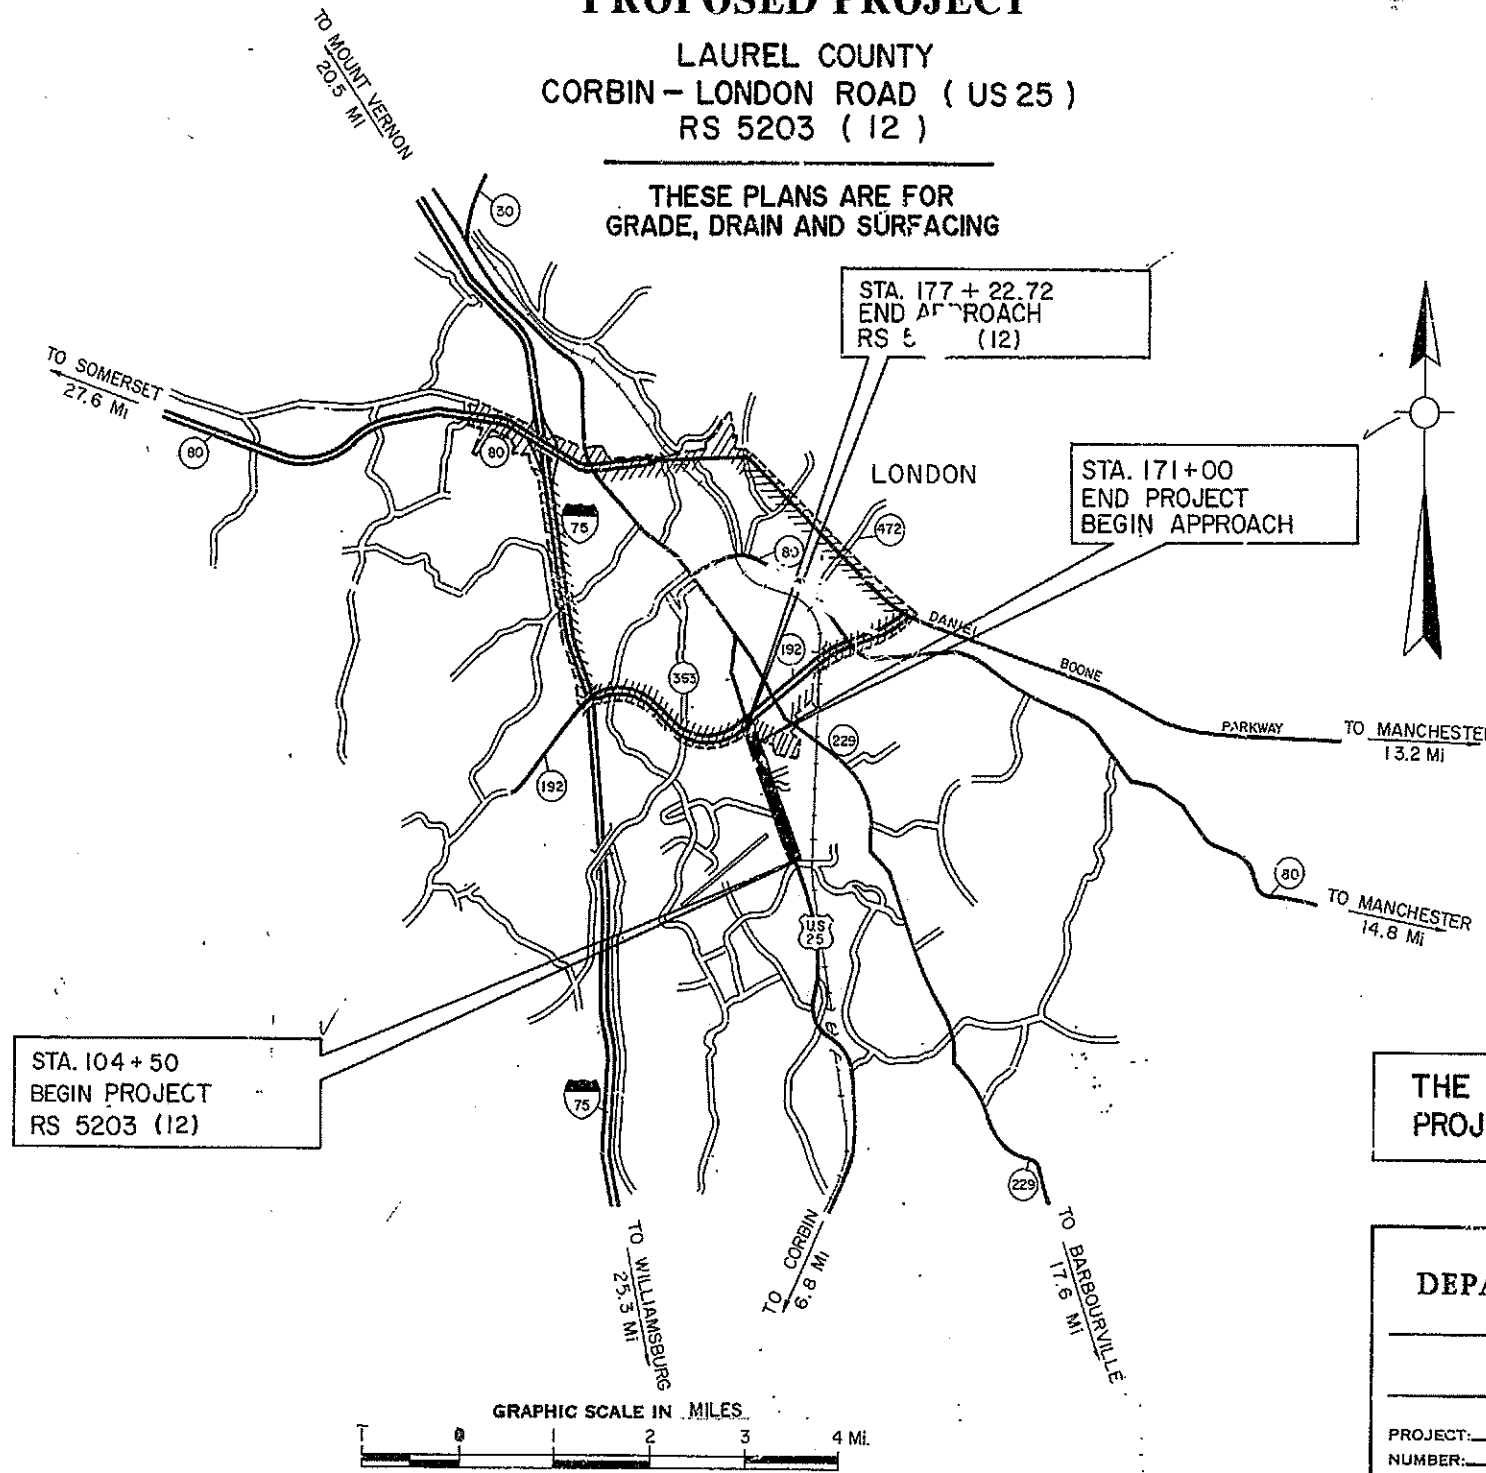

AS BUILT PLANS
P.O. Brady
 8-2-95

THE CONTROL OF ACCESS FOR THIS
 PROJECT SHALL BE BY PERMIT

SHEET NO	DESCRIPTION
1	LAYOUT SHEET
2 - 201	TYPICAL SECTIONS - SUMMARY OF QUANTITIES SHEETS
3 - 28	PLAN AND PROFILE SHEETS
29 - 34	UTILITY PLAN
35 - 37	RIGHT OF WAY SUMMARY SHEETS
38 - 50	RIGHT OF WAY METES AND BOUNDS
51 - 58	RIGHT OF WAY STRIP MAP SHEETS
59 - 65 F	DETAIL SHEETS
66	REFERENCE SHEETS
N/A	SOIL PROFILE SHEETS
67 - 112	PIPE DRAINAGE SHEETS
113 - 160	CROSS SECTION SHEETS

SHEETS NOT INCLUDED IN TOTAL SHEETS 2A-2M, 3A, 65A-65F

TOTAL BRIDGE SHEETS N/A

STANDARD DRAWINGS		
NUMBER	DESCRIPTION	
RBI 001 - 05	RDB 271 - 02	RDM 001 - 03
RBI 002 - 03	RDB 272 - 03	RDM 005 - 02
	RDB 273 - 02	RDM 010 - 03
	RDB 280 - 02	RDM 011 - 01
RBR 005 - 06	RDB 281	RDM 012
RBR 010 - 02	RDB 282	RDM 013
RBR 015 - 02	RDB 283	RDM 100
RBR 016 - 01	RDB 400 - 01	RDM 105
RBR 050	RDB 410 - 02	
RDB 004 - 05	RDB 420 - 01	RDX 160 - 02
RDB 007	RDB 430 - 02	RDX 200
		RFW 001 - 01
RDB 002 - 08	RDD 021 - 03	RGS 001 - 03
RDB 003 - 04	RDD 040 - 01	RGX 001 - 02
RDB 011 - 05	RDD 001 - 02	RGX 002 - 04
RDB 012 - 04	RDH 110	
	RDH 210	RGX 030 - 03
RDB 030	RDH 310 - 01	RPM 100 - 04
RDB 031	RDH 1005	RPM 110 - 01
RDB 032	RDH 1110	
RDB 033	RDH 1200	
RDB 034	RDH 1304	
RDB 035		RPM 160
RDB 020 - 02	RDI 001 - 03	RPM 170 - 01
RDB 100 - 01	RDI 003	RRE 002 - 02
RDB 101 - 01	RDI 020 - 04	TSC 200 - 04
RDB 105 - 02	RDI 030 - 03	TSC 015
RDB 106 - C1	RDI 100 - 01	TSC 250 - 02
RDB 270 - 03	RDI 120 - 01	TSC 260 - 06
	RDI 200	TSC 261 - 03

TOTAL STD. DRAWING 78

DESIGN CRITERIA	
CLASS OF HIGHWAY	COLLECTOR
TYPE OF TERRAIN	ROLLING URBAN
DESIGN SPEED	45 MPH
REQUIRED NPSD	325 MIN.
REQUIRED PSD	N/A
LEVEL OF SERVICE	N/A
ADT PRESENT (1985)	15,000
ADT FUTURE (2005)	24,000
DHV (2005)	1,800 (7% TRUCKS)
D %	7%
T %	7% DHV 10% ADT

GEOGRAPHIC COORDINATES	
LATITUDE	37°-06' NORTH
LONGITUDE	84°-04' WEST

DESIGNED

% RESTRICTED SD	N/A
LEVEL OF SERVICE	
MAX. DISTANCE W/O PASSING	N/A

GROSS LENGTH		NET LENGTH		GROSS LENGTH		NET LENGTH		GROSS LENGTH		NET LENGTH	
ADDED	DEDUCTED	ADDED	DEDUCTED	ADDED	DEDUCTED	ADDED	DEDUCTED	ADDED	DEDUCTED	ADDED	DEDUCTED
6650.00		6650.00									



KENTUCKY DEPARTMENT OF HIGHWAYS	
LAUREL COUNTY	
CORBIN - LONDON ROAD (US 25)	
PROJECT:	RS 5203 (12)
NUMBER:	FSP 063 0025 012 013 C
LETTING DATE:	12-16-88
DESIGNED BY:	June 09, 1988 BY <i>H.A. Gilbert</i> <small>ASST. DISTRICT ENGINEER BY PERM. CONTRIBUTION</small>
APPROVE:	Sept. 8, 1988 BY <i>Henry C. Latta</i> FOR: <i>J.R. Latta</i> <small>DIRECTOR OF TRAFFIC</small>
PLAN CHECKED:	9-13-88 BY <i>M.W. Copeland</i> <small>FOR: CHIEF DRAFTER</small>
PLAN APPROVED:	9/14/88 BY <i>James S. Blum</i> <small>DIRECTOR OF DESIGN</small>
PLAN APPROVED:	10 BY <i>[Signature]</i> <small>STATE HIGHWAY ENGINEER</small>

CONSTRUCTION PLANS 1-37-88
 RECORD PLANS 12-14-88

REVIEWED BY: DIVISION OF CONSTRUCTION

PLANS CHECKED BY: E.T.W.
 FINAL CHECK BY: M.K.C. 7-12-88

TELETYPE POST
 10-1-82
 FORM NO. 1

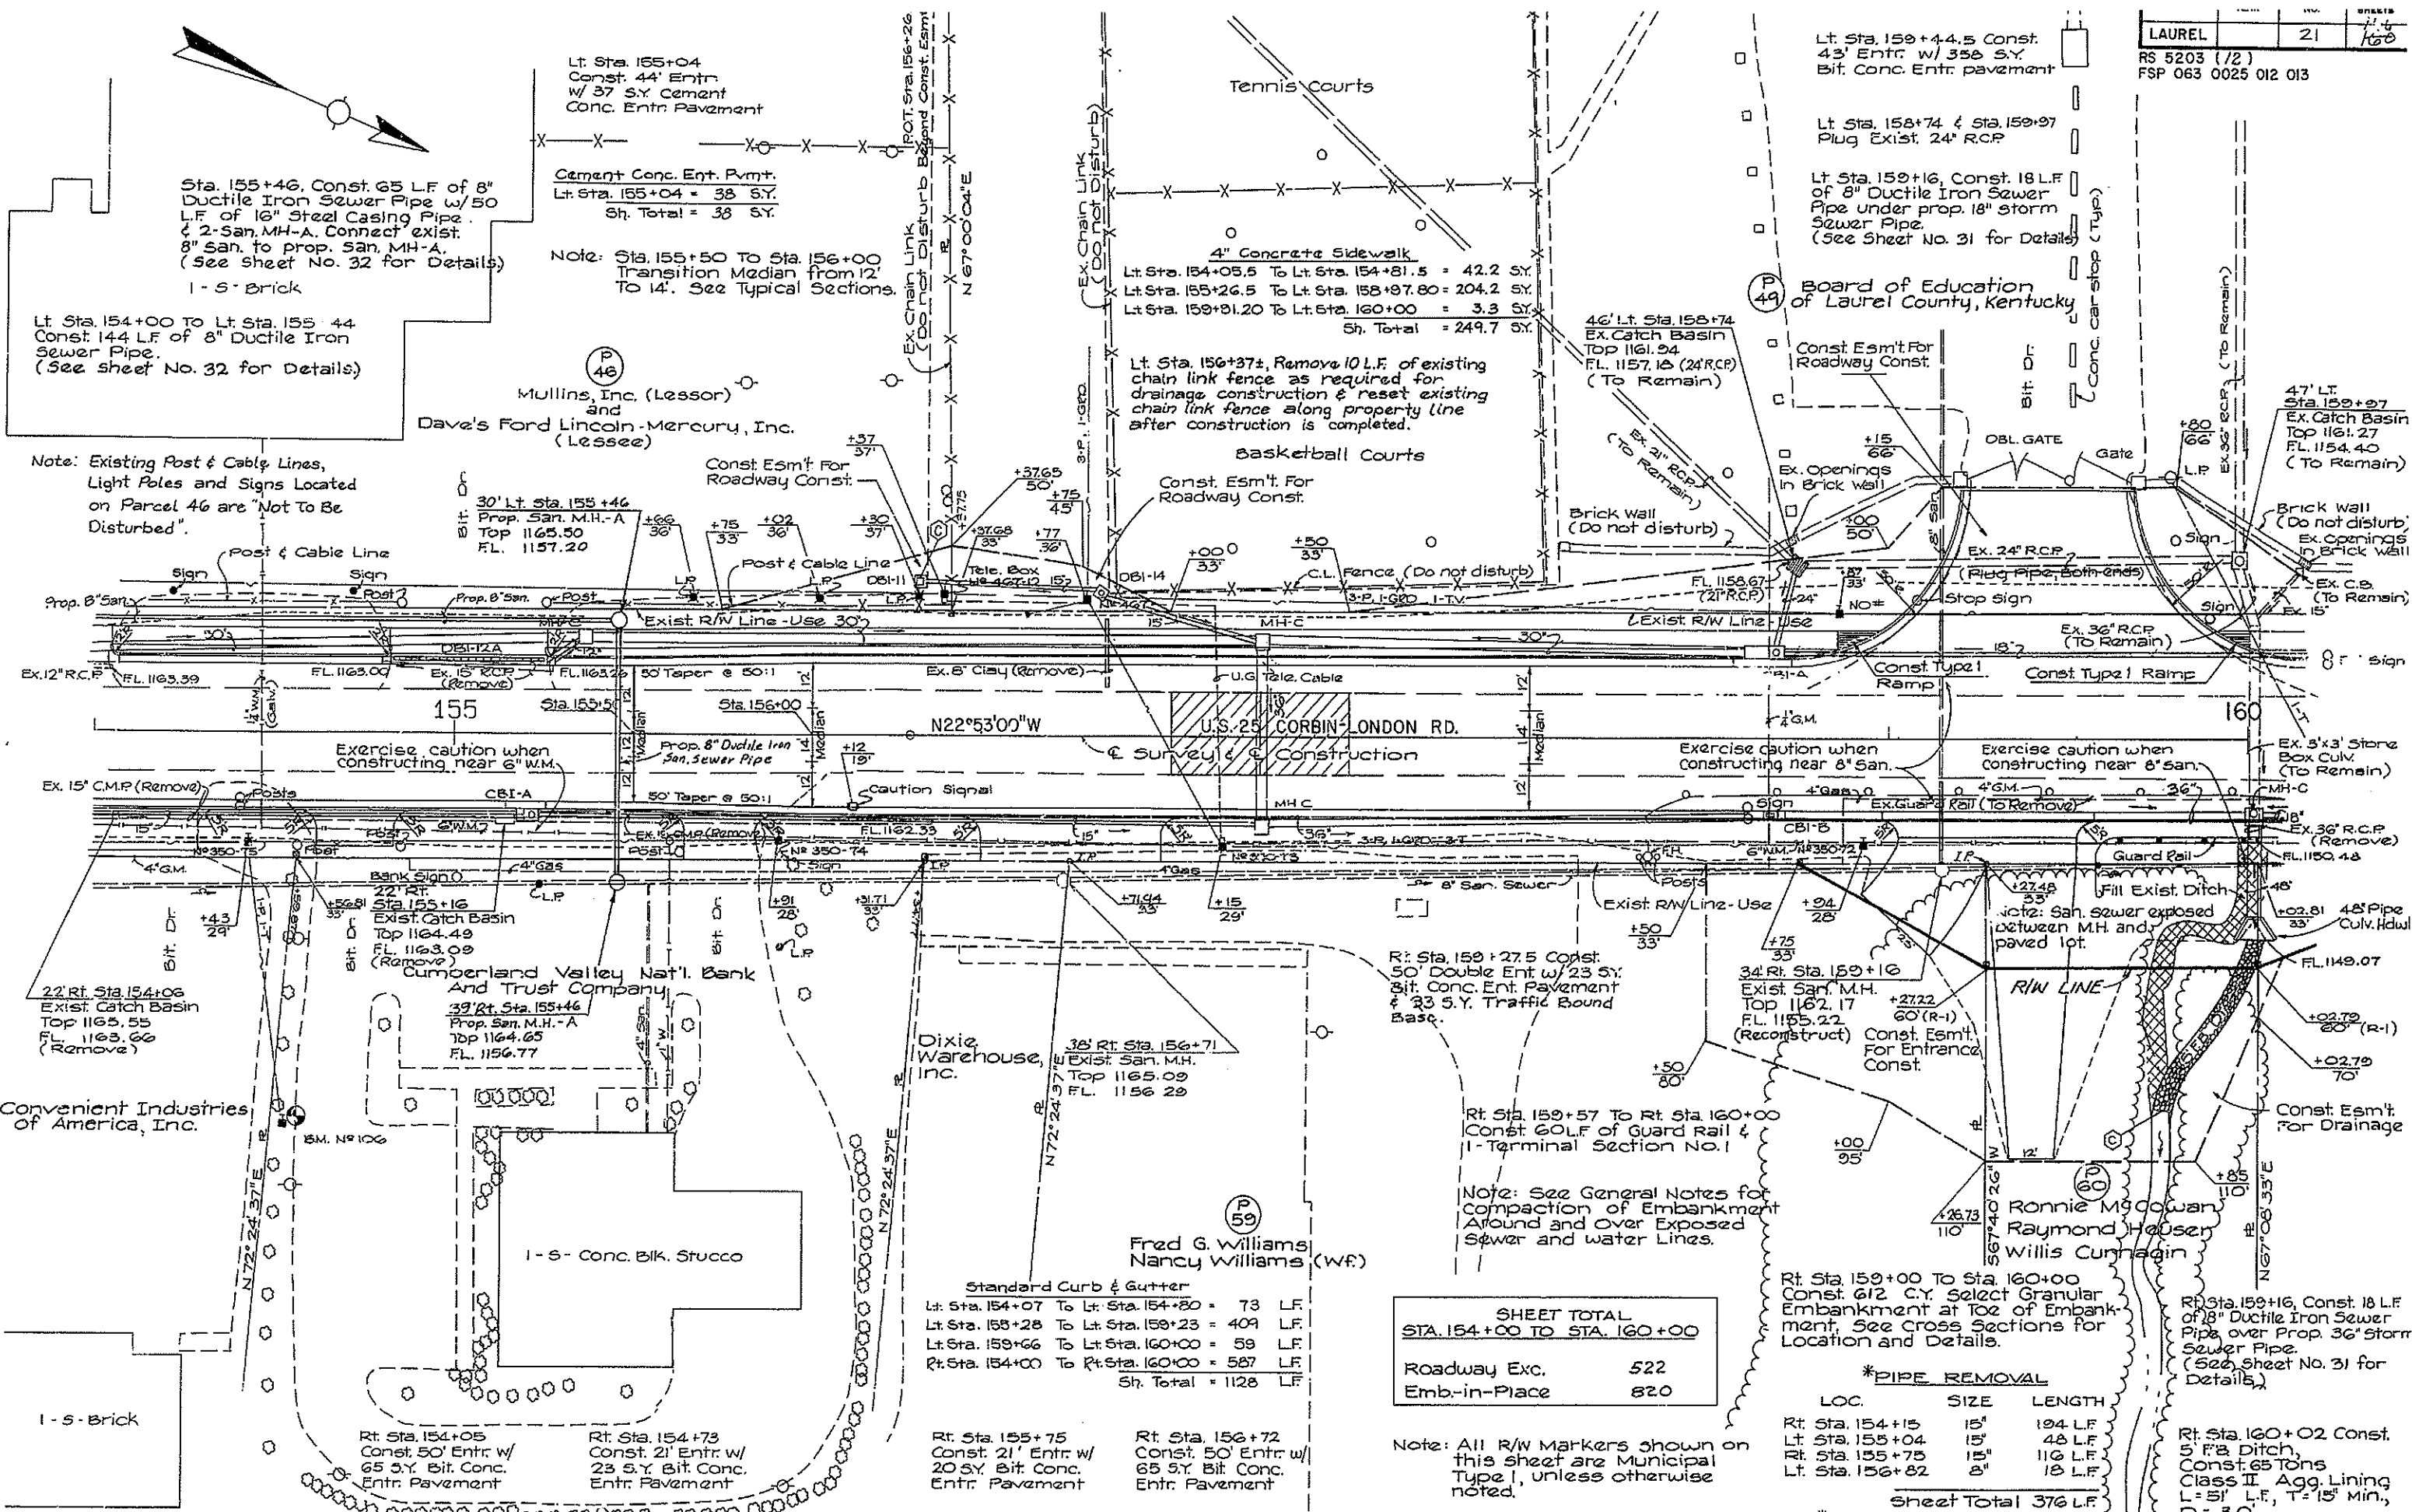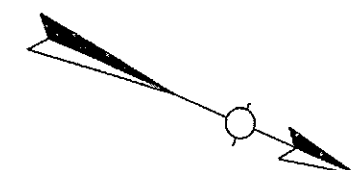

Standard Curb & Gutter

Lt. Sta. 154+07 To Lt. Sta. 154+20 =	73 LF.
Lt. Sta. 158+28 To Lt. Sta. 159+23 =	409 LF.
Lt. Sta. 159+66 To Lt. Sta. 160+00 =	59 LF.
Rt. Sta. 154+00 To Rt. Sta. 160+00 =	587 LF.
Sh. Total = 1128 LF.	

SHEET TOTAL STA. 154+00 TO STA. 160+00		
Roadway Exc.	522	
Emb.-in-Place	820	

*PIPE REMOVAL

LOC.	SIZE	LENGTH
Rt. Sta. 154+15	15"	194 LF.
Lt. Sta. 155+04	15"	48 LF.
Rt. Sta. 155+75	15"	116 LF.
Lt. Sta. 156+82	8"	18 LF.
Sheet Total 376 LF.		

Note: All R/W markers shown on this sheet are Municipal Type I, unless otherwise noted.

Existing Pavement Removal Included in Roadway Excavation

Note: Removal shall be considered incidental to the project earthwork and no additional payment will be allowed.


Scale: 1" = 20'

35

RR. SPIKE IN PP #412 ON EAST SIDE
OF U.S. 25, PP BETWEEN CUMBERLAND
VALLEY NAT. BANK & CONVENIENT STORE
102' RT. STA. 154+56


+97 1-NITZ
Elev. 1195.15
(Plotting not correct)

LAUREL 22 144/160
RS 5203 (1/2)
FSP 063 0025 012 013

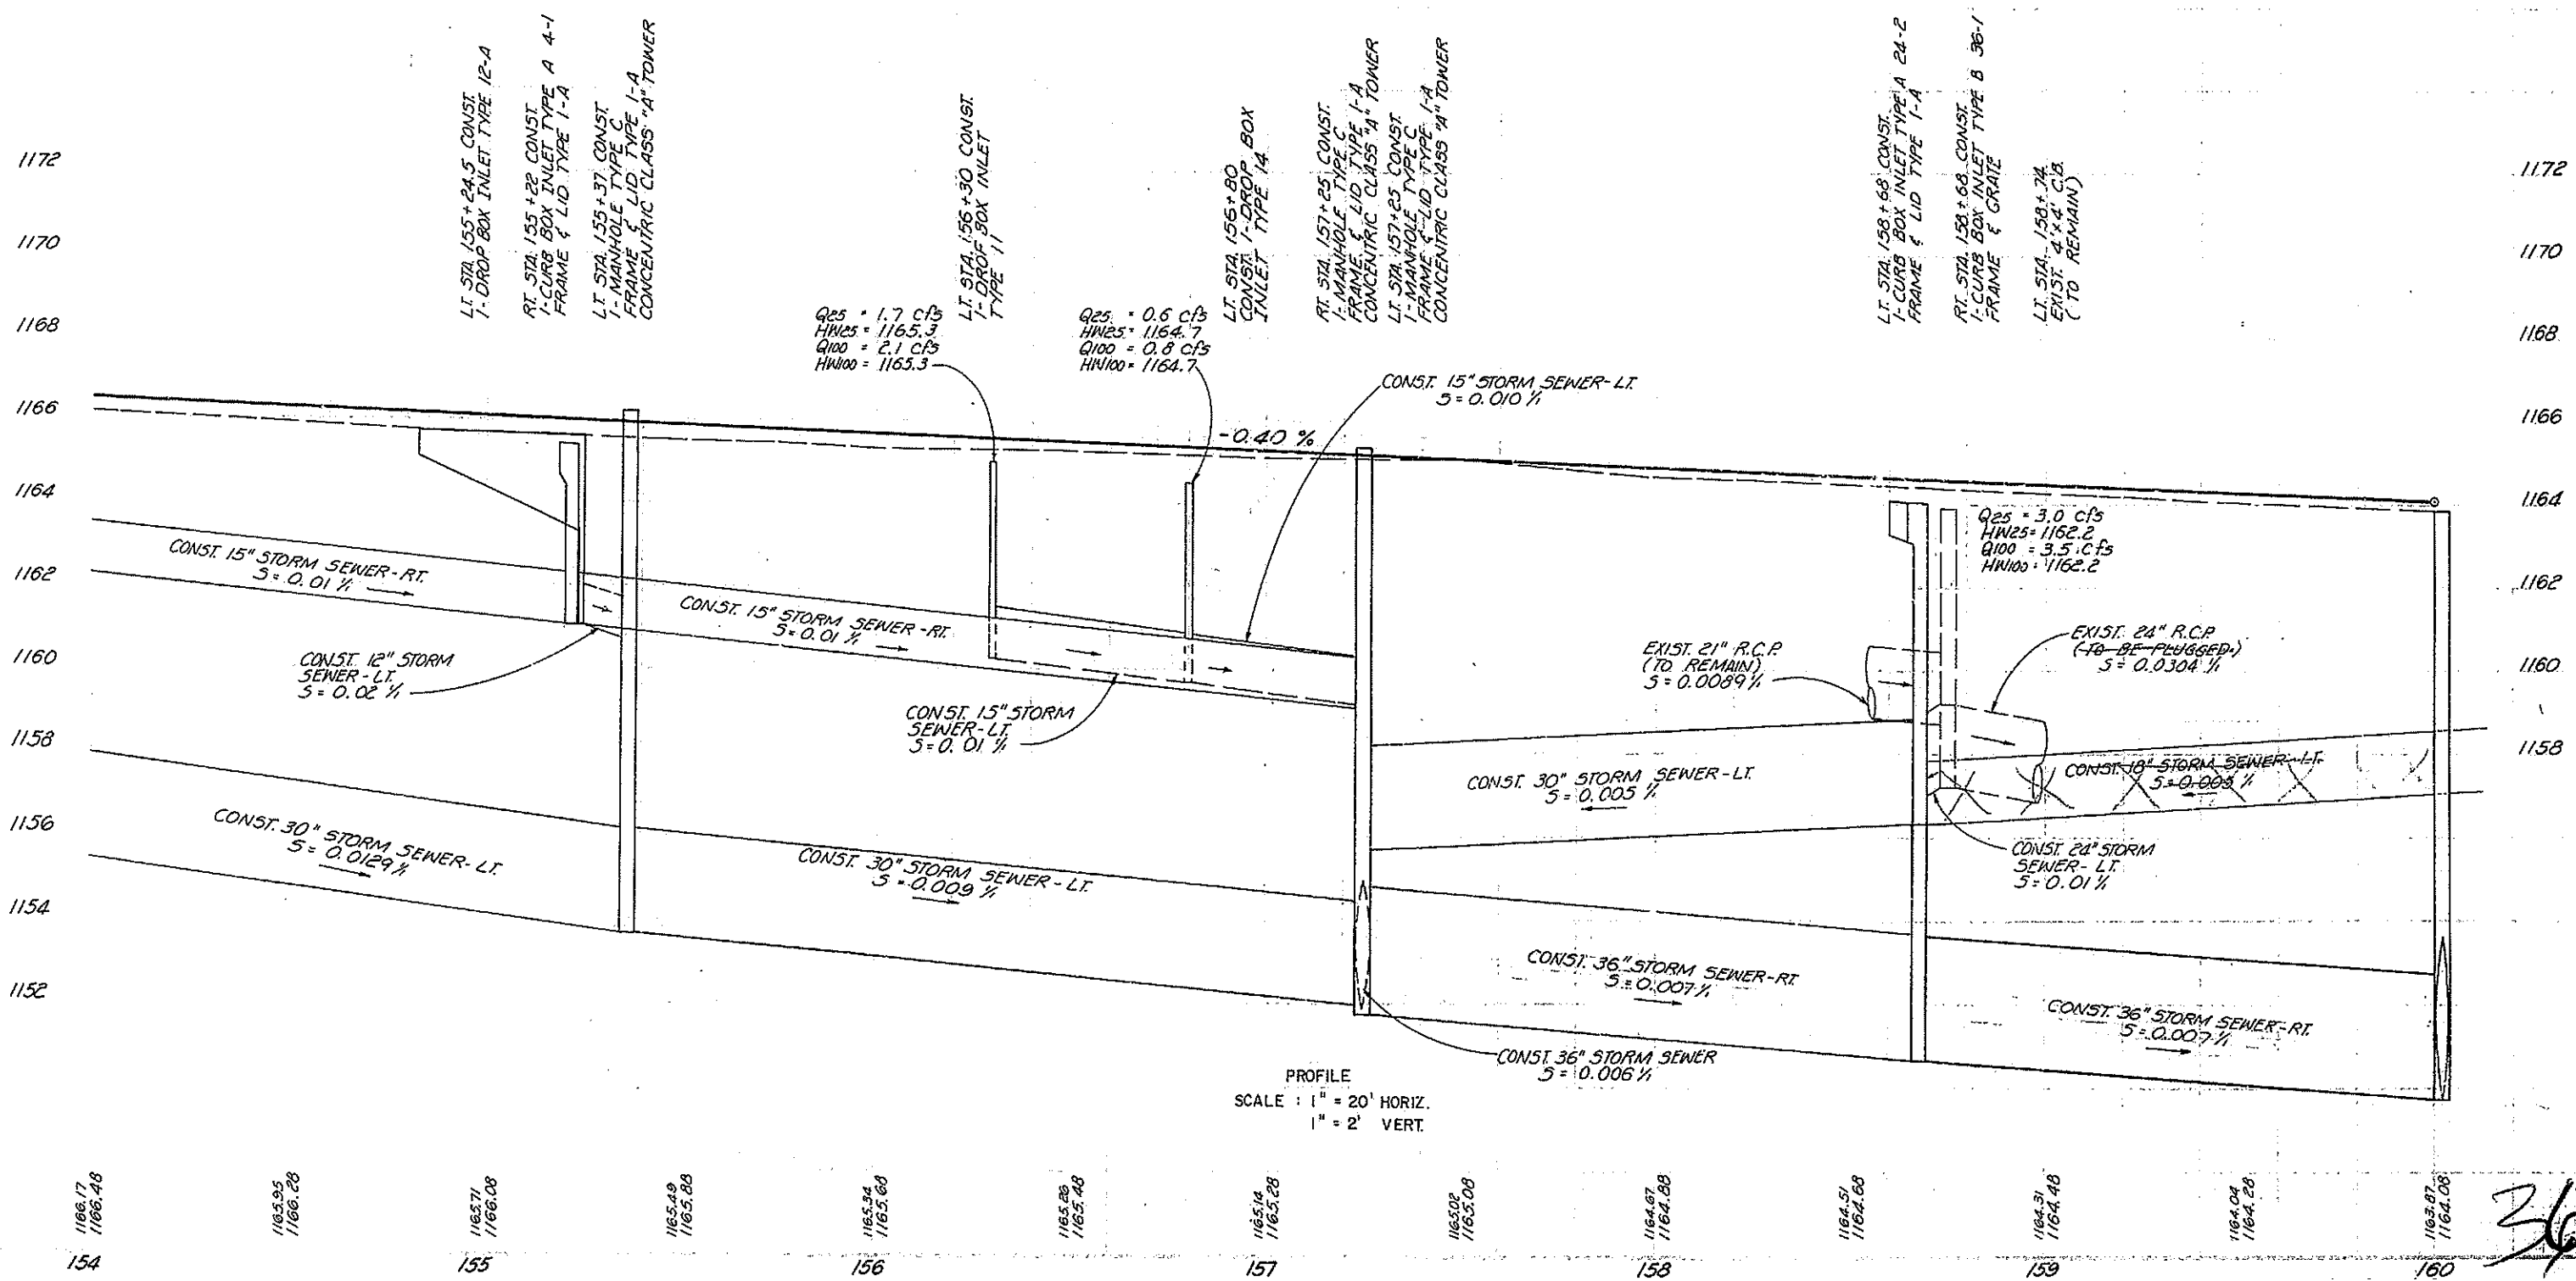

1166.17 / 1166.48
1165.95 / 1166.28
1165.71 / 1166.08
1165.49 / 1165.88
1165.24 / 1165.68
1165.28 / 1165.48
1165.14 / 1165.28
1165.02 / 1165.08
1164.87 / 1164.88
1164.51 / 1164.68
1164.31 / 1164.48
1164.04 / 1164.28
1163.87 / 1164.08


36

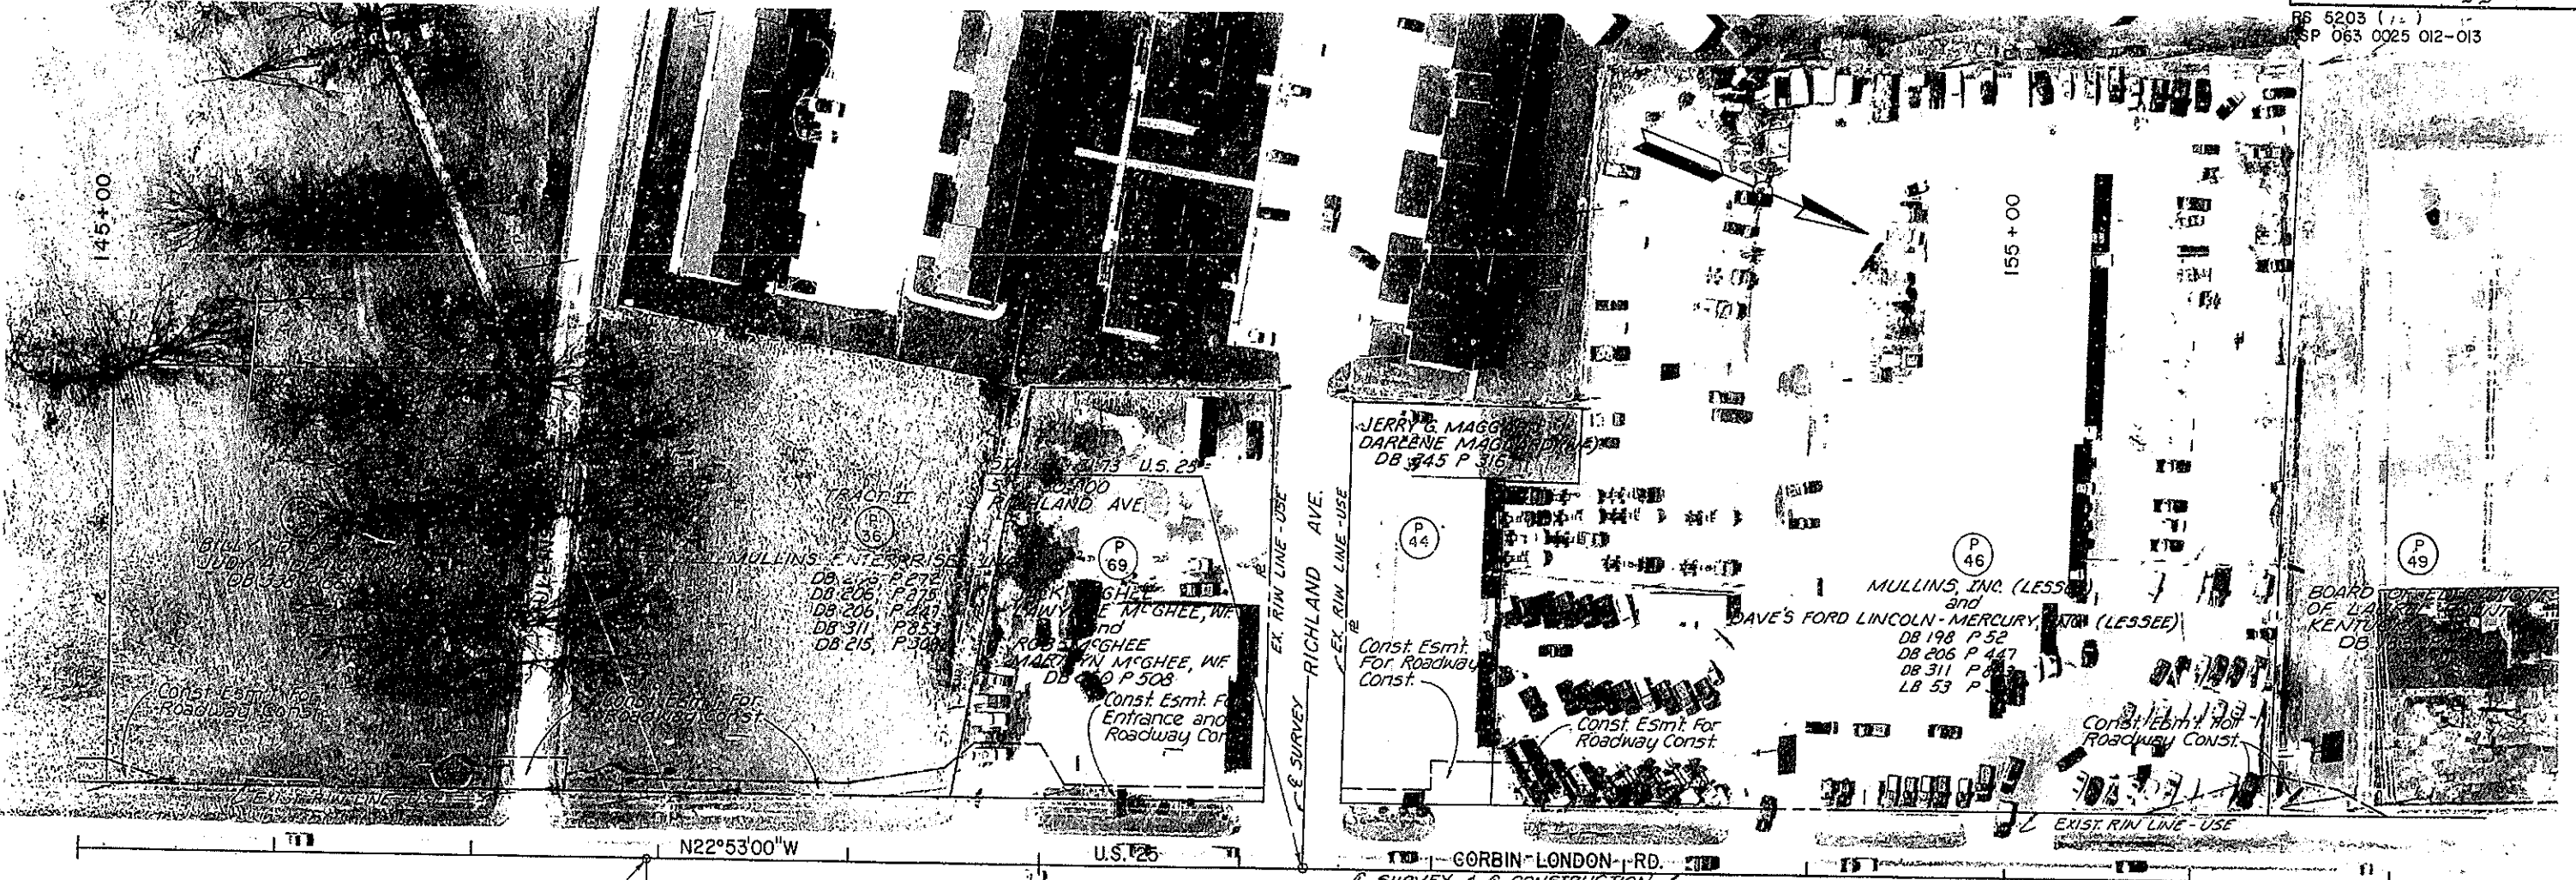

Scale: 1" = 50'

68


R/W STRIP MAP

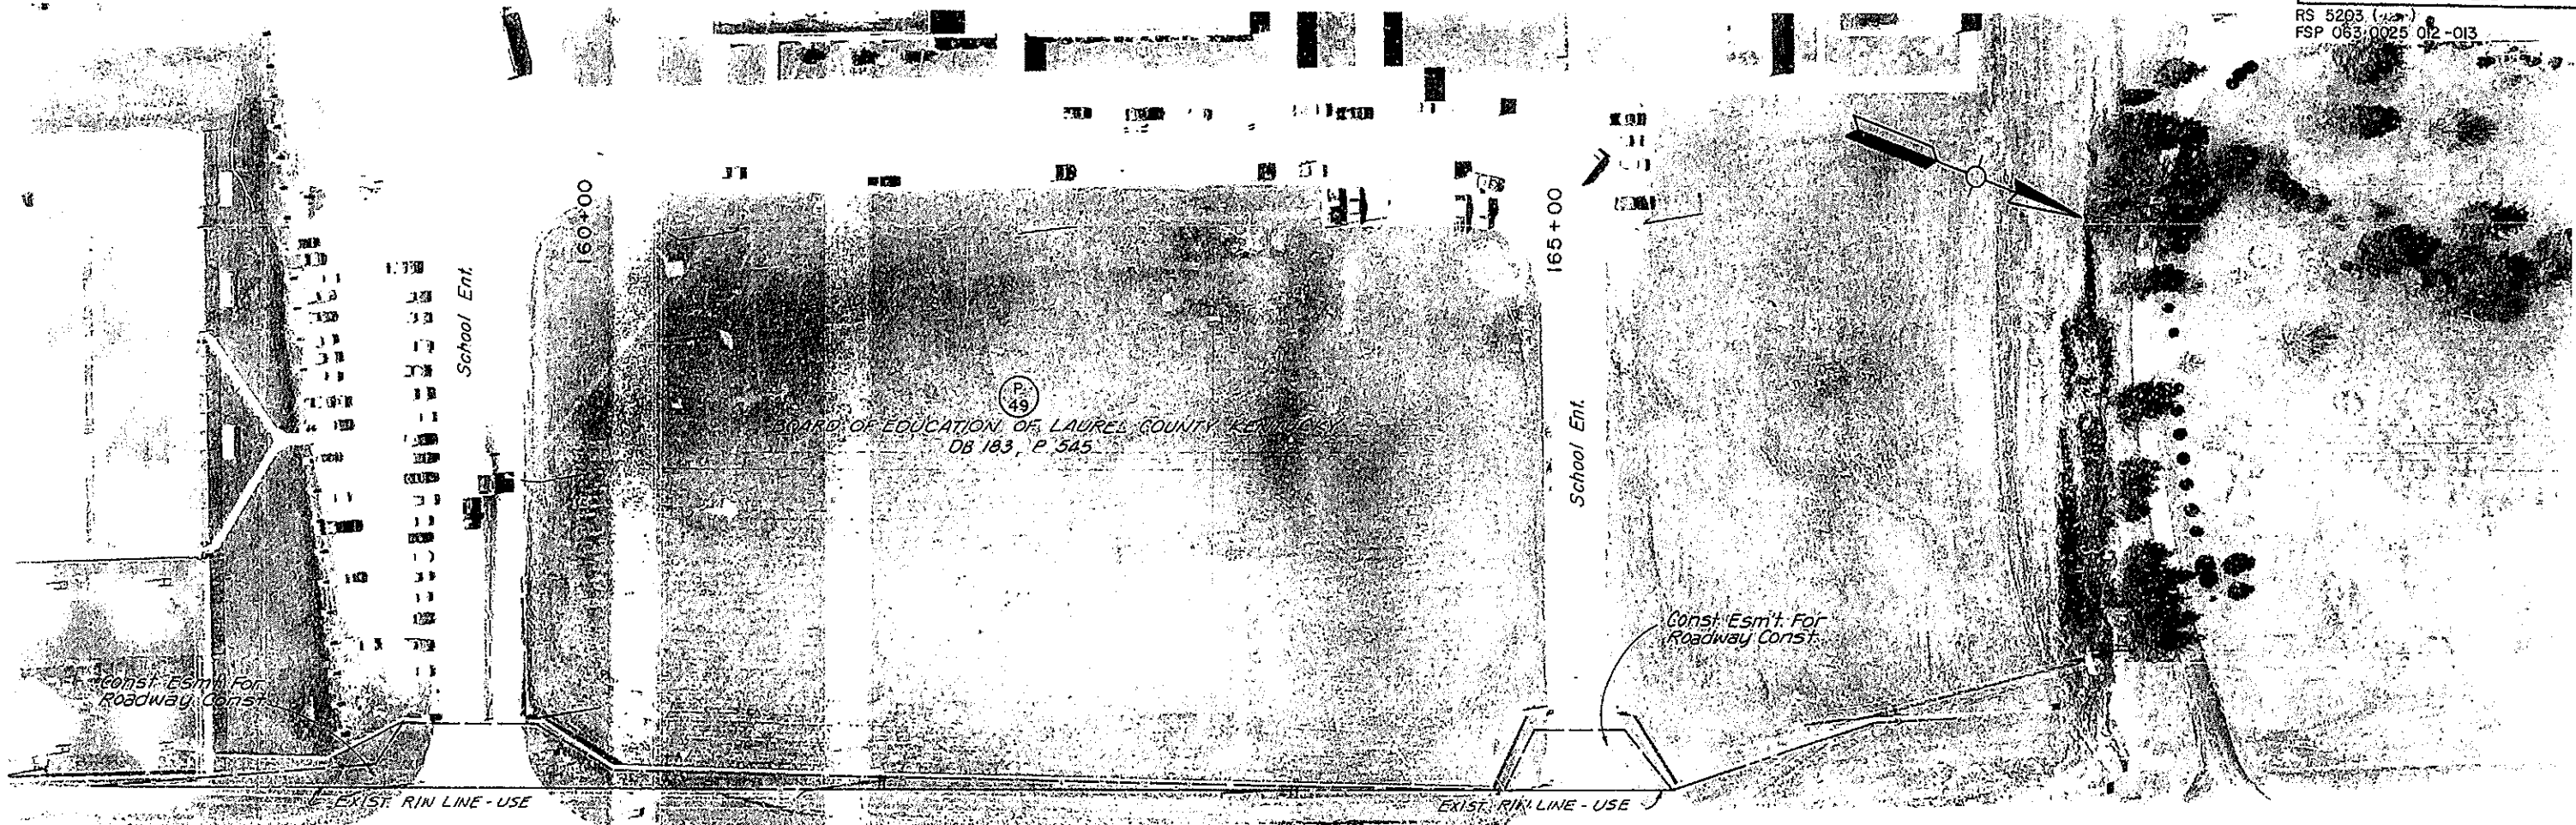

N22°53'00"


U.S. 25 CORBIN-LONDON RD.

E SURVEY & CONSTRUCTION

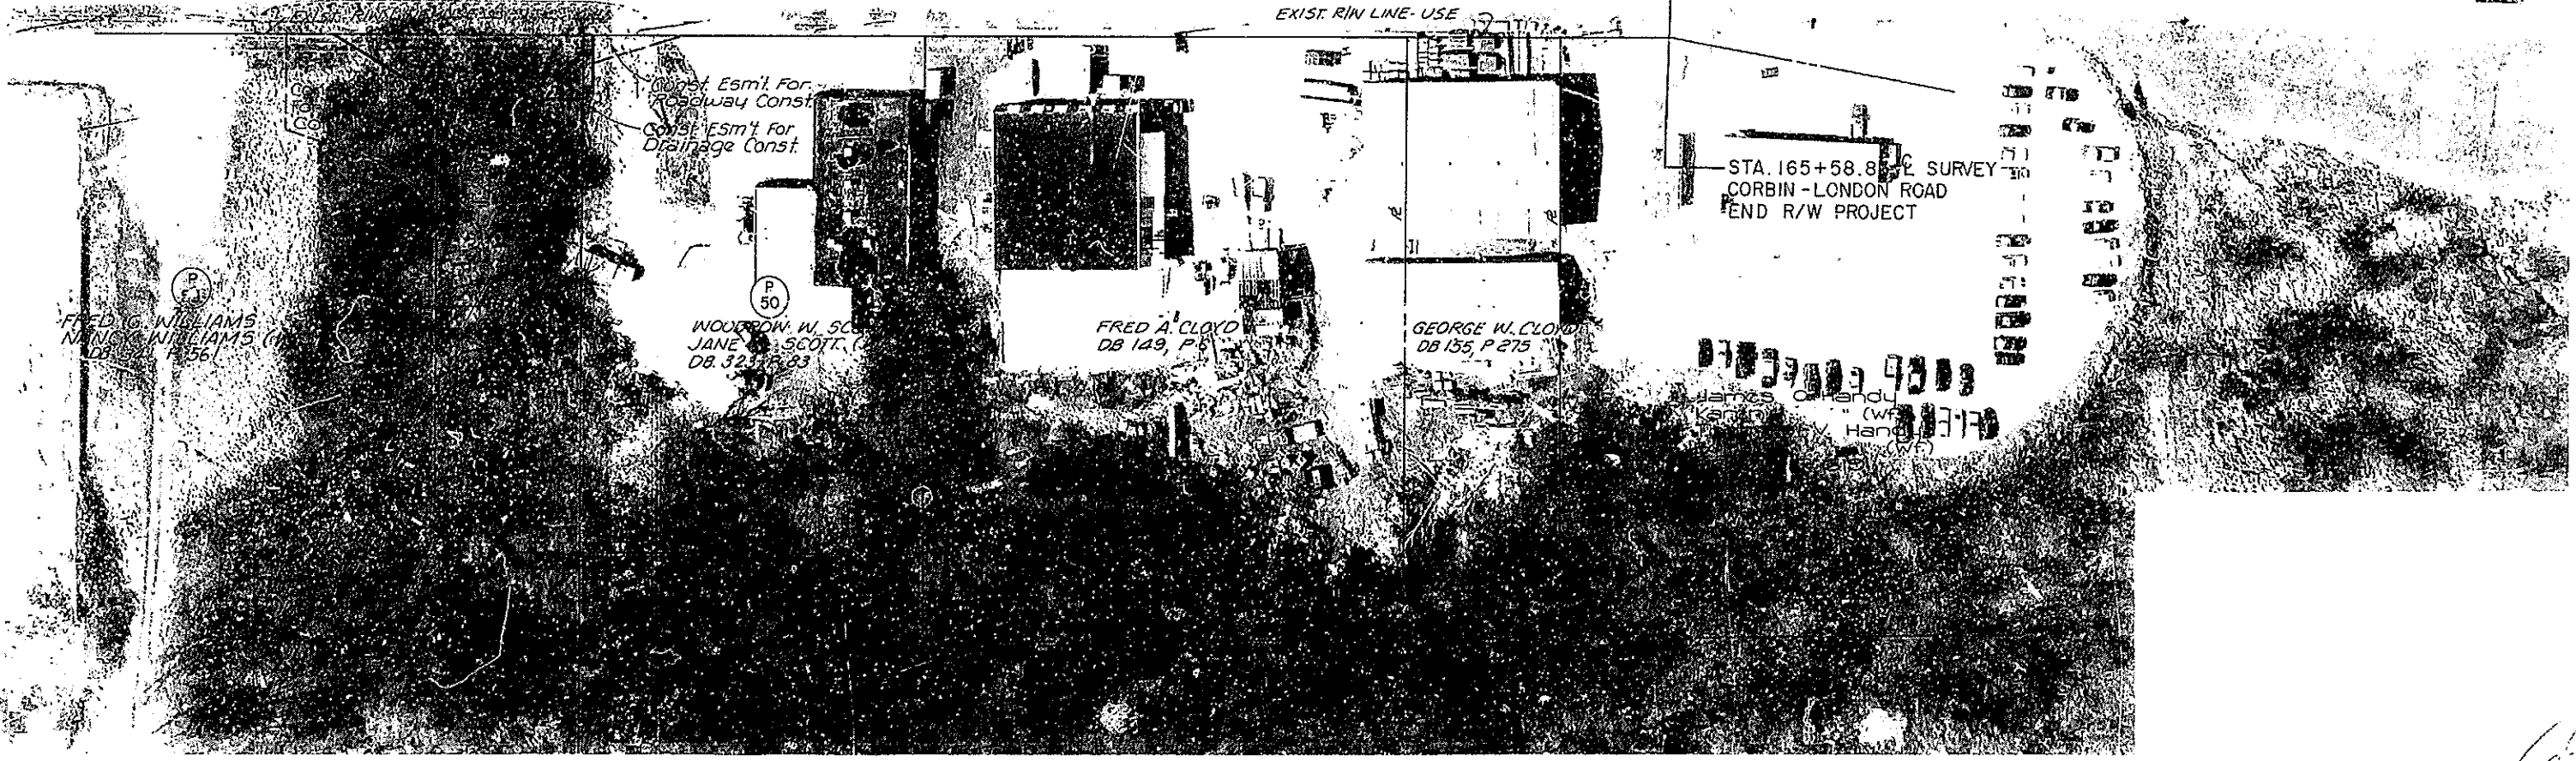

Scale: 1"=50'


154 155 156 157 158 159 160

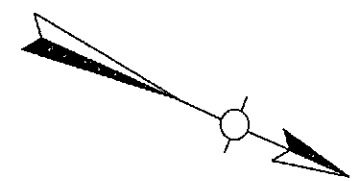


P 46
MULLINS, INC. (LESSOR)
and
DAVE'S FORD LINCOLN-MERCURY, INC. (LESSEE)
DG 198 P 52
DB 206 P 447
DB 311 P 853
LB 53 P 30

P 49
BOARD OF EDUCATION OF LAUREL COUNTY, KENTUCKY
DB 183 P 545

① N69°43'51"W 21.93'

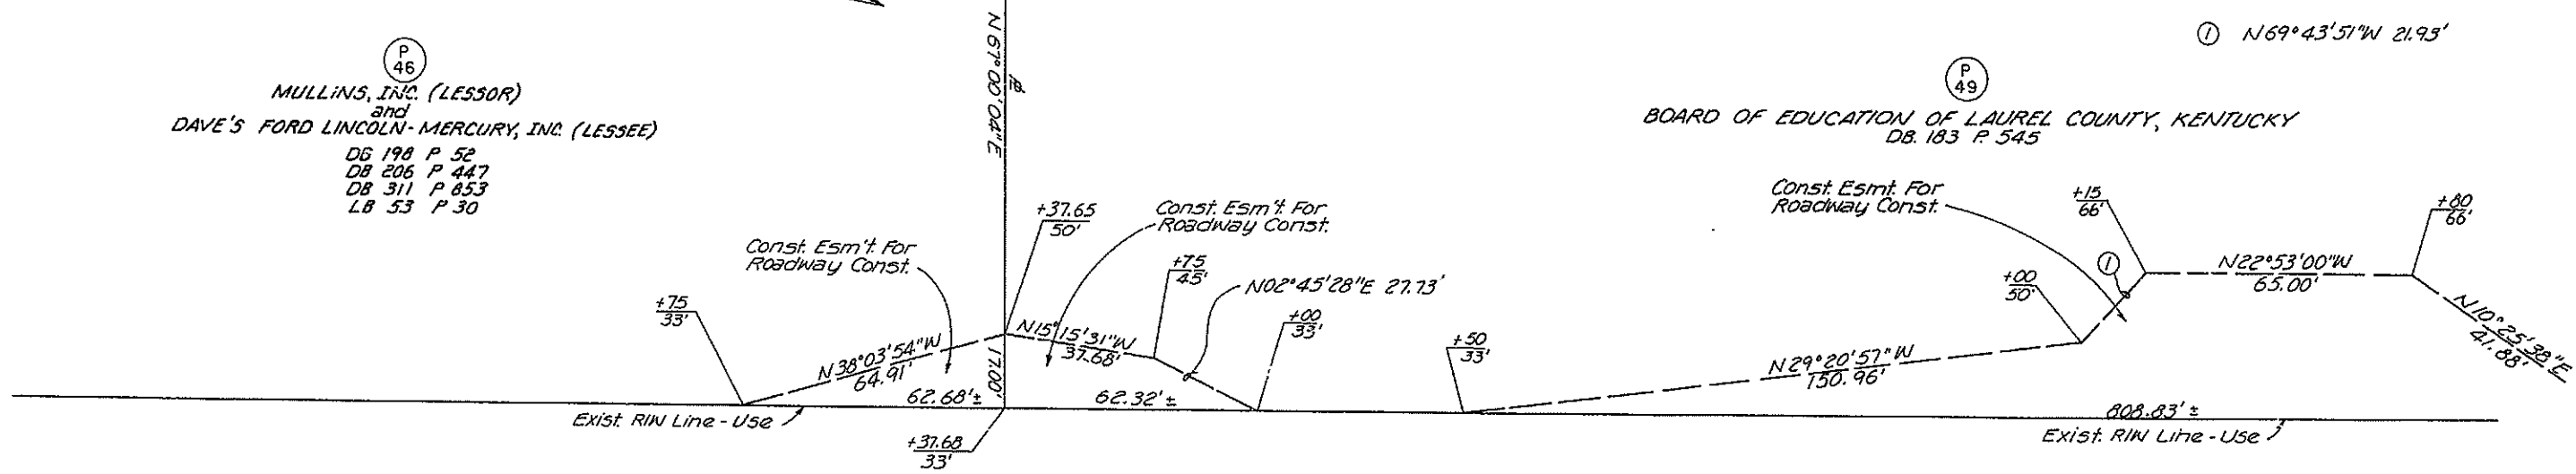

N22°53'00"W U.S. 25 CORBIN-LONDON RD. SURVEY & CONSTRUCTION

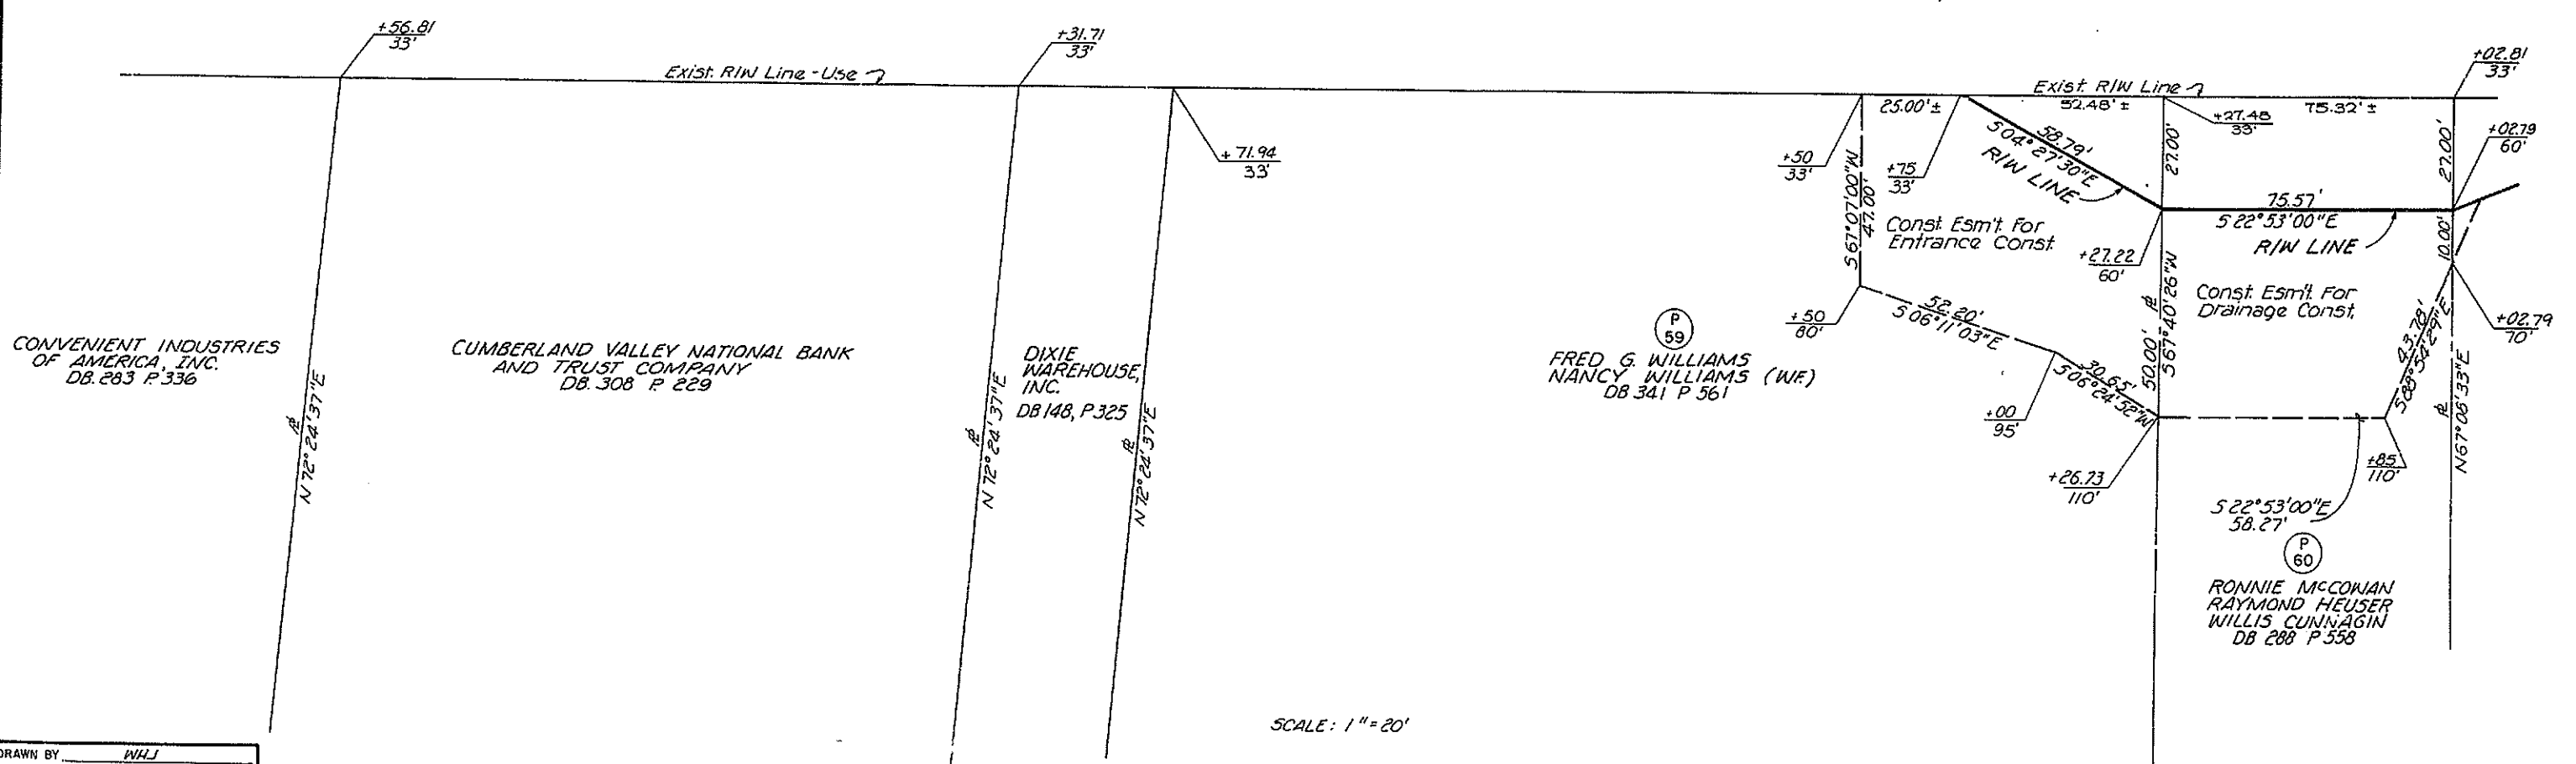

CONVENIENT INDUSTRIES
OF AMERICA, INC.
DB 283 P 336

CUMBERLAND VALLEY NATIONAL BANK
AND TRUST COMPANY
DB 308 P 229

DIXIE
WAREHOUSE,
INC.
DB 148, P 325




P 59
FRED G. WILLIAMS
NANCY WILLIAMS (WF)
DB 341 P 561

P 60
RONNIE MCCONNAN
RAYMOND HEUSER
WILLIS CUNNINGHAM
DB 288 P 558

SCALE: 1" = 20'

DRAWN BY: WJL
CHECKED BY: RDS
APPROVED BY:

61

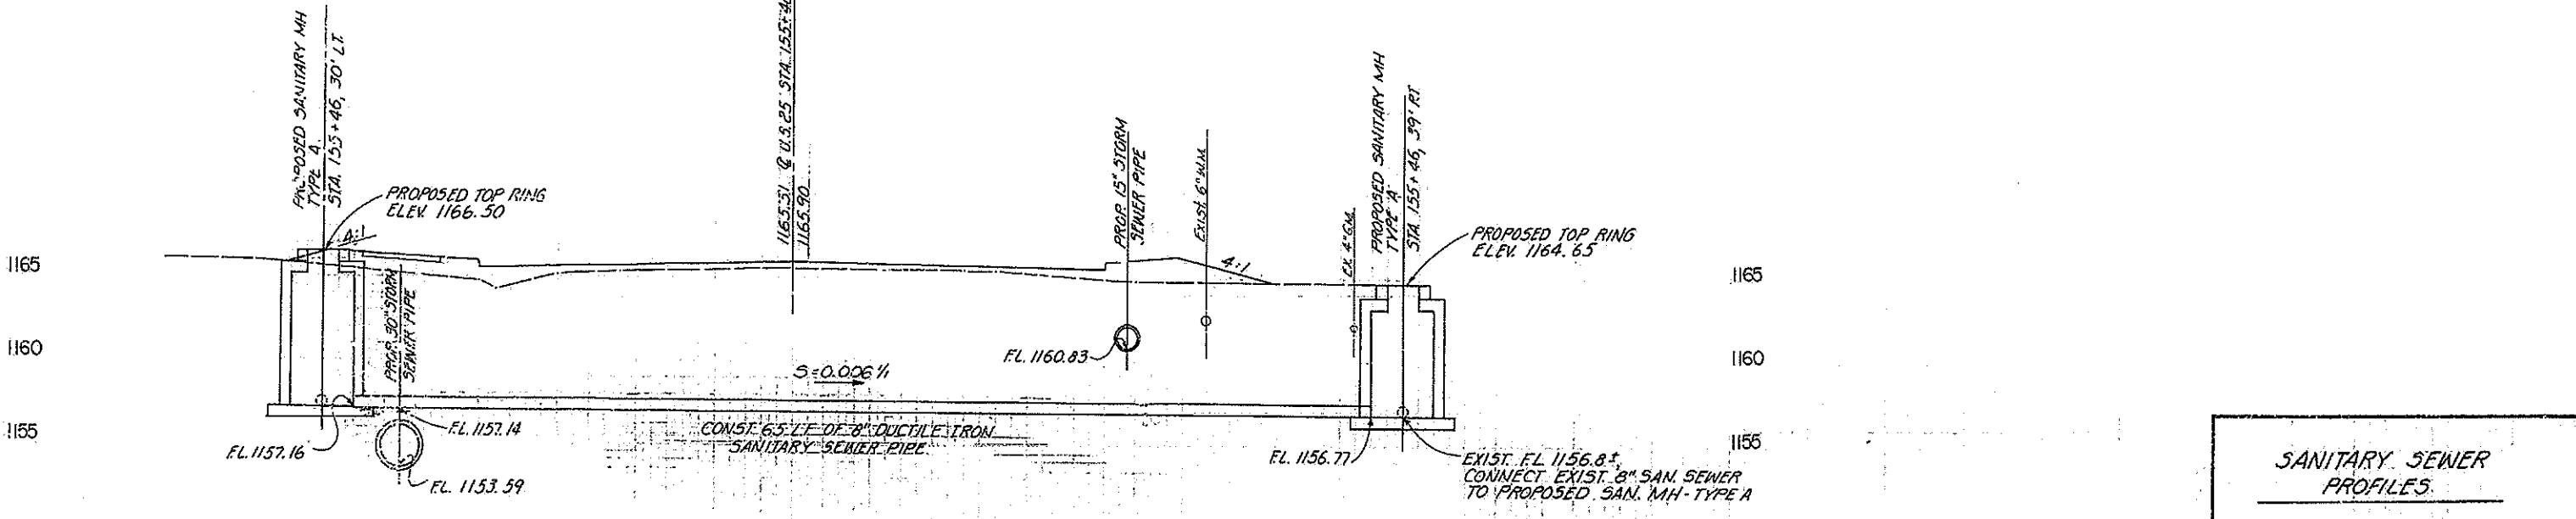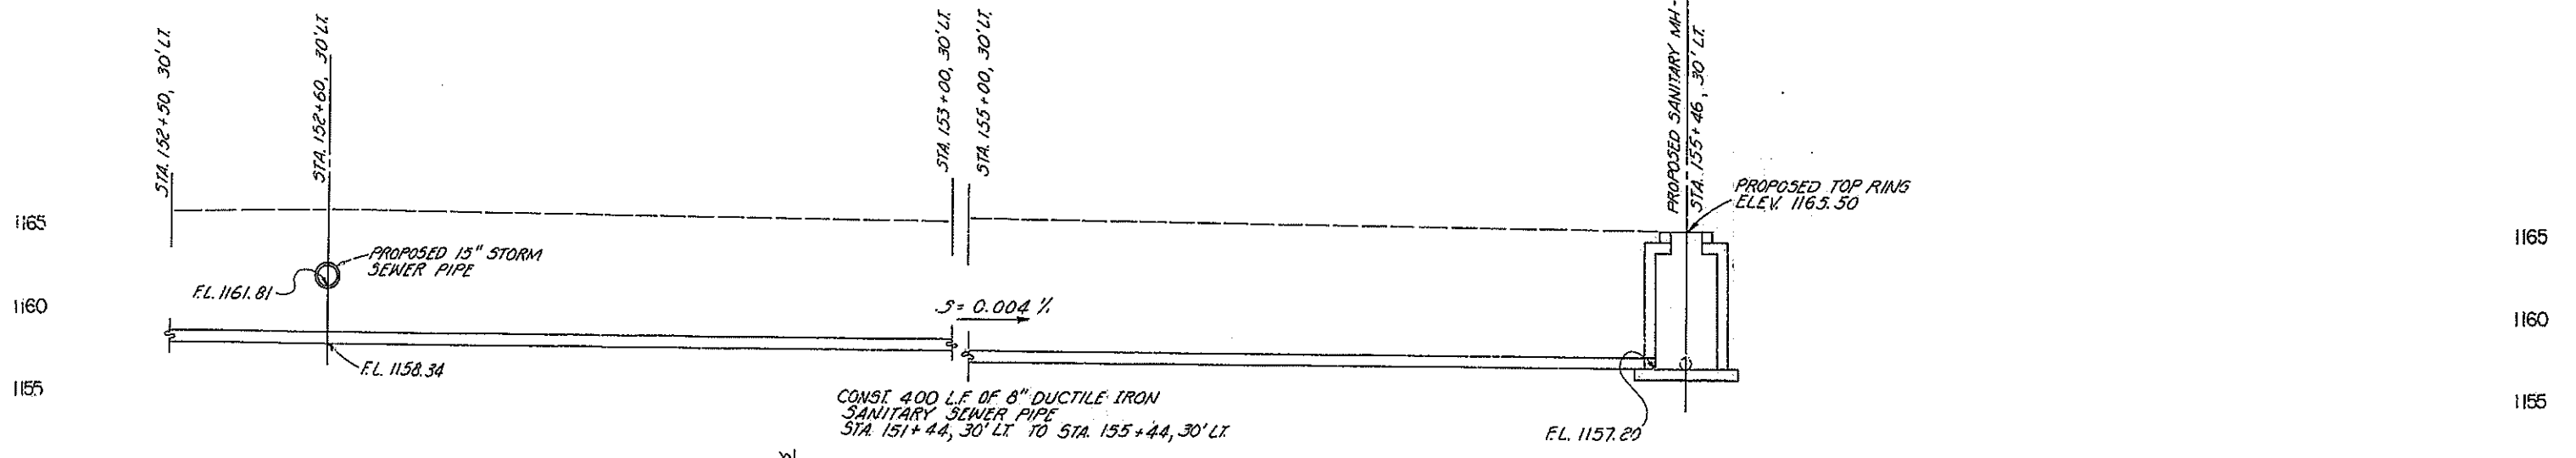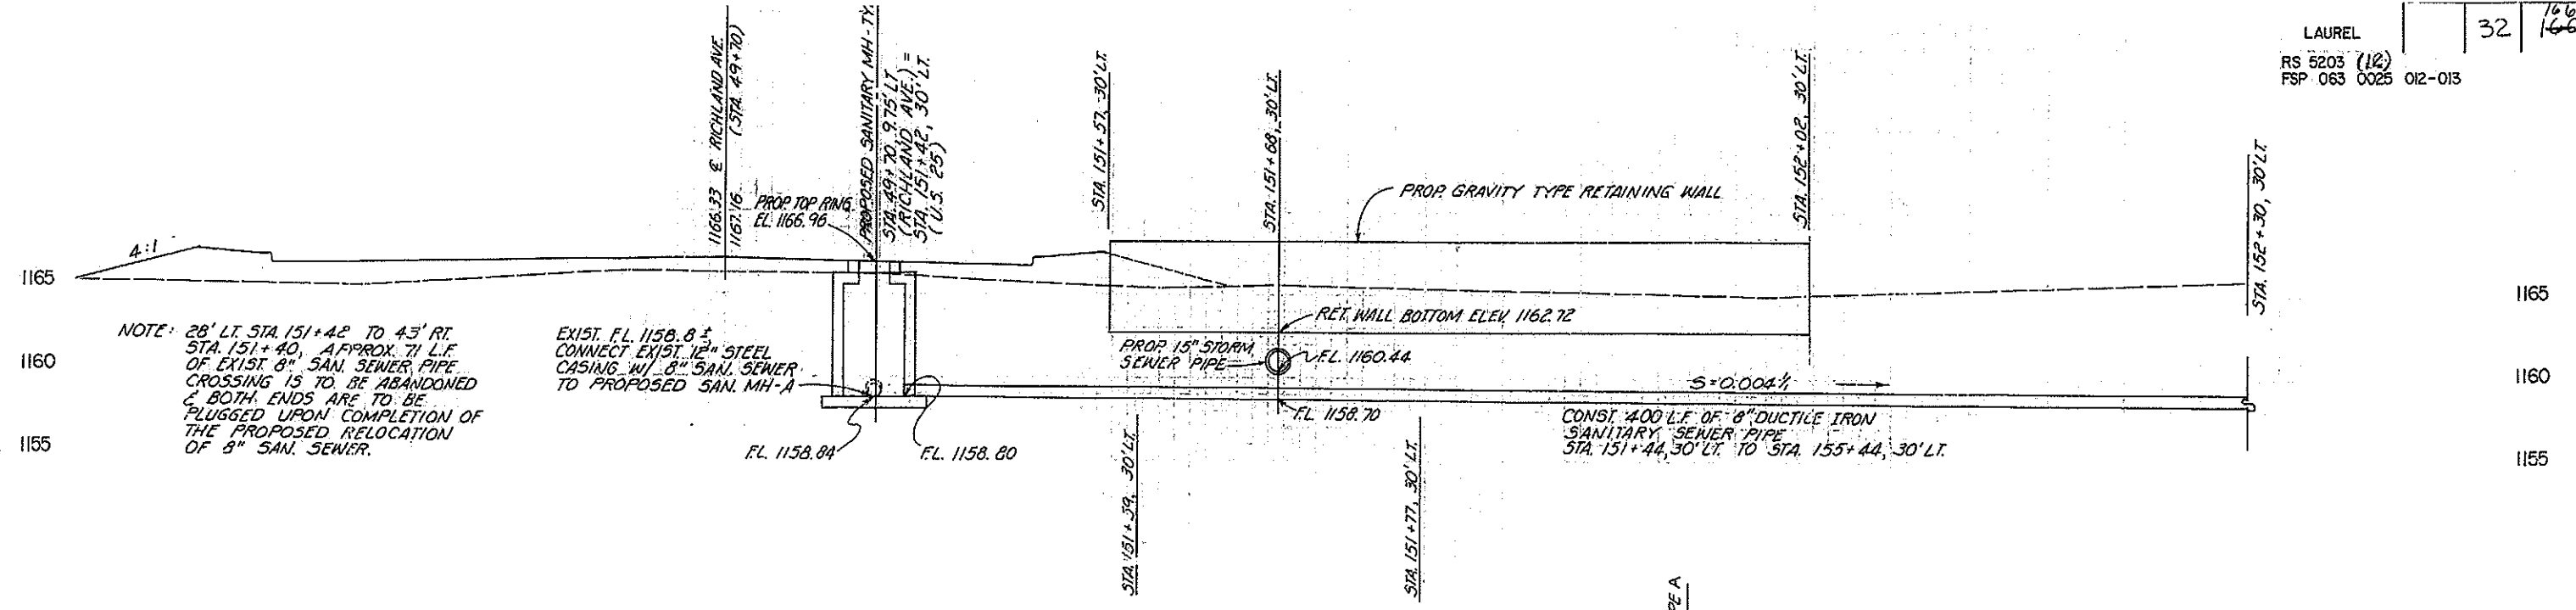

SANITARY SEWER PROFILES

SCALE: 1" = 5' HORIZ. & VERT.

STA. 151+42 TO STA. 155+46

46

COMMONWEALTH OF KENTUCKY
DEPARTMENT OF HIGHWAYS
PLAN AND PROFILE OF PROPOSED
STATE HIGHWAY
LAUREL COUNTY


SN-SP 63-III-4

SCALES
 PLAN 1 INCH = 100 FEET
 PROFILE 1/4 INCH = 10 FEET
 CROSS SECTION 1 INCH = 10 FEET

COUNTY OF	STATE DISTRICT NO.	SECTION NO.	PLAN YEAR	ENR. NO.	TOTAL SHEETS
LAUREL	63-III		1942	1	1

SUBSECTIONS OF CONTRACT
 LAUREL CO. SN-SP 63-III-4
 63-III-45A Surfacing, Sta. 70+72 to Sta. 184+00
 63-III-45B Surfacing, Sta. 383+47 to Sta. 0-3100

TYPICAL SECTION
 ROCK ASPHALT SEAL
 BITUMINOUS COATED CLASS F BINDER, TYPE A.

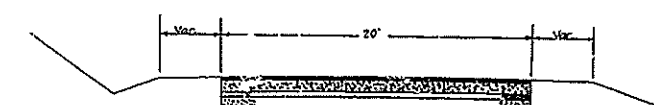

EXISTING: 1 1/2" Bituminous Mat. Waterbound Macadam Base, 6" depth.
 RECONSTRUCTION: Rock Asphalt Seal - Bituminous Coated Aggregate Class F Binder, Type A.

- Paint Coat [0.1 Gal. per sq. yd. Bituminous Material RC-2 for Paint Coat.
- 1/2" Binder [150 Lbs. per sq. yd. Bituminous Coated Aggregate Class F Binder Type A.
- 1/2" Seal [50 Lbs. per sq. yd. Rock Asphalt.

SURFACING QUANTITIES

PART	DESCRIPTION	UNIT	QUANTITIES
PART 1 - SN-SP 63-III - Sta. 70+72 to Sta. 184+00			
Roadway Excavation	Cu. Yd.	1700	
Bituminous Material RC-2 for Paint Coat	Gal.	2550	
Bituminous Coated Aggregate Class F Binder, Type A.	Ton	1920	
Rock Asphalt	Ton	640	
Final Dressing	100 Sls.	118	
Bit. Coated Agg. Class F Binder, Type A. (Alternate using slag)	Ton	1680	
PART 2 - SN-SP 63-III - Sta. 383+47 to Sta. 3100			
Roadway Excavation	Cu. Yd.	700	
Bituminous Material RC-2 for Paint Coat	Gal.	1660	
Bituminous Coated Aggregate Class F Binder, Type A.	Ton	1250	
Rock Asphalt	Ton	420	
Final Dressing	100 Sls.	73	
Bit. Coated Agg. Class F Binder, Type A. (Alternate using slag)	Ton	1100	
TOTAL PARTS 1 AND 2			
Roadway Excavation	Cu. Yd.	2000	
Bituminous Material RC-2 for Paint Coat	Gal.	4210	
Bituminous Coated Aggregate Class F Binder, Type A.	Ton	3170	
Rock Asphalt	Ton	1060	
Final Dressing	100 Sls.	187	
Bit. Coated Agg. Class F Binder, Type A. (Alternate using slag)	Ton	2780	

* Crushed limestone, slag or gravel mixed with Bituminous Material MC-5 or RT-10, in accordance with Special Specifications No. 32, may be used.
 NOTE: Where directed by the Engineer the Class F Material is to be placed so as to decrease the excessive crown in the existing surface. However in no case shall the compacted thickness be less than 3/4 inches.

GENERAL NOTES

All curves to be banked and widened according to Standards as directed. No payment will be allowed for Clearing and Grubbing.
 Half width construction will be required on this project, the Contractor keep the road open to traffic at all times.
 Contractor shall erect and maintain sufficient barricades and warning signs to protect and direct the traveling public, and shall supply a sufficient number of watchmen and flagmen to direct traffic and to protect that portion of the surface that is not ready to be opened to traffic.
 Contractor shall employ his operations so that at the end of each days work there will be remain no section of half width, unless as determined by the Engineer, conditions warrant a deviation from this rule.
 In order to prevent a traffic hazard the Bituminous Material for the paint coat shall be applied half width at a time.
 All surfacing material shall be spread and finished by an approved mechanical or self-propelled spreading and finishing machine operated on side forms or by an approved self-propelled, spreading leveling and finishing machine, operated without side forms, provided it will finish the surface to a uniform line, grade and cross section.
 Final Dressing will be confined within the shoulder lines on fills and to the back of ditches in cuts except where slopes have been disturbed by yield excavation material.
 The Standard Specifications for State and Federal Road and Bridge Construction, with the following Amendments and Deviations will apply on this project:

Booklet No. 1, Amendments and Revisions
 Special Provisions for Asphalt Mixing Plants.
 Special Specifications No. 32 for Bituminous Coated Aggregate Class F.



FOR SURFACING

	LINE FT.	SQ. YDS.	MILES
PART 1 - SN-SP 63-III - Sta. 70+72 to Sta. 184+00			
GROSS LENGTH	11,354.4		2.150
26.4' Added for			
NET LENGTH	11,354.4		2.150
Added for Curve Widening		269	
Total Surfacing Part 1		25,500	
PART 2 - SN-SP 63-III - Sta. 383+47 to Sta. 3100			
GROSS LENGTH	7,466		1.414
NET LENGTH	7,349		1.391
17' Deducted for Bridge			
Added for Curve Widening		269	
Total Surfacing Part 2		16,600	
TOTAL PARTS 1 AND 2			
GROSS LENGTH	18,820.4		3.564
26.4' Added for Equalities			
NET LENGTH	18,703.4		3.542
17' Deducted for Bridge			
Added for Curve Widening		537	
TOTAL SURFACING PARTS 1 AND 2		42,100	

Note: Distances in feet as shown above are chained measurements.

INDEX OF SHEETS

NO.	DESCRIPTION
LAYOUT SHEET	TYPICAL SECTIONS - SUMMARY OF QUANTITIES
PLAN AND PROFILE SHEETS	DETAIL SHEETS
REFERENCE SHEETS	CROSS SECTION SHEETS
DRAINAGE SHEETS	BRIDGE SHEETS

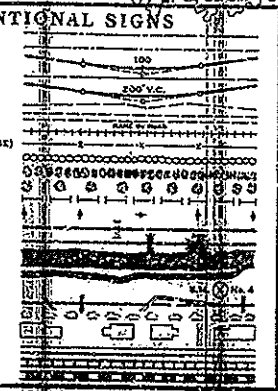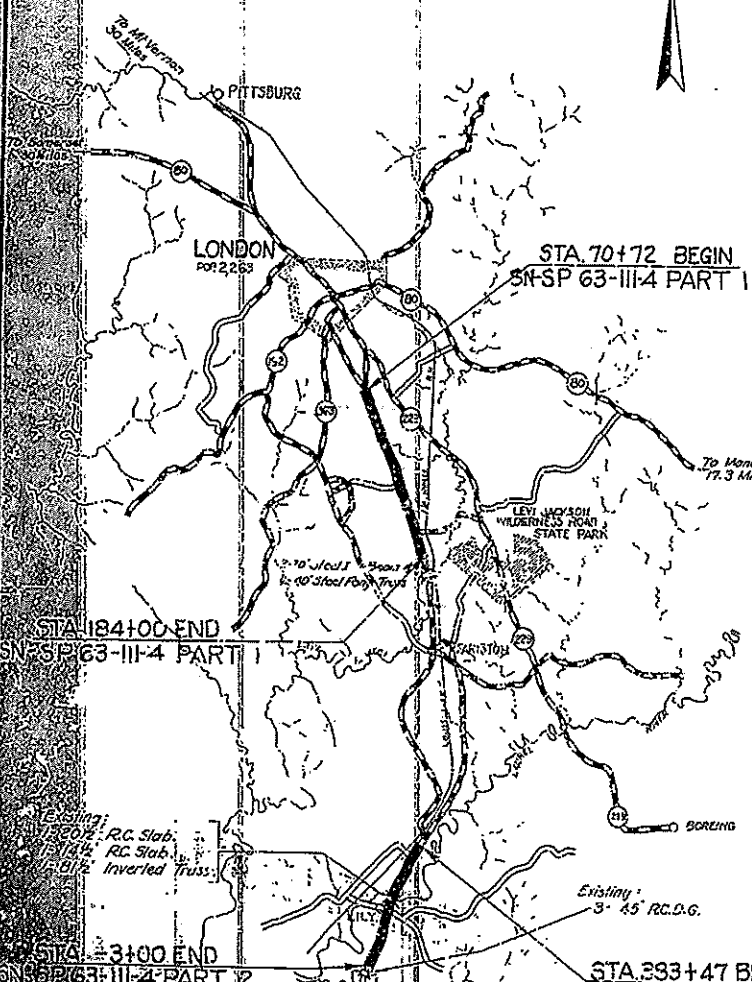

LAYOUT MAP

SCALE 1 INCH = 5200 FEET

PART 1		PART 2		TOTAL	
GROSS LENGTH	11,354.4	7,466	18,820.4		
FOR EQUALITIES	26.4				
NET LENGTH	11,354.4	7,349	18,703.4		
FOR EQUALITIES					
NOT INCLUDED					

KENTUCKY DEPARTMENT OF HIGHWAYS
 COUNTY OF **LAUREL**
LONDON - CORBIN ROAD
 STATE PROJECT SECTION DATE
 No. 63-III 1942

SURVEYED BY: [Signature]
 PLANS CHECKED BY: [Signature]
 SURVEY AND PLANS APPROVED BY: [Signature]
 SURVEY AND PLANS APPROVED BY: [Signature]

RECOMMENDED FOR APPROVAL

APPROVED BY: [Signature]

APPROVED BY: [Signature]

63-III-4

COMMONWEALTH OF KENTUCKY
DEPARTMENT OF HIGHWAYS


OF	YEAR	SHEET NO.	TOTAL SHEETS
LAUREL		1	207

PLANS OF
PROPOSED PROJECT
LAUREL COUNTY
US 25

STPR 5203 (18)

GRADE, L.AIN, AND SURFACE PLANS

END CONSTRUCTION
US 25
STA. 88 + 80.00
STPR 5203 (18)

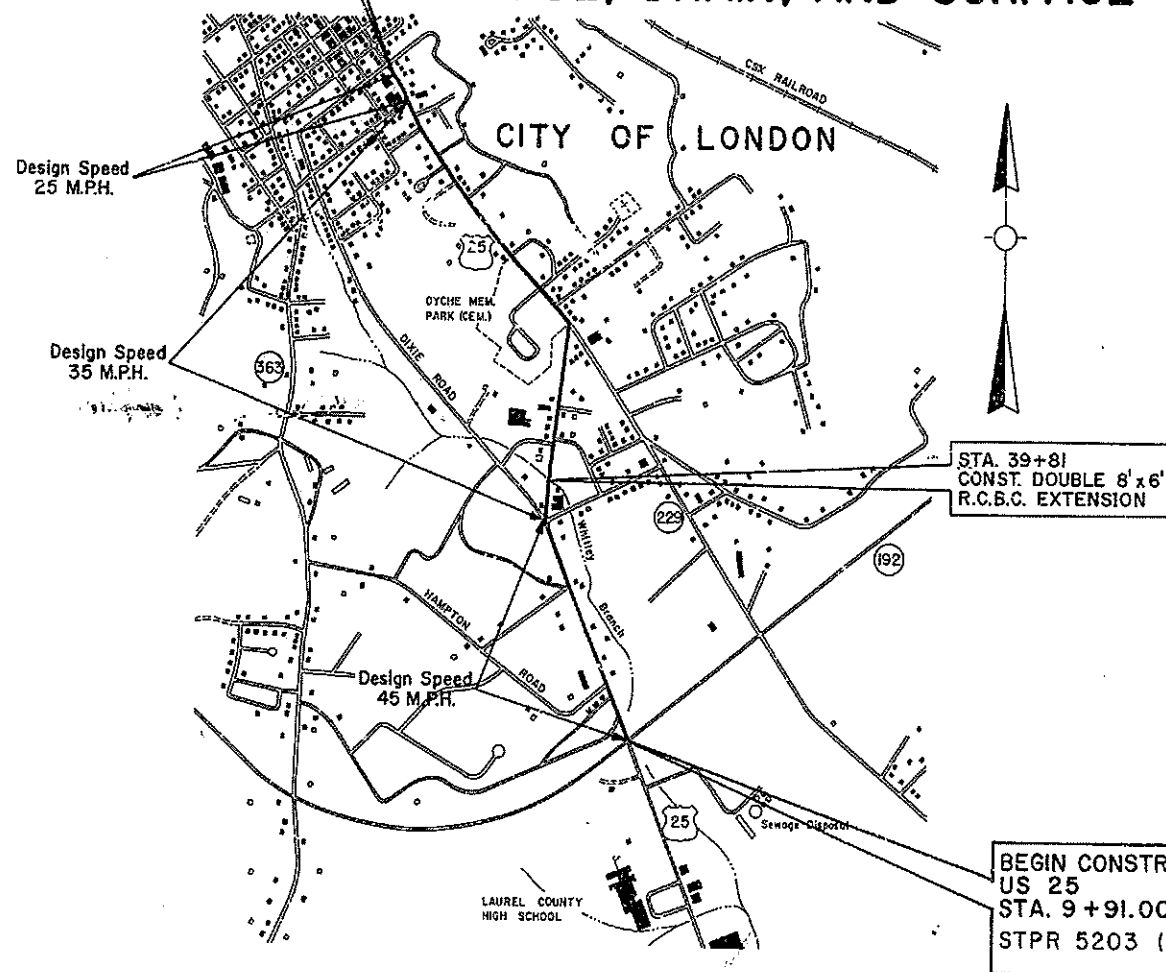

STA. 39+81
CONST. DOUBLE 8'x6'
R.C.B.C. EXTENSION

BEGIN CONSTRUCTION
US 25
STA. 9 + 91.00
STPR 5203 (18)

AS BUILT PLANS
Dexter Nauman
9-14-99

STA. 9+91 TO STA. 14+74.25 IS A PARTIALLY CONTROLLED ACCESS HIGHWAY. ACCESS SHALL BE PROVIDED ONLY WHERE SPECIFICALLY INDICATED ON PLANS. STA. 14+74.25 TO STA. 88+20.00 THE CONTROL OF ACCESS SHALL BE BY PERMIT.

SHEET NO.	DESCRIPTION
1	LAYOUT SHEET
2-2m	TYPICAL SECTIONS-SUMMARY OF QUANTITIES
3-40	PLAN AND PROFILE SHEETS
40a-64	UTILITY PLAN SHEETS
65-67	RIGHT OF WAY SUMMARY SHEETS
68-70	RIGHT OF WAY STRIP MAP SHEETS
71-71u	DETAIL SHEETS (M.O.T.)
72	REFERENCE SHEETS
73-79	SOIL PROFILE SHEETS
80-103	PIPE DRAINAGE SHEETS
104-207	CROSS SECTION SHEETS

SHEETS NOT INCLUDED IN TOTAL SHEETS
2a-2m, 71a-71u, 40a-40y
TOTAL BRIDGE SHEETS 11

STANDARD DRAWINGS

NUMBER		
RBI - 001 - 06	RDB - 430 - 03	RGX - 020 - 09
RBR - 001 - 09		RGX - 030 - 05
RBR - 005 - 08	RDI - 001 - 04	RPM - 100 - 06
RBR - 010 - 03		RPM - 150 - 03
RBR - 015 - 03	RDI - 020 - 05	
	RDI - 025 - 01	RPM - 160 - 01
RDB - 001 - 09	RDM - 001 - 04	RPM - 170 - 03
RDB - 003 - 05	RDM - 010 - 03	RDX - 160 - 04
RDB - 011 - 06	RDM - 011 - 02	TSC - 400 - 02
RDB - 012 - 06	RDM - 012 - 01	
RDB - 270 - 04	RDM - 013 - 01	
RDB - 271 - 03	RDM - 100 - 01	
RDB - 272 - 04	RDX - 005 - 01	
RDB - 273 - 03	RDX - 200 - 01	
RDB - 400 - 02	RGX - 001 - 03	
RDB - 410 - 03	RGX - 002 - 06	TSC - 300 - 05
RDB - 420 - 02	RGX - 005 - 03	TSC - 320 - 04
RDH - 110 - 01	RGX - 010 - 02	RDP - 005 - 03
RDH - 120 - 01	RDH - 310 - 02	RDP - 006 - 02
RDH - 210 - 01	RDH - 340 - 02	RDP - 051 - 01
RDH - 216 - 01	RDP - 001 - 04	TOTAL STD. DRWGS. - 52

NO. SETS	DATE

REVIEW BY
DIVISION OF CONSTRUCTION

PLANS CHECKED BY
FINAL CHECK BY

DESIGN CRITERIA

CLASS OF HIGHWAY URBAN ARTERIAL
TYPE OF TERRAIN ROLLING
DESIGN SPEED 25, 35, 45 MPH
REQUIRED NPSD (25 MPH) 50', (35 MPH) 225', (45 MPH) 325'
REQUIRED PSD N/A
LEVEL OF SERVICE _____
ADT PRESENT (1992) 17,100 VPD
ADT FUTURE (2016) 23,000 VPD
DHV 2,300 VPH
D % N/A
T % 3% ADT 2% DHV

GEOGRAPHIC COORDINATES

LATITUDE 37 DEGREES 07 MINUTES NORTH
LONGITUDE 84 DEGREES 04 MINUTES WEST

DESIGNED

% RESTRICTED SD N/R
LEVEL OF SERVICE N/R
MAX. DISTANCE W/O PASSING N/A


GROSS LENGTH	LN. FT.	MILES	GROSS LENGTH	LN. FT.	MILES	GROSS LENGTH	LN. FT.	MILES	GROSS LENGTH	LN. FT.	MILES
7889.00	1,494										
ADDED FOR EQUALITIES	N/A										
DEDUCTED FOR EQUALITIES											
NET LENGTH	7889.00	1,494									
RAILROAD CROSSINGS NO. NOT INCLUDED			RAILROAD CROSSINGS NO. NOT INCLUDED			RAILROAD CROSSINGS NO. NOT INCLUDED			RAILROAD CROSSINGS NO. NOT INCLUDED		
BRIDGES			BRIDGES			BRIDGES			BRIDGES		

KENTUCKY
DEPARTMENT OF HIGHWAYS
LAUREL COUNTY COUNTY

US 25

PROJECT FD45 063 0025 010 - 013 C
NUMBER: STPR 5203 (18)
LETTING DATE: 5-21-96

DESIGNED BY Dec 13 1995 by Daniel J. Newell ASST. DIS. ENGINEER FOR PRE-CONSTRUCTION
APPROVED March 26 1996 by Daniel J. Newell DIRECTOR OF TRAFFIC
PLAN CHECKED 4/26/96 by Glenn C. Dockery CHIEF DESIGNER
PLAN APPROVED 4/26 1996 by John B. Sacksteder DIRECTOR OF DESIGN
PLAN APPROVED 5-26-96 by J. M. Yaworski STATE HIGHWAY ENGINEER

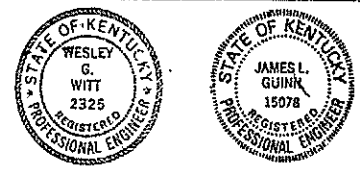

BRIDGE AND CULVERT SUMMARY

COUNTY OF	FISCAL YEAR	SHEET NO.	TOTAL SHEETS
LAUREL		21	207

STEP 5203 (18)

DIVISION OF BRIDGES ESTIMATE AND PROJECT SUMMARY
KENTUCKY DEPARTMENT OF HIGHWAYS

SHEET 1

COUNTY LAUREL	STATE PROJECT NO. F025 063 0025 Y 010-013 0410	COMPLETED DATE
ROAD KY192 TO FIRST STREET	FEDERAL PROJECT NO. 000RS 05203 015	DI REVISION DATE
SPECIAL DRAWINGS 23654/6SH, 23655/4SH		
STANDARD DRAWINGS BGX-006-06/1SH		

DRAWING NUMBER	23654	23655	
STATION ON PROJECT ROUTE	39+81.00*	*****	TOTAL PLAN SHEETS 11
STATION ON CROSSING ROUTE		56+08.00	

DESCRIPTION OF STRUCTURE

	CULVERT	CULVERT	
TOTAL LENGTH	E 41.0	E 20.0	
NO. OF BARRELS	DOUBLE	SINGLE	
SKEW	31.0 RIGHT	02.0 LEFT	
TYPE & SIZE	RCBC 08X06	RCBC 05X04	
INLET LENGTH	24.0 22.0		
INLET ELEV.	1156.5		
OUTLET LENGTH	17.0	20.0 15.21	
OUTLET ELEV.	1156.3	1169.2	
DEPTH OF COVER	4.2	4.5	
FOUNDATION	ROCK	ROCK	

QUANTITIES

CODE UNIT	DESCRIPTION			TOTALS FOR PROJECT
8100 C. Y.	CONCRETE-CLASS A	108.4	23.9	
8150 LBS.	STEEL REINFORCEMENT	10534.	1457.	132.3
8001 C. Y.	STRUCTURE EXCAVATION-COMMON	80.	30.	11991.
8002 C. Y.	STRUCTURE EXCAV-SOLID ROCK	30.		110.
2403 C. Y.	REMOVING CONCRETE MASONRY	25.	10.	30.
				35.

NOTES AND SPECIAL PROVISIONS
SPECIAL PROVISIONS(94)

BRIDGE AND CULVERT QUANTITIES ARE NOT INCLUDED IN THE GENERAL SUMMARY.

SHEET NO.	DESCRIPTION
1	LAYOUT SHEET
2	TYPICAL SECTIONS—SUMMARY OF QUANTITIES
	LIST OF STANDARD DRAWINGS
3.11	CURVE WIDENING SUPER ELEVATION, ROCK SECTIONS
3.12	STANDARD STRUCTURES
3.16	PRIVATE ENT. & ROAD INTERSECTIONS

G-15 PLAN AND PROFILE SHEETS (PRA ONLY)


COMMONWEALTH OF KENTUCKY DEPARTMENT OF HIGHWAYS

PLAN AND PROFILE OF PROPOSED STATE HIGHWAY

LAUREL COUNTY
S 150 (4)

S 150 (4)			
FED. ROAD DIST. NO.	STATE	FISCAL YEAR	SHEET NO.
7	KY	1952	1

SUBSECTION OF CONTRACT
FOR
LAUREL COUNTY
S 150 (4) SP 63-91-4
G3-91-43A Surface from Sta. 29+00 to Sta. 107+24

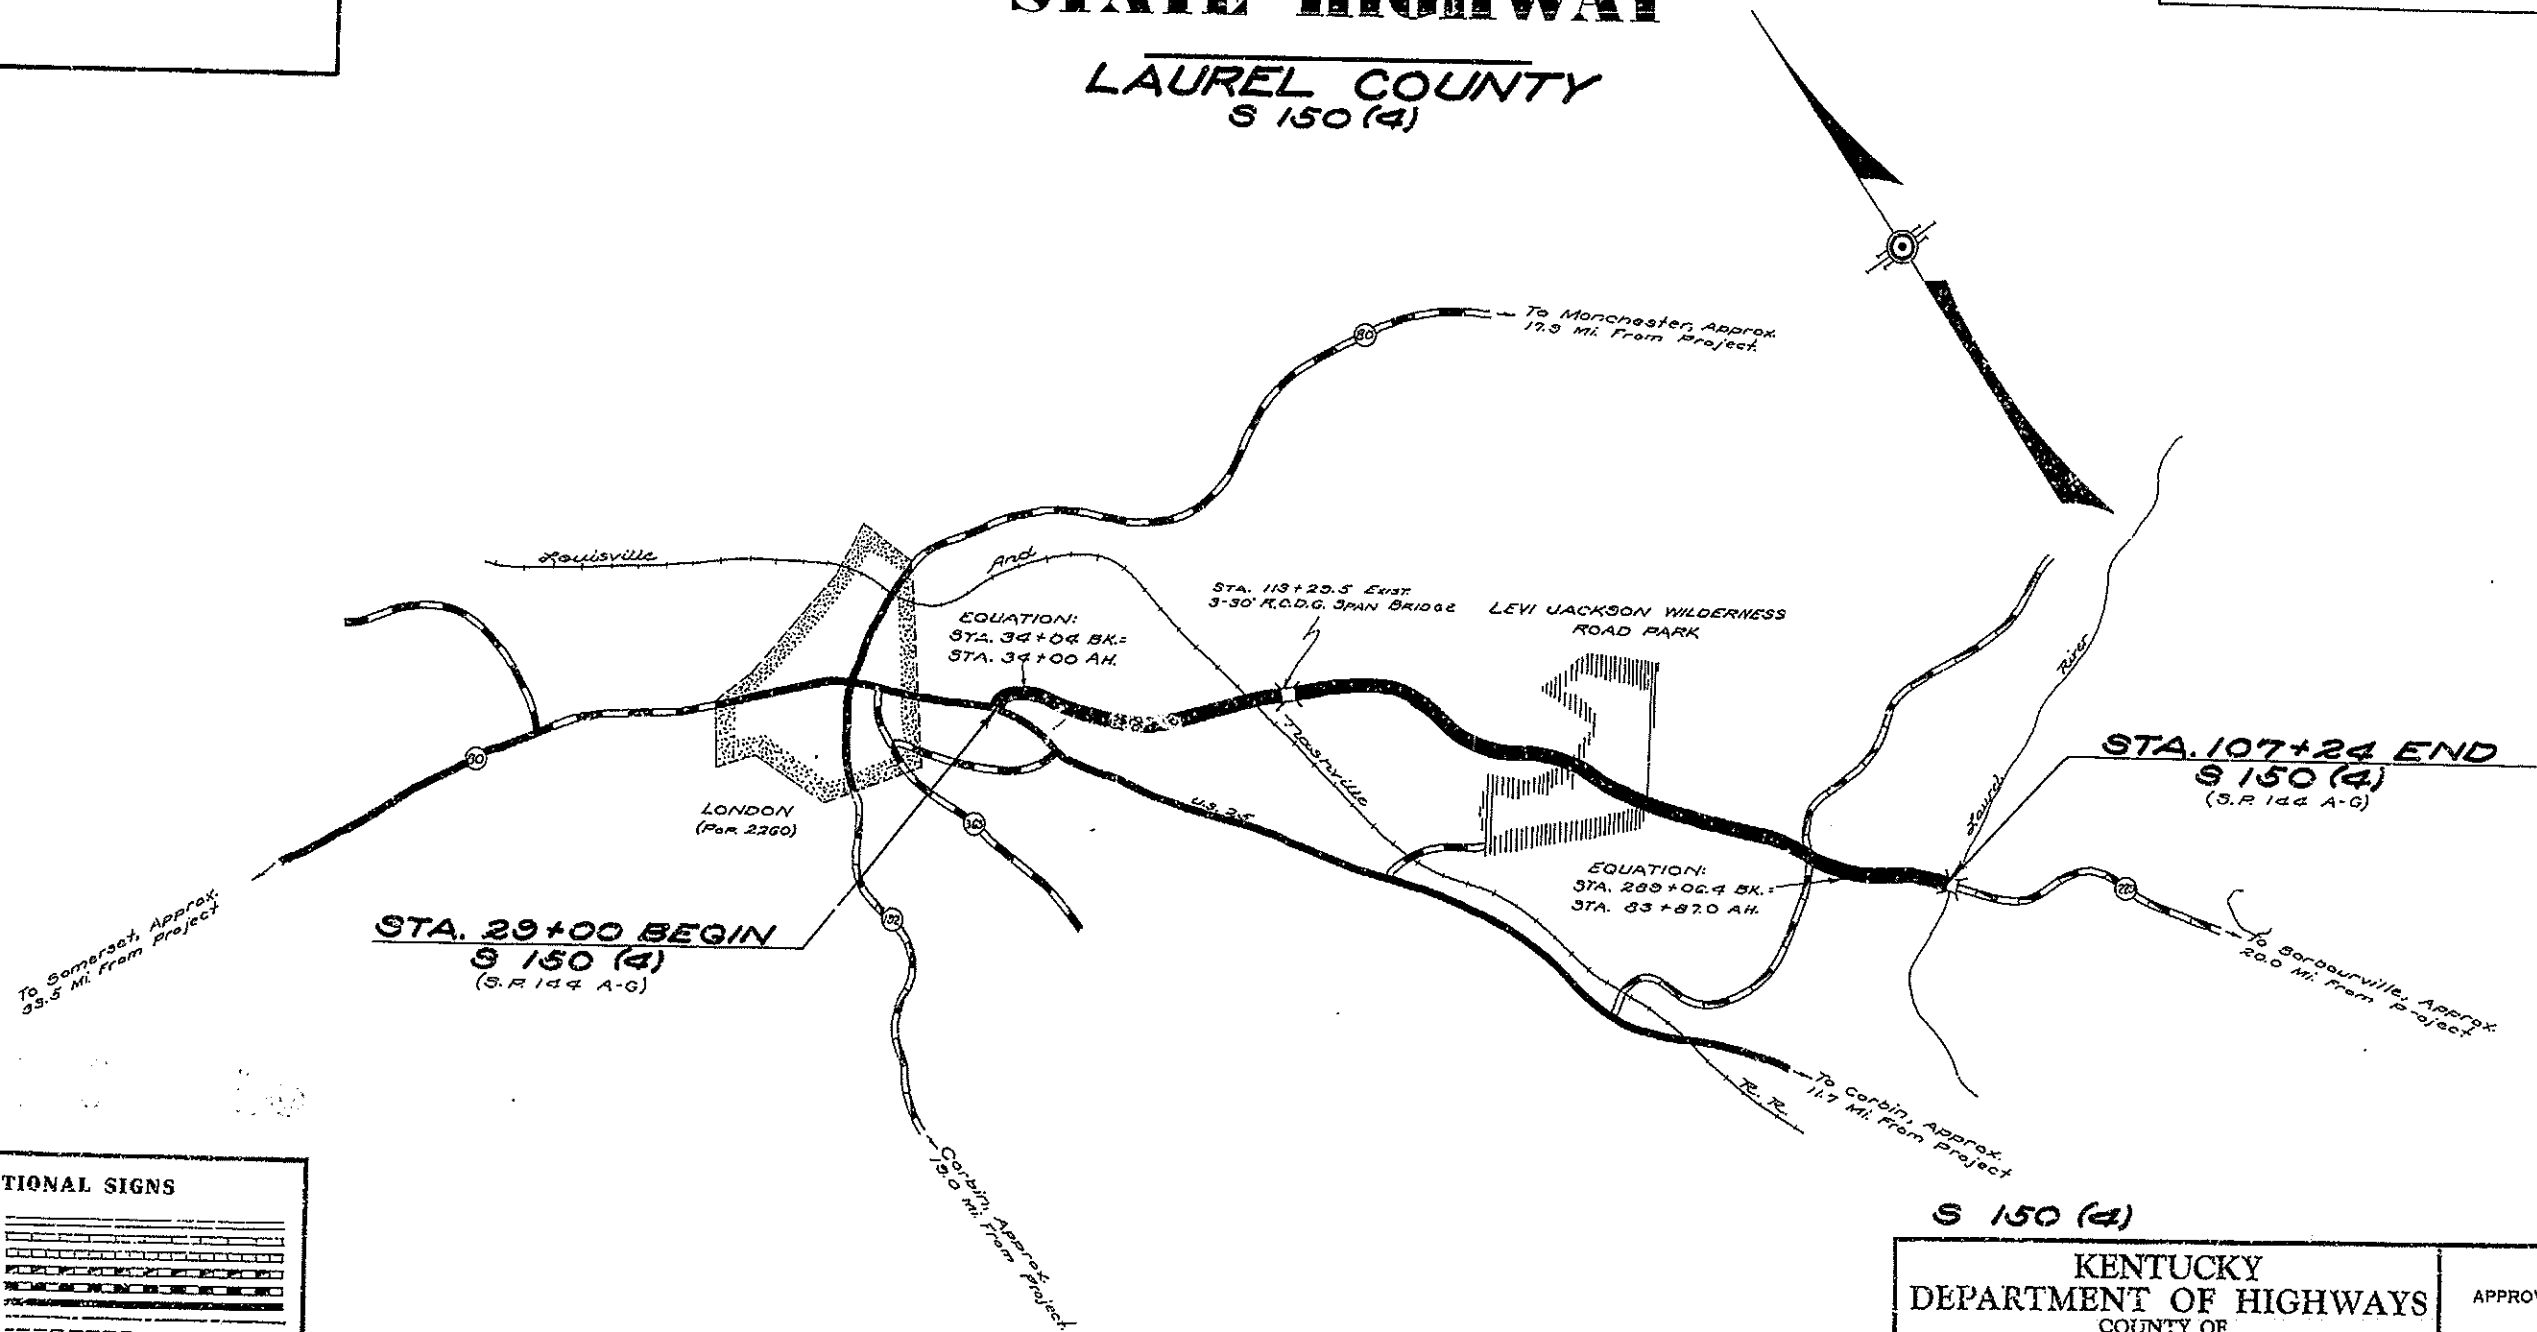

STA. 29+00 BEGIN
S 150 (4)
(S.R. 144 A-G)

STA. 107+24 END
S 150 (4)
(S.R. 144 A-G)

GRAPHIC SCALE IN Miles

LAYOUT MAP

GROSS LENGTH		NET LENGTH		GROSS LENGTH		NET LENGTH		GROSS LENGTH		NET LENGTH	
ADD. DEDUCTED	FOR EQUALITIES	ADD. DEDUCTED	FOR EQUALITIES	ADD. DEDUCTED	FOR EQUALITIES	ADD. DEDUCTED	FOR EQUALITIES	ADD. DEDUCTED	FOR EQUALITIES	ADD. DEDUCTED	FOR EQUALITIES
28347.4	5.368	28224.9	5.345	28347.4	5.368	28224.9	5.345	28347.4	5.368	28224.9	5.345
MILES		MILES		MILES		MILES		MILES		MILES	

CONVENTIONAL SIGNS

UNIMPROVED ROAD	
GRADE AND DRAINED ROAD	
SOIL SURFACE ROAD	
METAL SURFACED ROAD	
LOW TYPE BITUMINOUS ROAD	
PAVED ROAD	
COUNTY LINE	
CORPORATE LIMITS	
SURVEY LINE	
PROPOSED RIGHT OF WAY	
GRADE LINE	
GROUND LINE	
TRAVELED WAY	
RAILROAD	
FENCES (EXCEPT STONE & HEDGE)	
STONE FENCE	
HEDGE FENCE	
TREES & STUMPS	
PIPE LINE	
TELEPHONE POLES	
PIPE CULVERT	
CONCRETE CULVERT & BRIDGE	
LARGE STREAM	
SMALL STREAM	
DITCH MARKS	
ROAD INTERSECTIONS	
MARSH	
BUILDINGS	

LETTING DATE 8-1-52

S 150 (4)

KENTUCKY
DEPARTMENT OF HIGHWAYS
COUNTY OF
LAUREL
LONDON-BARBORVILLE
ROAD

STATE PROJECT No. 63-91-4 DATE 1952

APPROVED 6/27 1952

BY: W. C. Cudline COMMISSIONER OF HIGHWAYS

DEPARTMENT OF COMMERCE
BUREAU OF PUBLIC ROADS

RECOMMENDED FOR APPROVAL:

DISTRICT ENGINEER DATE

APPROVED:

SURVEYED BY _____ CHIEF OF PARTY

SURVEY APPROVED BY C. J. Fuller CHIEF LOCATING ENGINEER

PLAN CHECKED 6/25 1952 by W. L. Riley CHIEF DRAFTSMAN

SURVEY AND PLAN APPROVED BY 6/27 1952 by W. A. Johnson DIRECTOR OF DESIGN

SURVEY AND PLAN APPROVED BY 6/27 1952 by W. A. Brown

RECORD PLANS
CONSTRUCTION PLANS
REVIEWED BY
DIVISION OF CONSTRUCTION
PLANS TRACED BY
PLANS COMPLETED BY
PLANS CHECKED BY
FINAL CHECK BY


TYPICAL SECTION AND SUMMARY SHEET

S 150 (A)				
FED. ROAD DIST. NO.	STATE	FISCAL YEAR	SECT. NO.	TOTAL SHEETS
7	KY.	1952	2	13

LAUREL COUNTY
London - Barbourville Road.

BITUMINOUS CONCRETE SURFACE, CLASS I - WITH -

TYPICAL SECTION

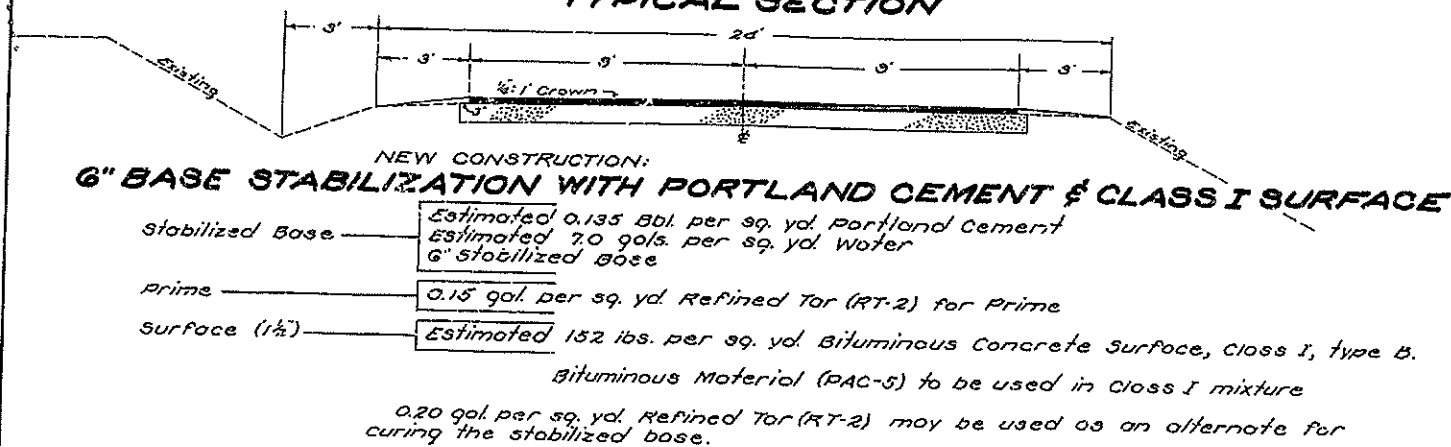


FOR SURFACING

STA. 29+00 to STA. 107+24	LIN. FT.	SQ. YDS.	MILES
GROSS LENGTH (20523.4' Added for Equalities)	28347.4		5.368
NET LENGTH (95.0' deduct. Bridge) (24' deduct. for R.R. Crossing)	28224.4		5.345
CURVE WIDENING AND APPROACH		762	
TOTAL SURFACING		57403.18' 58982.185'	

ITEM	UNIT	QUANTITY
BASE STABILIZATION		
Portland Cement	Bbl.	7965
Water	100 Gal.	4130
6" Stabilized Base	Sq. Yd.	58982
Refined Tar (RT-2) for Prime	Gal.	8850
Bituminous Concrete Surface, Type B	Ton	4363
Final Dressing	100 Sta.	283
Project Monuments	Each	2
OR - WATERBOUND MACADAM BASE		
Crushed Limestone, Size No. 2	Ton	9830
Crushed Limestone, Size No. 5	Ton	2810
Crushed Limestone, Size No. 10	Ton	4355
Refined Tar (RT-2) for Prime	Gal.	14745
Bituminous Concrete Surface, Type B	Ton	4363
Final Dressing	100 Sta.	283
Project Monuments	Each	2

-OR- TYPICAL SECTION

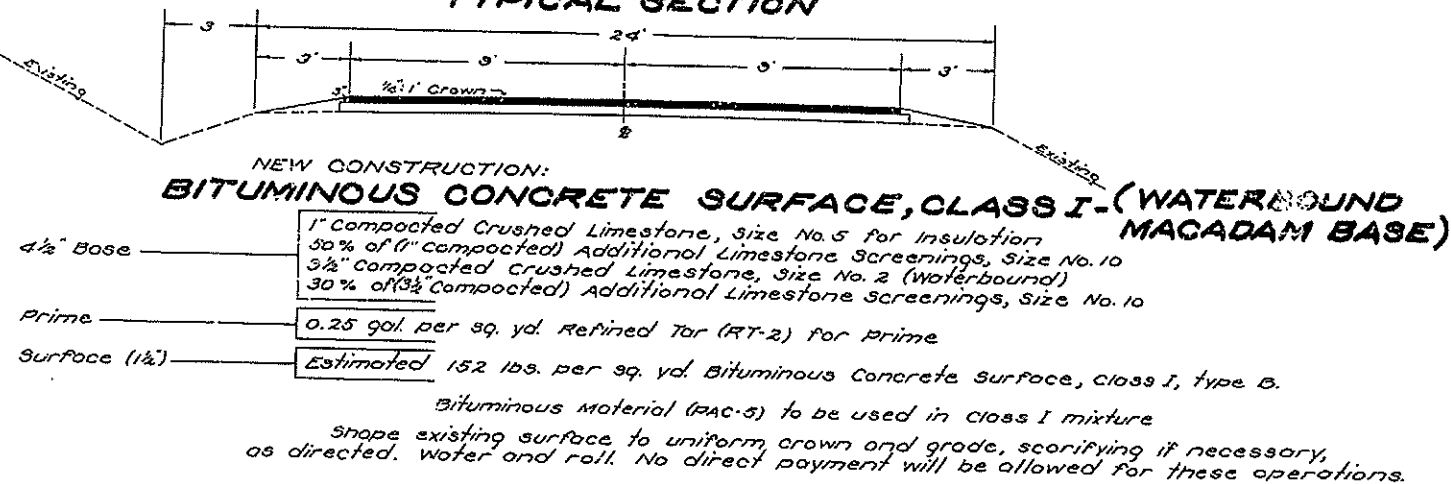

GENERAL NOTES

All curves to be banked and widened according to Standards or as directed. Superelevation for special cases to be authorized by the District Engineer.

Drawings for Standard Warning Signs will be furnished by the District Engineer.

Final Dressing will be confined to the bottom of ditches in cuts and shoulder lines on fills, and back slopes where they have been disturbed to yield excavation. It shall include pulling ditches to a maximum depth of one (1) foot below the shoulder line, furnishing material and construction of shoulders to the proposed Typical Section. If sufficient shoulder material is not obtained by pulling ditches, it may be obtained from back slopes within the Right-of-Way limits which are not already adequately protected against erosion, or the contractor may obtain shoulder material outside the Right-of-Way limits at sites selected by him at no additional expense to the Department. No payment will be allowed for overhaul on shoulder material. The unit price bid per 100' sta. for Final Dressing shall include furnishing all shoulder material, labor and equipment necessary for the work described.

The Standard Specifications for State and Federal Road and Bridge Construction, edition of 1945, as amended by the amendments published in Pamphlet No. 2 of Approved Provisions, Specifications and Amendments, with the following Amendments, Provisions and Special Specifications, will apply on this project:

- Amendment No. 30: Process Agent
- Amendment No. 31: Tar
- Amendment No. 25-R: Bituminous Concrete Surface, Class I
- Emergency Provision No. 13: Deferment or Cancellation


Necessary seeding and sodding for erosion control will be done after completion of this project.

The road may be closed to through traffic.

APPENDIX F



MAP SCALE 1" = 1000'

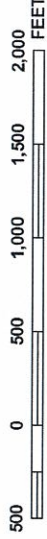

LEGEND

SPECIAL FLOOD HAZARD AREAS (SFHAS) SUBJECT TO INUNDATION BY THE 1% ANNUAL CHANCE FLOOD



The 1% annual chance flood (100-year flood), also known as the base flood, is the flood that has a 1% chance of being equaled or exceeded in any given year. The Special Flood Hazard Area is the area subject to flooding by the 1% annual chance flood. Areas of Special Flood Hazard include Zones A, AE, AH, AO, AR, A99, V, and VE. The Base Flood Elevation is the water-surface elevation of the 1% annual chance flood.

ZONE A No Base Flood Elevation determined.

ZONE AE Base Flood Elevations determined.

ZONE AH Flood depths of 1 to 3 feet (usually areas of ponding); Base Flood Elevations determined.

ZONE AO Flood depths of 1 to 3 feet (usually sheet flow on sloping terrain); average depths determined. For areas of alluvial fan flooding, velocities also determined.

ZONE AR Area of special flood hazard formerly protected from the 1% annual chance flood event by a flood control system that was subsequently decertified. Zone AR indicates that the former flood control system is being restored to provide protection from the 1% annual chance of greater flood event.

ZONE A99 Areas to be protected from 1% annual chance flood event by a Federal flood protection system under construction; no Base Flood Elevations determined.

ZONE V Coastal flood zone with velocity hazard (wave action); no Base Flood Elevations determined.

ZONE VE Coastal flood zone with velocity hazard (wave action); Base Flood Elevations determined.

FLOODWAY AREAS IN ZONE AE



The floodway is the channel of a stream plus any adjacent floodplain areas that must be kept free of encroachment so that the 1% annual chance flood can be carried without substantial increases in flood heights.

OTHER FLOOD AREAS



ZONE X Areas of 0.2% annual chance flood; areas of 1% annual chance flood with average depths of less than 1 foot or with drainage areas less than 1 square mile; and areas protected by levees from 1% annual chance flood.

OTHER AREAS



ZONE X Areas determined to be outside the 0.2% annual chance floodplain.

NFIP

PANEL 0230C

FIRM

FLOOD INSURANCE RATE MAP
LAUREL COUNTY
KENTUCKY
AND INCORPORATED AREAS

PANEL 230 OF 400

(SEE MAP INDEX FOR FIRM PANEL LAYOUT)

CONTAINS:

COMMUNITY	NUMBER	PANEL	SUFFIX
LAUREL COUNTY	210134	0230	C
LONDON CITY OF	210396	0230	C

Notice to Users: The Map Number shown below should be used when checking maps for updates. The Map Number should be used on insurance applications for the subject community.



MAP NUMBER
21125C0230C

EFFECTIVE DATE
AUGUST 2, 2006


Federal Emergency Management Agency

This is an official copy of a portion of the above referenced flood map. It was extracted using F-MIT On-Line. This map does not reflect changes or amendments which may have been made subsequent to the date on the title block. For the latest product information about National Flood Insurance Program flood maps check the FEMA Flood Map Store at www.msc.fema.gov

Insurance Program at 1-800-638-6620.



MAP SCALE 1" = 1000'

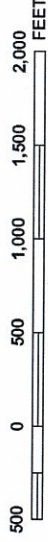

NFIP
NATIONAL FLOOD INSURANCE PROGRAM

PANEL 0230C

FIRM
FLOOD INSURANCE RATE MAP
LAUREL COUNTY
KENTUCKY
AND INCORPORATED AREAS

PANEL 230 OF 400

(SEE MAP INDEX FOR FIRM PANEL LAYOUT)

CONTAINS:

COMMUNITY	NUMBER	PANEL	SUFFIX
LAUREL COUNTY	210134	0230	C
LONDON CITY OF	210396	0230	C

Notice to User: The Map Number shown below should be used when placing map orders; the Community Number shown above should be used on insurance applications for the subject community.



MAP NUMBER
21125C0230C

EFFECTIVE DATE
AUGUST 2, 2006

Federal Emergency Management Agency

This is an official copy of a portion of the above referenced flood map. It was extracted using F-MIT On-Line. This map does not reflect changes or amendments which may have been made subsequent to the date on the title block. For the latest product information about National Flood Insurance Program flood maps check the FEMA Flood Map Store at www.msc.fema.gov

OTHER AREAS

- ZONE X**
Areas determined to be outside the 0.2% annual chance floodplain.
- ZONE D**
Areas in which flood hazards are undetermined, but possible.

COASTAL BARRIER RESOURCES SYSTEM (CBRS) AREAS

OTHERWISE PROTECTED AREAS (OPAs)


CBRS and OPAs are normally located within or adjacent to Special Flood Hazard Areas.

- 1% annual chance floodplain boundary
- 0.2% annual chance floodplain boundary
- Floodway boundary
- Zone D boundary
- CBRS and OPA boundary

Boundary dividing Special Flood Hazard Areas of different Base Flood Elevations, flood depths or flood velocities.

Base Flood Elevation line and value; elevation in feet*
 Base Flood Elevation value where uniform within zone; elevation in feet*

* Referenced to the North American Vertical Datum of 1988 (NAVD 88)

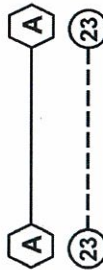

97°07'30", 32°22'30"

4275000mE

6000000 FT

DX5510_X

● M1.5

Geographic coordinates referenced to the North American Datum of 1983 (NAD 83), Western Hemisphere

1000-meter Universal Transverse Mercator grid ticks, zone 16
 5000-foot grid values: Kentucky State Plane coordinate system, South Zone (FIPZONE = 1602), Lambert projection
 Bench mark (see explanation in Notes to Users section of this FIRM panel)

River Mile
 MAP REPOSITORIES
 Refer to Map Repositories list on Map Index


EFFECTIVE DATE OF COUNTYWIDE
 FLOOD INSURANCE RATE MAP
 AUGUST 2, 2006

EFFECTIVE DATE(S) OF REVISION(S) TO THIS PANEL

Insurance Program at 1-800-638-6620.



MAP SCALE 1" = 1000'

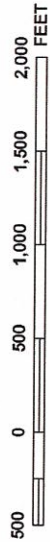

NFIP NATIONAL FLOOD INSURANCE PROGRAM

PANEL 0230C

FIRM FLOOD INSURANCE RATE MAP LAUREL COUNTY KENTUCKY AND INCORPORATED AREAS

PANEL 230 OF 400

(SEE MAP INDEX FOR FIRM PANEL LAYOUT)

CONTAINS:

COMMUNITY	NUMBER	PANEL	SUFFIX
LAUREL COUNTY	210194	0230	C
LONDON CITY OF	210396	0230	C


Notice to User: The Map Number shown below should be used when placing map orders; the Community Number shown above should be used on insurance applications for the subject community.

MAP NUMBER
21125C0230C
EFFECTIVE DATE
AUGUST 2, 2006



Federal Emergency Management Agency

This is an official copy of a portion of the above referenced flood map. It was extracted using F-MIT On-Line. This map does not reflect changes or amendments which may have been made subsequent to the date on the title block. For the latest product information about National Flood Insurance Program flood maps check the FEMA Flood Map Store at www.msc.fema.gov

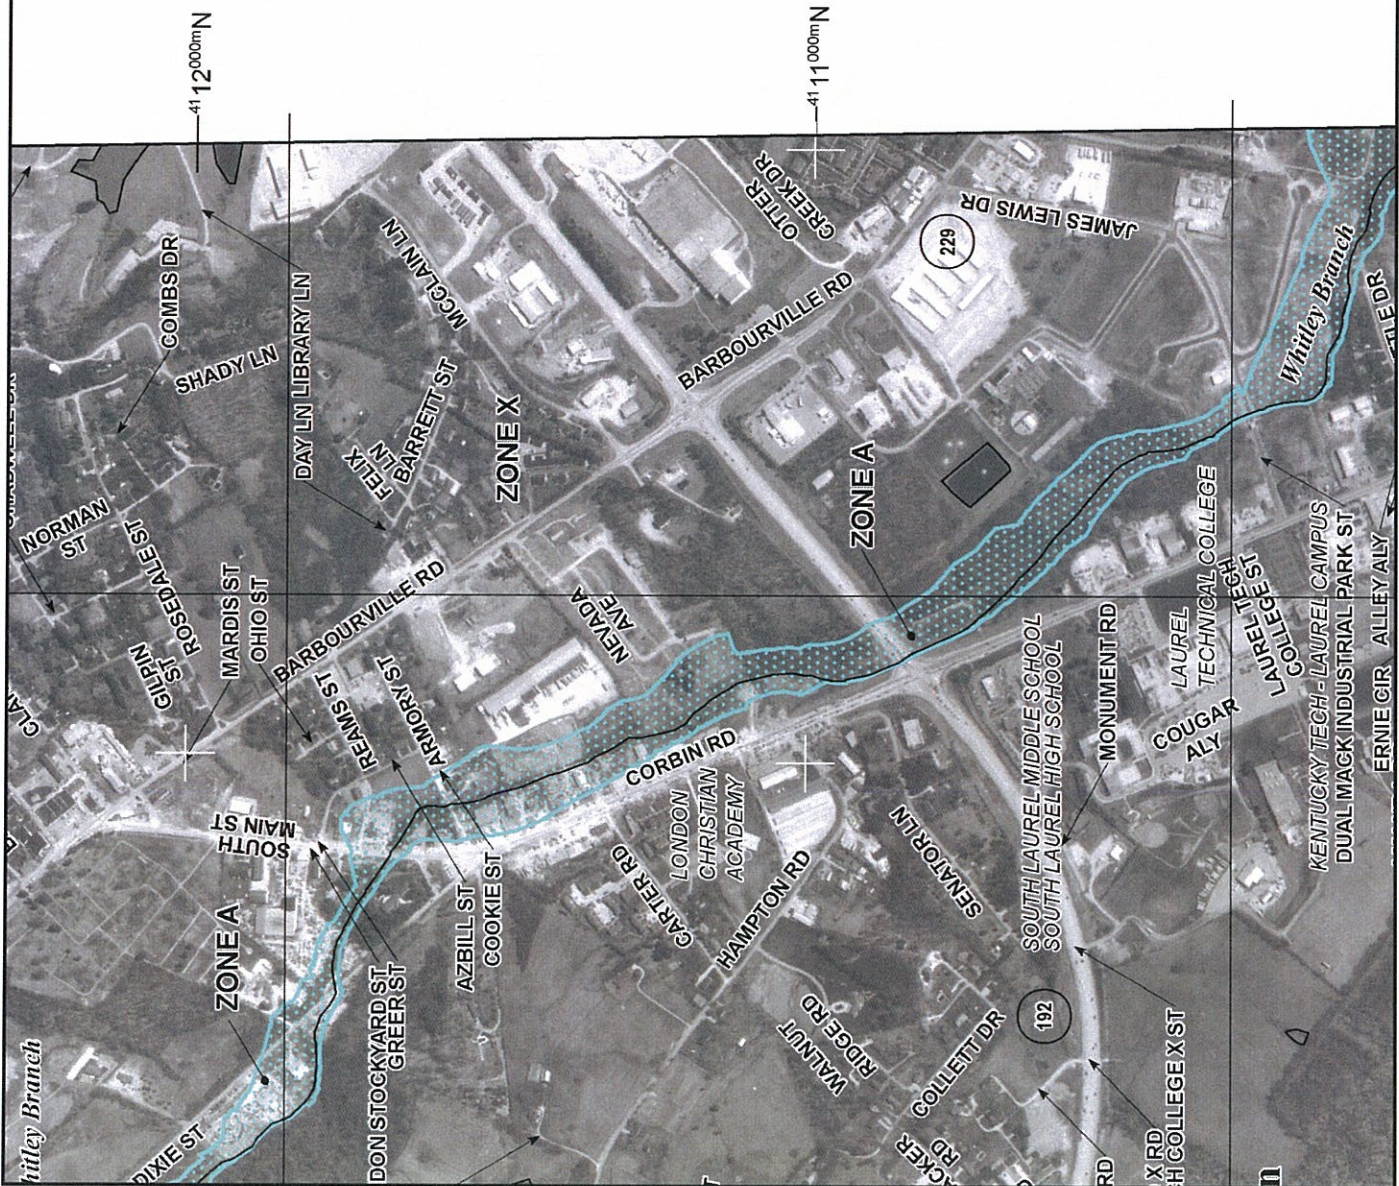

APPENDIX G

EXHIBIT 1

ITEM NO. 11-147
 US-25 & KY-229
 Project Area A-Alternative 2

US-25 DNA PREDESIGN
 SCOPING STUDY:
 LAUREL COUNTY

Legend

- Rerouted KY-229
- Rerouted US-25
- US Highway
- State Road
- Local Road

250 125 0 250 500 Feet

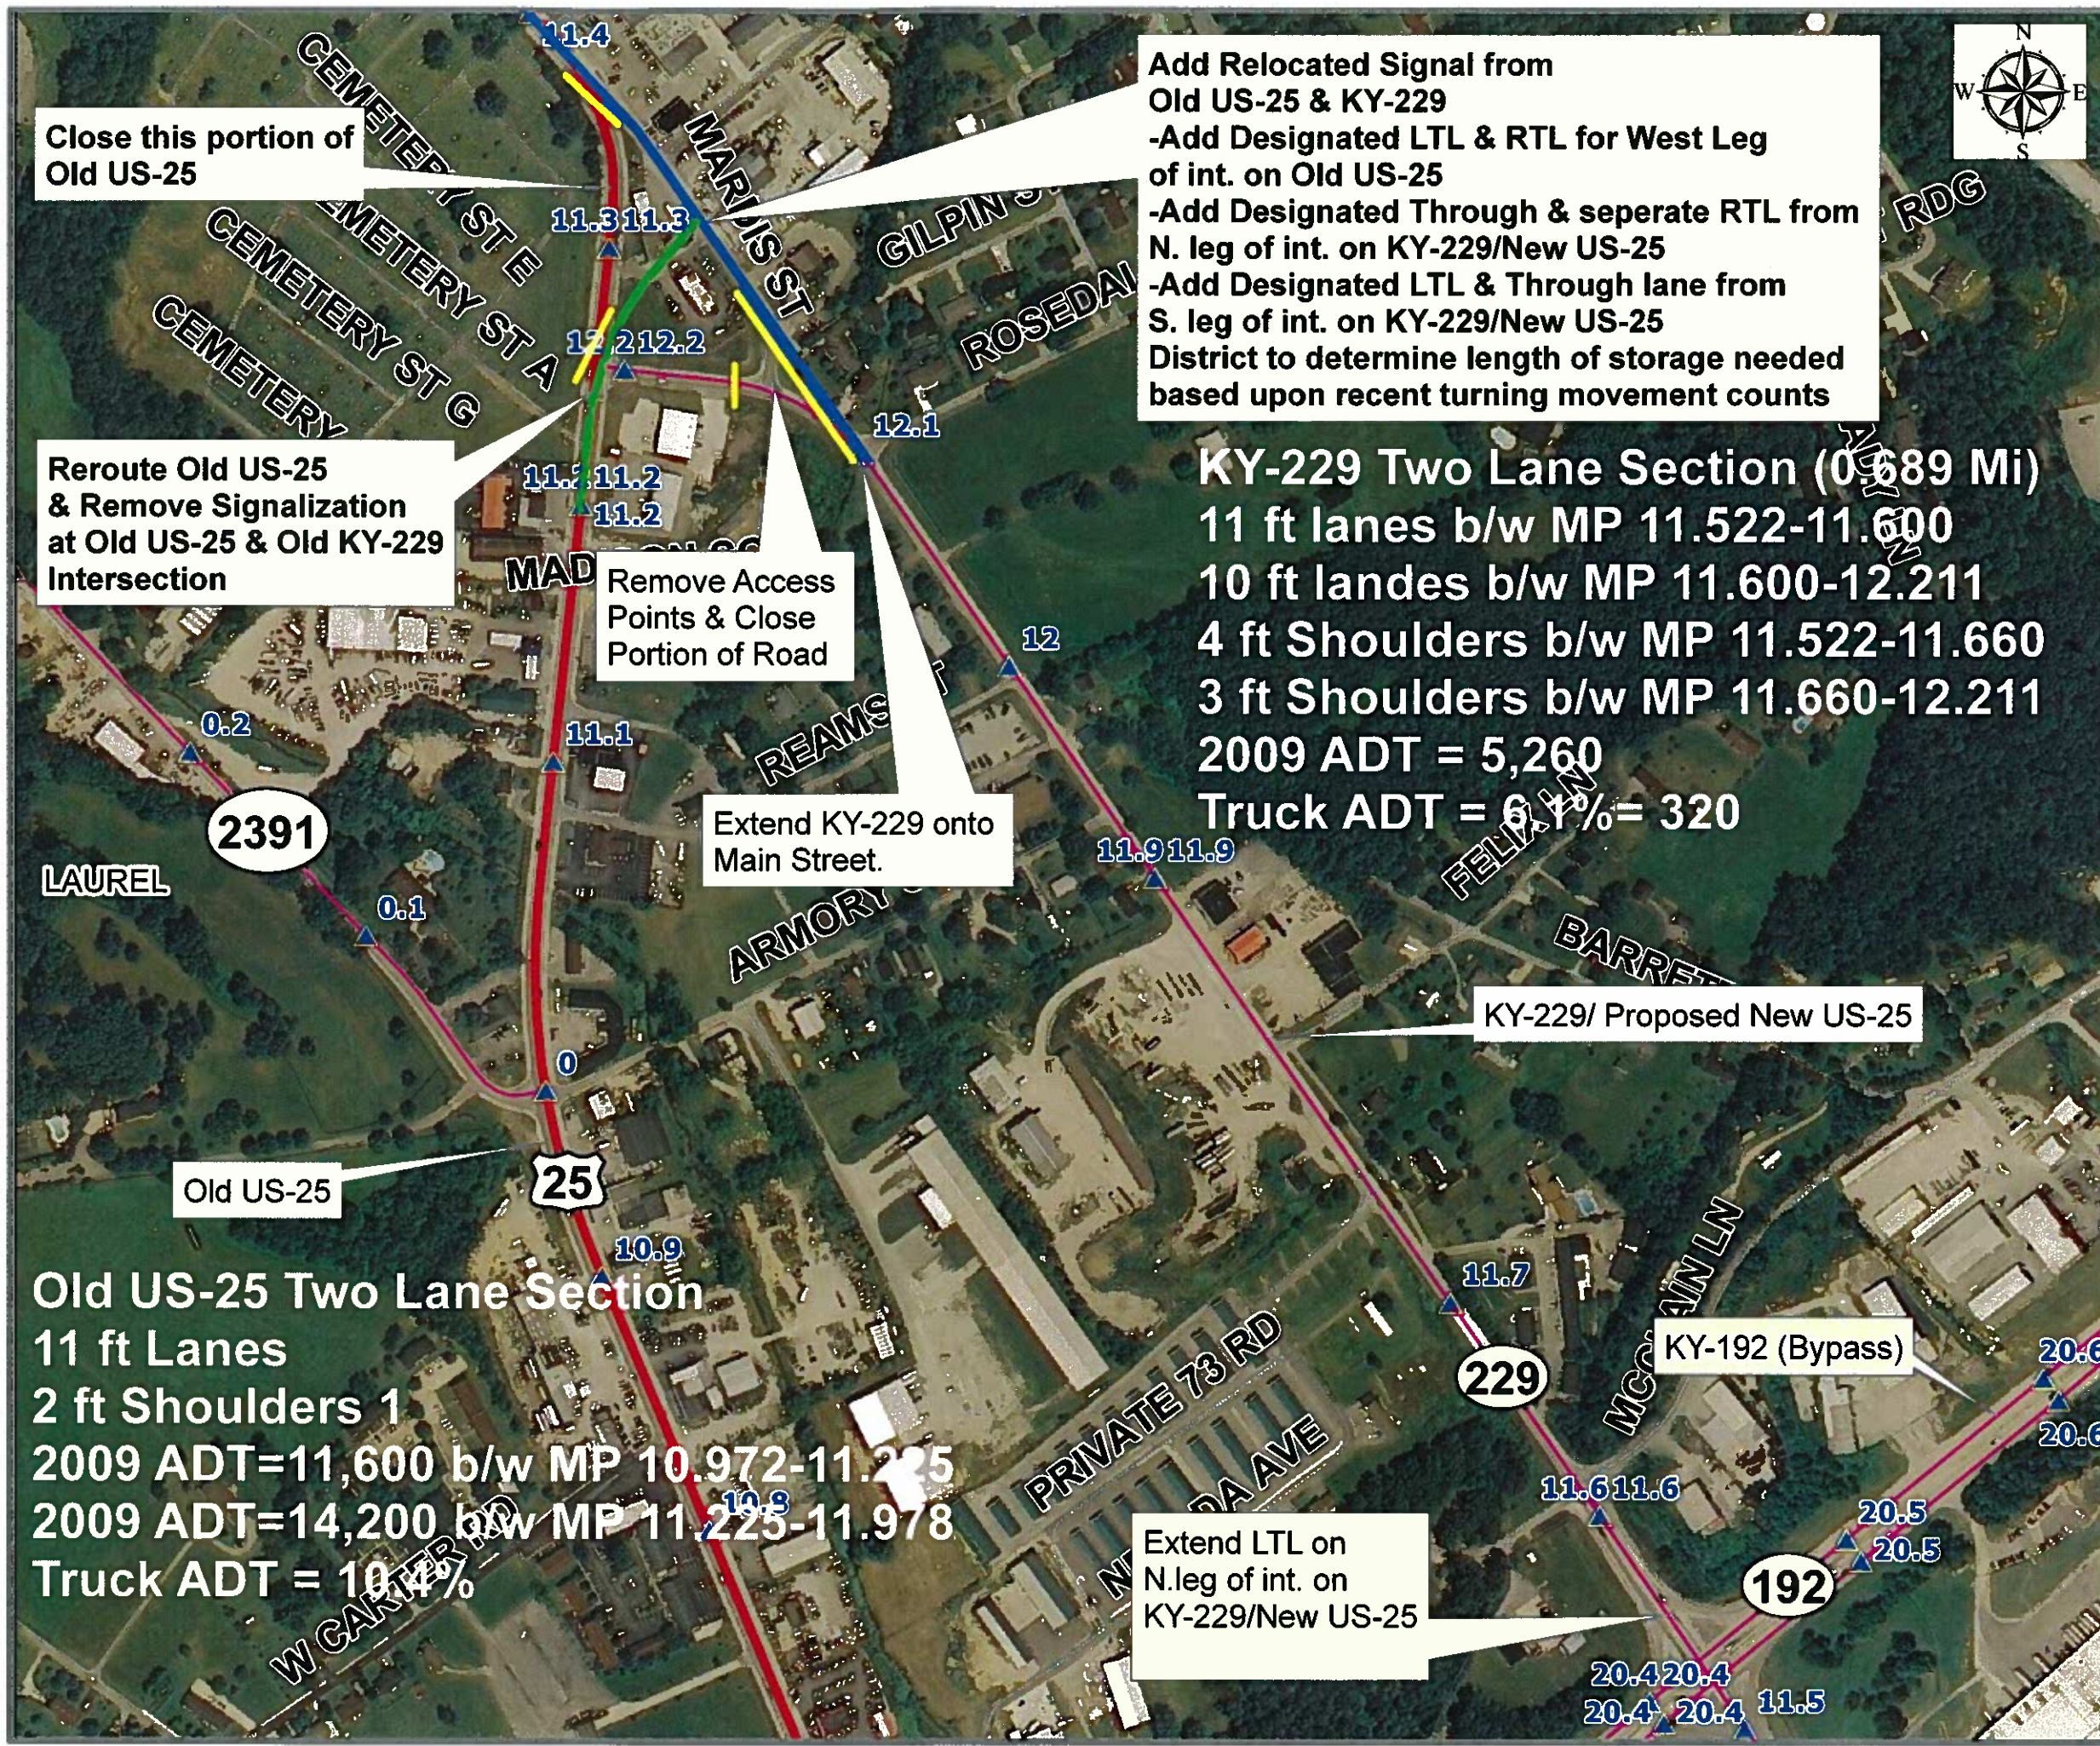


EXHIBIT 2

ITEM NO. 11-147
 US-25 & Commercial Drive
 Project Area A-Alternative 3

US 25 PREDESIGN
 SCOPING STUDY:
 LAUREL COUNTY

Legend

- Rerouted KY-229
- Rerouted US-25
- US Highway
- State Road
- Local Road

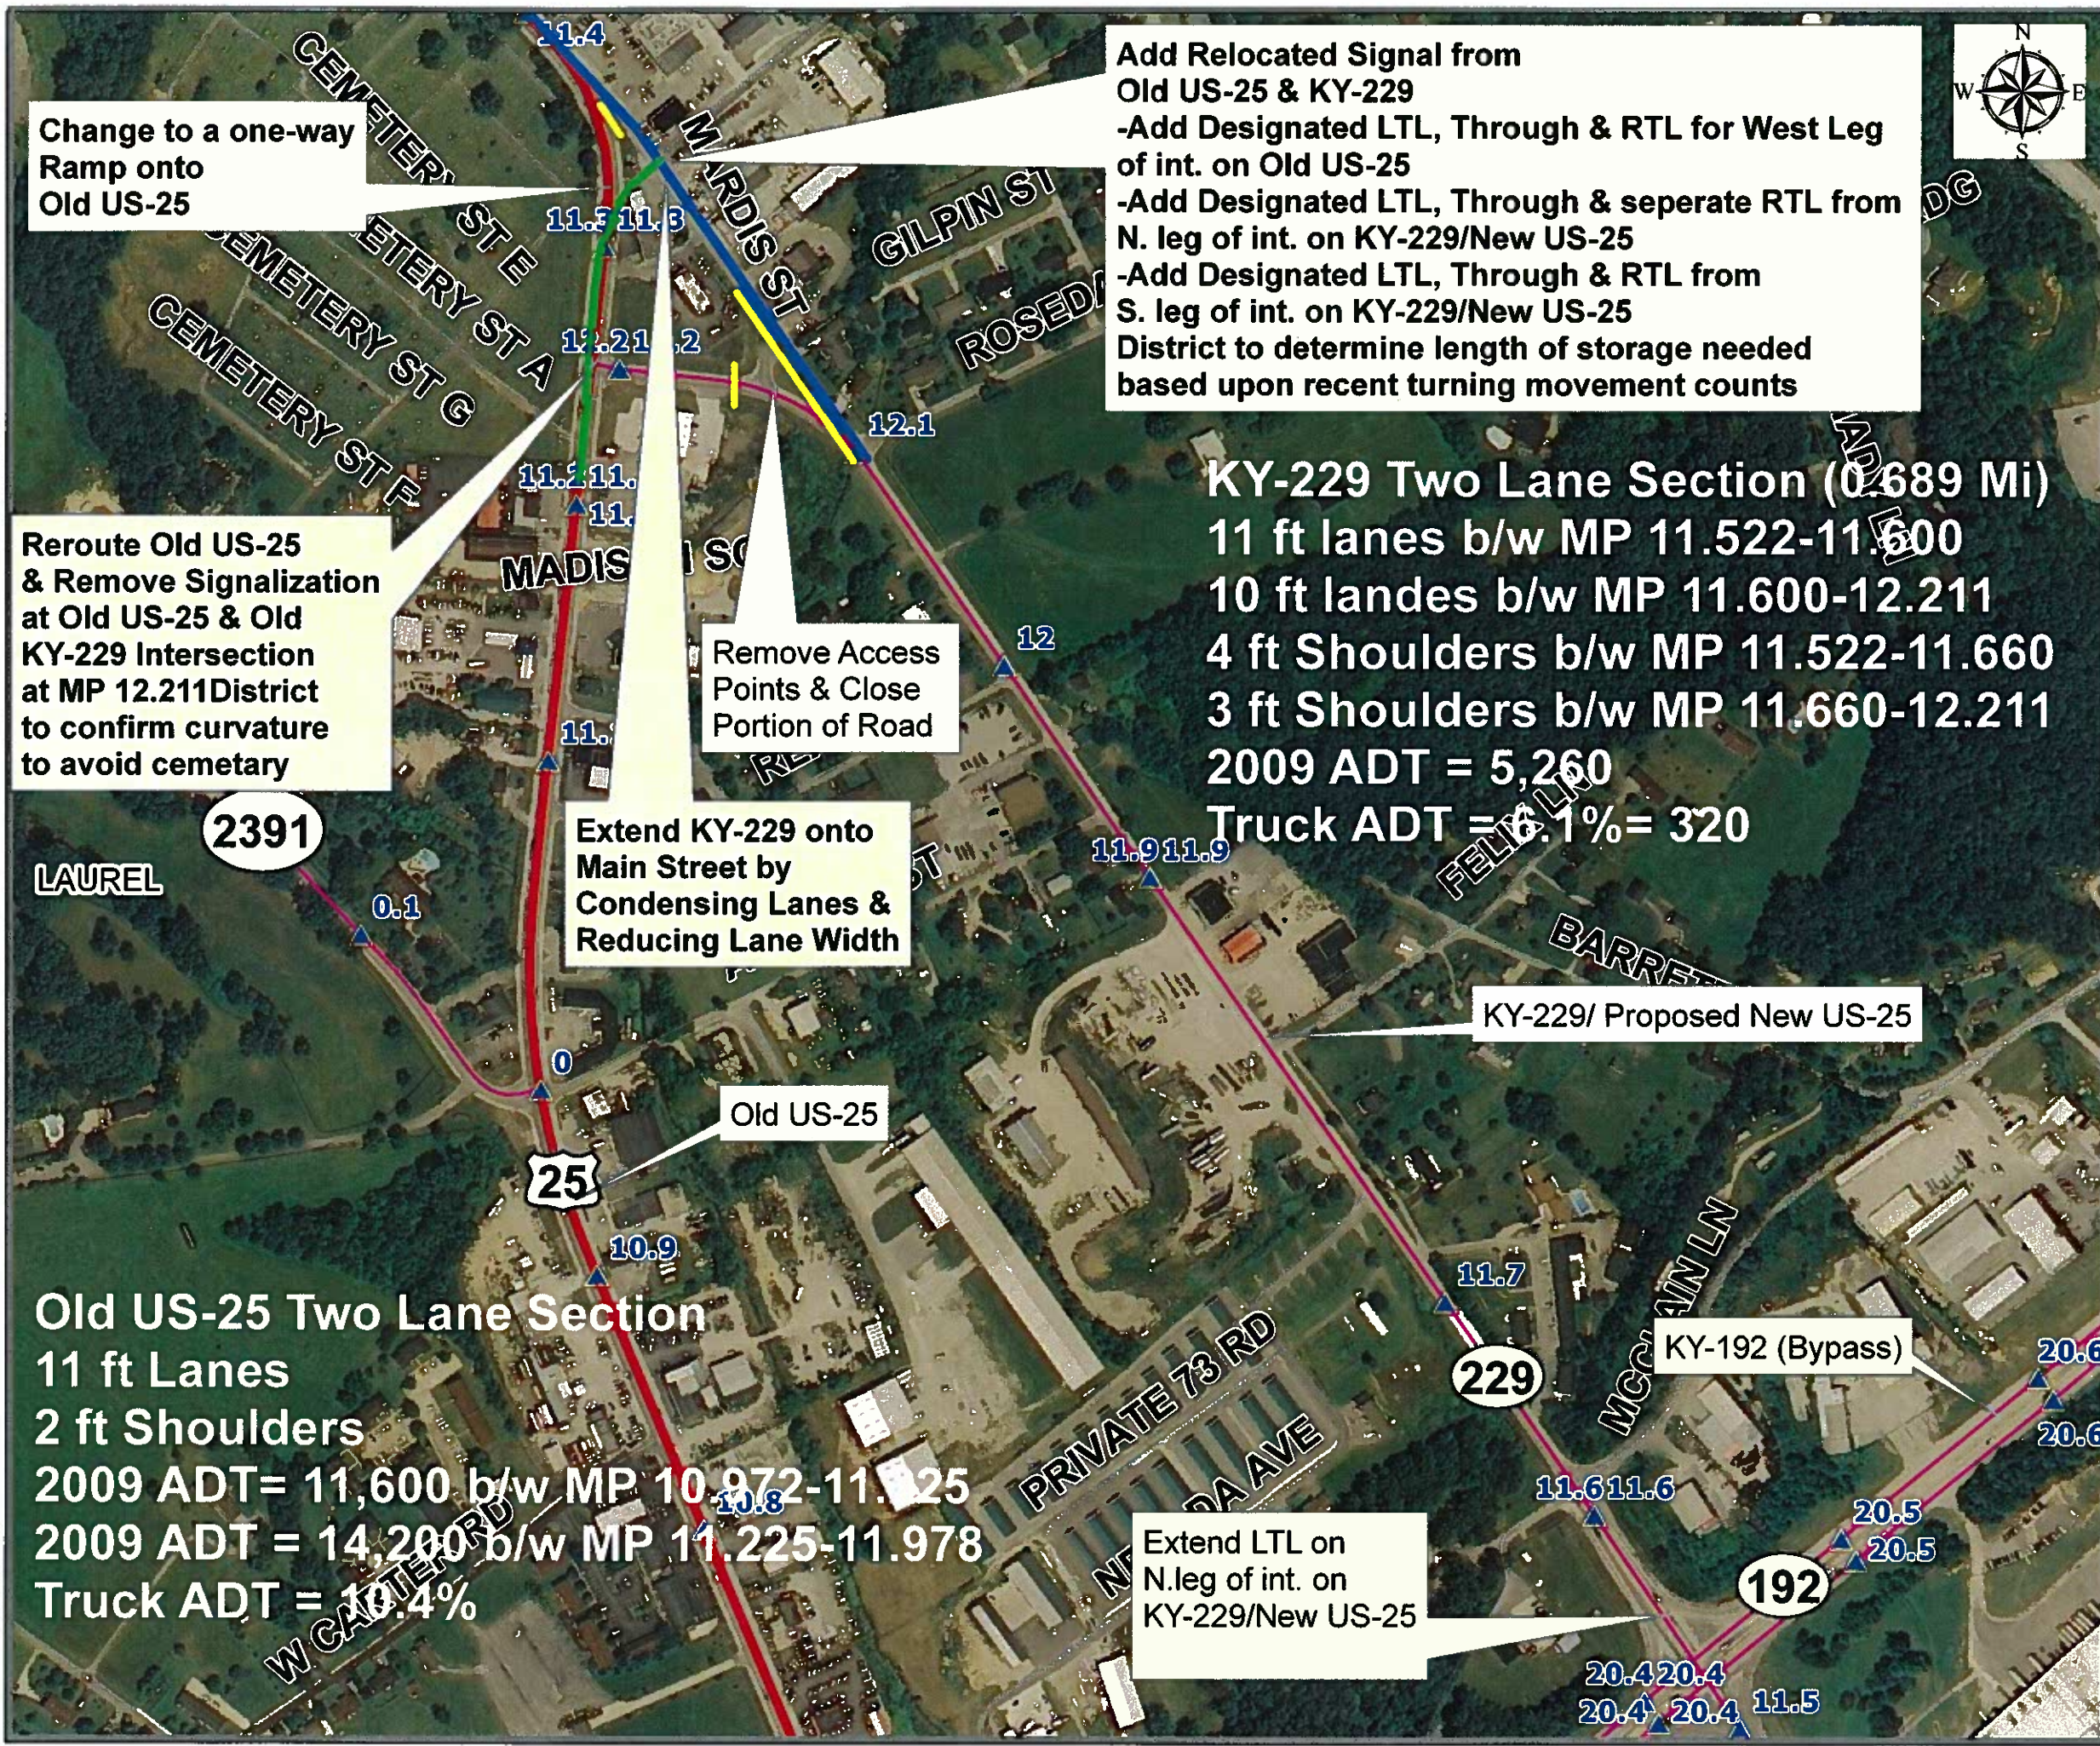



EXHIBIT 3

ITEM NO. 11-147.00
 US-25 & KY-229
 Project Area A-Alternative 4

US-25 DNA PREDESIGN
 SCOPING STUDY:
 LAUREL COUNTY

Legend

- New KY-229
- Rerouted US-25
- US Highway
- State Road
- Local Road

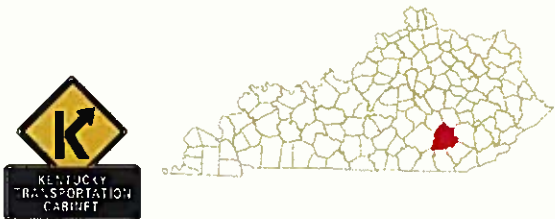

Change to a one-way Ramp onto Old US-25

Add Relocated Signal from Old US-25 & KY-229
 -Add Designated LTL, Through & RTL for West Leg of int. on Old US-25
 -Add Designated LTL, Through & RTL from N. leg of int. on KY-229/New US-25
 -Add Designated LTL & Through & RTL from S. leg of int. on KY-229/New US-25
 District to determine length of storage needed based upon recent turning movement counts

Reroute Old US-25 & Remove Signalization at Old US-25 & Old KY-229 Intersection
 District to confirm curvature to avoid cemetery.

Remove Access Points & Close Portion of Road

Extend KY-229 onto Main Street.

KY-229 Two Lane Section (0.689 Mi)
 11 ft lanes b/w MP 11.522-11.600
 10 ft lanes b/w MP 11.600-12.211
 4 ft Shoulders b/w MP 11.522-11.660
 3 ft Shoulders b/w MP 11.660-12.211
 2009 ADT = 5,260
 Truck ADT = 6.1% = 320.

KY-229/ Proposed New US-25 Expand to:
 2-12 ft Lanes, TWLTL & 8 ft Shoulders

Old US-25 Two Lane Section
 11 ft Lanes
 2 ft Shoulders
 2009 ADT = 11,600 b/w MP 10.972-11.225
 2009 ADT = 14,200 b/w MP 11.225-11.978
 Truck ADT = 10.4%

Extend LTL on N.leg of int. on KY-229/New US-25

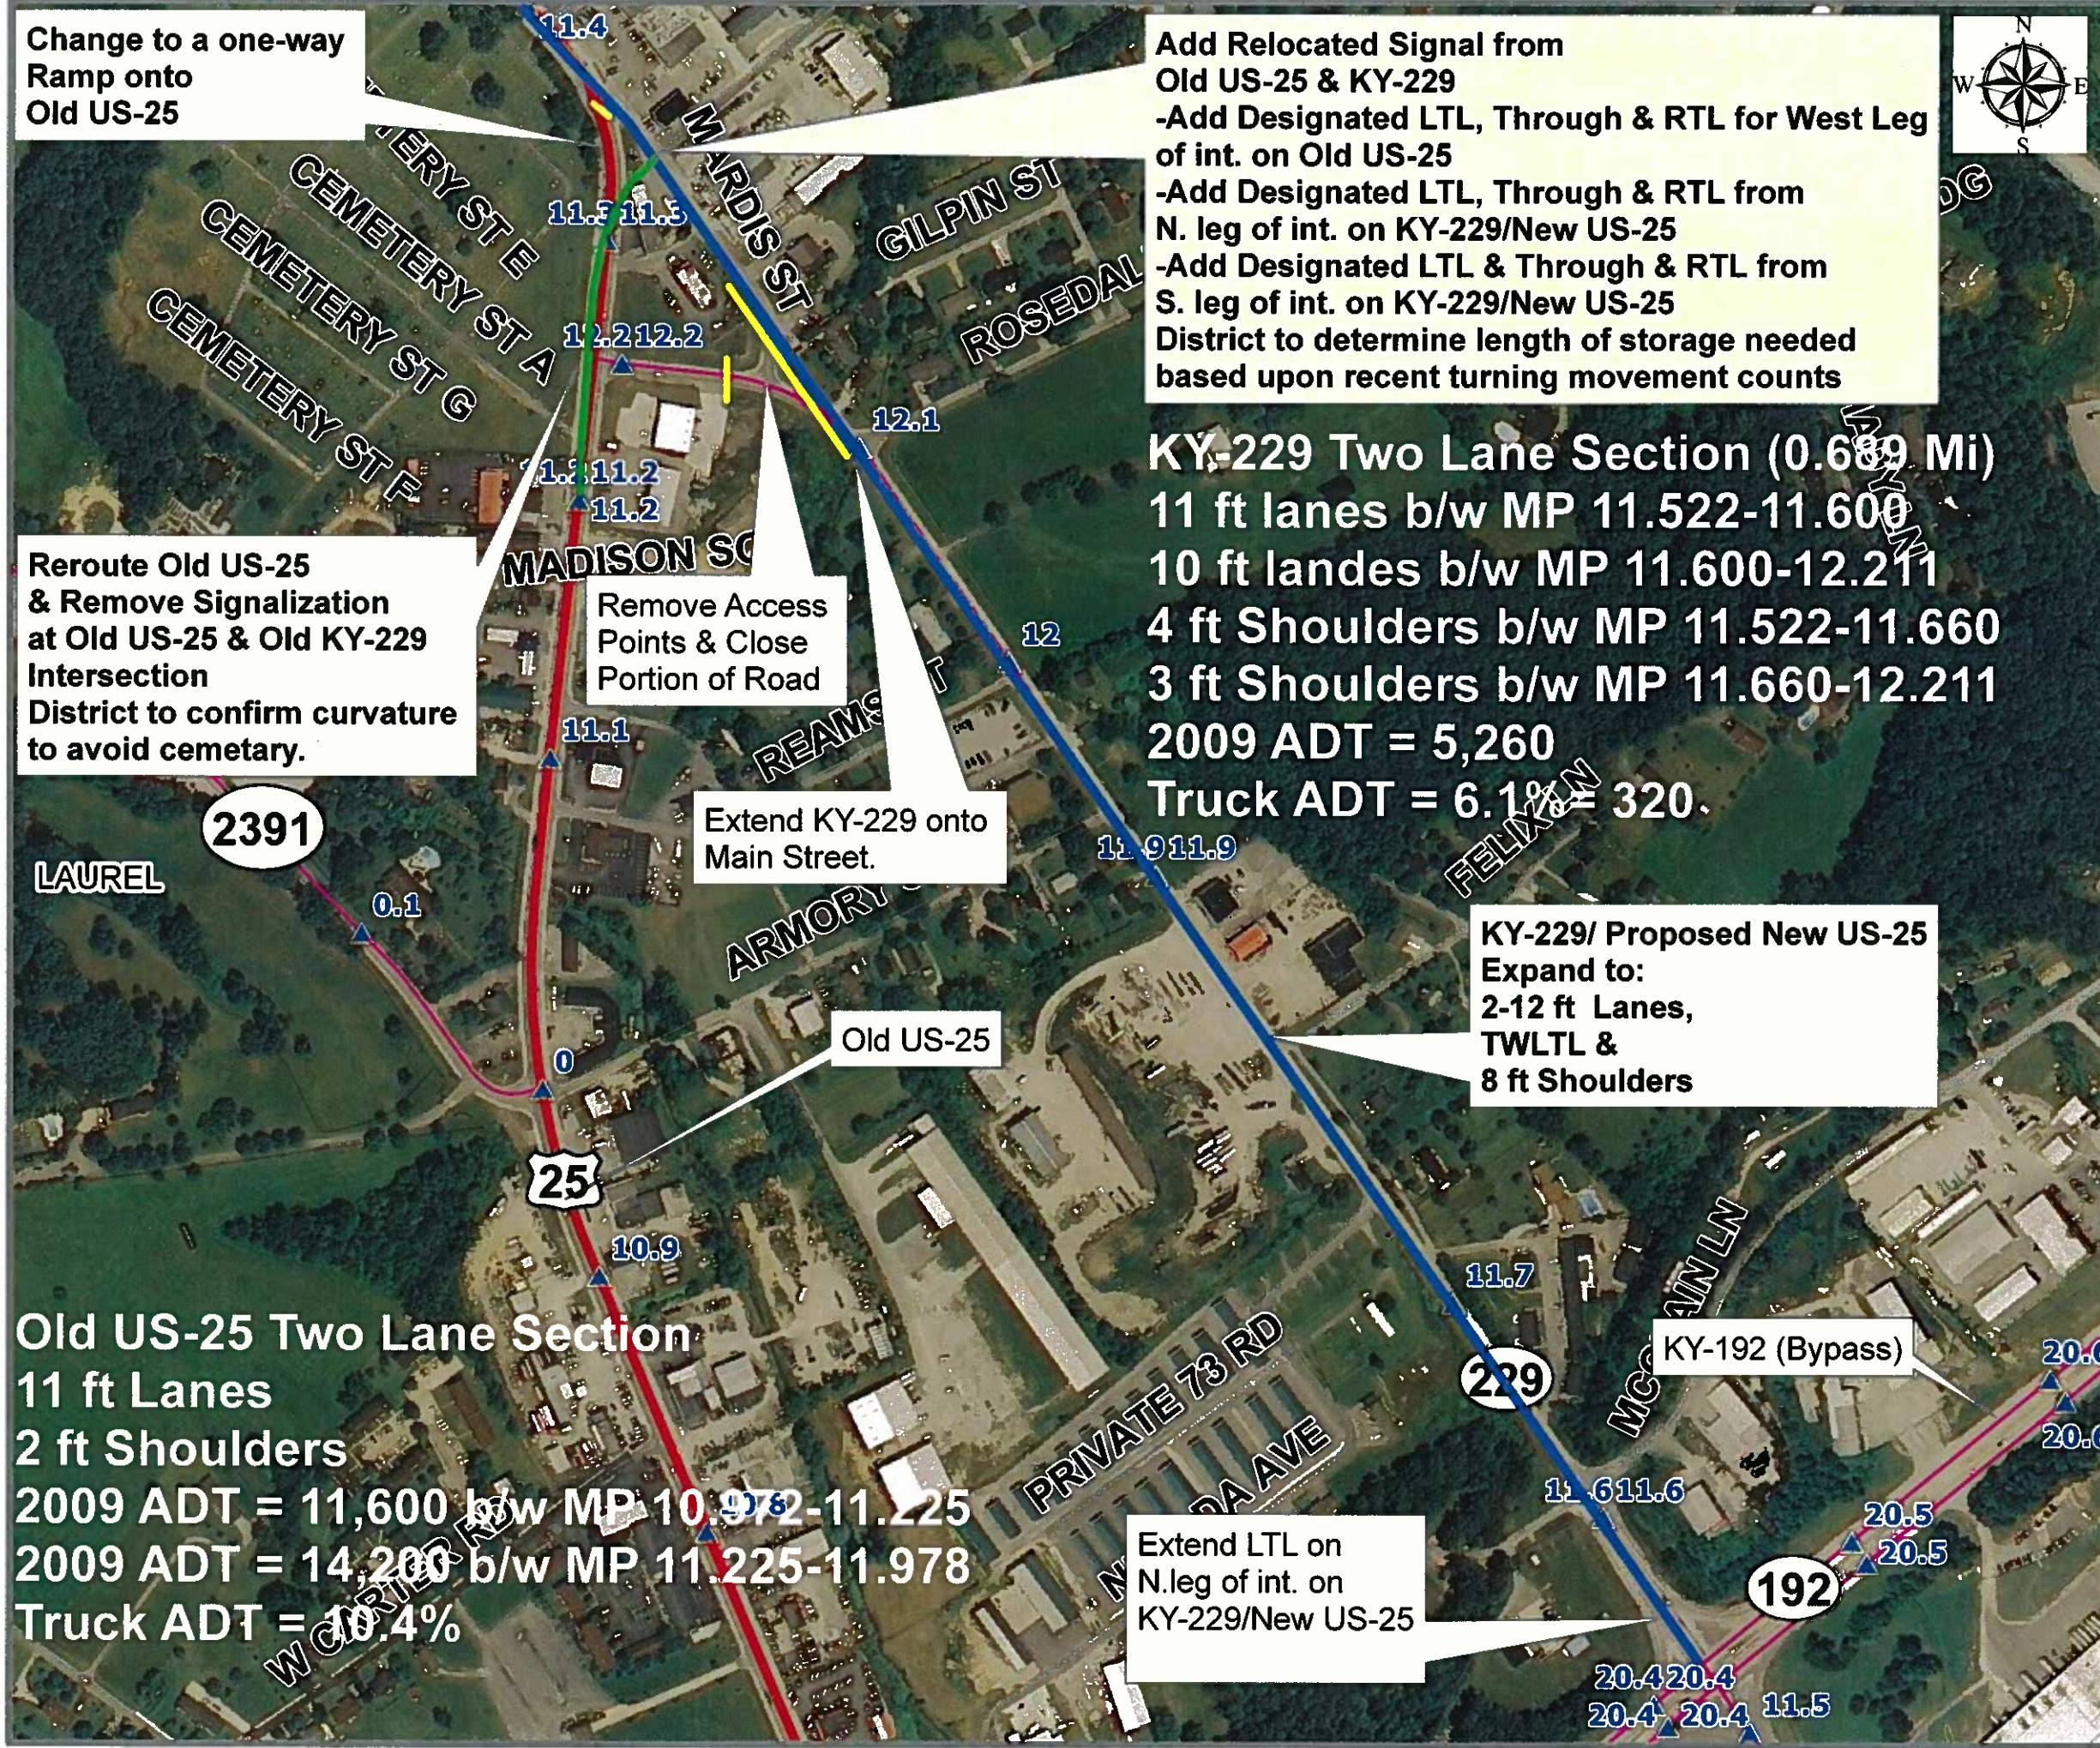


EXHIBIT 4

ITEM NO. 11-147
 US-25 & KY-229
 Project Area A-Alternative 5

US 25 PREDESIGN
 SCOPING STUDY:
 LAUREL COUNTY

Legend

- Rerouting KY-229
- Rerouting US-25
- US Highway
- State Road
- Local Road

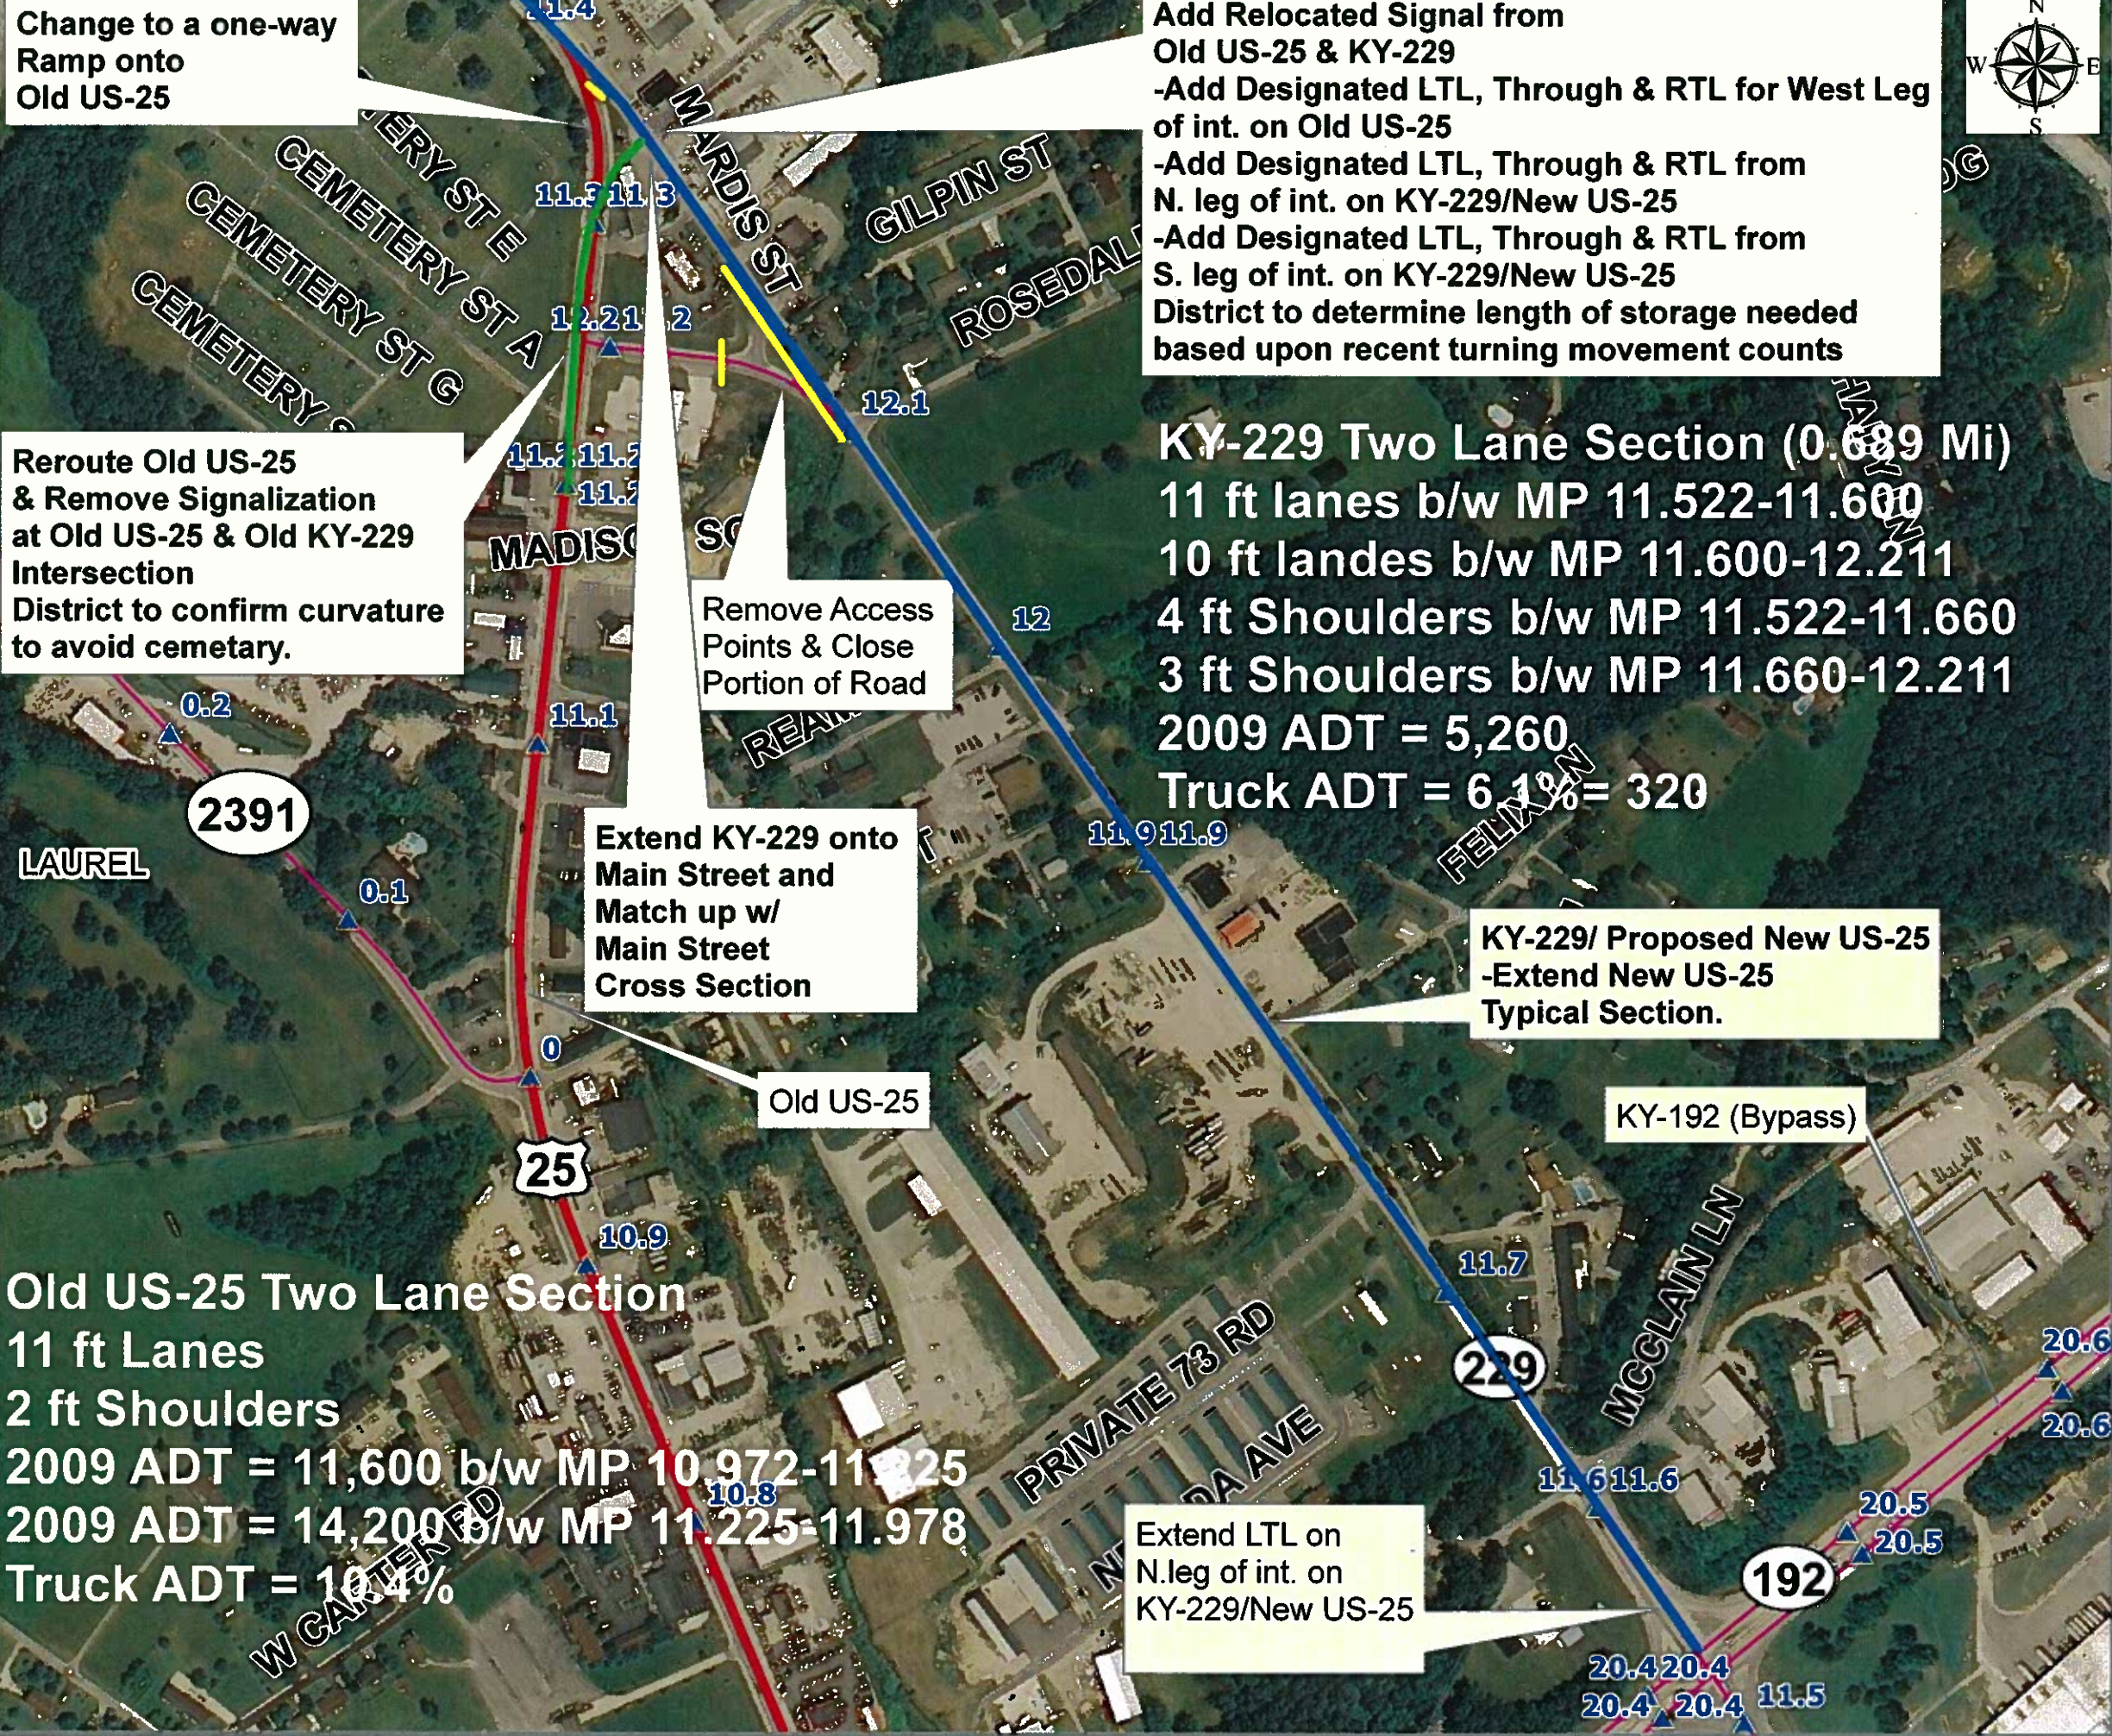
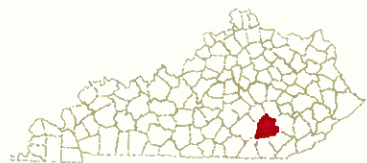
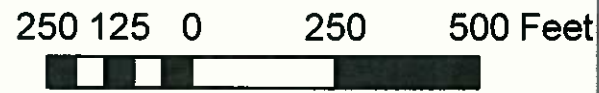


EXHIBIT 5


ITEM NO. 11-147.00
US-25 & Commercial Drive
Project Area B-Alternative 7

US-25 DNA PREDESIGN
SCOPING STUDY:
LAUREL COUNTY


Legend

- New Southern Bypass
- New School Access Road
- US Highway
- State Road
- Local Road

40 20 0 40 80 Feet

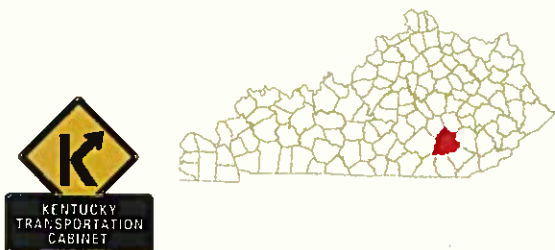

US-25 Two Lane Section (0.505 Mi)
11 foot lanes
2 ft Shoulders to MP 9.028-10.300
2009 ADT = 25,300
Truck ADT = 14.3% = 3,618

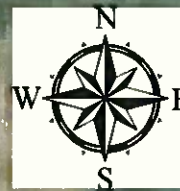

Remove and Relocate Light Signal to US-25 & Commercial Drive and Close This SLHS Entrance for New Access from New Southern Bypass.

Remove existing entrances adjacent to intersection as they are in way of added turn lanes and within 100 ft of intersection. Both properties have multiple entrances.

Close Access Point at Laurel Technical College Street Formerly Recommended by Laurel County School Board

Proposed New Access Road for S.L.H.S. & Laurel Tech. College to New Southern Bypass. This is a separate project.

Proposed New Southern Bypass from KY-363 to US-25 at Commercial Drive. This is a separate project.

Provide Relocated Signal at Intersection of US-25 & Commercial Drive
-Add Designated LTL & RTL for ALL legs of the intersection to include:
-North and South legs of Old US-25
-East leg of Commercial Drive
-West leg of Proposed New Southern Bypass.
District to confirm length of lanes once traffic forecast and modeling information is received.

LAUREL TECH COLLEGE ST

LAUREL

Project Area B,
B-1 Intersection

25

COMMERCIAL DR

10.1

Commercial Drive

EXHIBIT 6

ITEM NO. 11-147.00
US-25 & Commercial Drive
Project Area B-Alternative 8


US-25 DNA PREDESIGN
SCOPING STUDY:
LAUREL COUNTY

US-25 Two Lane Section (0.505 Mi)
11 foot lanes
2 ft Shoulders to MP 9.028-10.300
2009 ADT = 25,300
Truck ADT = 14.3% = 3,618



Legend

-  New Southern Bypass
-  New School Access Road
-  US Highway
-  State Road
-  Local Road

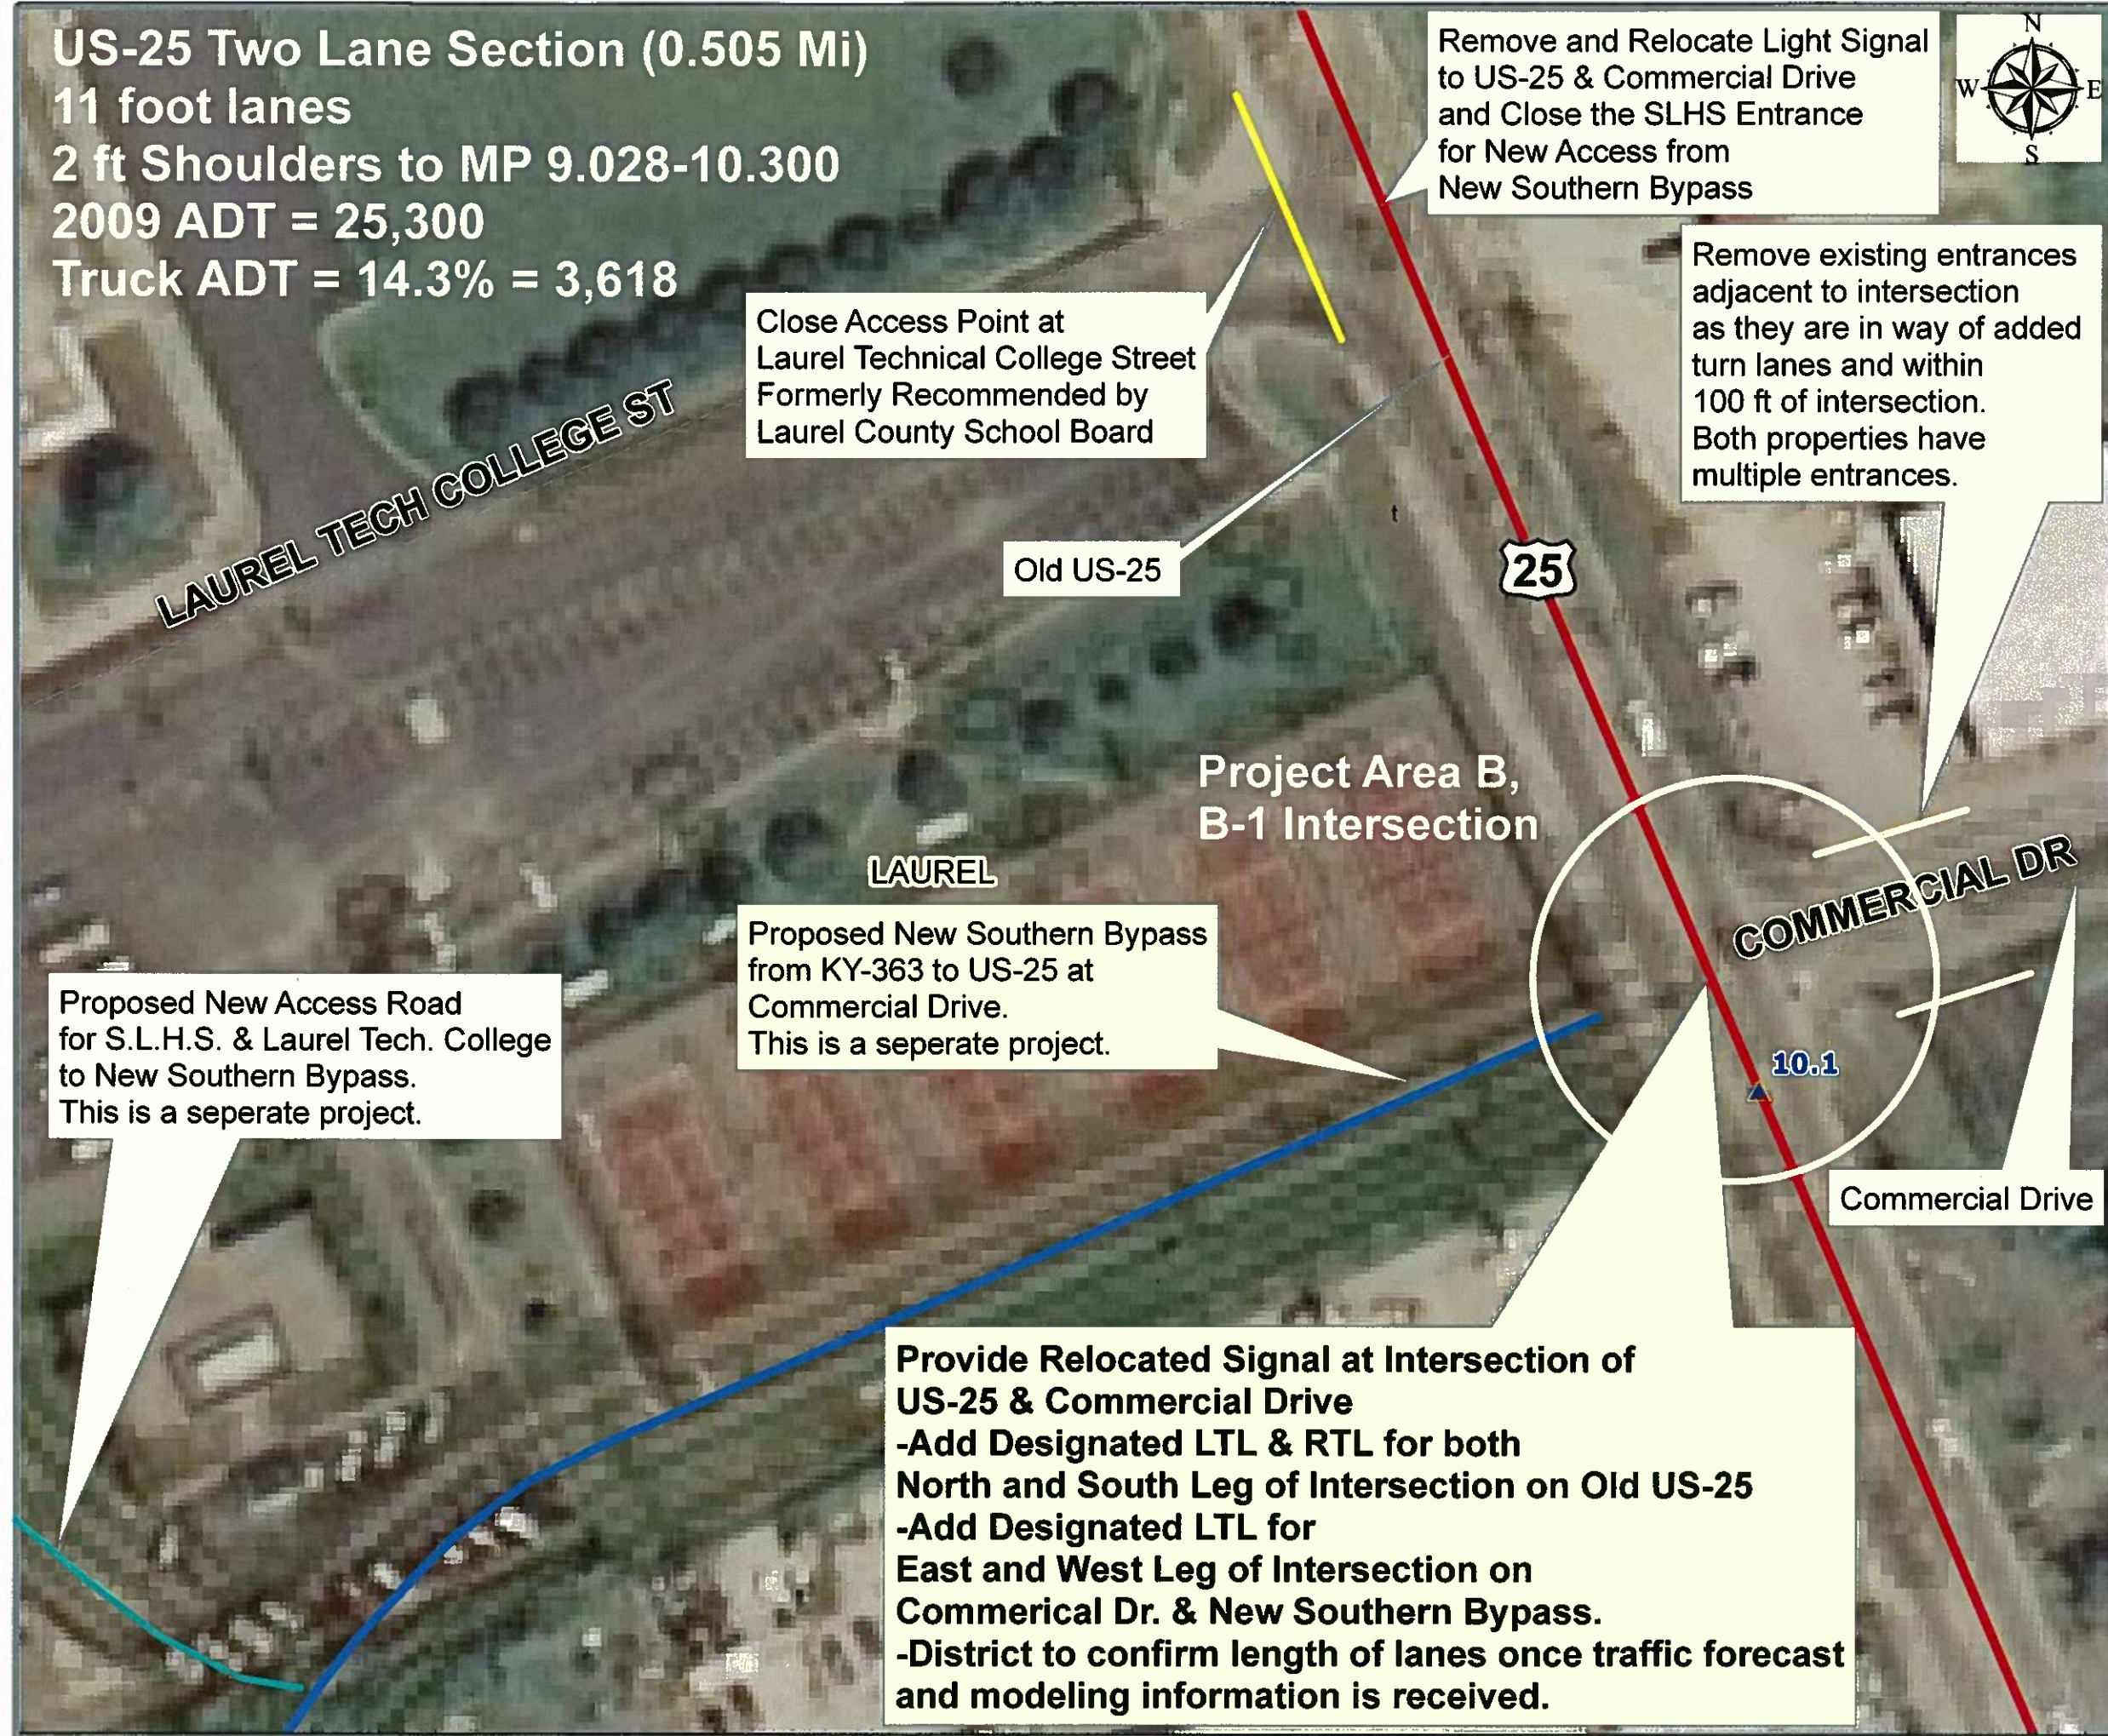

Remove and Relocate Light Signal to US-25 & Commercial Drive and Close the SLHS Entrance for New Access from New Southern Bypass

Remove existing entrances adjacent to intersection as they are in way of added turn lanes and within 100 ft of intersection. Both properties have multiple entrances.

Close Access Point at Laurel Technical College Street Formerly Recommended by Laurel County School Board

Old US-25

Project Area B, B-1 Intersection

Proposed New Southern Bypass from KY-363 to US-25 at Commercial Drive. This is a separate project.

Proposed New Access Road for S.L.H.S. & Laurel Tech. College to New Southern Bypass. This is a separate project.

Provide Relocated Signal at Intersection of US-25 & Commercial Drive
-Add Designated LTL & RTL for both North and South Leg of Intersection on Old US-25
-Add Designated LTL for East and West Leg of Intersection on Commercial Dr. & New Southern Bypass.
-District to confirm length of lanes once traffic forecast and modeling information is received.

Commercial Drive

EXHIBIT 7

ITEM NO. 11-147.00
US-25 & Commercial Drive
Project Area B-Alternative 9

US-25 DNA PREDESIGN
SCOPING STUDY:
LAUREL COUNTY

Legend

- New School Access Road
- New Southern Bypass
- Proposed Commercial Dr. Extension
- Proposed James Lewis Dr. Tie-In
- US Highway
- State Road
- Local Road

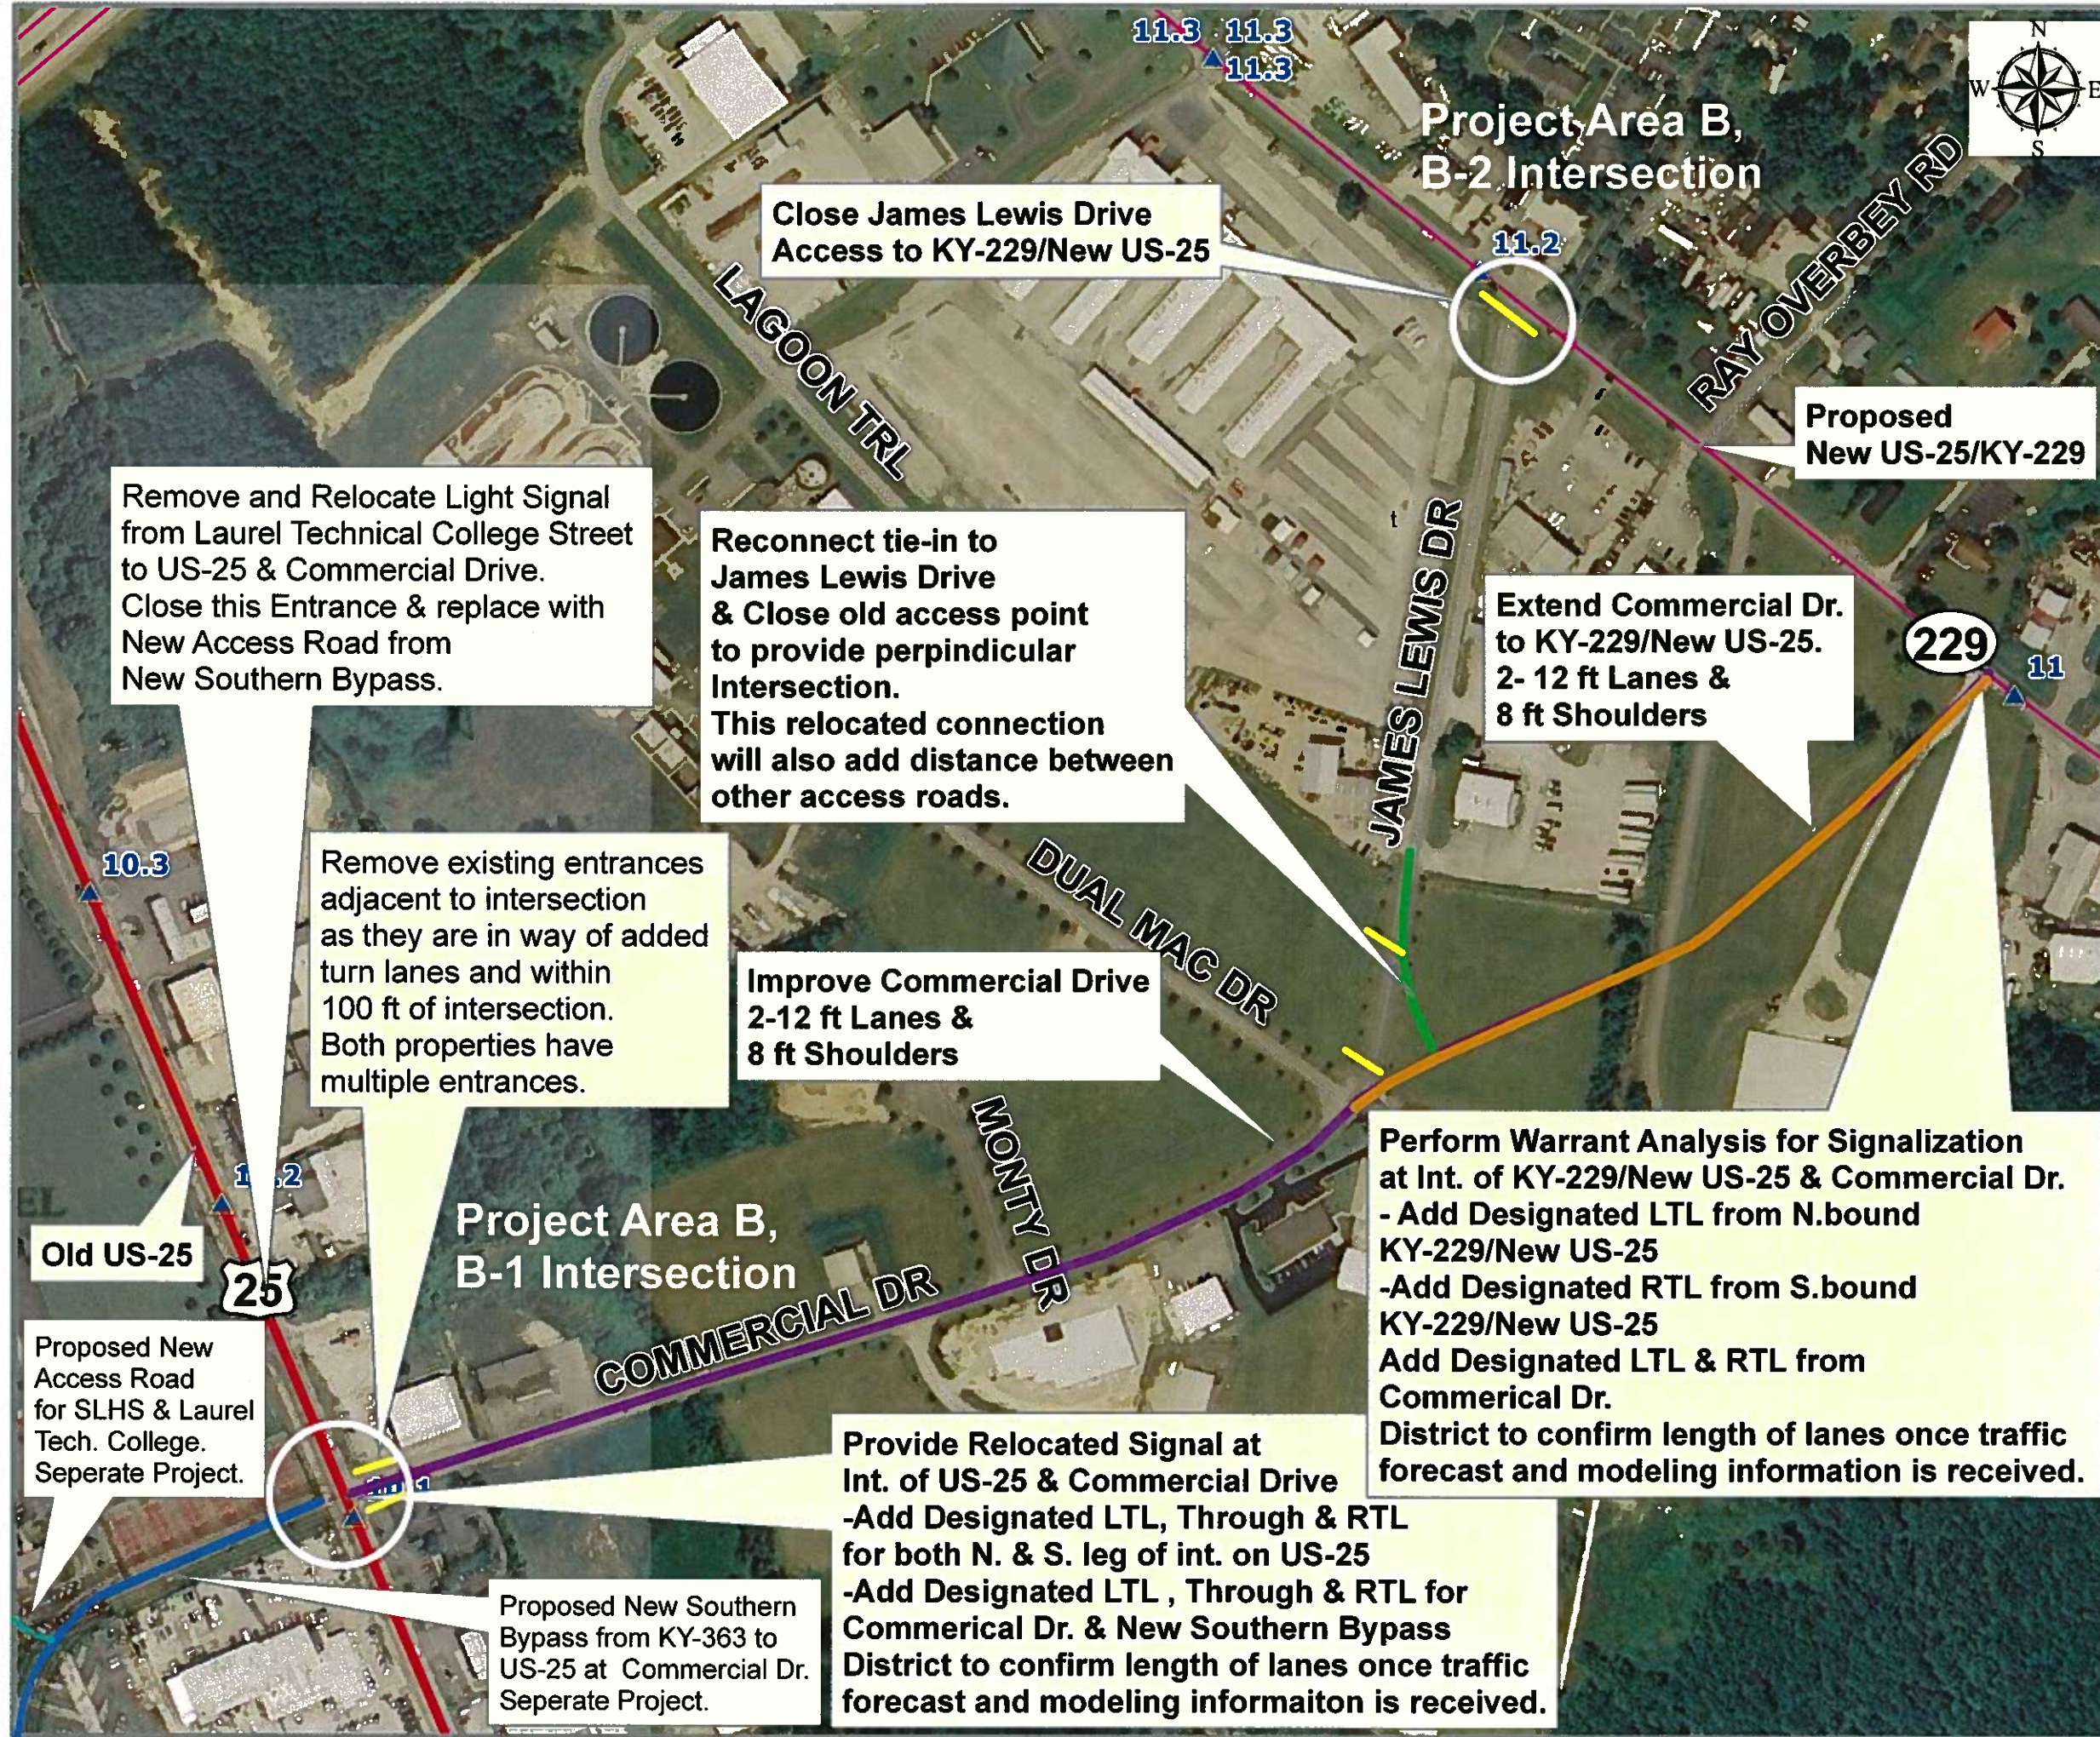
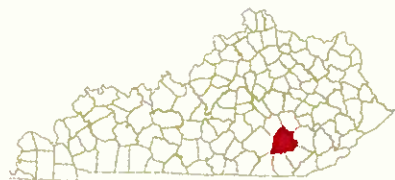
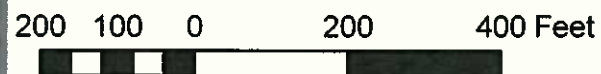




EXHIBIT 8

ITEM NO. 11-147.00
 US-25 & Commercial Drive
 Project Area B-Alternative 10

US-25 DNA PREDESIGN
 SCOPING STUDY:
 LAUREL COUNTY

Legend

-  New School Access Road
-  New Southern Bypass
-  Commercial Drive
-  James Lewis Drive
-  US Highway
-  State Road
-  Local Road

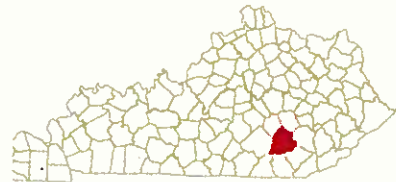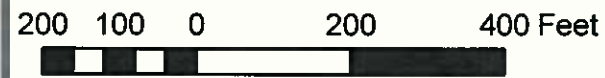

US-25 Two Lane Section (0.505 Mi)
 (from MP 10.000 to MP 10.505)
 11 foot lanes
 2 ft Shoulders to MP 9.028-10.300
 2009 ADT = 25,300
 Truck ADT = 14.3% = 3,618

KY-229 Two Lane Section (0.382 Mi)
 (from MP 11.140 to MP 11.522)
 11 foot lanes
 2 ft Shoulders
 2009 ADT = 9,230
 Truck ADT = 4.8% = 443

