

# TRANSPORTATION CABINET DEPARTMENT OF HIGHWAYS

## MASON COUNTY

### US 62/68 OVER LAWRENCE CREEK



UPDATE DATE: \_\_\_\_\_ LETTING DATE: \_\_\_\_\_  
 DATE 8-5-94 DATE 8-5-94 DATE 8-22-94  
 SHEET NO. 1 OF 1  
 DESIGNED BY: \_\_\_\_\_ CHECKED BY: \_\_\_\_\_  
 DRAWN BY: \_\_\_\_\_ CHECKED BY: \_\_\_\_\_  
 PREPARED BY: \_\_\_\_\_

REFERENCE AND ESTIMATE OF QUANTITIES															
LOCATION	ITEM	SHEET NUMBER	CLASS A CONCRETE CU. YDS.	CLASS AA CONCRETE CU. YDS.	REINF. STEEL LBS.	REINF. STEEL EPOXY COATED LBS.	STRUCTURE EXCAVATION		CONCRETE STRUCTURAL MODIFIED MEMBERS LIN. FT.	STRUCTURAL STEEL LUMP SUM	HP 14 X 73 STEEL PILES		PILE POINTS 14" INCH EACH	EXPANSION DAM 4" NEOPRENE LIN. FT.	STRUCTURE GRANULAR BACKFILL CU. YDS.
							COMMON CU. YDS.	SOLID ROCK CU. YDS.			TEST PILES LIN. FT.	FURNISH & DRIVE LIN. FT.			
TITLE AND ESTIMATE OF QUANTITIES		1													
GENERAL NOTES		2													
LAYOUT		3													
ELEVATION & TYPICAL DECK SECTIONS		4													
SUBSURFACE DATA		5-7													
FOUNDATION LAYOUT		8, 9													
SUBSTRUCTURE															
END BENT 1	10, 11, 14		94.5	60.3		15498					105	1800	19		193
PIER 1	15, 21	▲	417.7		▲	7171.6					45	1043	32		
PIER 2	16, 17, 21	▲	649.3		▲	11185.0		184	695						
PIER 3	18, 19, 21	▲	649.3		▲	11185.0		138	469						
PIER 4	20, 21	▲	417.7		▲	7171.6					70	1992	32		
END BENT 2	12-14		94.5	59.9		15467					120	2052	19		193
SUB-TOTAL SUBSTRUCTURE			▲ 2323.0	120.4	▲ 367132	30965		322	1164		340	6887	102		386
SUPERSTRUCTURE															
SUPERSTRUCTURE	22-25		0	1755											135
SUPERSTRUCTURE BILL OF REINFORCEMENT	25				▲	481075									
FRAMING PLAN	26														
"BULB-T" I-BEAM DETAILS	28-30							4548							
CONSTRUCTION ELEVATIONS	27, 31-33	▲													
EMBANKMENT AT END BENT	34 & 35	▲													
EXPANSION DAM 4" NEOPRENE	36	▲													
SUB-TOTAL SUPERSTRUCTURE			0	1755	0	▲ 481075		0	0		0	0	0	135	0
BRIDGE TOTALS			▲ 2323.0	1875.4	▲ 367132	▲ 512040		4548	4780	4780	0	0	0	135	0

① APPROXIMATE WEIGHT OF STRUCTURAL STEEL IS ~~4780~~ 4070 LBS (ARMORED EDGES BJE-001# PRAINS) ▲

BILL OF INCIDENTAL MATERIALS			
ITEM	NO.	DESCRIPTION	LOCATION
PLASTIC PIPE	16	1" I.D. x 1'-1"	WINGS
▲ FLANGED REBAR COUPLERS	168	THREADED FOR #5 BAR	PIERS
▲ FLANGED REBAR COUPLERS	192	THREADED FOR #10 BAR	PIERS
1/2" THREADED ROD 1'-6"	100		MID-SPAN DIA.
1/2" INSERTS	100		MID-SPAN DIA.
5/8" INSERTS	112		PIER DIA.
5/8" THREADED ROD 2'-6"	112		PIER DIA.
▲ CABLE CLAMPS	192	CLAMPS FOR 1/2" PRESTRESS STRAND	BEAM ENDS @ PIERS
▲ ELASTOMERIC BEARING PADS	12	23" x 15" x 5 25/32" (SHIMMED)	END BENTS
▲ ELASTOMERIC BEARING PADS	48	23" x 15" x 1 5/8" (SHIMMED)	PIERS
▲ 1" POLYSTYRENE	4	1'-0" x 4'-2"	END BENT DIAPHRAGM
▲ 1" POLYSTYRENE	20	2'-0" x 7'-3"	PIER DIAPHRAGM
▲ 1" POLYSTYRENE	24	2'-4" x 4'-0"	PIER DIAPHRAGM
▲ 1" POLYSTYRENE	40	10" x 2'-9"	PIER DIAPHRAGM
▲ 1" POLYSTYRENE	8	1'-6" x 1'-9"	END BENT DIAPHRAGM
▲ 1 3/8" POST-TENSIONING BARS	10	1 3/8" PT BAR W/ DUCTS, COUPLER, ANCHOR P.	INTERMEDIATE DIAPHRAGMS

- ① INCIDENTAL TO CLASS "AA" CONCRETE
- ② INCIDENTAL TO CLASS "A" CONCRETE
- ③ INCIDENTAL TO PRESTRESSED CONCRETE I-BEAMS

  
 Signed *William B. Casland* Date *Sept 7, 1994*  
  
 Signed *H. Hubert* Date *9/6/94*

**REFERENCES:**  
 STANDARD DRAWINGS, SPECIAL PROVISIONS AND SPECIAL NOTES LISTED BELOW ARE THE CURRENT EDITIONS, AND ARE TO BE USED WITH THESE PLANS.

**STANDARD DRAWINGS:**  
 BGX-006-05 STENCIL CONSTRUCTION DATE FOR BRIDGES  
 BPS-009-03 14" STRUCTURAL STEEL BEARING PILE AT 73 POUNDS

**SPECIAL PROVISIONS:**  
 38K (91) BUY AMERICA  
 69C (91) EMBANKMENT AT BRIDGE END BENT STRUCTURES  
 92 (91) PERMANENT STEEL BRIDGE DECK FORMS

**SPECIAL NOTES:**  
 SPECIAL NOTE FOR PILE POINTS  
 SPECIAL NOTE FOR CONCRETE BONDING AGENTS (DELAYED CURE TYPE)  
 SPECIAL NOTE FOR NON-EPOXY ADHESIVES  
 SPECIAL NOTE FOR LIGHT WEIGHT AGGREGATE FOR USE IN PORTLAND CEMENT CONCRETE.  
 SPECIAL NOTE FOR SEMI-LIGHT WEIGHT CONCRETE FOR USE IN PRESTRESSED CONCRETE BEAMS.

AMERICAN ENGINEERING COMPANY  
 CONSULTING ENGINEERS  
 LEXINGTON, KENTUCKY  
  
 JANSSEN & SPAANS ENGINEERING  
 CONSULTING ENGINEERS  
 INDIANAPOLIS, INDIANA

U.S. 62/68 OVER LAWRENCE CREEK SHEET 1  
**COMMONWEALTH OF KENTUCKY**  
**DEPARTMENT OF HIGHWAYS**  
 FRANKFORT  
 COUNTY OF  
**MASON**  
 U.S. 62/68  
 ROAD  
 STATION 192+67.50 P. E. PROJECT NO. FD 04 0062 N 017-018 J  
 CONSTRUCTION PROJECT NO. MAINTENANCE PROJECT NO. DRAWING NO.  
23687

DESIGNED BY: \_\_\_\_\_ CHECKED BY: \_\_\_\_\_ DATE: 6/24  
 DETAILED BY: \_\_\_\_\_ CHECKED BY: \_\_\_\_\_ DATE: 6/24  
 PREPARED BY: \_\_\_\_\_ CHECKED BY: \_\_\_\_\_ DATE: 6/24  
 REVISIONS: \_\_\_\_\_ DATE: \_\_\_\_\_  
 REVISIONS: \_\_\_\_\_ DATE: \_\_\_\_\_  
 REVISIONS: \_\_\_\_\_ DATE: \_\_\_\_\_  
 REVISIONS: \_\_\_\_\_ DATE: \_\_\_\_\_

**SPECIFICATIONS**

ALL REFERENCES TO THE STANDARD SPECIFICATIONS ARE TO THE 1991 EDITION OF THE KENTUCKY DEPARTMENT OF HIGHWAYS STANDARD SPECIFICATIONS FOR ROAD AND BRIDGE CONSTRUCTION.

ALL REFERENCES TO THE AASHTO SPECIFICATIONS ARE TO THE 1992 EDITION OF THE AASHTO STANDARD SPECIFICATIONS FOR HIGHWAY BRIDGES WITH INTERIMS THRU 1993.

**DESIGN LOAD**

THIS BRIDGE IS DESIGNED FOR HS25 LIVE LOAD OR ALTERNATE LOADING OF TWO 24-KIP AXLES SPACED FOUR FEET APART, WHICHEVER PRODUCES THE GREATER STRESS. THE HS25 LIVE LOAD IS ARRIVED AT BY INCREASING THE STANDARD HS20-44 TRUCK AND LANE LOADS AS SPECIFIED IN THE AASHTO SPECIFICATIONS BY 25%. THIS BRIDGE IS DESIGNED FOR A WIND LOAD BASED ON A WIND VELOCITY OF 84 MPH.

**DESIGN METHOD**

ALL REINFORCED CONCRETE MEMBERS ARE DESIGNED BY THE LOAD FACTOR METHOD AS SPECIFIED IN THE CURRENT AASHTO SPECIFICATIONS.

**MATERIALS DESIGN SPECIFICATIONS**

- FOR CLASS "A" REINFORCED CONCRETE F'C = 3500 PSI
- FOR CLASS "AA" REINFORCED CONCRETE F'C = 4000 PSI
- FOR STEEL REINFORCEMENT F<sub>y</sub> = 60000 PSI
- FOR PRESTRESSED GIRDER CONCRETE F'C = 7000 PSI
- FOR PRESTRESSING STRAND F'S = 270,000 PSI

**MATERIALS**

ASTM OR AASHTO SPECIFICATIONS, CURRENT EDITION, AS DESIGNATED BELOW SHALL GOVERN THE MATERIALS FURNISHED.

- AASHTO M270 GRADE 36 STRUCTURAL STEEL, 36,000 PSI MINIMUM YIELD
- AASHTO M203 LOW RELAXATION UNCOATED SEVEN-WIRE STABILIZED STRAND FOR PRESTRESSED CONCRETE, GRADE 270 (SUPPLEMENT S1)
- AASHTO M-31 DEFORMED AND PLAIN BILLET-STEEL BARS FOR CONCRETE REINFORCEMENT, GRADE 60
- AASHTO M153 PREMOLDED CORK

**PREFORMED CORK EXPANSION JOINT MATERIAL**

PREFORMED EXPANSION JOINT MATERIAL SHALL CONFORM TO SUBSECTION 807.03.02 (TYPE 11) OF THE KENTUCKY DEPARTMENT OF HIGHWAYS SPECIFICATIONS.

**EPOXY COATED REINFORCING STEEL**

ALL REINFORCING BARS DESIGNATED BY SUFFIX (E) IN THE PLANS SHALL BE EPOXY COATED IN ACCORDANCE WITH SECTION B11.10 OF THE STANDARD SPECIFICATIONS.

**CONCRETE**

CLASS "AA" CONCRETE IS TO BE USED THROUGHOUT THE SUPERSTRUCTURE AND IN THE PORTIONS OF THE SUBSTRUCTURE ABOVE THE TOP OF THE CAPS EXCEPT IN THE PEDESTALS. CLASS "A" CONCRETE IS TO BE USED IN THE PEDESTALS AND IN THE SUBSTRUCTURE BELOW THE TOP OF THE CAPS. PRESTRESSED GIRDER CONCRETE SHALL BE IN ACCORDANCE WITH THE PLANS AND SPECIFICATIONS.

**REINFORCEMENT**

DIMENSIONS SHOWN FROM THE FACE OF CONCRETE TO BARS ARE CLEAR DISTANCES UNLESS OTHERWISE SHOWN. SPACING OF BARS IS FROM CENTER TO CENTER OF BARS.

**CONSTRUCTION IDENTIFICATION**

THE NAMES OF THE PRIME CONTRACTOR AND THE SUB-CONTRACTOR SHALL BE IMPRINTED IN THE CONCRETE WITH ONE INCH LETTERS AT A LOCATION DESIGNATED BY THE ENGINEER. THE CONTRACTOR SHALL FURNISH ALL PLANS, EQUIPMENT AND LABOR NECESSARY TO DO THE WORK FOR WHICH NO DIRECT PAYMENT WILL BE MADE.

**TEMPORARY SUPPORTS**

TEMPORARY SUPPORTS OR SHORING WILL NOT BE PERMITTED UNDER THE GIRDERS WHEN POURING THE CONCRETE FLOOR SLAB OR WHEN TAKING "TOP OF BEAM" ELEVATIONS.

**BEVELED EDGES**

ALL EXPOSED EDGES SHALL BE BEVELED 7/8" UNLESS OTHERWISE SHOWN.

**DIMENSIONS**

DIMENSIONS ARE FOR A NORMAL TEMPERATURE OF 60 DEGREES FAHRENHEIT. LAYOUT DIMENSIONS ARE HORIZONTAL MEASUREMENTS.

**BILL OF INCIDENTAL MATERIAL**

THE QUANTITIES SHOWN IN THE BILL OF INCIDENTAL MATERIALS ARE APPROXIMATE ONLY AND THE CONTRACTOR IS RESPONSIBLE FOR FURNISHING ENOUGH MATERIAL TO COMPLETE THE WORK IN ACCORDANCE WITH THE PLANS AND SPECIFICATIONS. THE COST OF THESE ITEMS IS TO BE INCLUDED IN THE UNIT PRICE BID FOR THE QUANTITIES SPECIFIED IN THE "BILL OF INCIDENTAL MATERIALS" TABLE.

**FOOTING EXCAVATION**

SPECIAL CARE SHALL BE TAKEN NOT TO DISTURB THE BOTTOM OF THE EXCAVATION, AND THE FINAL REMOVAL OF THE FOUNDATION MATERIAL TO GRADE SHALL NOT BE MADE UNTIL JUST BEFORE THE MASONRY IS TO BE PLACED. THE EXCAVATION SHALL BE MAINTAINED FREE OF STANDING WATER, INSOFAR AS PRACTICABLE.

**POURING SEQUENCE**

THE POURING SEQUENCE OF THE SLAB MAY BE CHANGED WITH THE WRITTEN APPROVAL OF THE ENGINEER.

**CONTROL OF HORIZONTAL EARTH PRESSURE**

IN ORDER TO ALLEVIATE EXCESSIVE HORIZONTAL EARTH PRESSURE ON THE END BENT, PLACEMENT OF BACKFILL BEHIND THE END BENT BACKWALL ABOVE THE TOP OF CAP ELEVATION WILL NOT BE ALLOWED UNTIL THE SUPERSTRUCTURE AND DECK ARE IN PLACE.

**PLAN ELEVATION FOR FOOTINGS**

WHEN SUITABLE ROCK IS ENCOUNTERED AT A DATUM ELEVATION HIGHER THAN THE PLAN ELEVATION, THE HIGHER ELEVATION MAY BE UTILIZED FOR BEARING AS OUTLINED IN THE SPECIFICATIONS. WHEN THE BOTTOM OF FOOTING ELEVATION DIFFERS FROM THAT ELEVATION SHOWN ON PLANS, THE ELEVATION DATA SHALL BE SUBMITTED TO THE DIRECTOR, DIVISION OF BRIDGES TO BE PLACED ON ORIGINAL PLANS.

**PILE DATA**

PILING SHALL BE DRIVEN TO THE "REQUIRED DRIVING RESISTANCE" AS SHOWN IN THE PILE RECORD.

TEST PILES SHALL BE DRIVEN WHERE DESIGNATED ON THE PLANS TO DETERMINE THE LENGTH OF PILE REQUIRED.

ALL TEST PILES SHALL BE ACCURATELY LOCATED SO THAT THEY MAY BE USED IN THE FINISHED STRUCTURE.

CONTRARY TO THE STANDARD DRAWINGS FOR STEEL PILES, MILL TEST REPORTS ARE NOT REQUIRED TO BE NOTARIZED.

**PILE POINTS**

ALL PILES REQUIRE 14" PILE POINTS. THE POINTS SHALL BE THE TYPE FOR KEYING INTO A SLOPING ROCK SURFACE. THE "SPECIAL NOTE FOR PILE POINTS" SHALL APPLY TO THIS WORK.

**FOUNDATION DATA**

SPREAD FOOTING FOUNDATIONS ARE DESIGNED FOR PRESSURES AS SHOWN IN SPREAD FOOTING RECORD ON FOUNDATION LAYOUT.

**COFFERDAMS**

COFFERDAMS MAY BE NECESSARY FOR CONSTRUCTION OF PIERS 2 AND 3. THE COST OF ANY COFFERDAM SHALL BE INCIDENTAL TO COST OF STRUCTURE EXCAVATION, COMMON.

**PAYMENT FOR PRECAST CONCRETE BEAMS**

THE BASIS OF PAYMENT FOR THE PRESTRESSED CONCRETE BEAMS SHALL BE AT THE CONTRACT UNIT PRICE PER LINEAR FOOT OF BEAM, IN ACCORDANCE WITH THE SPECIFICATIONS.

**TESTING PRESTRESSED CONCRETE MEMBERS**

IN ADDITION TO THE REQUIREMENTS OF SECTION 605 OF THE DEPARTMENT'S STANDARD SPECIFICATIONS, FABRICATORS OF PRESTRESSED CONCRETE MEMBERS SHALL FURNISH, AS PART OF THEIR QUALITY CONTROL EQUIPMENT, A PACHOMETER FOR DETERMINING THE DEPTH OF CONCRETE COVER OVER STEEL REINFORCEMENT. THE METER FURNISHED SHALL BE AN "R" METER AS MANUFACTURED BY JAMES ELECTRONICS, INC., CHICAGO, ILLINOIS OR APPROVED EQUAL. THE PACHOMETER SHALL BE AVAILABLE FOR USE BY BOTH THE FABRICATOR'S QUALITY CONTROL PERSONNEL AND BY THE DEPARTMENT'S INSPECTOR(S).

NO SEPARATE PAYMENT WILL BE MADE FOR FURNISHING THE METER AS THIS IS CONSIDERED INCIDENTAL TO THE PRESTRESSED CONCRETE WORK.

**PAYMENT FOR STRUCTURAL STEEL**

THE LUMP SUM BID FOR STRUCTURAL STEEL SHALL BE FULL PAYMENT FOR ALL STRUCTURAL STEEL, BOLTS, WASHERS, WELDING AND WELDING MATERIALS, DRAINS, PAINT AND ALL LABOR AND MATERIALS NECESSARY TO ERECT THE STEEL IN ACCORDANCE WITH THE PLANS AND SPECIFICATIONS. THE APPROXIMATE WEIGHT OF STRUCTURAL STEEL SHOWN IN THE ESTIMATE OF QUANTITIES DOES NOT INCLUDE OVERRUN OR WELD MATERIAL.

**SELECT GRANULAR EMBANKMENT**

ALL REFERENCES IN THE PLANS TO SELECT GRANULAR EMBANKMENT SHALL BE INTERPRETED TO MEAN STRUCTURE GRANULAR BACKFILL OR ROADWAY FILL-GRANULAR EMBANKMENT AS APPLICABLE.

**SHOP DRAWINGS**

WHEN ANY CHANGES IN THE DESIGN PLANS ARE PROPOSED BY THE FABRICATOR OR SUPPLIER, THE SHOP DRAWINGS REFLECTING THESE CHANGES SHALL BE SUBMITTED TO THE DEPARTMENT THROUGH THE CONTRACTOR.

**DRAIN DETAILS**

FOUNDRIES SHALL CAST AT LEAST TWO TEST BARS FROM EACH DAYS PRODUCTION. THESE TEST BARS SHALL BE TESTED EITHER BY THE DIVISION OF MATERIALS OR BY THE FOUNDRIES QUALITY CONTROL UNIT WHO SHALL FURNISH ACTUAL TEST RESULTS FOR EACH DATE OF MANUFACTURE OR LOT NUMBER. DRAINS SHALL BE PAINTED INSIDE AND OUT.

THE DRAIN PIPE SHALL BE 6" ROUND STANDARD WEIGHT IN ACCORDANCE WITH ASTM-A53, A500, OR A501. PIPE AND ALL FITTINGS SHALL BE GALVANIZED INSIDE AND OUT IN ACCORDANCE WITH AASHTO M111. PAINTING NOT REQUIRED.

COST OF DRAINS, DRAIN PIPE, FITTINGS, CONNECTIONS AND BRACKET HARDWARE SHALL BE INCLUDED IN THE LUMP SUM PRICE FOR STRUCTURAL STEEL.

**ELASTOMERIC BEARINGS**


THE MATERIAL SPECIFICATIONS FOR ELASTOMERIC BEARING PADS SHALL CONFORM TO THE AASHTO STANDARD SPECIFICATIONS FOR HIGHWAY BRIDGES, EXCEPT THE LOW TEMPERATURE TEST IS WAIVED. THE ELASTOMER SHALL HAVE A DUROMETER HARDNESS OF 60, AND A LOW TEMPERATURE GRADE OF 2 (OR MORE). THE COST OF THIS ITEM IS TO BE INCLUDED IN THE PRICE PER LINEAR FOOT FOR PRECAST BEAMS.




**GENERAL NOTES**

U.S. 62/68 OVER LAWRENCE CREEK SHEET 2  
**COMMONWEALTH OF KENTUCKY**  
**DEPARTMENT OF HIGHWAYS**  
 FRANKFORT  
 COUNTY OF  
**MASON**  
 U.S. 62/68  
 ROAD  
 STATION 182+67.50 P.E. PROJECT NO.  
 CONSTRUCTION PROJECT NO. MAINTENANCE PROJECT NO. DRAWING NO. 23687

UPDATE DATE  
LETTING DATE

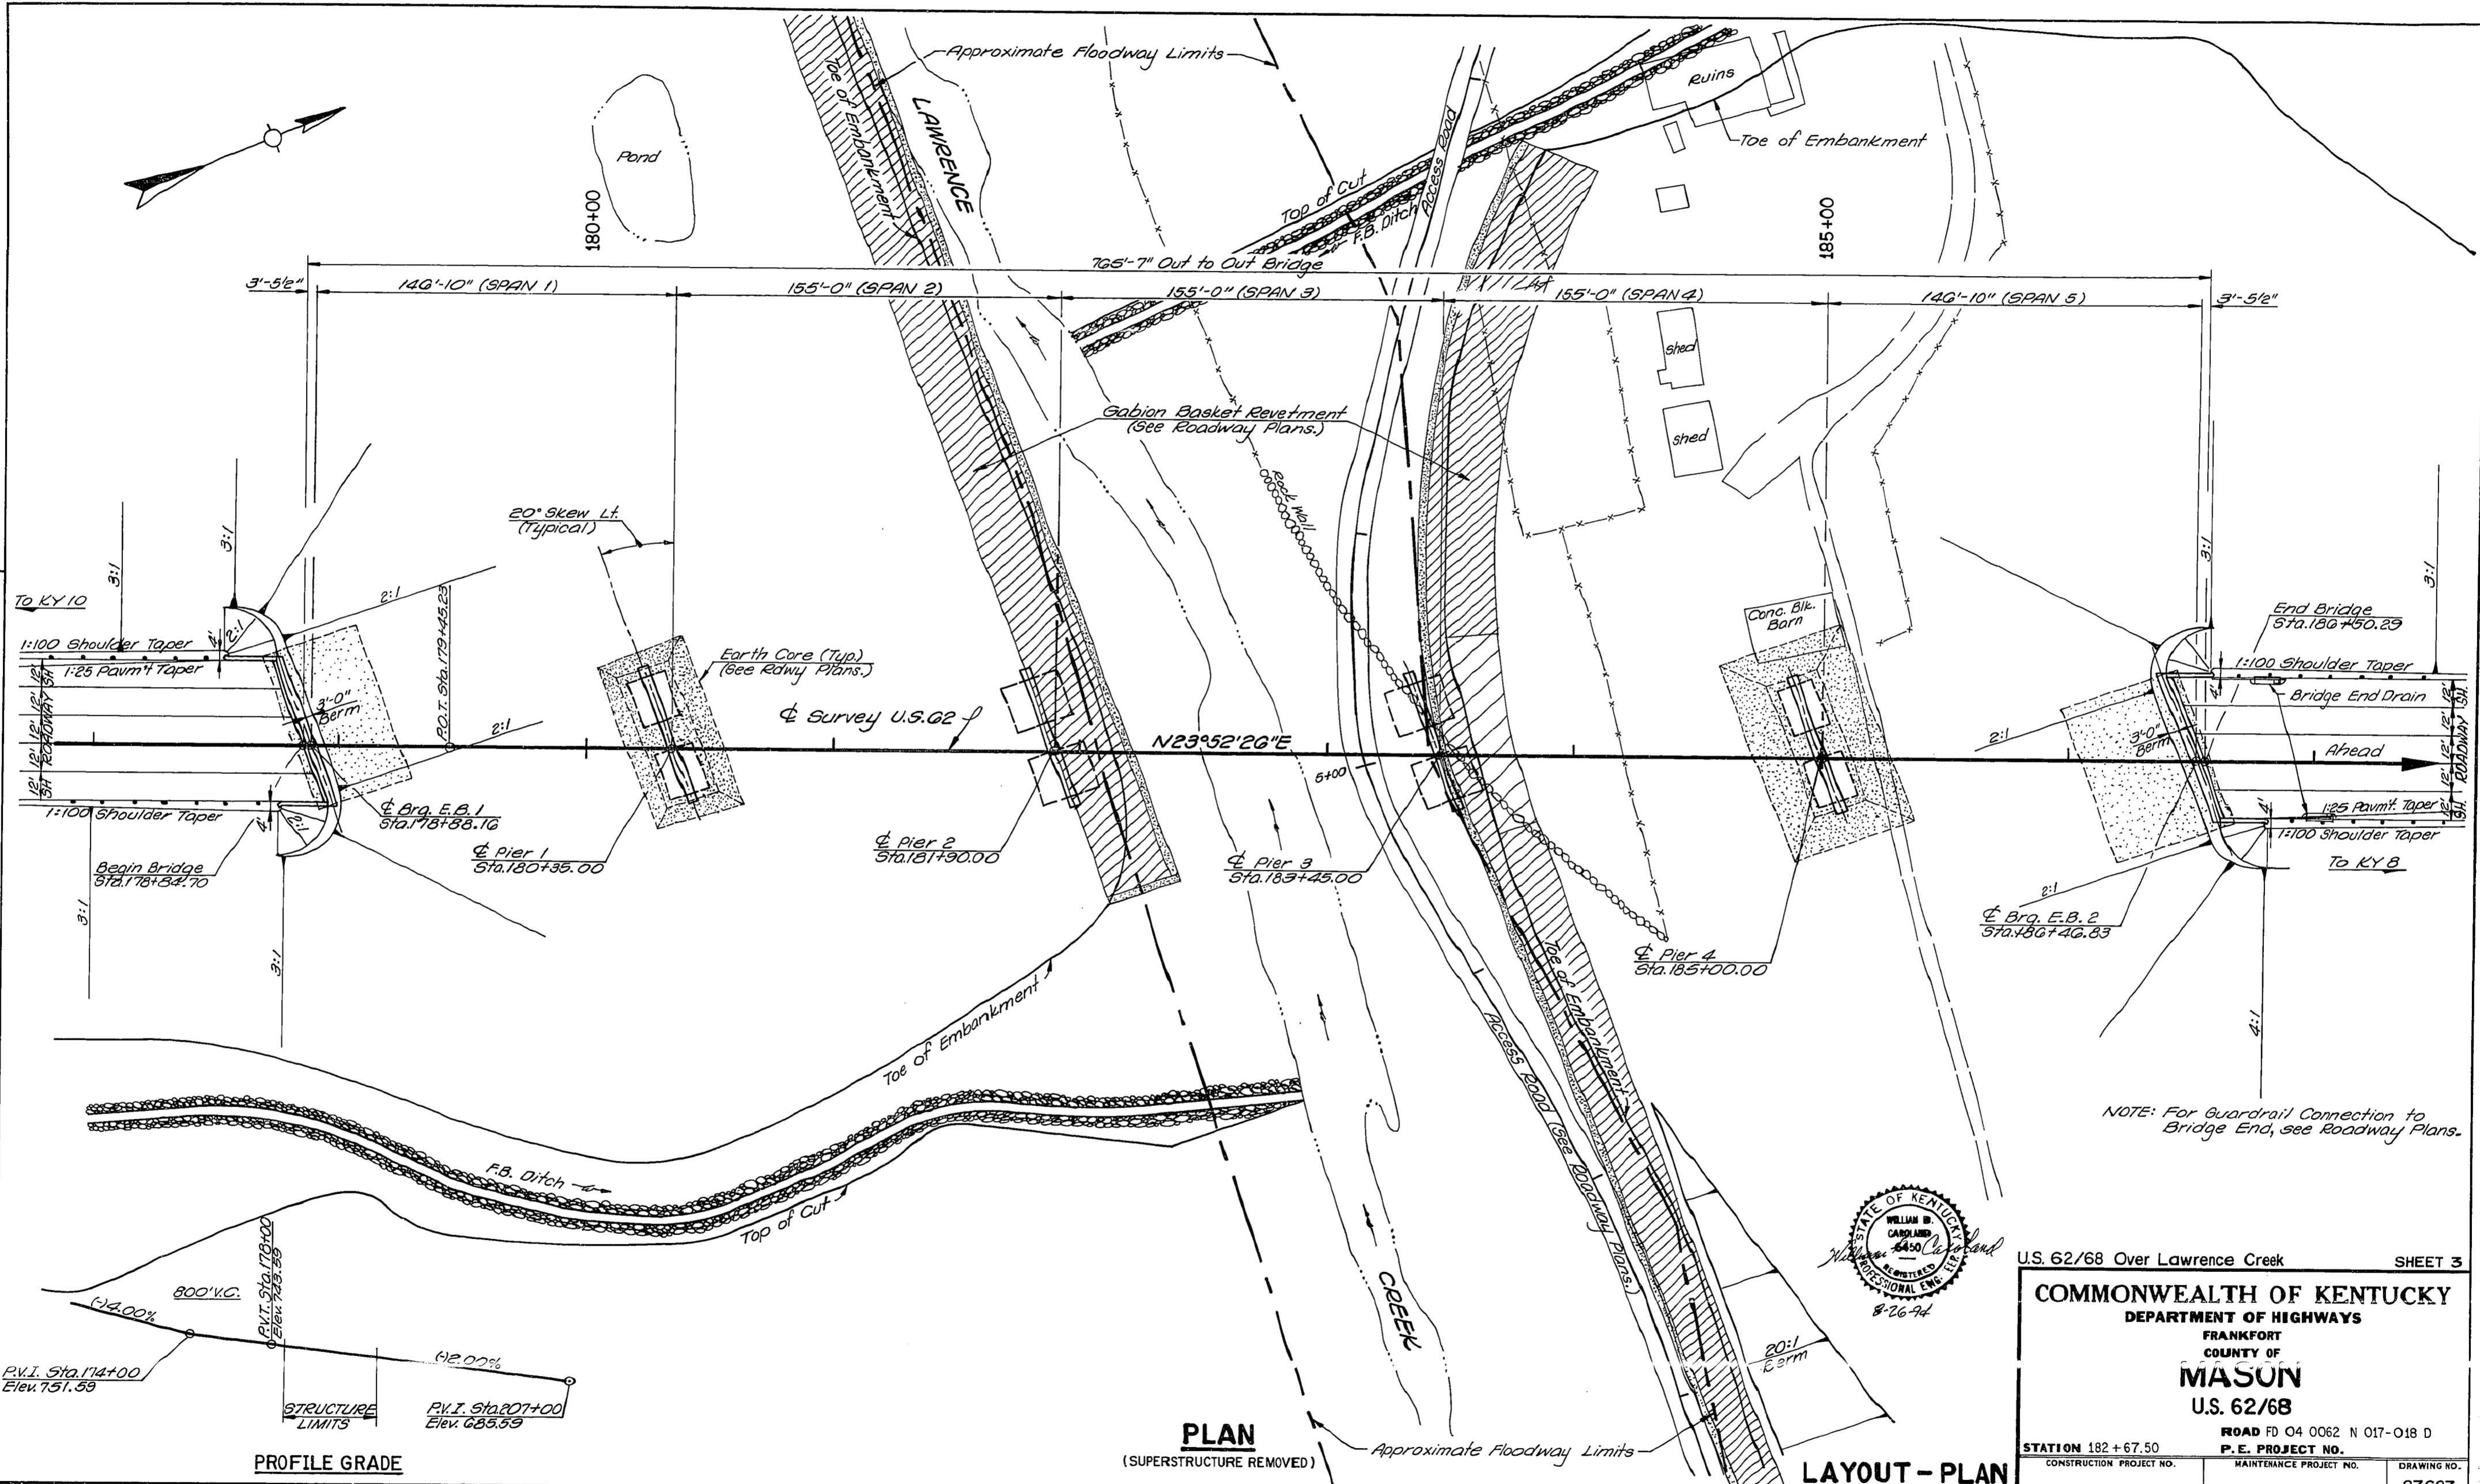

DESIGNED BY	DATE	DATE
CHECKED BY	DATE	DATE
APPROVED BY	DATE	DATE
PROJECT NO.	DATE	DATE
DATE	DATE	DATE

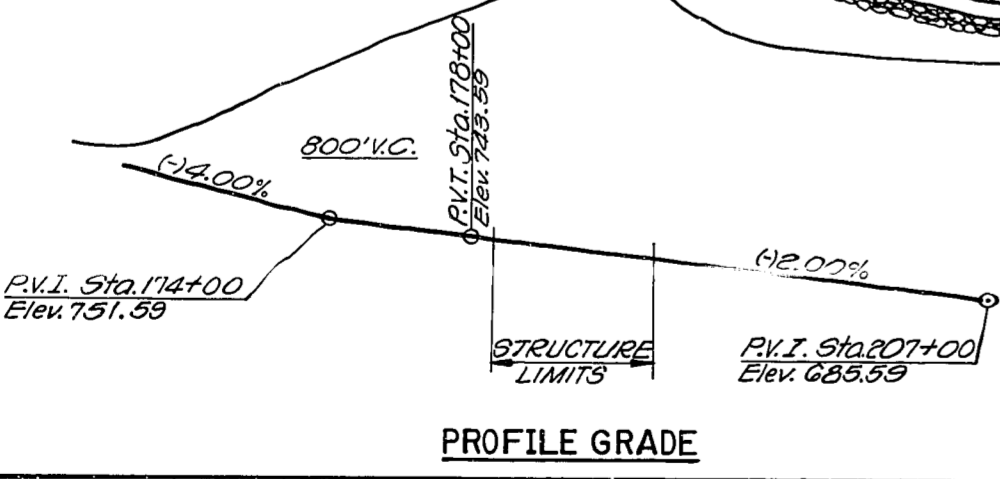

PLAN  
(SUPERSTRUCTURE REMOVED)


LAYOUT - PLAN

U.S. 62/68 Over Lawrence Creek SHEET 3

**COMMONWEALTH OF KENTUCKY**  
DEPARTMENT OF HIGHWAYS  
FRANKFORT  
COUNTY OF  
**MASON**  
U.S. 62/68

ROAD FD 04 0062 N 017-018 D  
P. E. PROJECT NO.


STATION 182+67.50  
CONSTRUCTION PROJECT NO. MAINTENANCE PROJECT NO. DRAWING NO. 23687

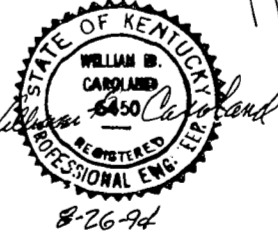

NOTE: For Guardrail Connection to Bridge End, see Roadway Plans.



UPDATE DATE  
LETTING DATE

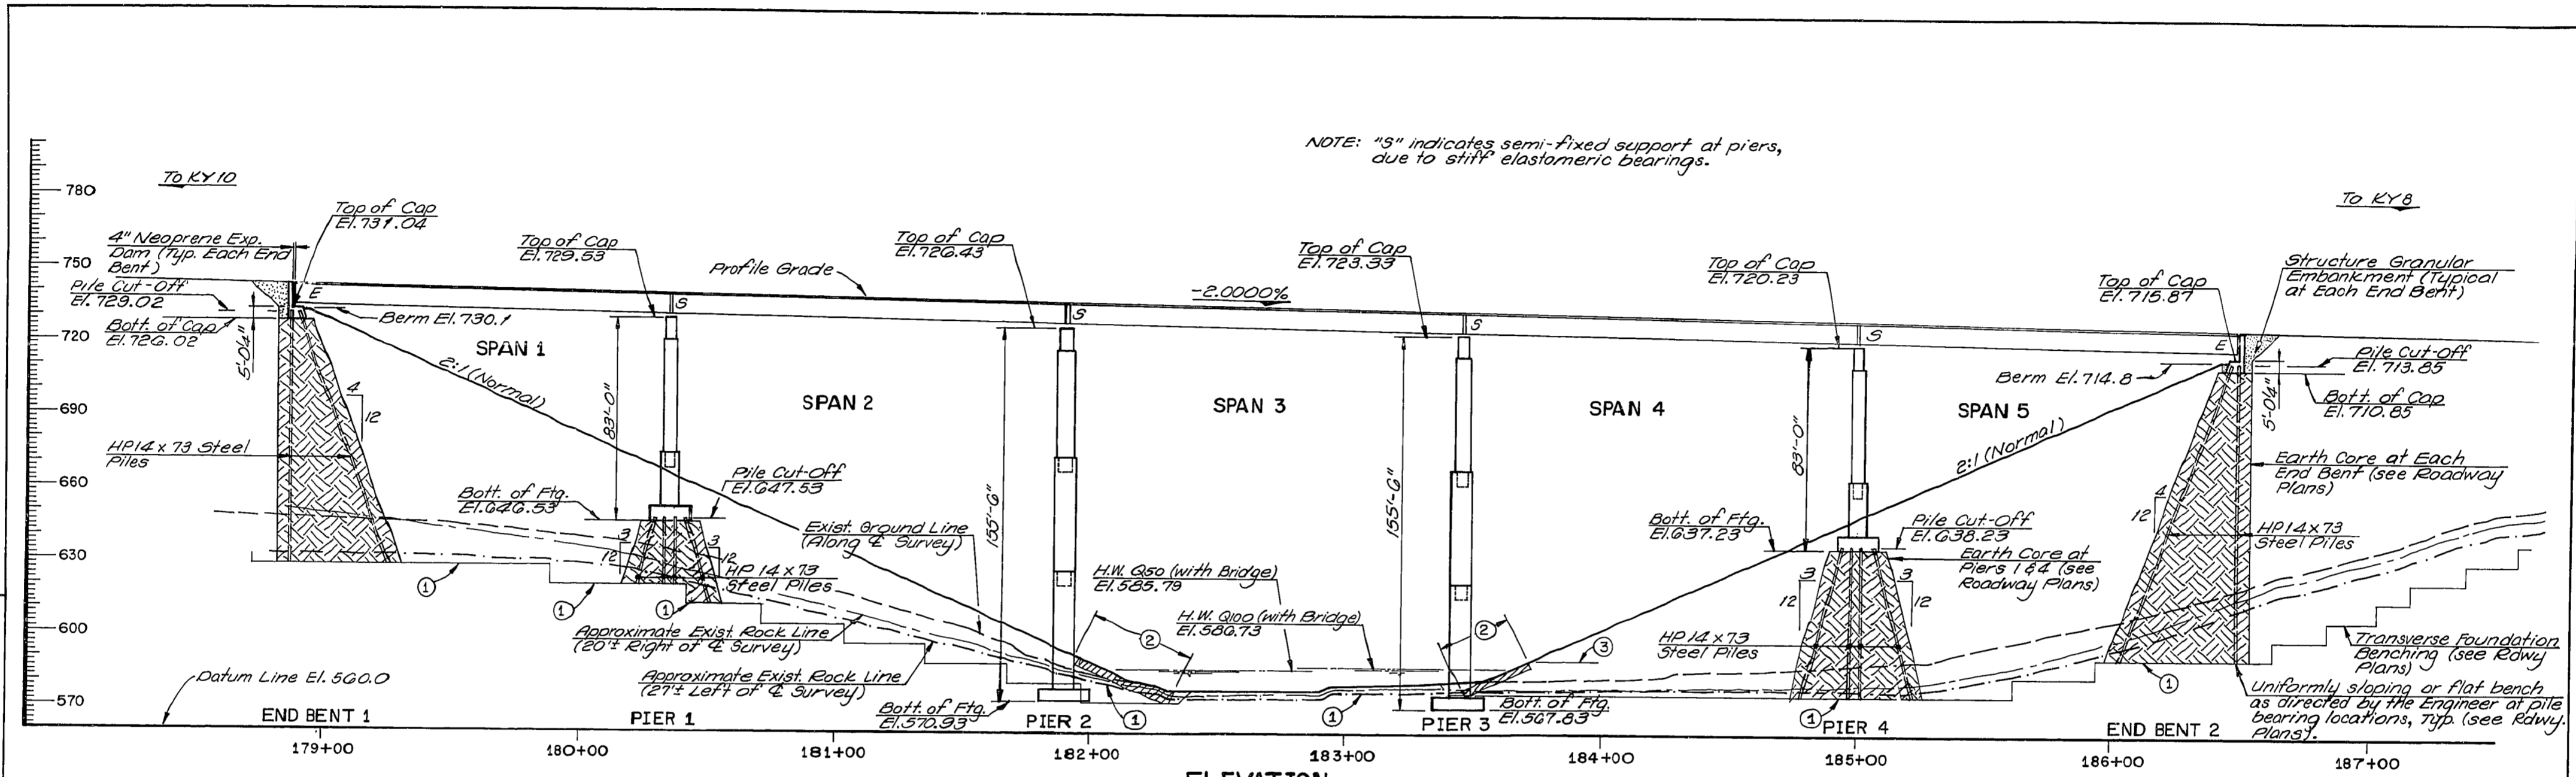


**ELEVATION**

146'-10" ~ 155'-0" ~ 155'-0" ~ 155'-0" ~ 146'-10" 90° P.R.C. I-Beams  
(Continuous for Live Load; Composite)  
HS25 Live Load, 60'-0" Roadway, 20° Skew Left,  
68'-0" Out to Out Shoulder at Bridge, 2:1 Fill Slopes


**NOTATIONS**

- ① Rock Line is the Potential Scour Limit.
- ② Gabion Basket Retement (see Roadway Plans)
- ③ Protect from Rock Line up to El. 590

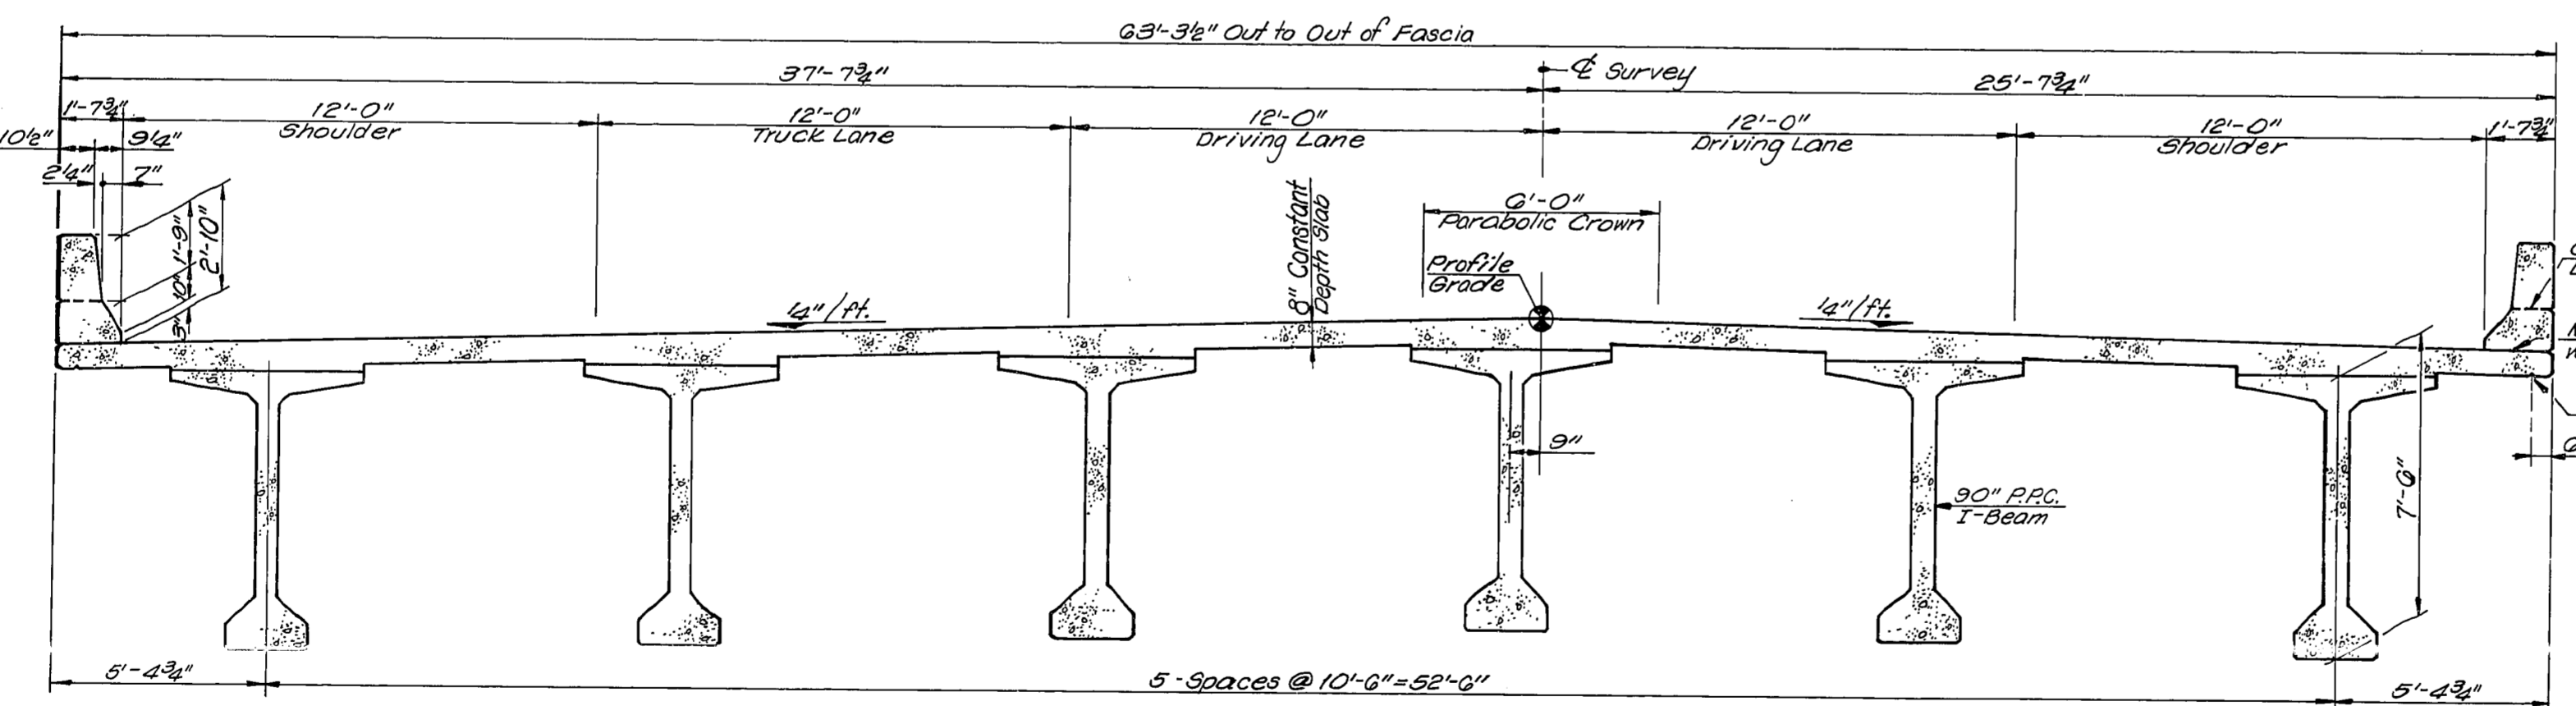

**TYPICAL DECK SECTION**  
(Looking Ahead)

**ELEVATION AND TYPICAL DECK SECTION**

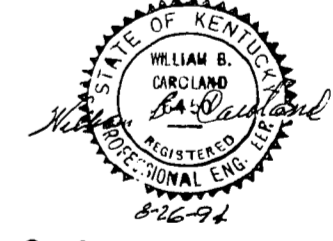


U.S. 62/68 Over Lawrence Creek SHEET 4  
**COMMONWEALTH OF KENTUCKY**  
 DEPARTMENT OF HIGHWAYS  
 FRANKFORT  
 COUNTY OF MASON  
 U.S. 62/68  
 ROAD FD 04 0062 N 017-018 D  
 STATION 182+67.50 P. E. PROJECT NO.  
 CONSTRUCTION PROJECT NO. MAINTENANCE PROJECT NO. DRAWING NO.  
 23687

DESIGNED BY: MBO  
 CHECKED BY: LCC  
 DATE: 6/24/68  
 DRAWN BY: LEB  
 DATE: 6/24/68  
 PROJECT NO.: 04 0062 N 017-018 D  
 SHEET NO.: 4  
 DRAWING NO.: 23687


# SUBSURFACE DATA

UPDATE DATE  
LETTING DATE

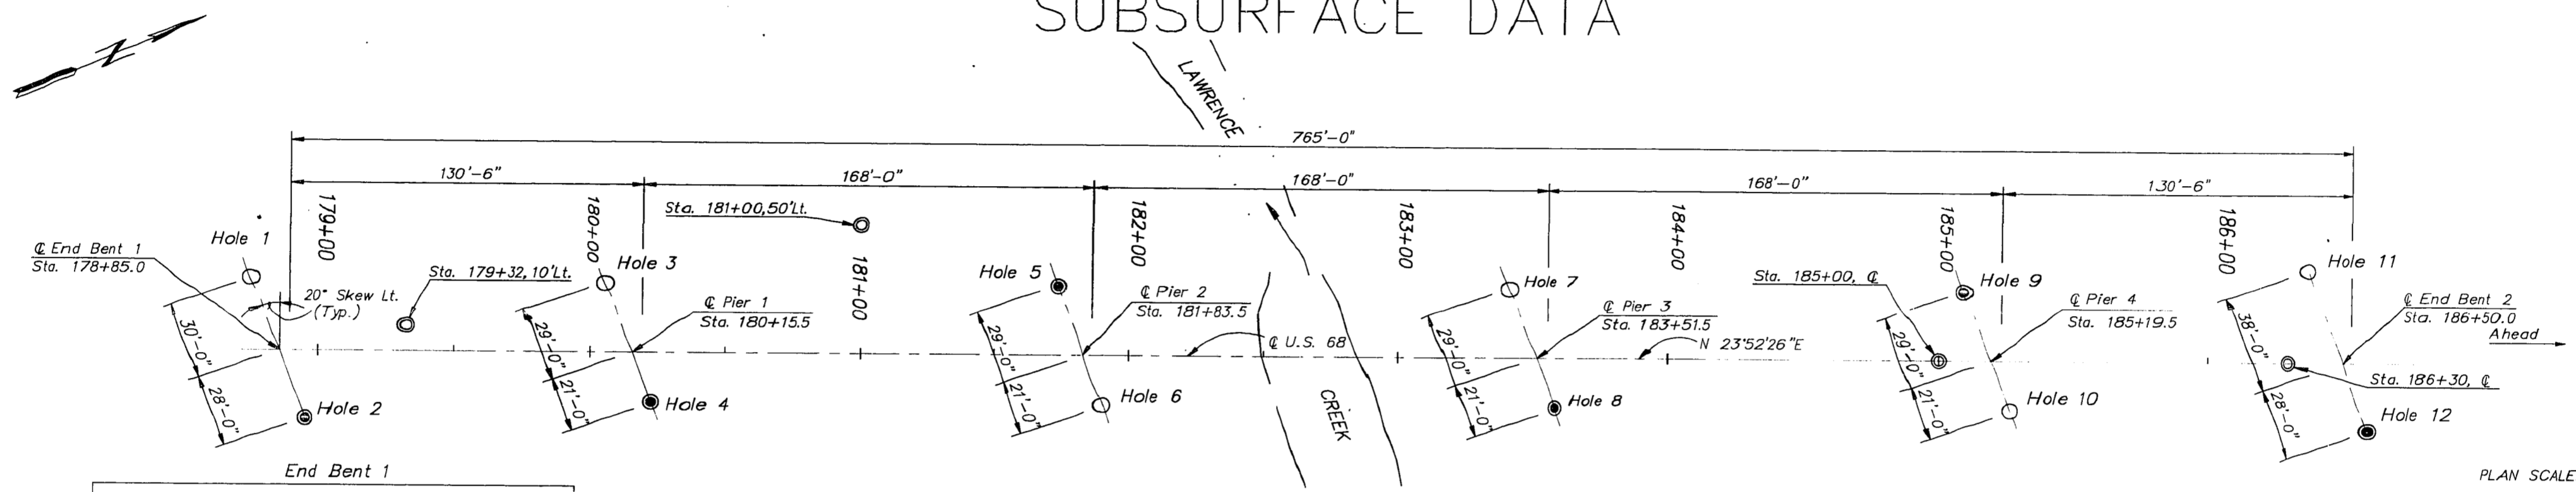

PLAN SCALE: 1"=30'

DESIGNED BY: \_\_\_\_\_ DATE: \_\_\_\_\_  
 CHECKED BY: \_\_\_\_\_ DATE: \_\_\_\_\_  
 REVISION: \_\_\_\_\_ DATE: \_\_\_\_\_  
 TRACED BY: \_\_\_\_\_ DATE: \_\_\_\_\_

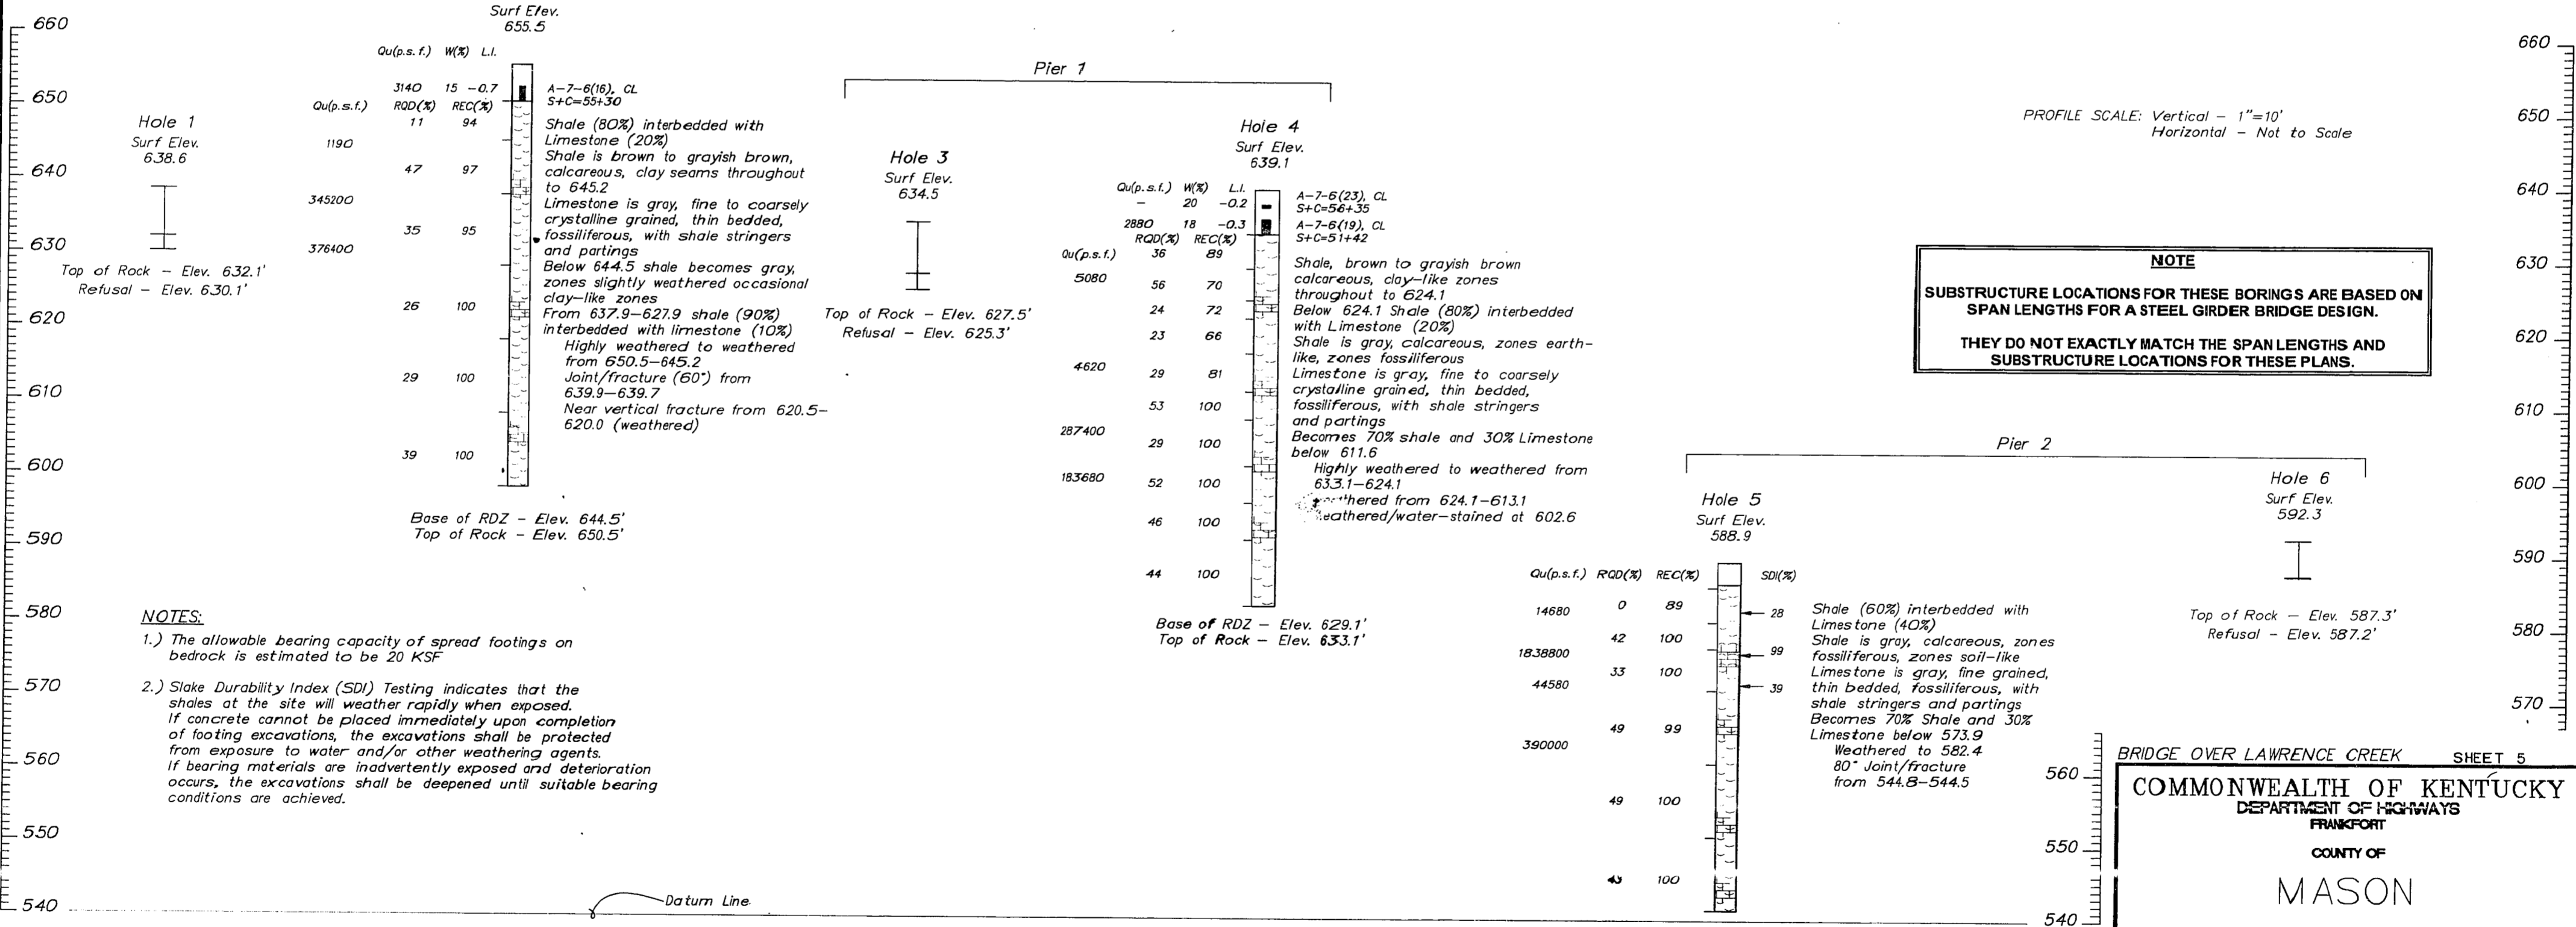

PROFILE SCALE: Vertical - 1"=10'  
Horizontal - Not to Scale

**NOTE**  
 SUBSTRUCTURE LOCATIONS FOR THESE BORINGS ARE BASED ON SPAN LENGTHS FOR A STEEL GIRDER BRIDGE DESIGN.  
 THEY DO NOT EXACTLY MATCH THE SPAN LENGTHS AND SUBSTRUCTURE LOCATIONS FOR THESE PLANS.


**NOTES:**  
 1.) The allowable bearing capacity of spread footings on bedrock is estimated to be 20 KSF  
 2.) Slake Durability Index (SDI) Testing indicates that the shales at the site will weather rapidly when exposed. If concrete cannot be placed immediately upon completion of footing excavations, the excavations shall be protected from exposure to water and/or other weathering agents. If bearing materials are inadvertently exposed and deterioration occurs, the excavations shall be deepened until suitable bearing conditions are achieved.

BRIDGE OVER LAWRENCE CREEK SHEET 5  
 COMMONWEALTH OF KENTUCKY  
 DEPARTMENT OF HIGHWAYS  
 FRANKFORT  
 COUNTY OF  
 MASON  
 ROAD SSP 081 0062 017-018 D  
 P.E. PROJECT NO. FD040062N017-018  
 STATION 182+67.5  
 DRAWING NO. 23687

# SUBSURFACE DATA

UPDATE DATE \_\_\_\_\_  
 LETTING DATE \_\_\_\_\_

DESIGNED BY: \_\_\_\_\_ DATE: \_\_\_\_\_  
 CHECKED BY: \_\_\_\_\_ DATE: \_\_\_\_\_  
 TRACED BY: \_\_\_\_\_ DATE: \_\_\_\_\_  
 REVISIONS: \_\_\_\_\_ DATE: \_\_\_\_\_  
 REVISIONS: \_\_\_\_\_ DATE: \_\_\_\_\_  
 REVISIONS: \_\_\_\_\_ DATE: \_\_\_\_\_

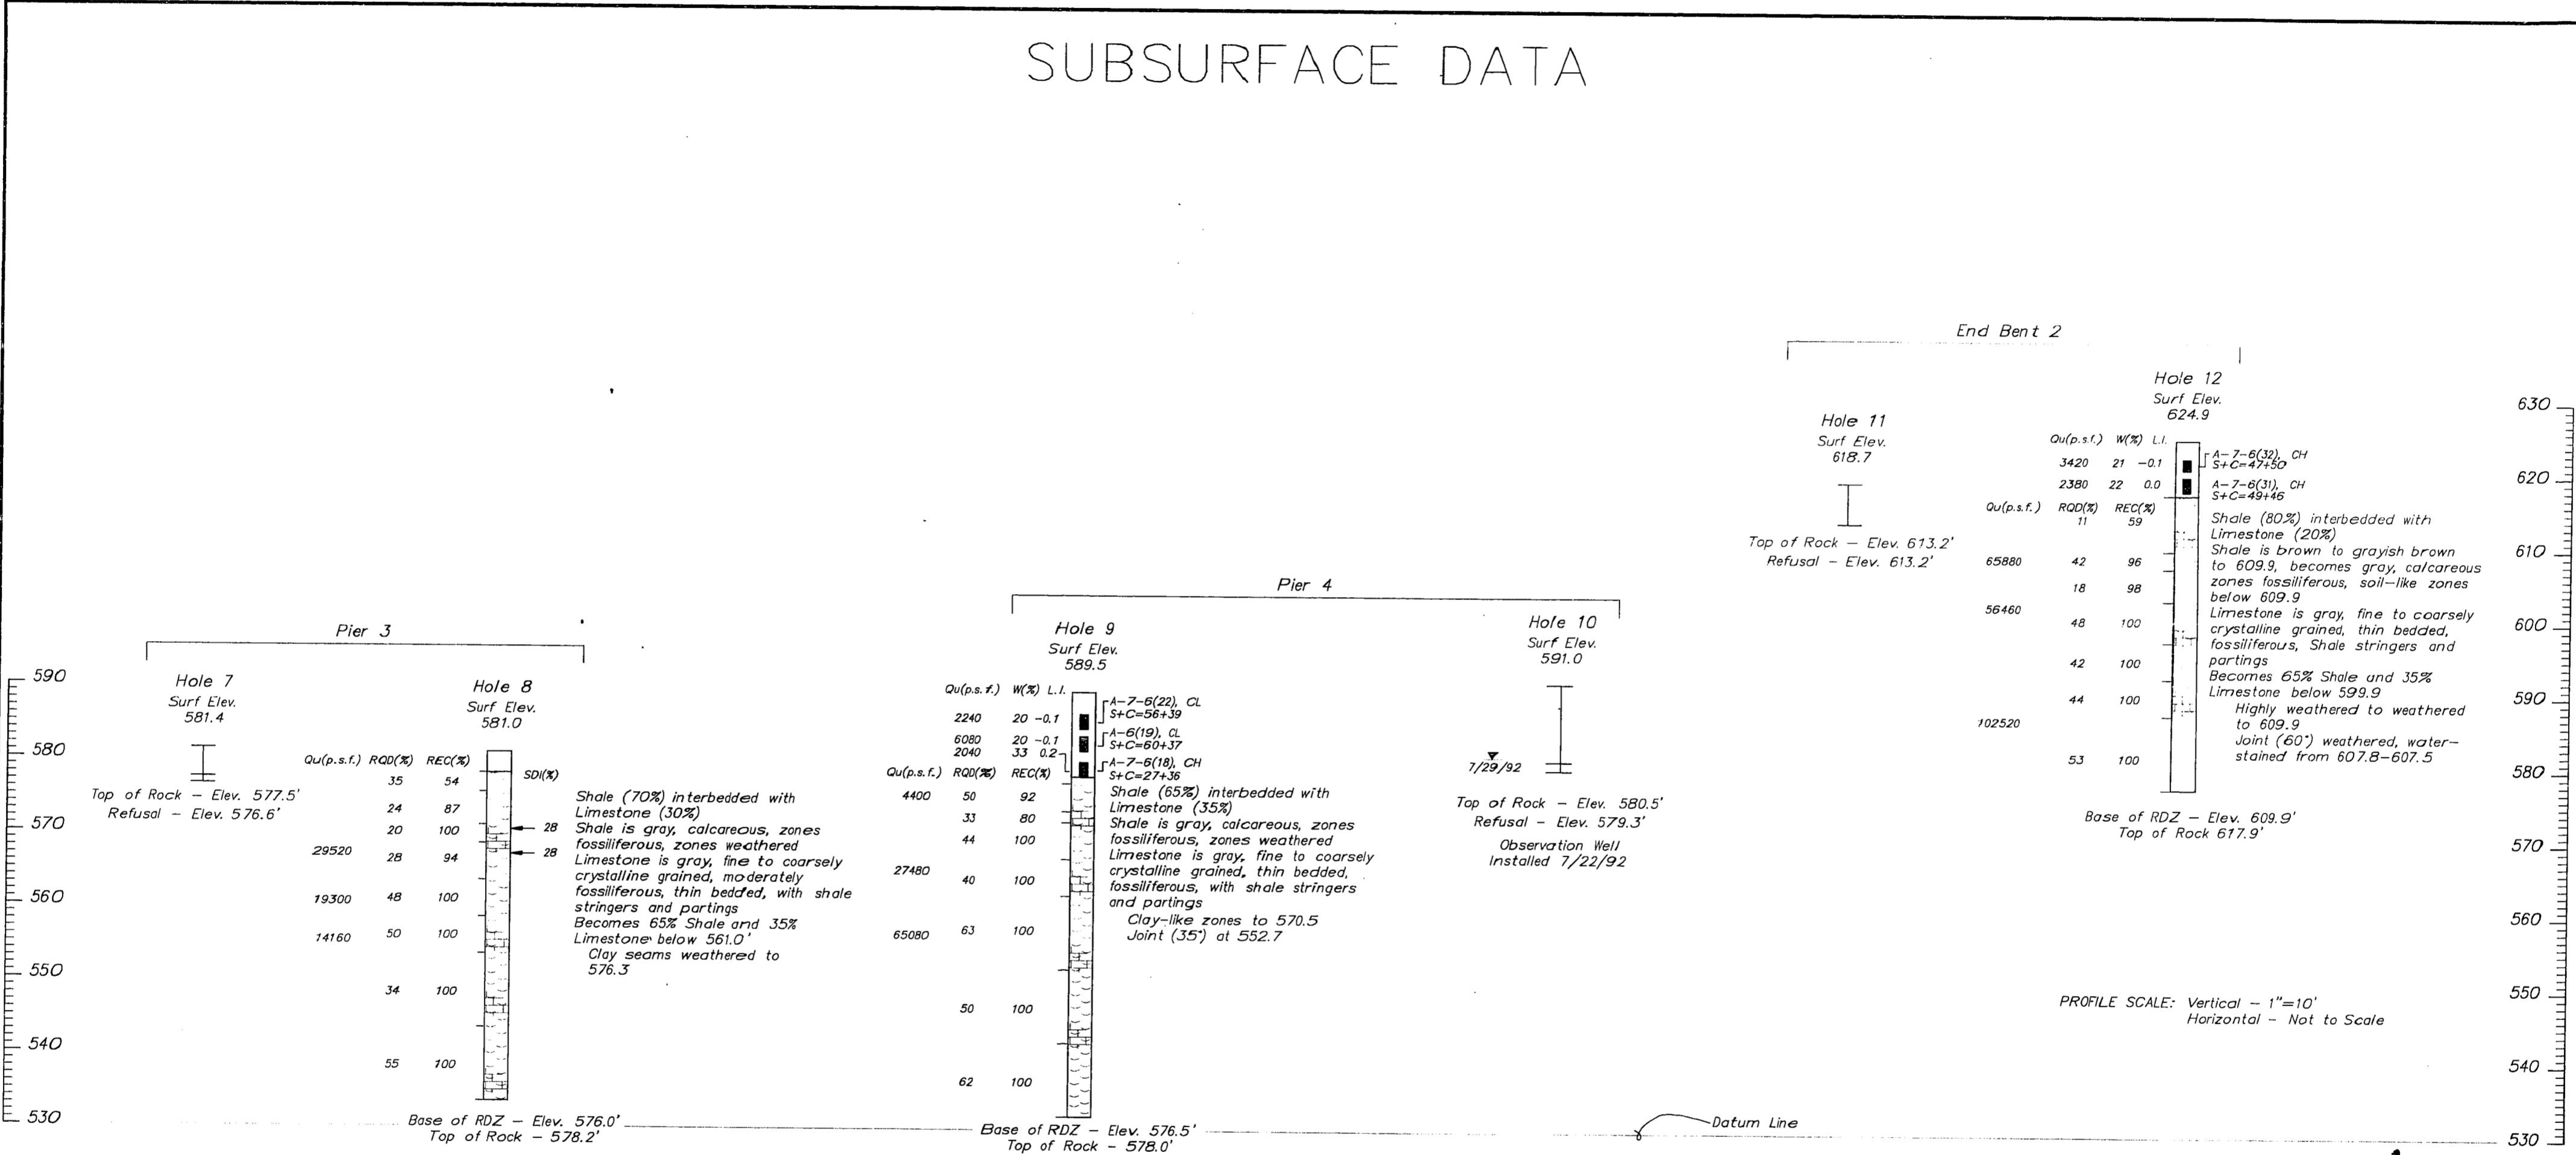

**NOTE**

SUBSTRUCTURE LOCATIONS FOR THESE BORINGS ARE BASED ON SPAN LENGTHS FOR A STEEL GIRDER BRIDGE DESIGN.

THEY DO NOT EXACTLY MATCH THE SPAN LENGTHS AND SUBSTRUCTURE LOCATIONS FOR THESE PLANS.

BRIDGE OVER LAWRENCE CREEK SHEET 6

COMMONWEALTH OF KENTUCKY  
DEPARTMENT OF HIGHWAYS  
FRANKFORT  
COUNTY OF  
**MASON**

ROAD SSP 081 0062 017-018 D  
P.E. PROJECT NO. FD040062N017-018D

STATION 182+67.5  
CONSTRUCTION PROJECT NO. \_\_\_\_\_ MAINTENANCE PROJECT NO. \_\_\_\_\_ DRAWING NO. **23687**

UPDATE DATE  
LETTING DATE

Description of Soil Compactness or Consistency

SOIL TYPE	COMPACTNESS OR CONSISTENCY	RANGE OF PENETRATION RESISTANCE	RANGE OF UNCONFINED COMPRESSIVE STRENGTH
Coarse grained soils. (More than half of material is larger than No. 200 sieve size.)	Very loose Loose Medium compact Compact Very compact	Less than 4 blows per foot. 4 to 10 10 to 30 30 to 50 Greater than 50	Not applicable
Fine grained soils. (More than half of material is smaller than No. 200 sieve size.)	Very soft Soft Medium stiff Stiff Very stiff Hard	Not applicable	Less than 0.25 tsf 0.25 to 0.5 0.5 to 1.0 1.0 to 2.0 2.0 to 4.0 Greater than 4.0

Unified Soil Classifications

MAJOR DIVISIONS	SYMBOL	NAME
COARSE-GRAINED SOILS	GRAVEL AND GRAVELLY SOILS	GW Well-graded gravels or gravel-sand mixtures, little or no fines.
		GP Poorly graded gravels or gravel-sand mixtures, little or no fines.
		GM Silty gravels, gravel-sand-silt mixtures
	SAND AND SANDY SOILS	GC Clayey gravels, gravel-sand-clay mixtures
		SW Well-graded sands or gravelly, little or no fines
		SP Poorly graded sands or gravelly sands, little or no fines
FINE GRAINED SOILS	SM Silty sands, sand-silt mixture	
	SC Clayey sands, sand-clay mixtures.	
	SILTS AND CLAYS LL IS LESS THAN 50	ML Inorganic silts and very fine sands, rock, flour, silty or clayey fine sands or clayey silts with slight plasticity
		CL Inorganic clays of low to medium plasticity, gravelly clays, sandy clays, silty clays, lean clays
SILTS AND CLAYS LL IS GREATER THAN 50	MH Inorganic silts, micaceous or diatomaceous fine sandy or silty soils, elastic silts	
	CH Inorganic clays of high plasticity, fat clays	
UNCLASSIFIED MATERIAL	NONE	Non-classified material (ie overburden, pavement, coal mine waste, slag, rubble, talus, etc) Include visual description

- N Penetration Resistance
- S + C(%) Material finer than No. 200 sieve
- Rockline Sounding
- ⊖ Disturbed Sample Boring
- ⊙ Undisturbed Sample Boring
- ⊙ Undisturbed Sample Boring and Rock Core
- Rock Core
- ⋯ Slope Inclination Installation
- Approximate Footing Elevation
- ⋮ Water Elevation
- ▬ Thin-walled Tube Sample
- ⊖ Standard Penetration Test Sample
- Qu Unconfined Compressive Strength
- w(%) Moisture Content
- RQD(%) Rock Quality Designation
- SDI(%) Slake Durability Index
- Rec(%) Core Recovery
- ∠ Angle of Internal Friction
- ∠ Effective Angle of Internal Friction
- c Cohesion
- τ Effective Cohesion
- γ Total Unit Weight
- RDZ Rock Disintegration Zone
- OB Overburden Bench
- IB Intermediate Bench
- R Refusal
- NR Refusal Not Encountered
- LI Liquidity Index
- AI Activity Index

- LIMESTONE
- SANDSTONE
- COAL
- SHALE, SOIL-LIKE (SDI ≤ 50)
- SHALE, INTERMEDIATE (50 < SDI < 95)
- SHALE, ROCK-LIKE (SDI ≥ 95)

Relation of RQD and in situ Rock Quality

RQD (%)	Rock Quality
90 - 100	Excellent
75 - 90	Good
50 - 75	Fair
25 - 50	Poor
0 - 25	Very Poor

U.S. 62 OVER LAWRENCE CREEK SHEET 7

COMMONWEALTH OF KENTUCKY  
DEPARTMENT OF HIGHWAYS  
FRANKFORT  
COUNTY OF  
**MASON**  
U.S. 62  
ROAD SSP 081 0062 017-018 D  
STATION 182+67.50 P.E. PROJECT NO. F00400G2N017-018 D  
CONSTRUCTION PROJECT NO. DRAWING NO.  
23687




UPDATE DATE  
LETTING DATE

DATE 8/2/82  
DATE 8/2/82  
DME

DESIGNED BY: JWS  
CHECKED BY: JWS  
DATE: 8/2/82

REVISIONS:  
NO. BY: DATE  
1. JWS 8/2/82

PREPARED BY: JWS  
CHECKED BY: JWS  
DATE: 8/2/82

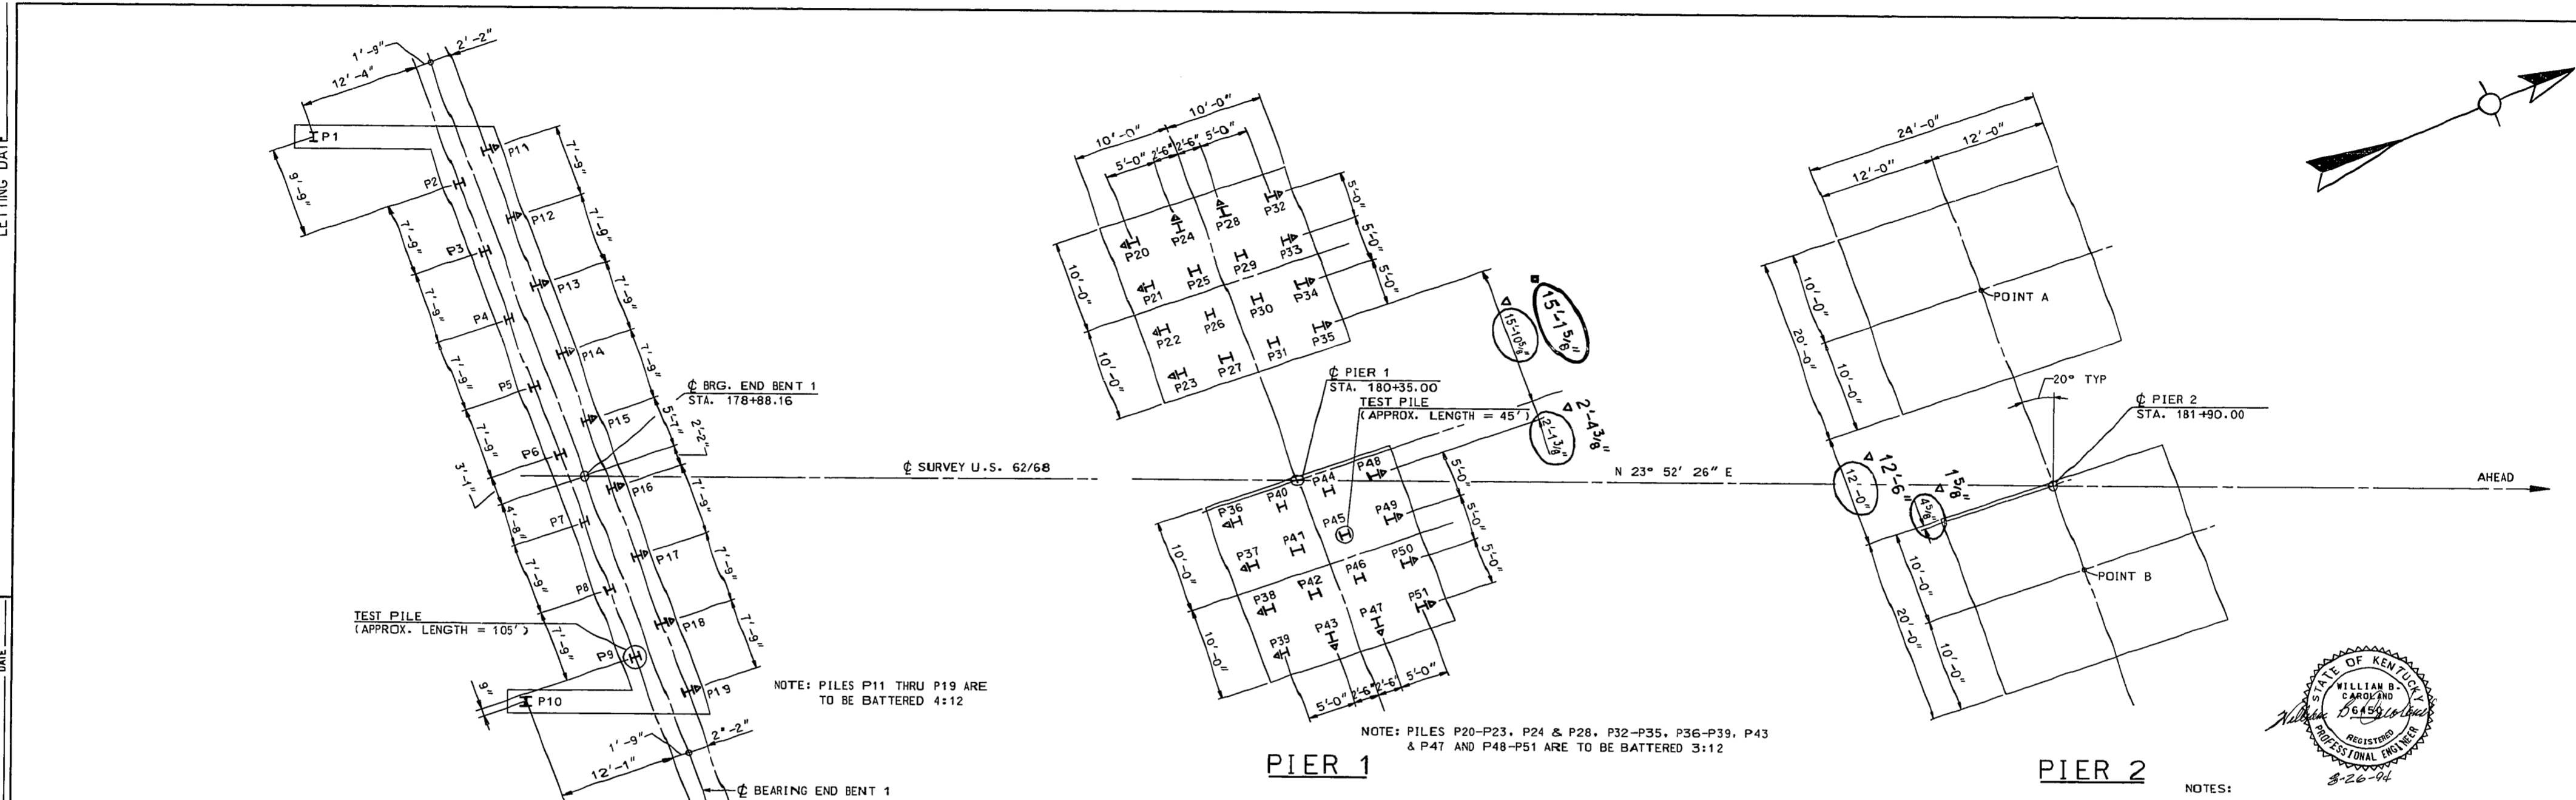

**PILE RECORD NOTE**  
AFTER ALL PILES HAVE BEEN DRIVEN, THE PROJECT ENGINEER SHALL RECORD FOR EACH PILE, THE "TIP OF PILE ELEVATION" AS DRIVEN, THE "LENGTH OF PILE IN PLACE" AND THE "DRIVING RESISTANCE", AND SHALL RETURN ONE BLUE LINE COPY OF THIS SHEET WITH THIS DATA TO THE DIRECTOR, DIVISION OF BRIDGES SO THAT THE DATA MAY BE RECORDED ON THE ORIGINAL PLANS. LENGTHS OF PILES IN PLACE SHOWN HEREON ARE THE ACTUAL LENGTHS OF PILES IN THE FINISHED STRUCTURE BELOW CUT-OFF ELEVATION.  
THIS PILE RECORD DOES NOT REPLACE OTHER RECORDS OF PILES REQUIRED TO BE KEPT AND SUBMITTED BY THE PROJECT ENGINEER.

**PILE RECORD - END BENT 1**

PILE NUMBER	PILE CUT-OFF ELEVATION	TIP OF PILE ELEVATION AS DRIVEN	LENGTH OF PILE IN PLACE (LIN. FT.)	DESIGN HORIZONTAL THRUST (TONS)	MAXIMUM DESIGN AXIAL LOAD (TONS)	MINIMUM DESIGN AXIAL LOAD (TONS)	REQUIRED DRIVING RESISTANCE (TONS)	ACTUAL DRIVING RESISTANCE (TONS)
P1	729.024			1.5	85.0	0	N/A	
P2	729.024			1.5	85.0	0	N/A	
**PILE RECORD - PIER 1**

PILE NUMBER	PILE CUT-OFF ELEVATION	TIP OF PILE ELEVATION AS DRIVEN	LENGTH OF PILE IN PLACE (LIN. FT.)	DESIGN HORIZONTAL THRUST (TONS)	MAXIMUM DESIGN AXIAL LOAD (TONS)	MINIMUM DESIGN AXIAL LOAD (TONS)	REQUIRED DRIVING RESISTANCE (TONS)	ACTUAL DRIVING RESISTANCE (TONS)
P20	647.533			2.0	103	0	N/A	
P21	647.533			2.0	103	0	N/A	
**SPREAD FOOTING RECORD - PIER 2**

POINT	PLAN FOOTING ELEVATION	AS-BUILT FOOTING ELEVATION
A	570.933	
B	570.933	

FOOTING IS DESIGNED FOR A MAXIMUM PRESSURE OF 8,500 PSF. THE ALLOWABLE BEARING CAPACITY IS 20,000 PSF.

**NOTES:**  
ALL PILES ARE HP 14x73. SEE STD. DWG. BPS-009 (C.E.)  
END BENT 1 & 2 AND PIERS 1 & 4 SHALL REQUIRE 14" PILE POINTS. THE POINTS SHALL BE THE TYPE FOR KEYING INTO A SLOPING ROCK SURFACE. THE "SPECIAL NOTE FOR PILE POINTS" SHALL APPLY TO THIS WORK.  
DIMENSIONS SHOWN ARE GIVEN AT THE BOTTOM OF THE END BENT CAP AND PIER FOOTINGS.

**NOTE:** AFTER ALL FOUNDATIONS HAVE BEEN PLACED, THE PROJECT RESIDENT ENGINEER SHALL RECORD THE BOTTOM OF FOOTING ELEVATION "AS-BUILT" AND SHALL SUBMIT ONE COPY OF THIS SHEET WITH THIS DATA TO THE DIRECTOR, DIVISION OF BRIDGES.

U.S. 62/68 OVER LAWRENCE CREEK SHEET 8

**COMMONWEALTH OF KENTUCKY**  
**DEPARTMENT OF HIGHWAYS**  
FRANKFORT  
COUNTY OF  
**MASON**  
U.S. 62/68  
ROAD

STATION 82+67.50 P.E. PROJECT NO.  
CONSTRUCTION PROJECT NO. MAINTENANCE PROJECT NO. DRAWING NO. 23687




① NO UPLIFT IS ANTICIPATED  
② PILES SHALL BE END BEARING & DRIVEN TO REFUSAL. PILE TIPS SHALL BE SEATED AT OR BELOW ROCK SURFACE. DRIVING RESISTANCE FORMULA DOES NOT APPLY.

**FOUNDATION LAYOUT**






DESIGNED BY: [ ] DATE: 6/24  
 CHECKED BY: [ ] DATE: 6/24  
 REVISIONS: [ ] DATE: [ ]  
 PREPARED BY: [ ] DATE: [ ]  
 DATE: [ ]  
 LETTING DATE: [ ]

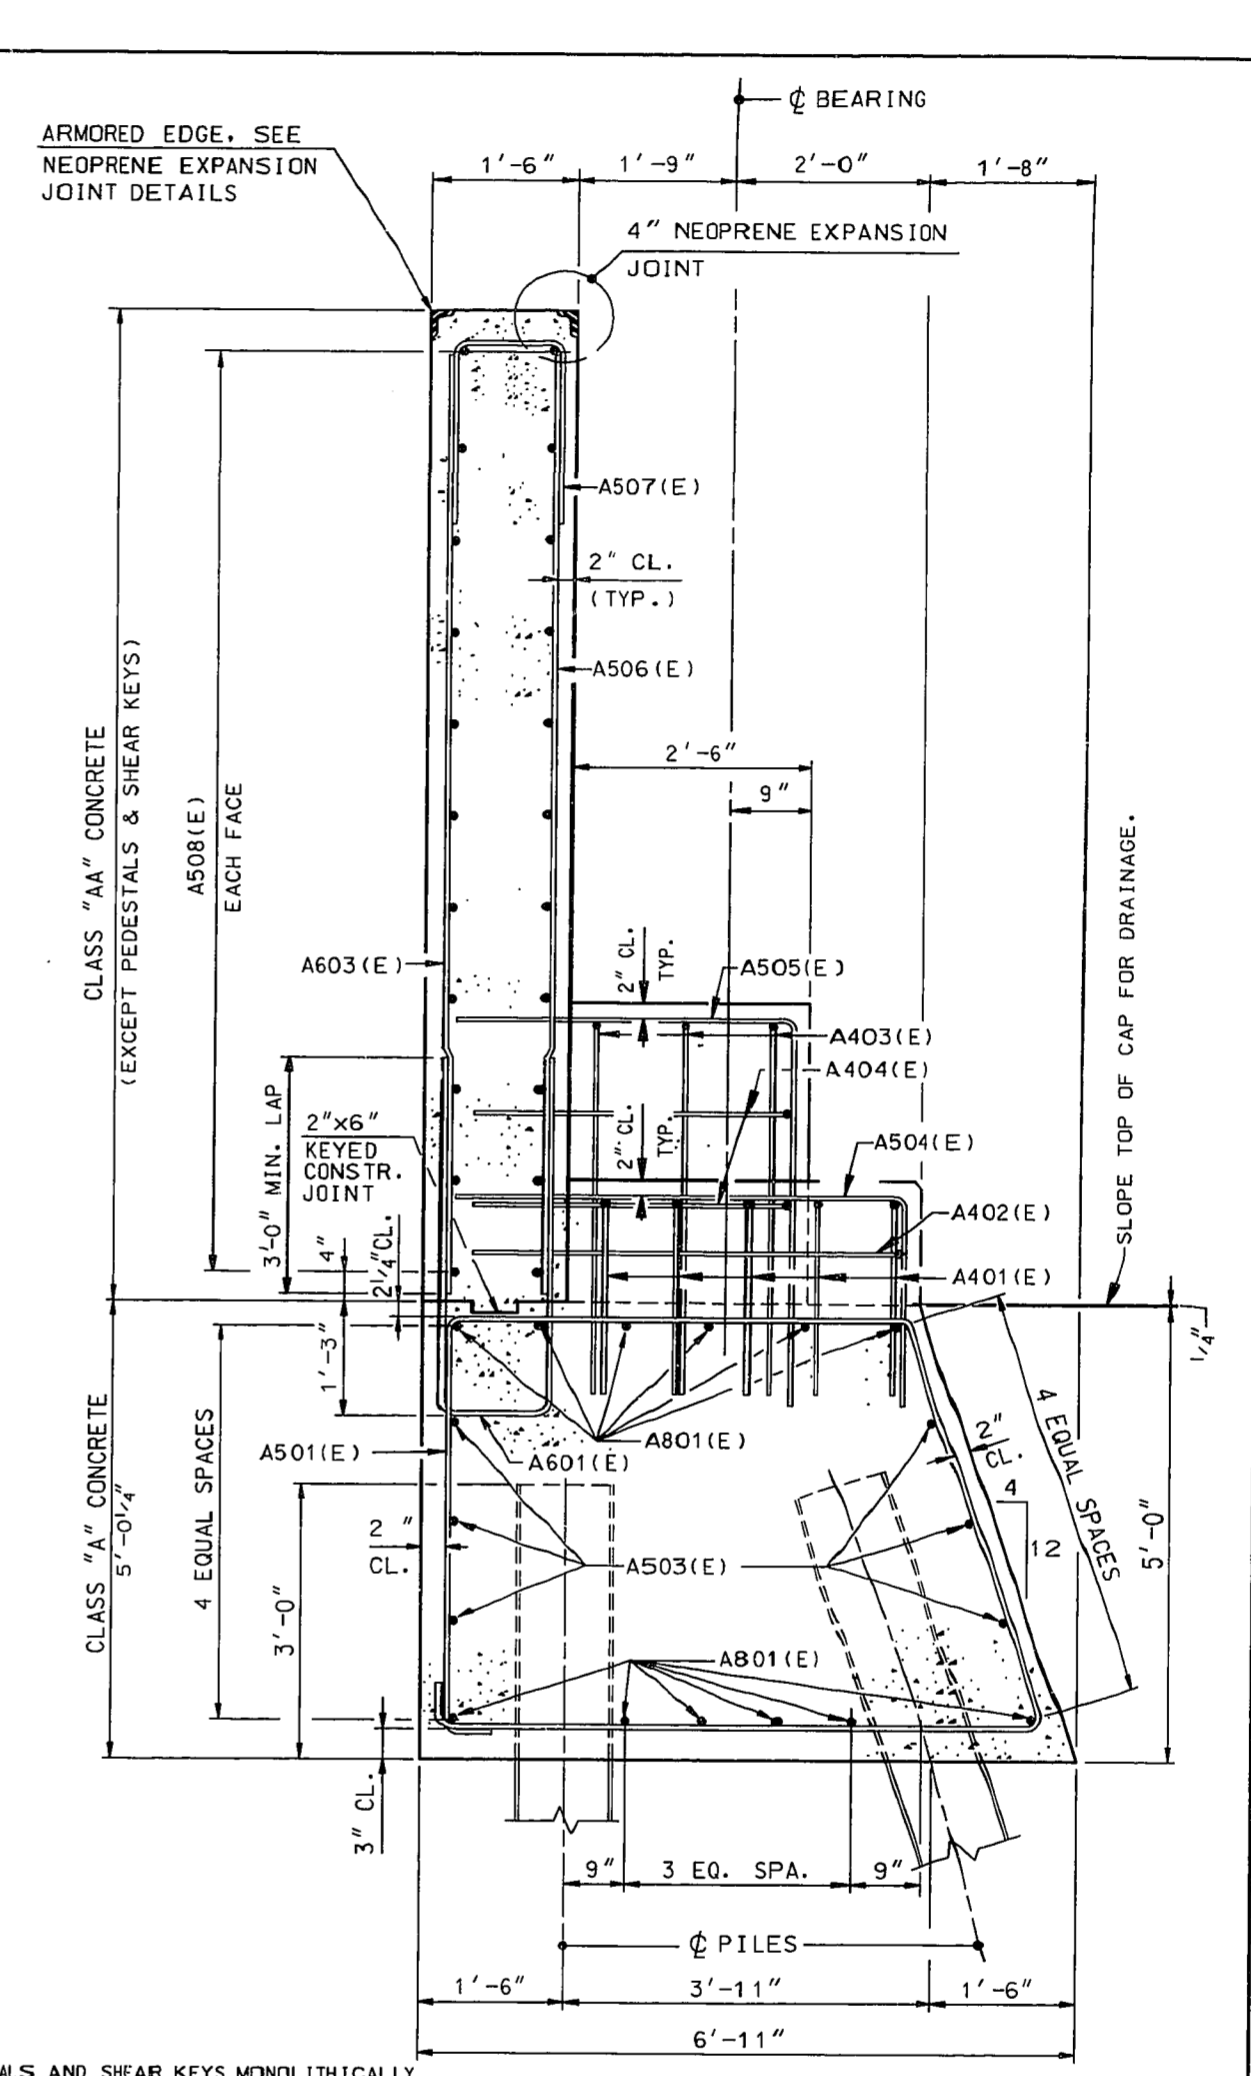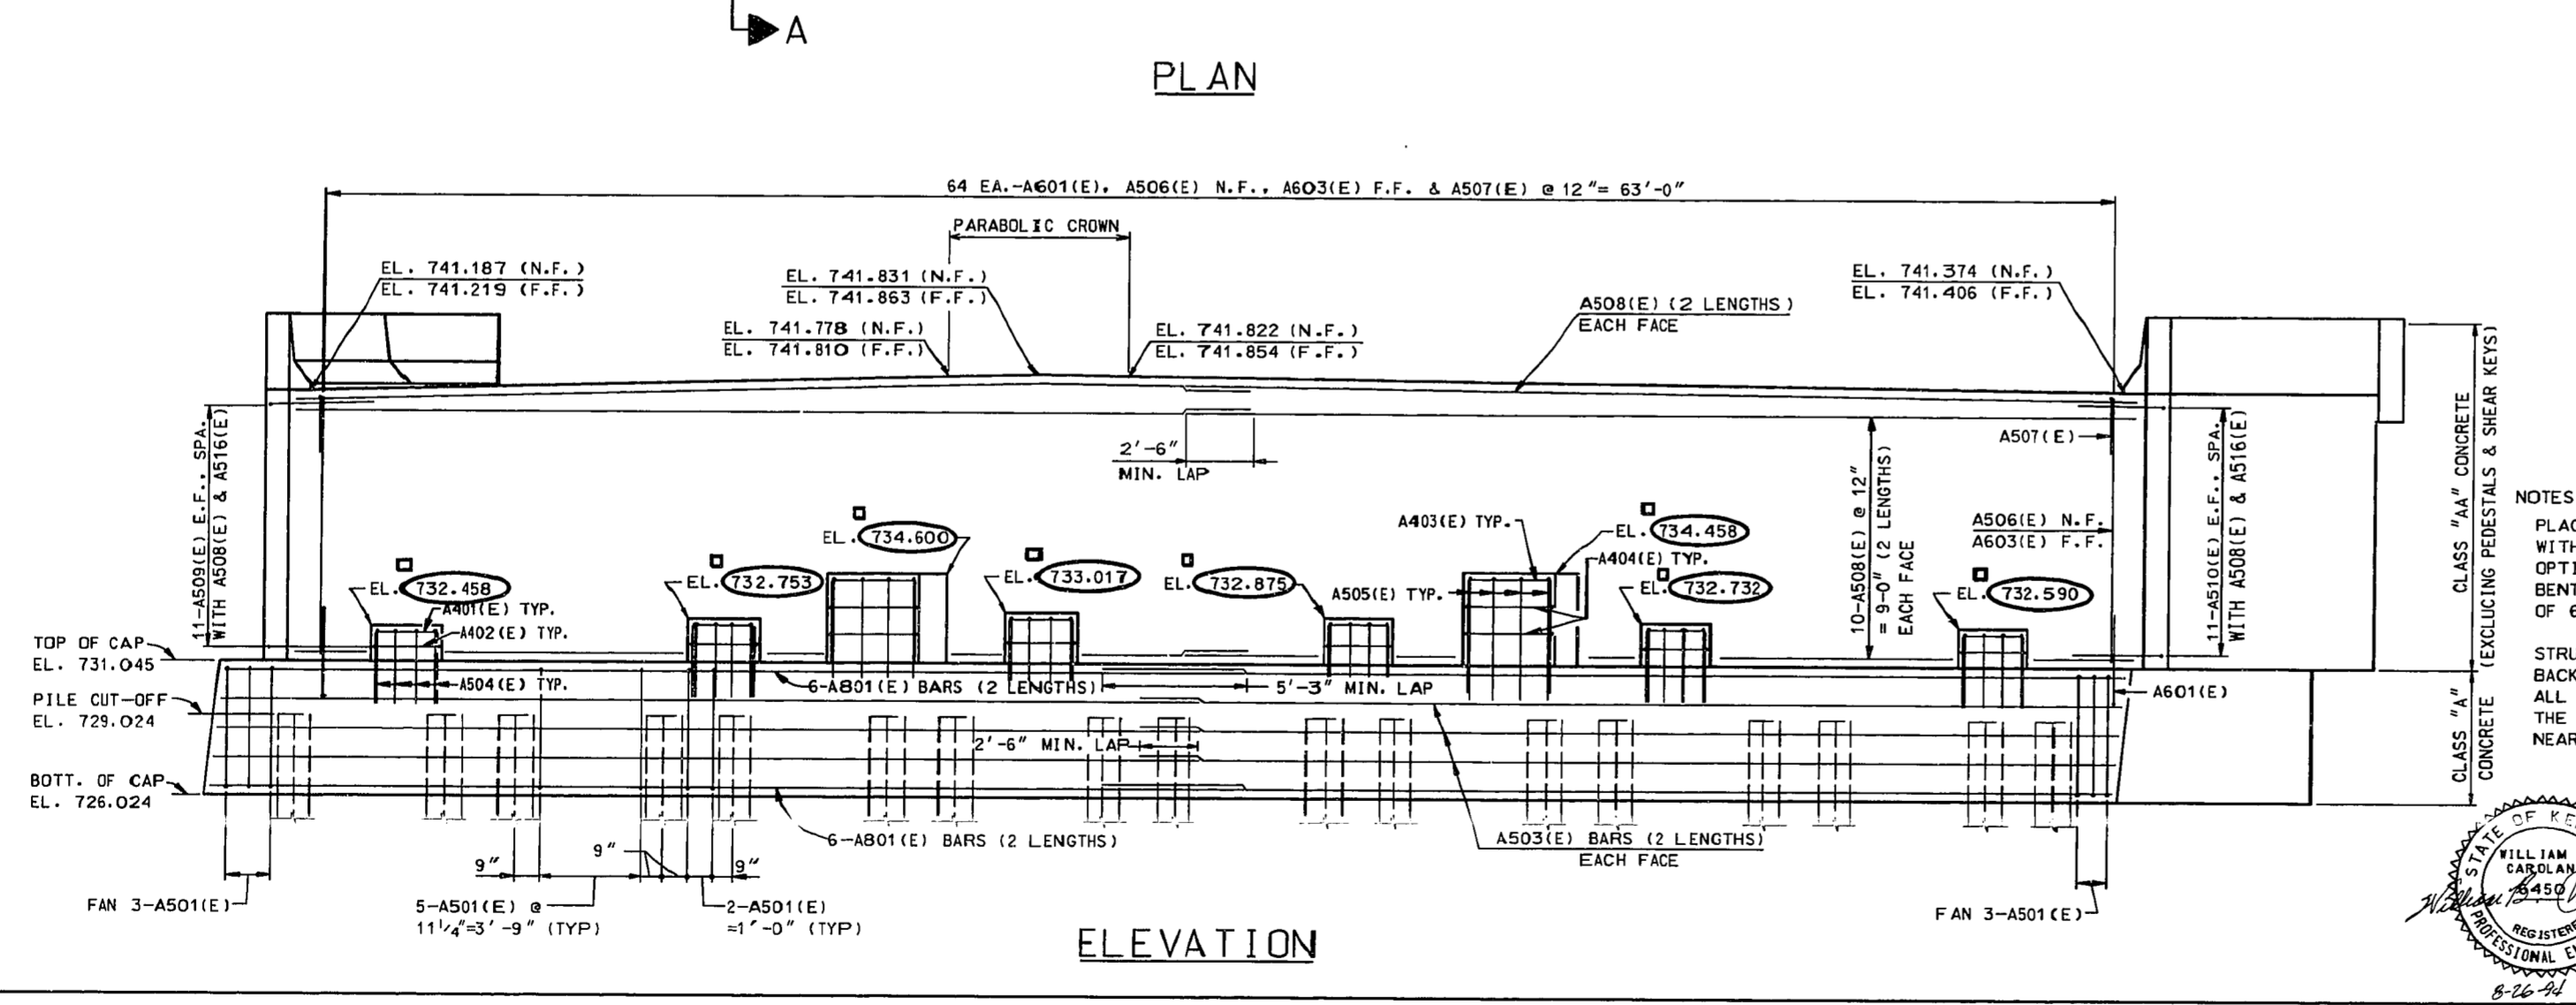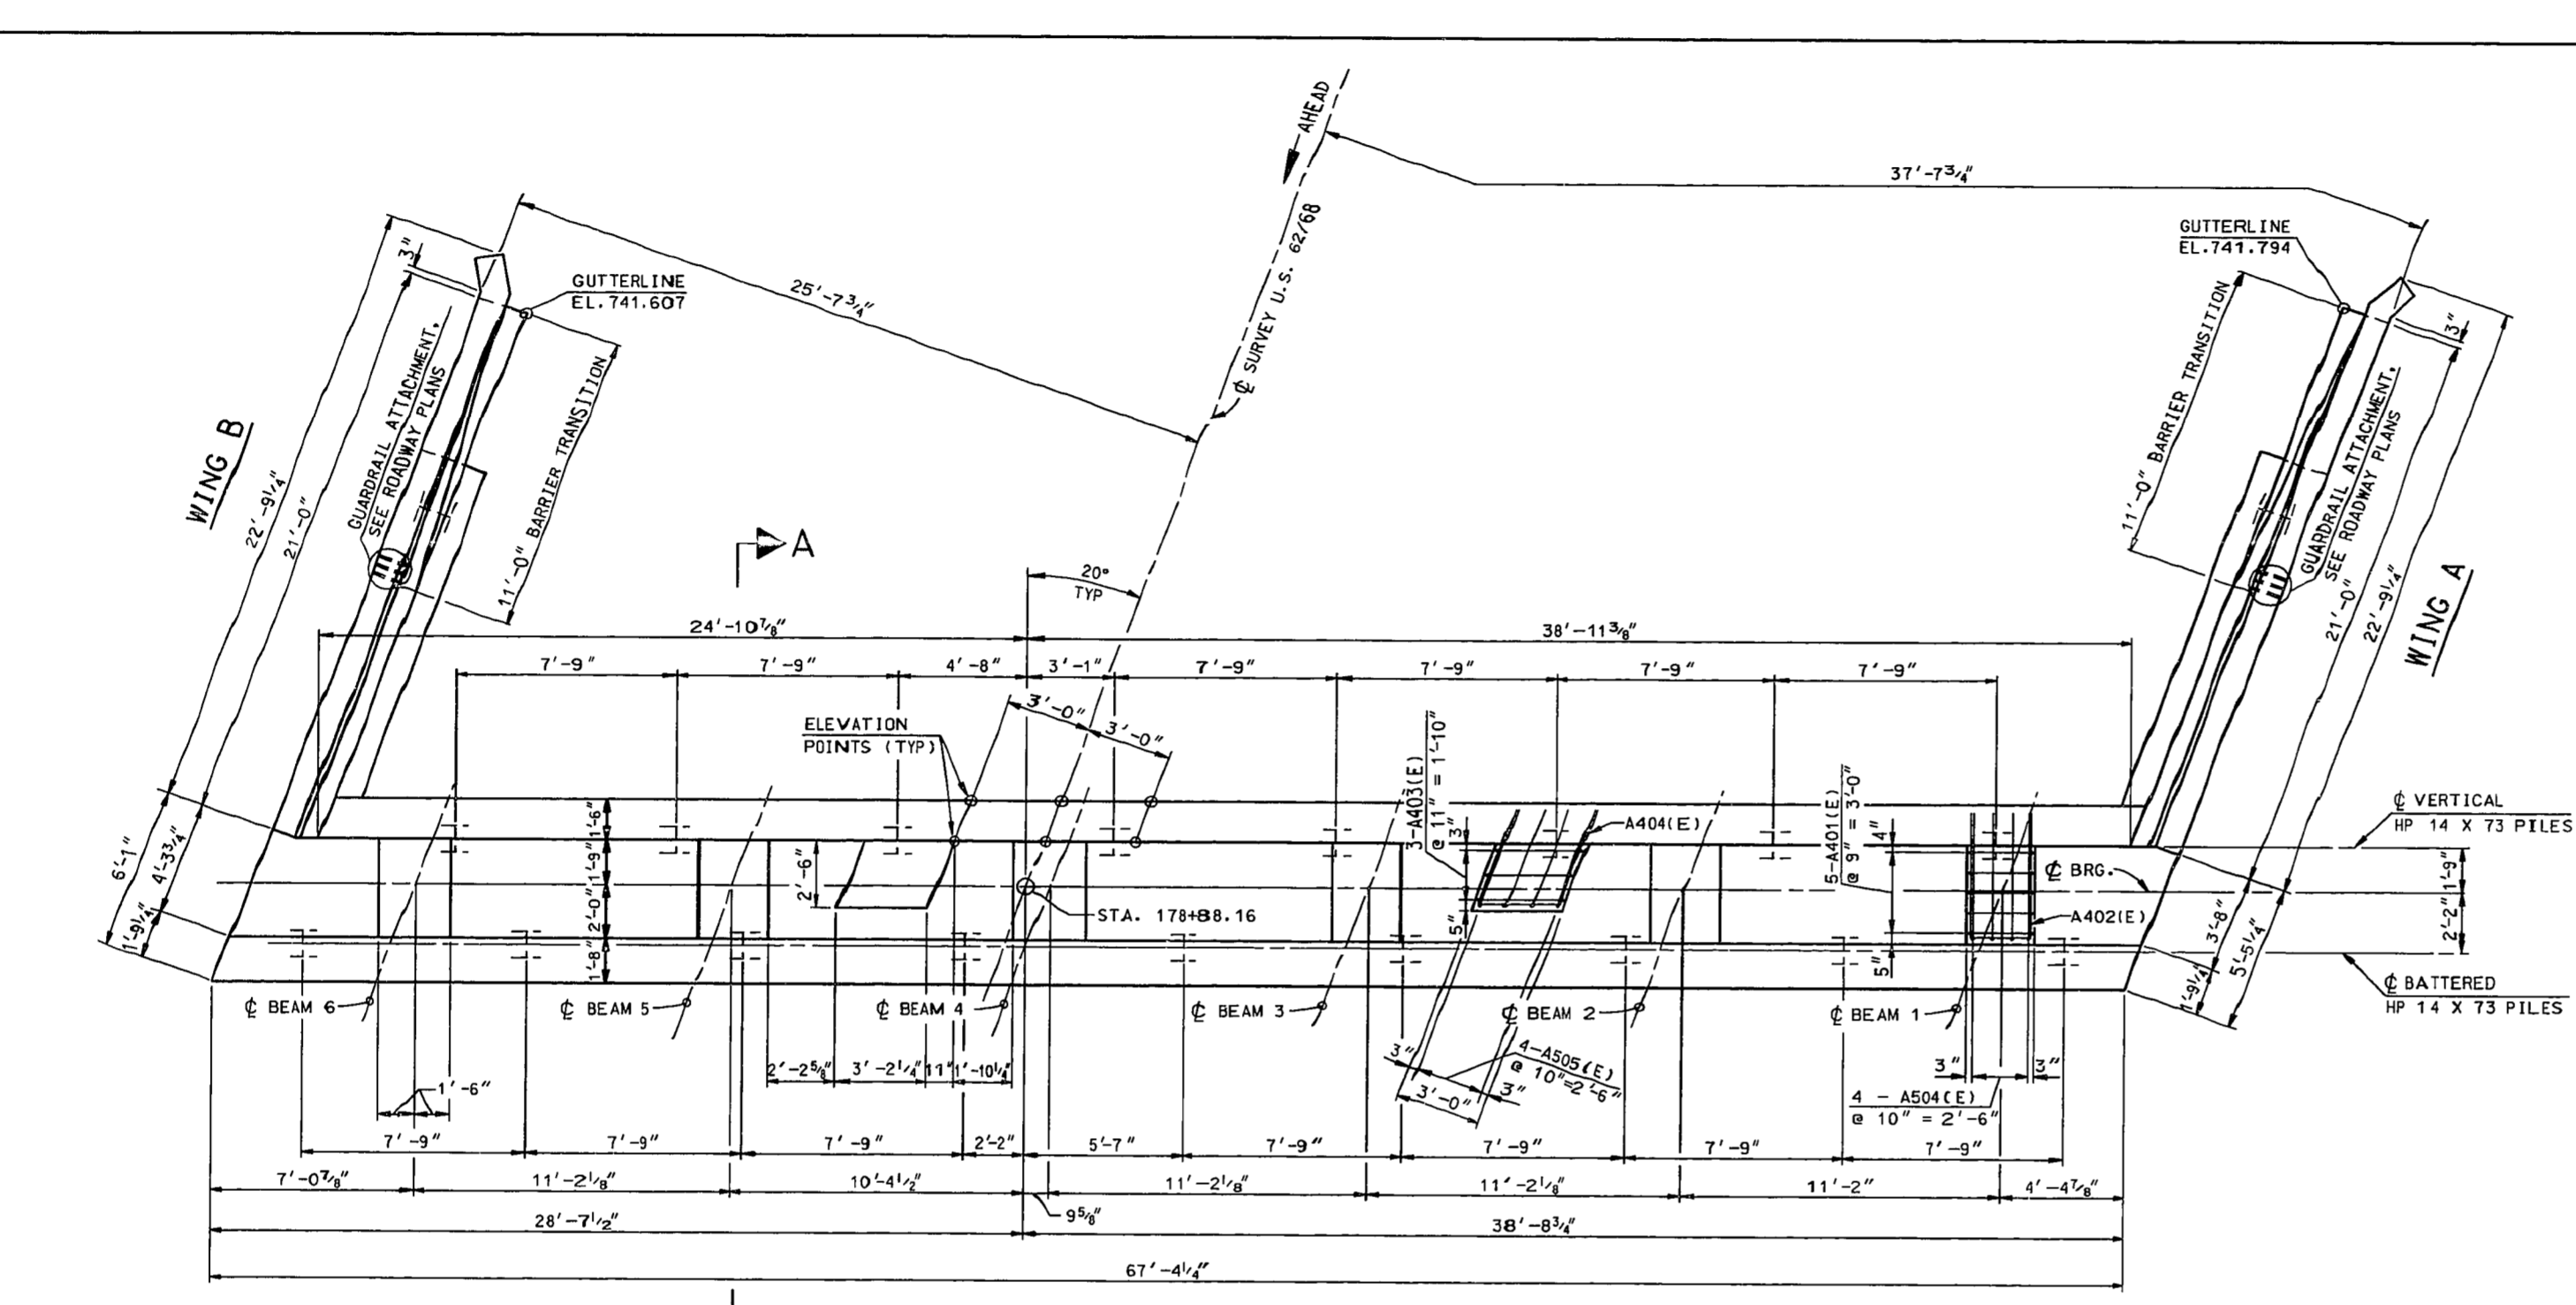

**SECTION A-A**  
 U.S. 62/68 OVER LAWRENCE CREEK SHEET 10  
**COMMONWEALTH OF KENTUCKY**  
**DEPARTMENT OF HIGHWAYS**  
 FRANKFORT  
 COUNTY OF  
**MASON**  
 U.S. 62/68  
 ROAD  
 STATION 182+7.50 P. E. PROJECT NO.  
 CONSTRUCTION PROJECT NO. MAINTENANCE PROJECT NO. DRAWING NO. 23687

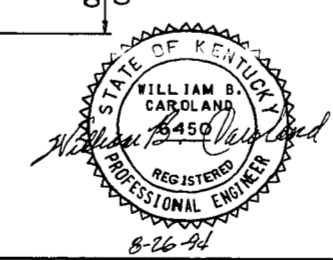

END BENT 1





NOTES:  
 PLACE PEDESTALS AND SHEAR KEYS MONOLITHICALLY WITH END BENT CAP. CONTRACTOR MAY USE AN OPTIONAL CONSTRUCTION JOINT 4" ABOVE END BENT CAP FOR PEDESTALS & SHEAR KEYS IN EXCESS OF 6" IN HEIGHT.  
 STRUCTURE GRANULAR BACKFILL BEHIND THE BACKWALL SHALL NOT BE PLACED UNTIL AFTER ALL DECK CONCRETE HAS BEEN POURED BETWEEN THE MANDATORY DECK CONSTRUCTION JOINTS NEAR THE ENDS OF THE DECK.







UPDATE DATE \_\_\_\_\_  
 LETTING DATE \_\_\_\_\_

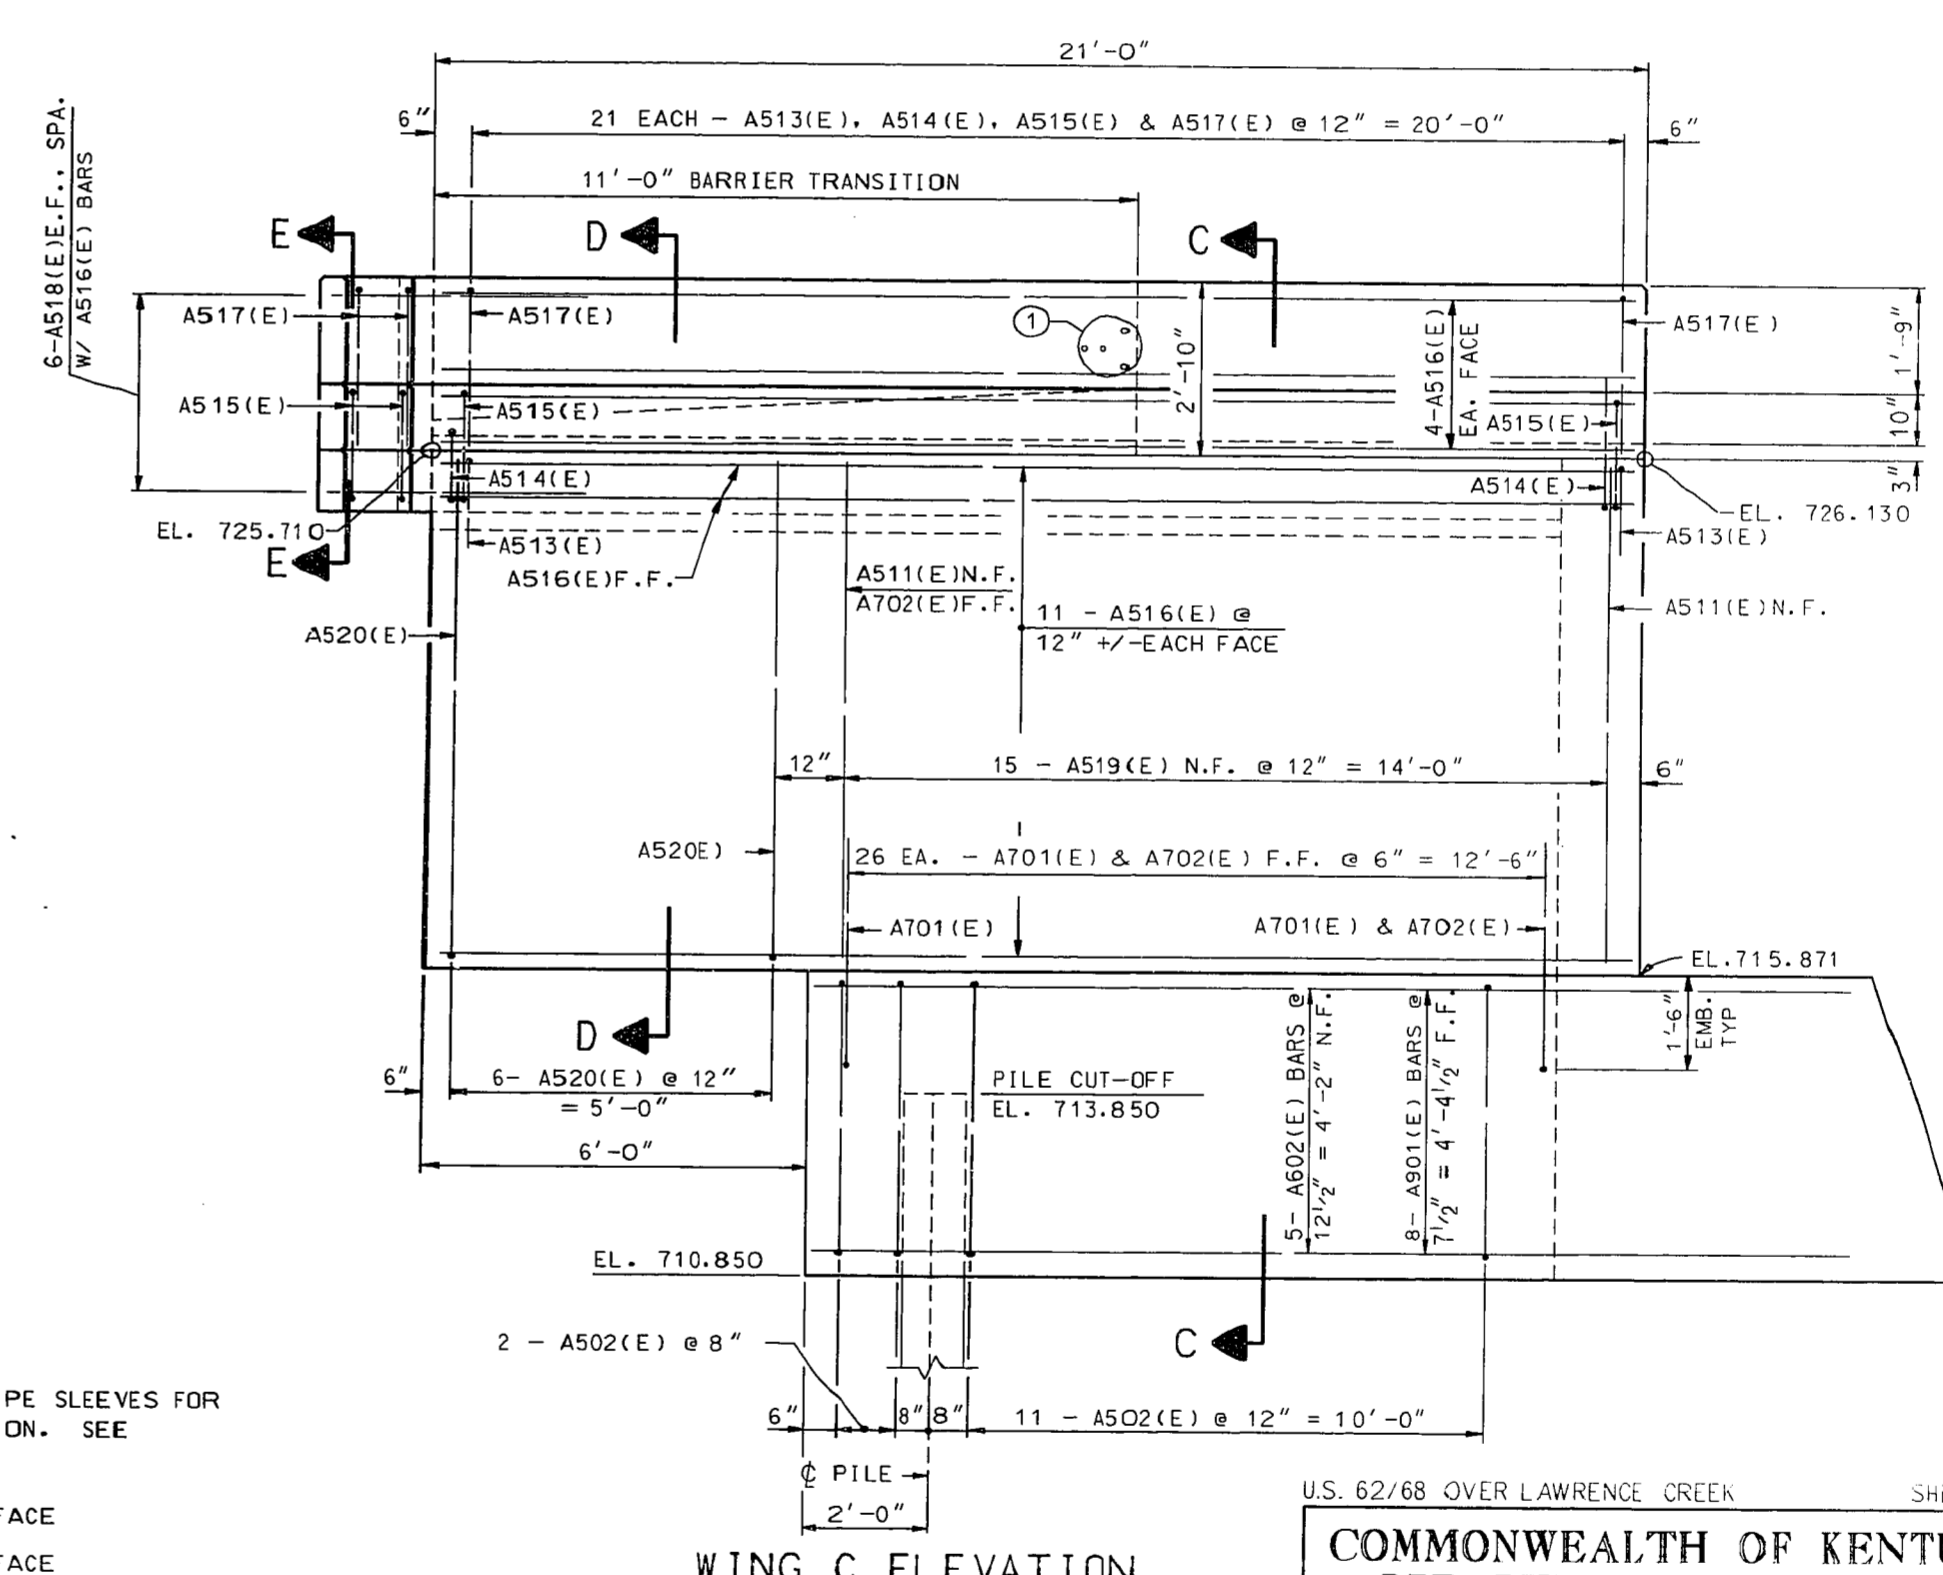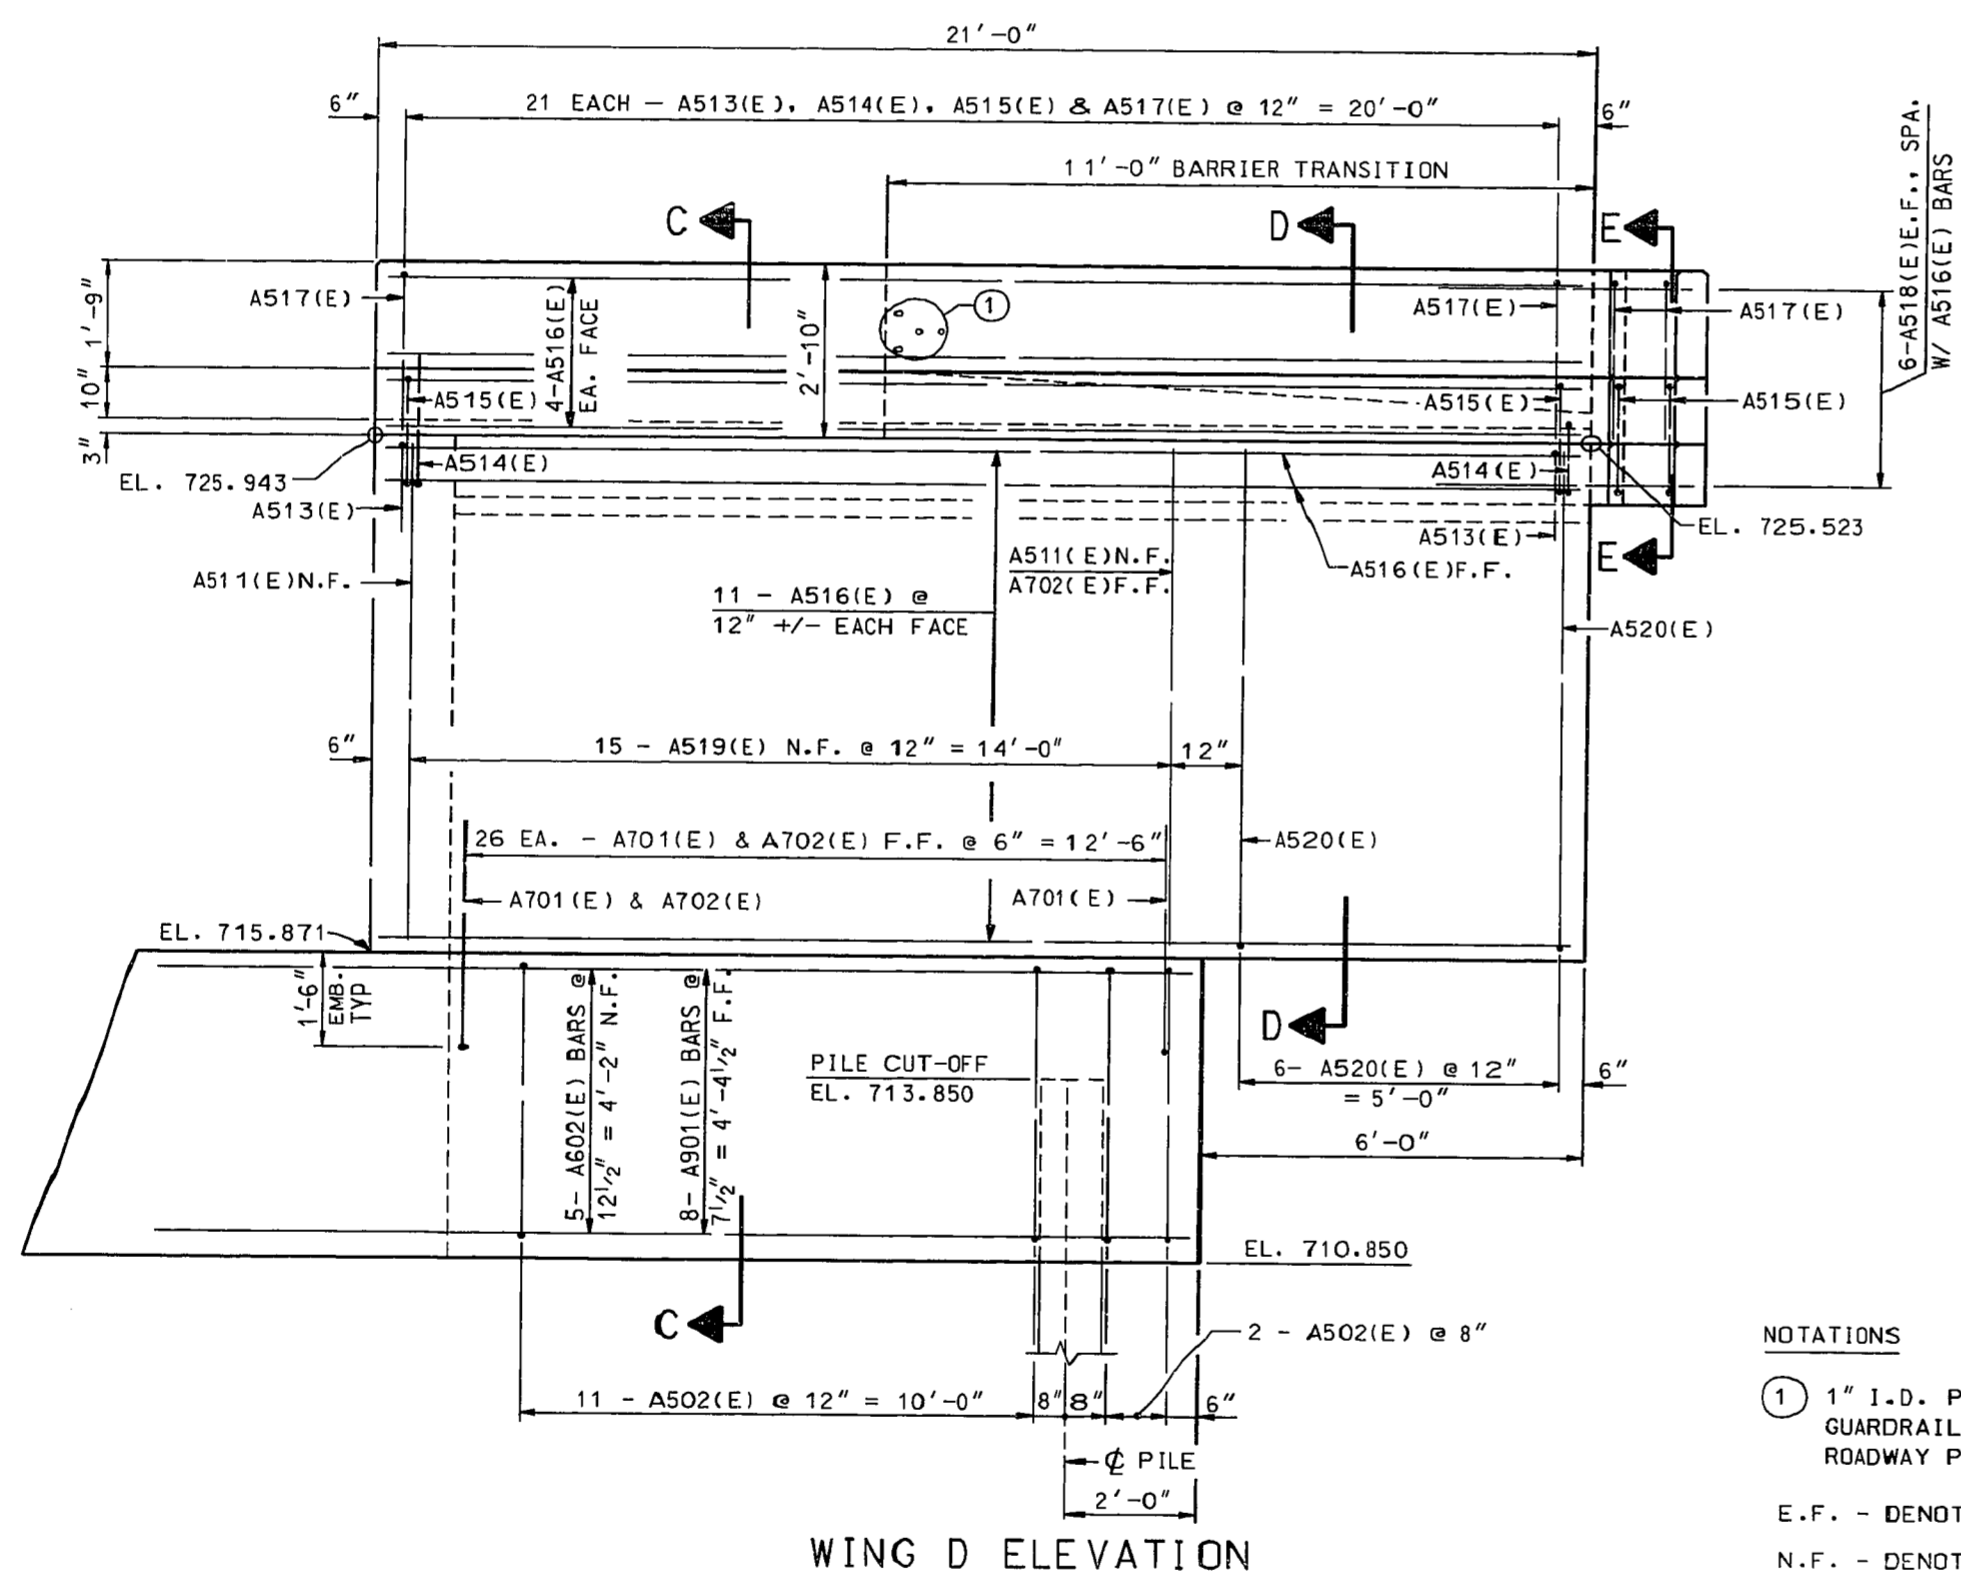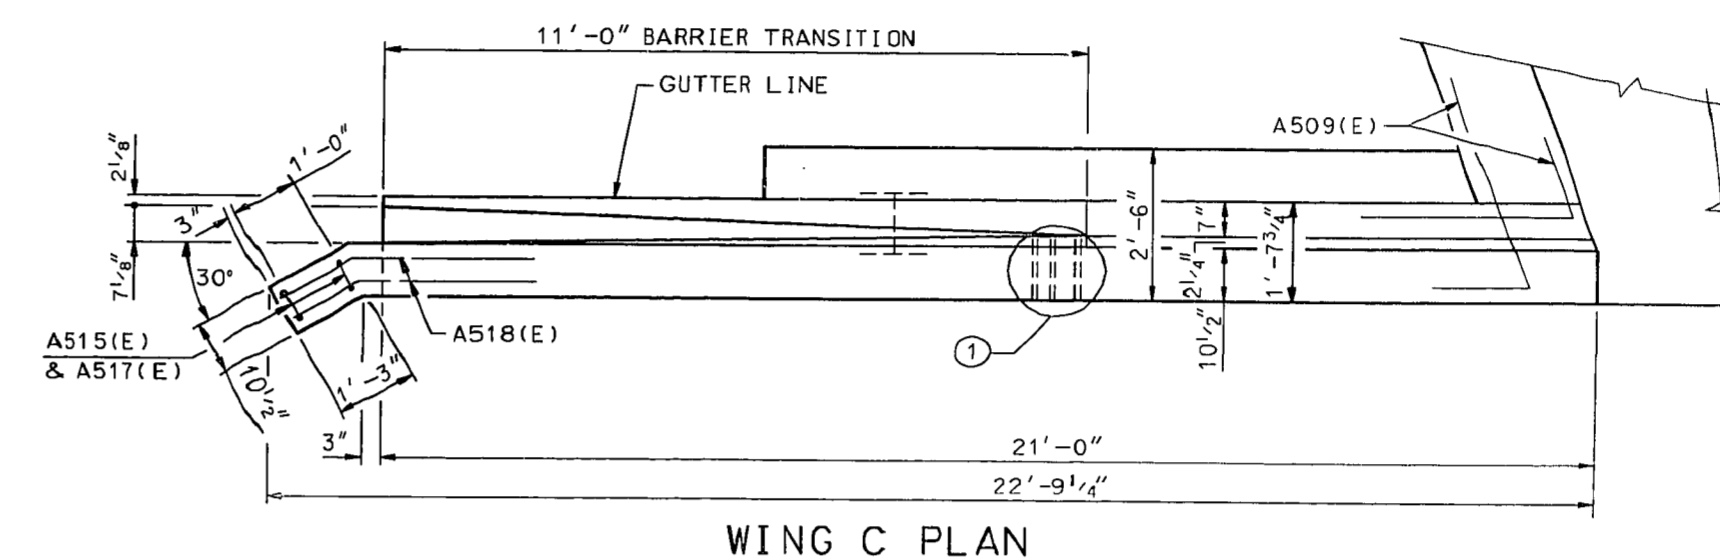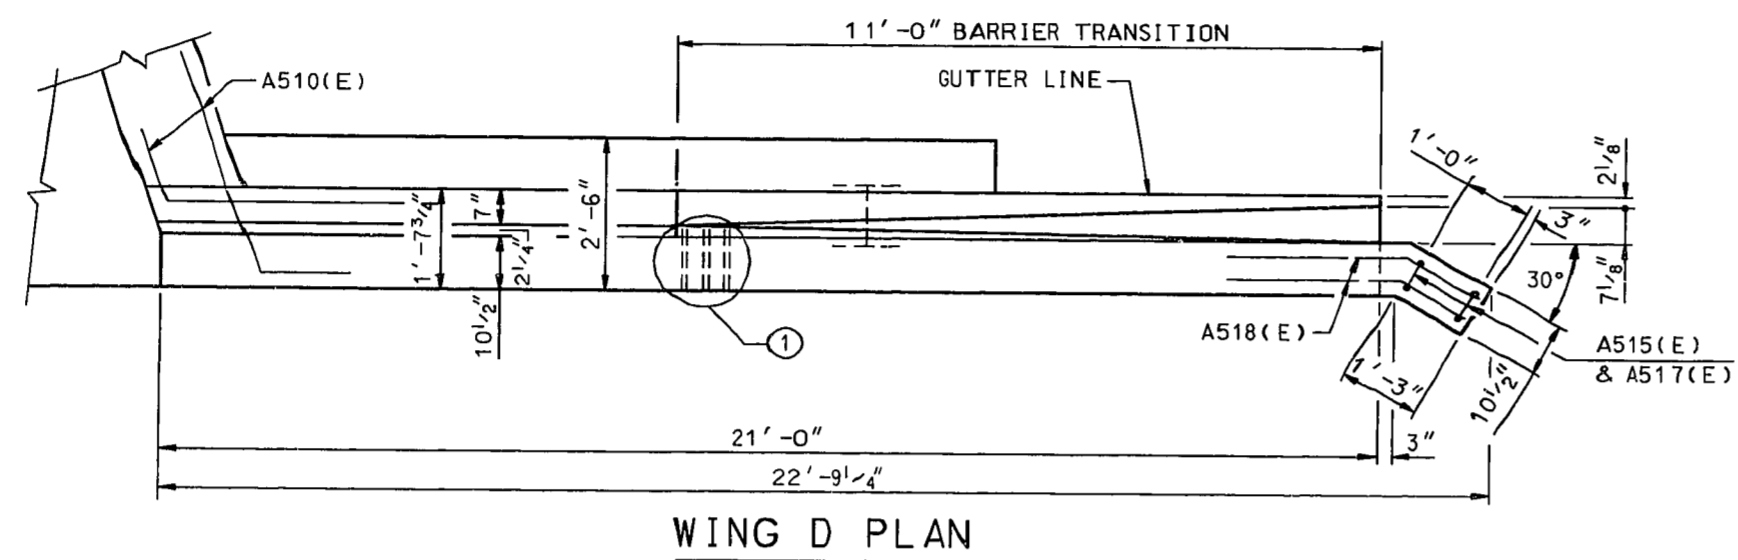

**NOTATIONS**

① 1" I.D. PLASTIC PIPE SLEEVES FOR GUARDRAIL CONNECTION. SEE ROADWAY PLANS.

E.F. - DENOTES EACH FACE  
 N.F. - DENOTES NEAR FACE  
 F.F. - DENOTES FAR FACE  
 \* - INDICATES TO FIELD BEND AS REQ'D.

DESIGNED BY	D.C.D.	REVISION	DATE
DRAWN BY	A.L.F.	REVISION	DATE
CHECKED BY		REVISION	DATE
PREPARED BY		REVISION	DATE



**END BENT 2**





U.S. 62/68 OVER LAWRENCE CREEK SHEET 13

**COMMONWEALTH OF KENTUCKY**  
 DEPARTMENT OF HIGHWAYS

FRANKFORT  
 COUNTY OF  
**MASON**  
 U.S. 62/68  
 ROAD

STATION 182+67.50 P. E. PROJECT NO. \_\_\_\_\_  
 CONSTRUCTION PROJECT NO. \_\_\_\_\_ MAINTENANCE PROJECT NO. \_\_\_\_\_ DRAWING NO. **23687**

UPDATE DATE  
LETTING DATE

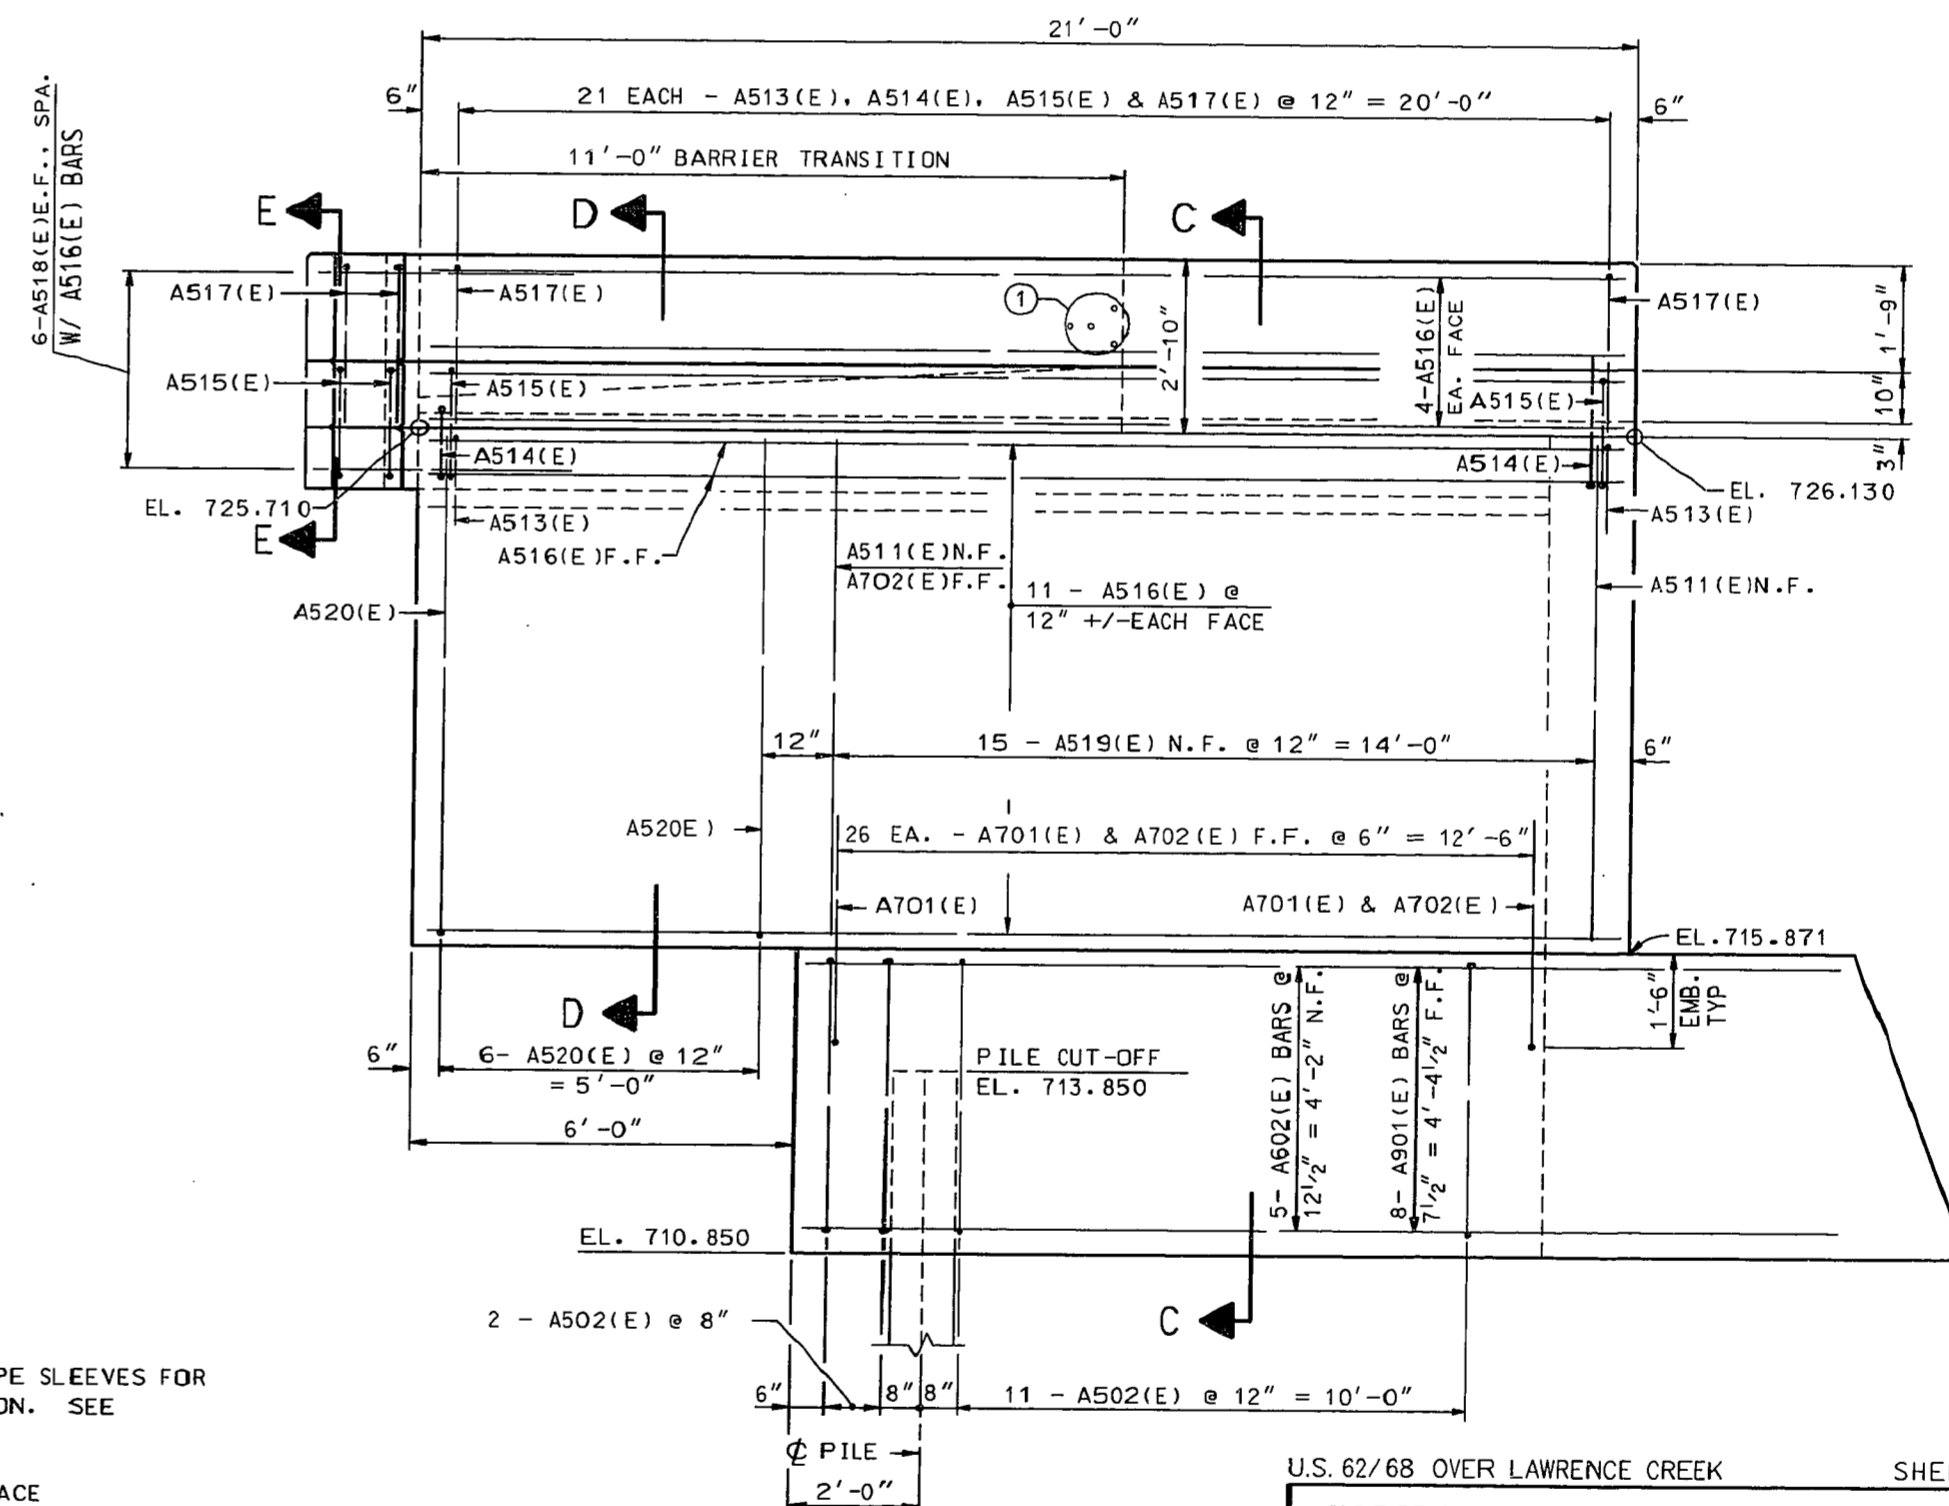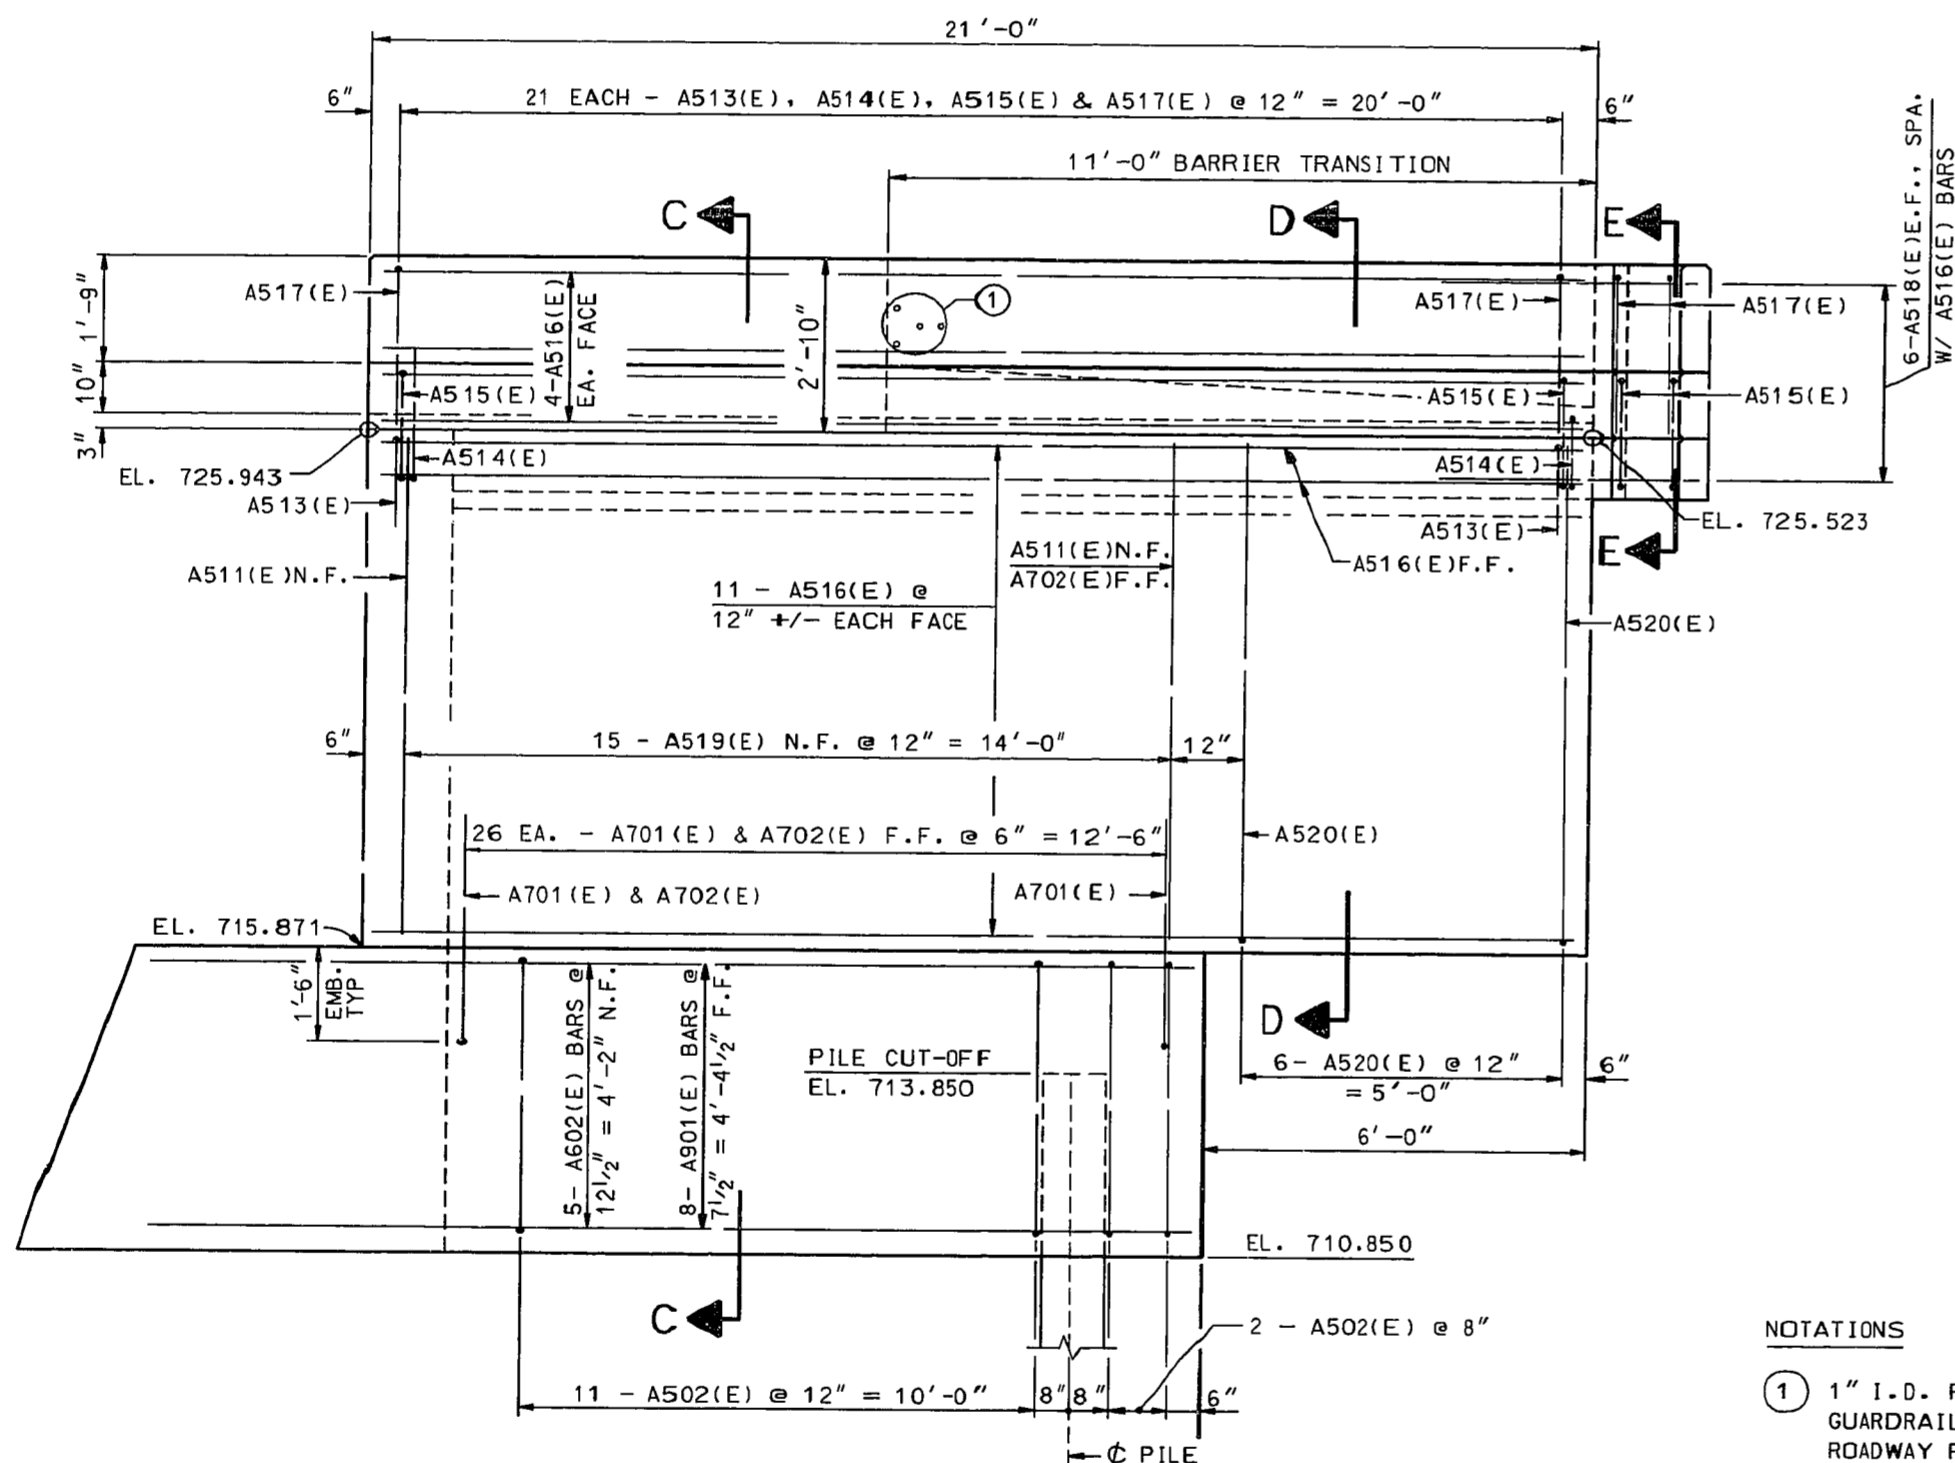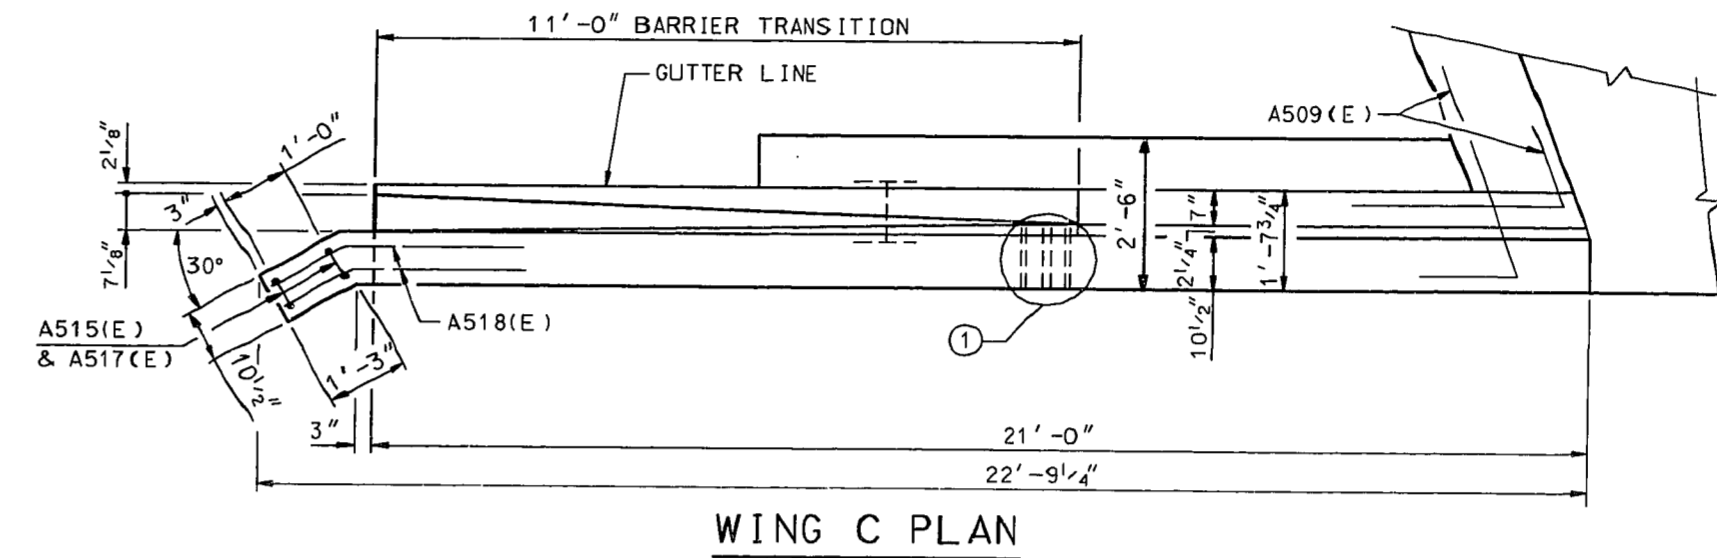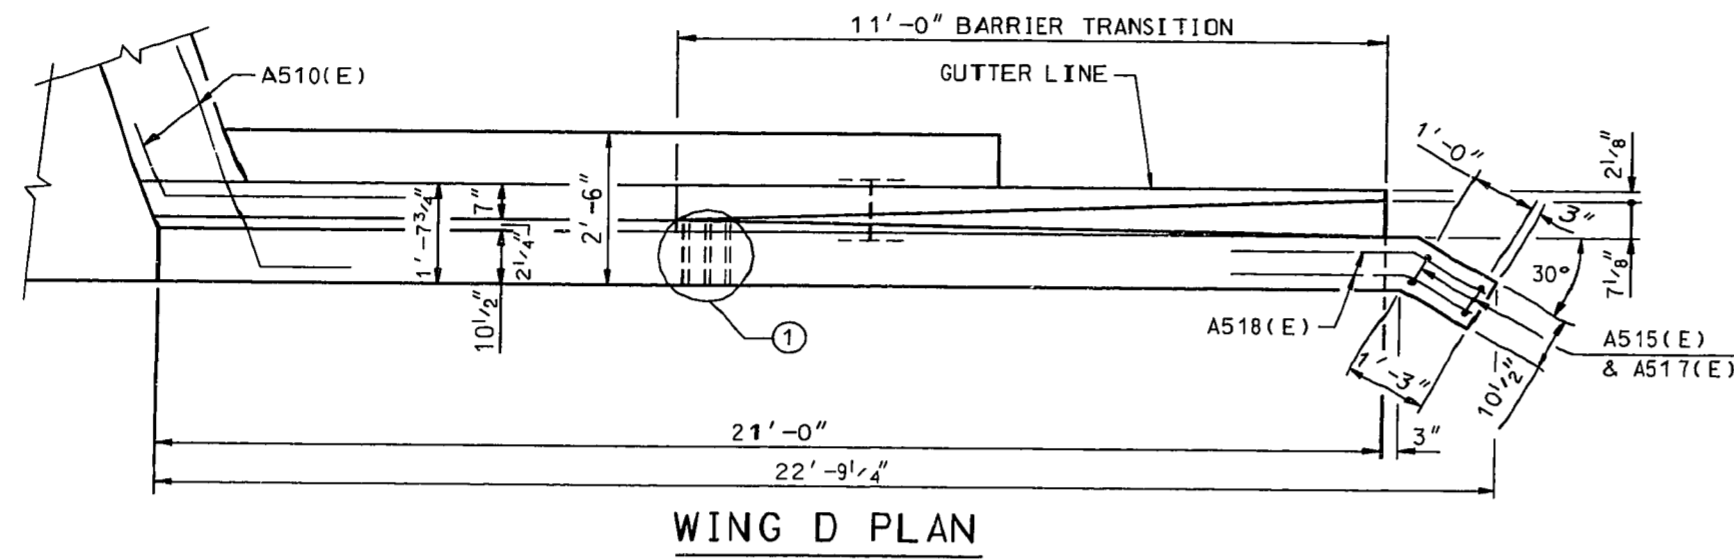

**NOTATIONS**

① 1" I.D. PLASTIC PIPE SLEEVES FOR GUARDRAIL CONNECTION. SEE ROADWAY PLANS.

E.F. - DENOTES EACH FACE  
N.F. - DENOTES NEAR FACE  
F.F. - DENOTES FAR FACE

\* - INDICATES TO FIELD BEND AS REQ'D.

DESIGNED BY	DATE	CHECKED BY	DATE
DOD	6/24	DOD	6/24
REVISION		REVISION	
REVISION		REVISION	
PREPARED BY	DATE	GRAPHICS SECTION	CHECKED BY



END BENT 2

U.S. 62/68 OVER LAWRENCE CREEK SHEET 13

**COMMONWEALTH OF KENTUCKY**  
DEPARTMENT OF HIGHWAYS

FRANKFORT  
COUNTY OF  
**MASON**  
U.S. 62/68  
ROAD

STATION 182+67.50 P. E. PROJECT NO.  
CONSTRUCTION PROJECT NO. MAINTENANCE PROJECT NO.

DRAWING NO. **23687**






# BILL OF REINFORCEMENT


MARK	TYPE	SIZE	NUMBER		LENGTH Ft. In.	LOCATION	A		B		C		D	
			EB 1	EB 2			Ft.	In.	Ft.	In.	Ft.	In.	Ft.	In.
A401(E)	1	4	30	6	8	PEDESTALS	3	0	2	7				
A402(E)	1	4	6	6	12	PEDESTALS	4	10	2	8				
A403(E)	1	4	6	6	11	SHEAR KEYS	4	7	2	9				
A404(E)	2	4	4	4	9	SHEAR KEYS	2	10	3	3 1/2	3	6	1	3 1/4
A501(E)	3	5	62	62	21	CAP								
A502(E)	4	5	26	26	14	WING FOOTING	4	7	2	2				
A503(E)	STR.	5	12	12	34	CAP								
A504(E)	5	5	24	24	7	PEDESTALS	3	0	4	10				
A505(E)	5	5	8	8	5	SHEAR KEY	4	7	3	10				
A506(E)	STR.	5	64	64	9	BACKWALL								
A507(E)	1	5	64	64	6	BACKWALL								
A508(E)	STR.	5	22	22	34	BACKWALL								
A509(E)	6	5	22	22	6	BACKWALL - WING	4	6	2	2	2	0 1/2	0	9
A510(E)	7	5	22	22	6	BACKWALL - WING	4	6	2	2	2	0 1/2	0	9
A511(E)	STR.	5	30	30	9	WING WALL								
A512(E)	1	5	12	12	20	WING WALL	10	1	0	8				
A513(E)	8	5	42	42	3	WING WALL								
A514(E)	9	5	42	42	2	WING WALL & BARRIER								
A515(E)	4	5	46	46	5	WING WALL & BARRIER								
A516(E)	STR.	5	64	64	20	WING WALL & BARRIER	1	9 1/2	0	6 1/2				
A517(E)	10	5	46	46	6	WING BARRIER								
A518(E)	STR.	5	24	24	3	WING TURNBACK	2	9	1	2	0	7	1	0
A519(E)	STR.	7	30	30	9	WING WALL								
A520(E)	1	5	12	12	19	WING WALL	9	4	0	8				
A601(E)	1	6	64	64	9	CAP-BACKWALL	4	3	1	2				
A602(E)	STR.	6	10	10	18	WING FOOTING								
A603(E)	STR.	6	64	64	9	BACKWALL								
A701(E)	1	7	52	52	11	WING FTG.-WING WALL	5	6	0	8				
A702(E)	STR.	7	52	52	9	WING WALL								
A801(E)	STR.	8	24	24	36	CAP								
A901(E)	STR.	9	16	16	18	WING FOOTING								

UPDATE DATE  
LETTING DATE


DESIGNED BY: DCD  
CHECKED BY: WBC  
DATE: 6/23/84  
REVISION: NONE  
PREPARED BY: ALF  
SECTION: DCD  
DATE: 6/24/84  
REVISION: NONE

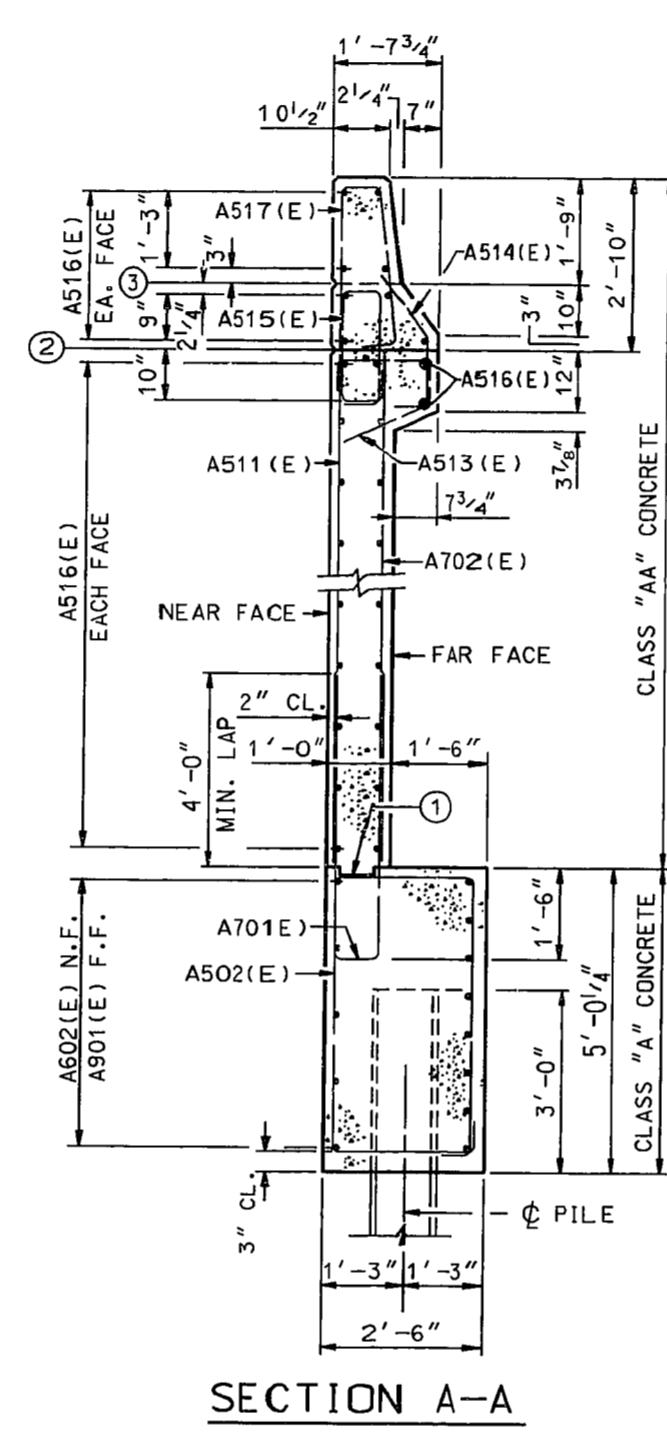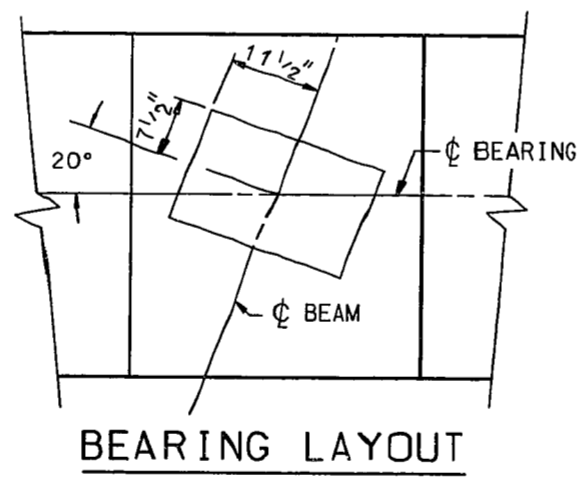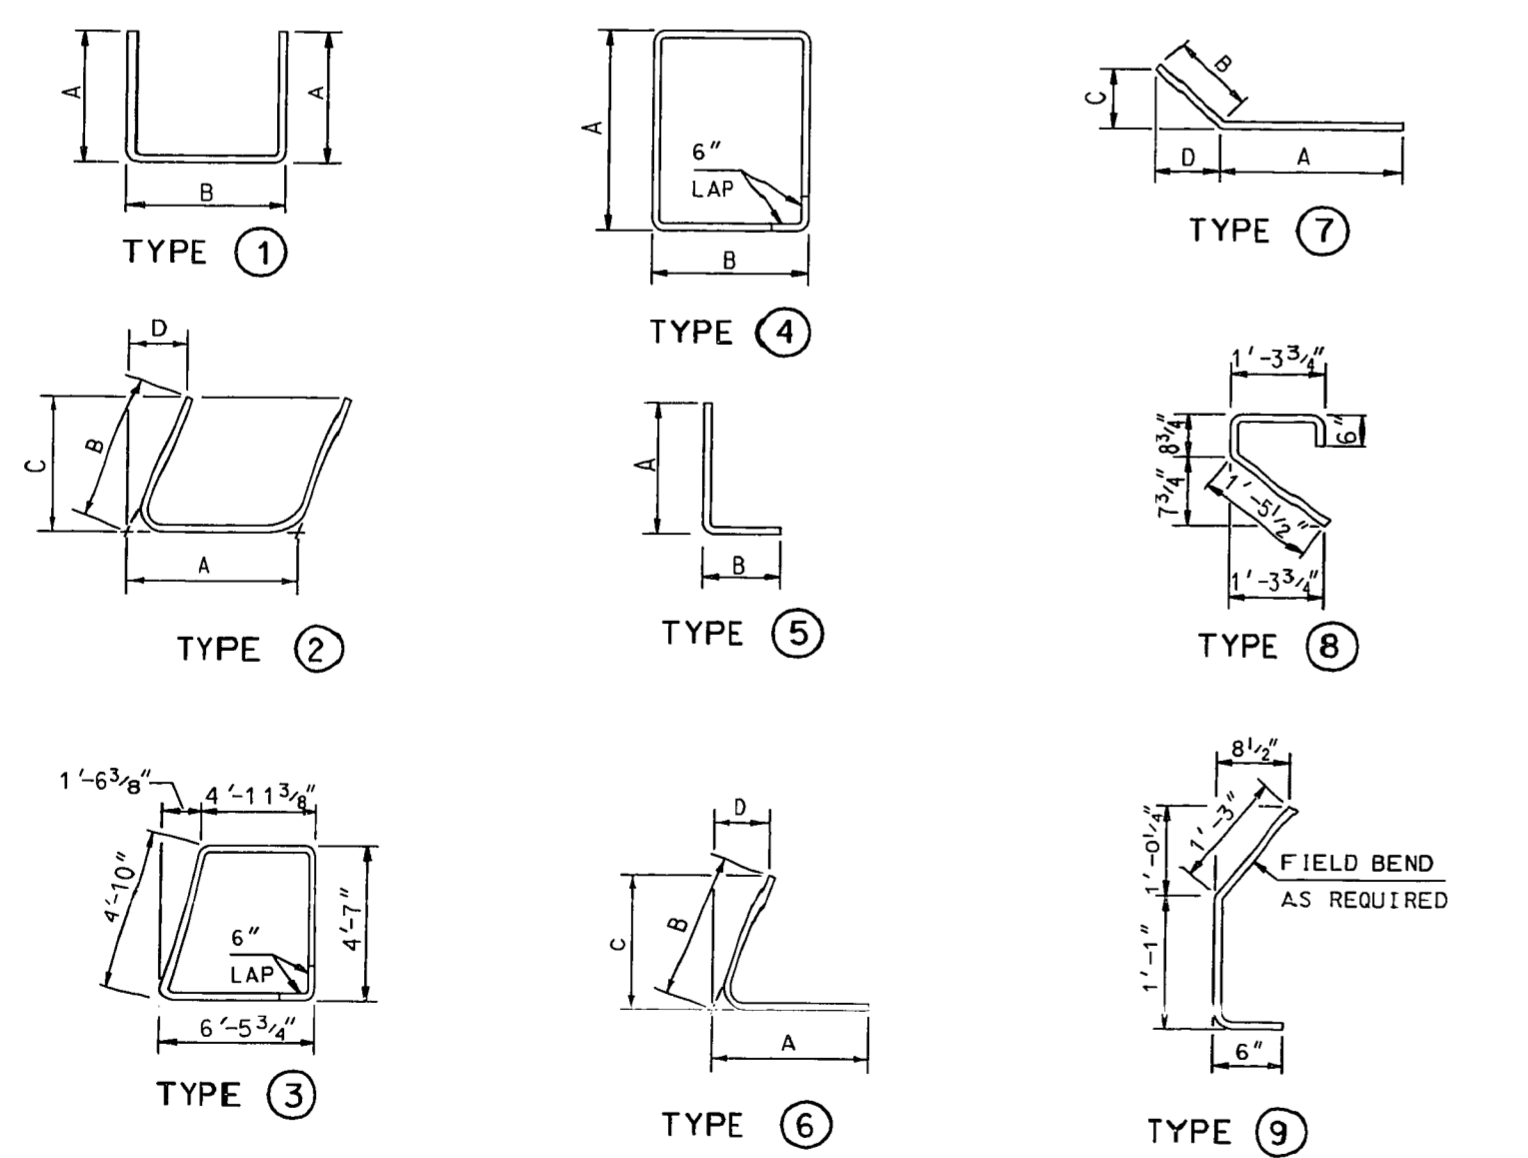


SECTION A-A

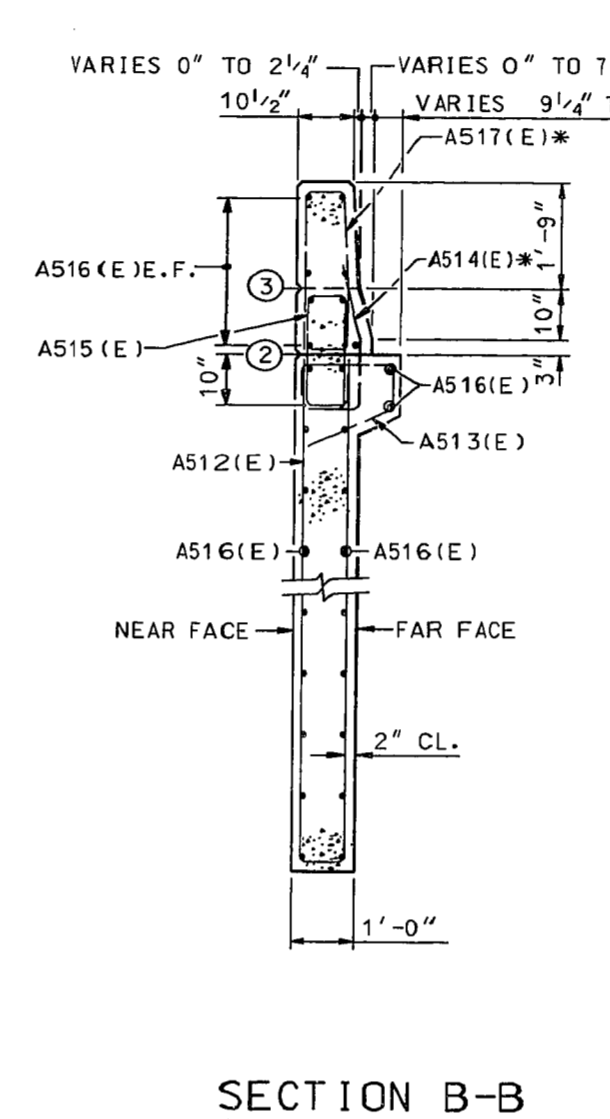


SECTION B-B

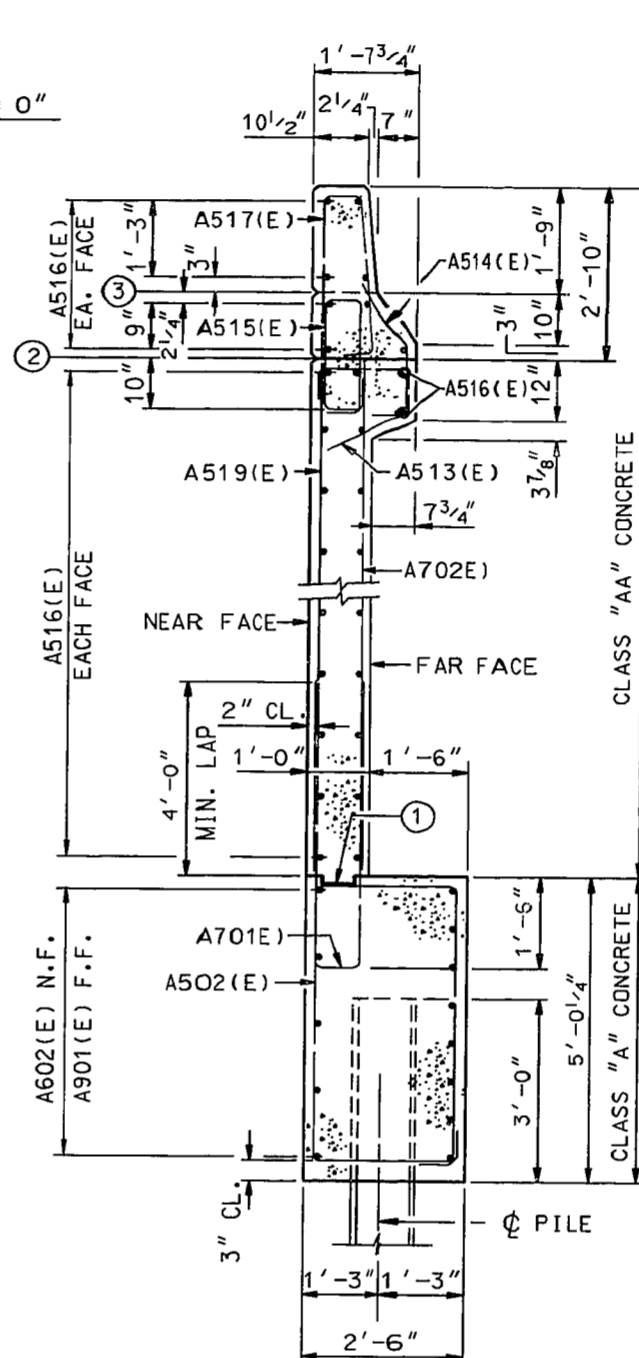

SECTION C-C

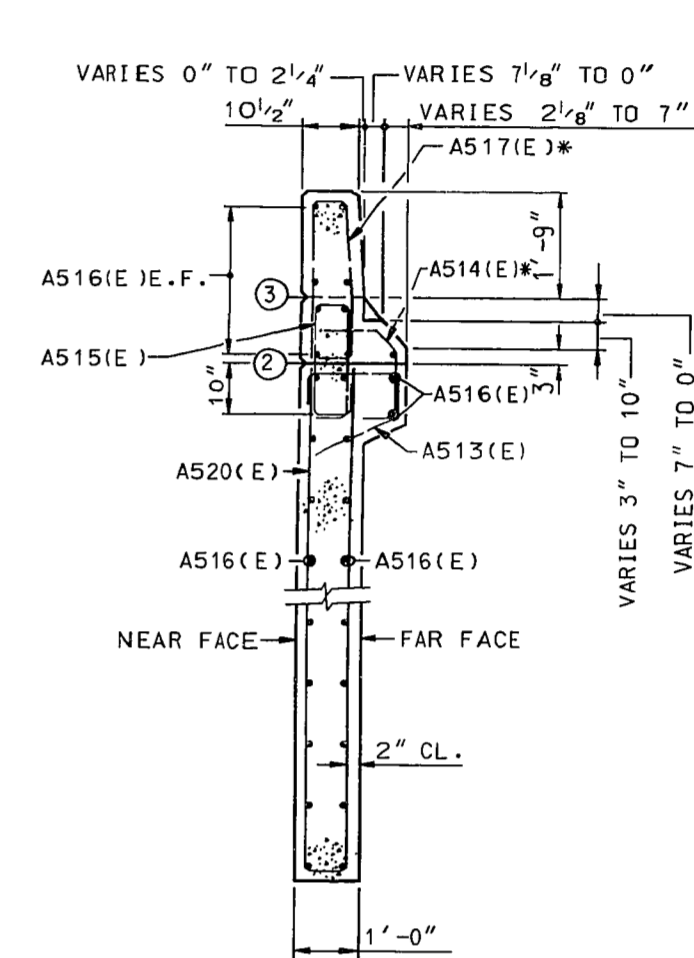


SECTION D-D

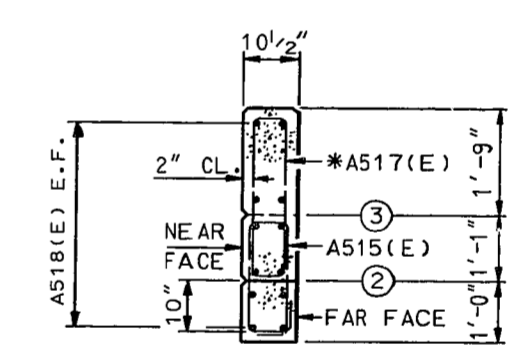

SECTION E-E

- NOTATIONS
- ① 2"x4" KEYED CONSTRUCTION JOINT
  - ② MANDATORY CONSTRUCTION JOINT & RUSTICATION GROOVE
  - ③ OPTIONAL CONSTRUCTION JOINT & RUSTICATION GROOVE (USE ONLY IF OPTIONAL JOINT IN SUPERSTRUCTURE BARRIER IS USED.)
- E.F. - DENOTES EACH FACE  
N.F. - DENOTES NEAR FACE  
F.F. - DENOTES FAR FACE  
\* - INDICATES TO FIELD BEND AS REQ'D.

## RUSTICATION GROOVE

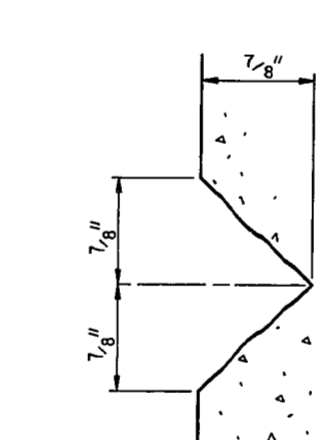

ITEM	UNIT	QUANTITY
CLASS "A" CONCRETE	CU. YDS.	E.B.1 04.5 E.B.2 04.5
CLASS "AA" CONCRETE	CU. YDS.	60.5 59.9
EPOXY COATED REINFORCEMENT	LBS.	15498 15467




## END BENT 1 & 2 DETAILS


U.S. 62/68 OVER LAWRENCE CREEK SHEET 14  
**COMMONWEALTH OF KENTUCKY**  
**DEPARTMENT OF HIGHWAYS**  
 FRANKFORT  
 COUNTY OF  
**MASON**  
 U.S. 62/68  
 ROAD  
 STATION 182+7.50 P. E. PROJECT NO.  
 CONSTRUCTION PROJECT NO. MAINTENANCE PROJECT NO. DRAWING NO. 23687

UPDATE DATE  
LETTING DATE


DESIGNED BY: [ ] CHECKED BY: [ ] DATE: 8/24  
 REVISIONS: [ ] COLUMN LOGS 101 DATE: 8/24  
 [ ] AS PER KY MARK UP DATE: 8/24  
 PREPARED BY: [ ] SECTION CHECKED BY: [ ]

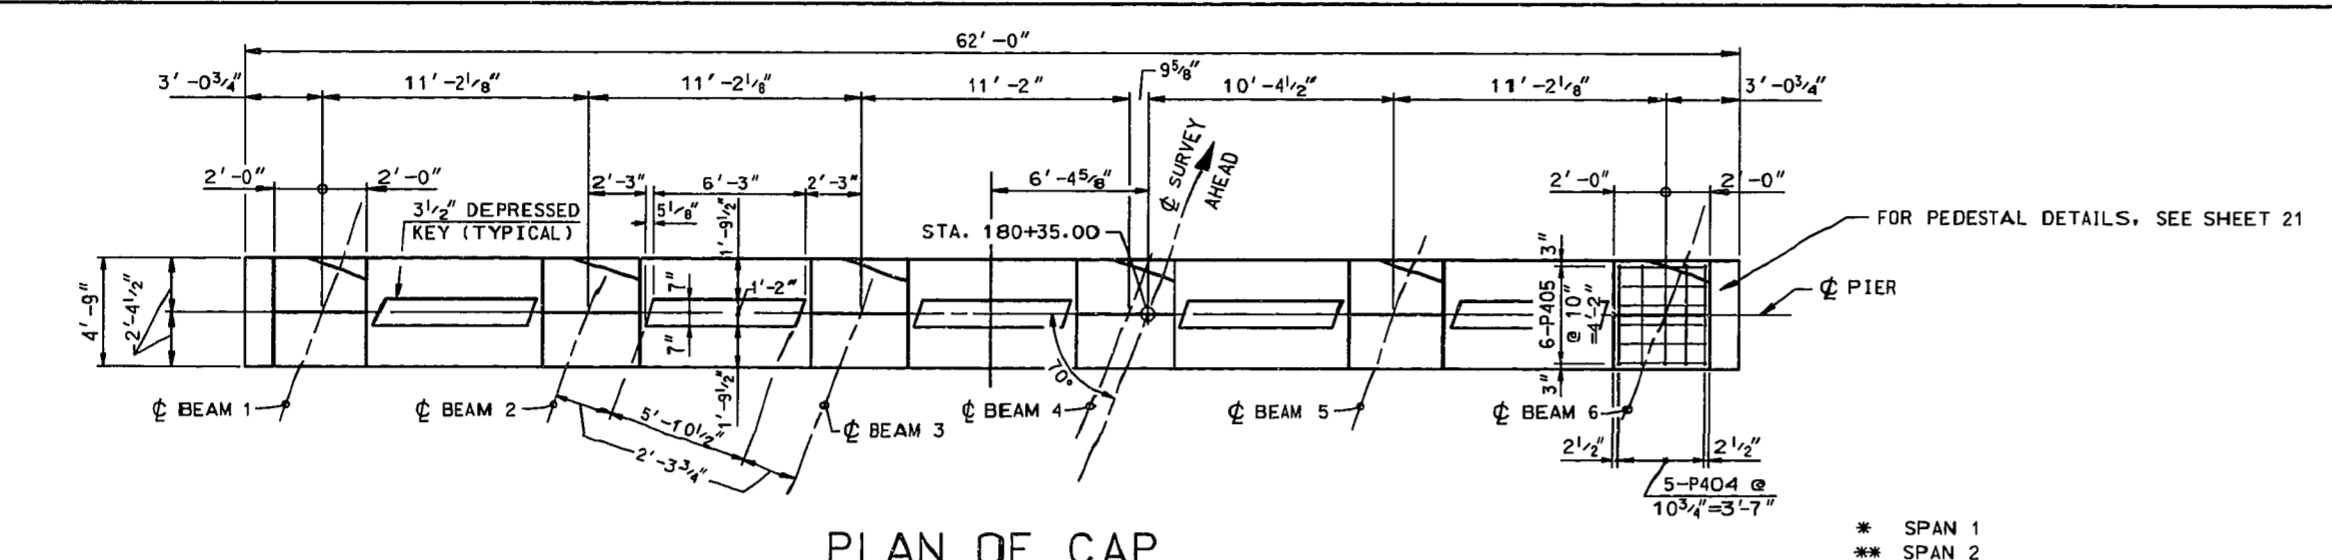

PLAN OF CAP

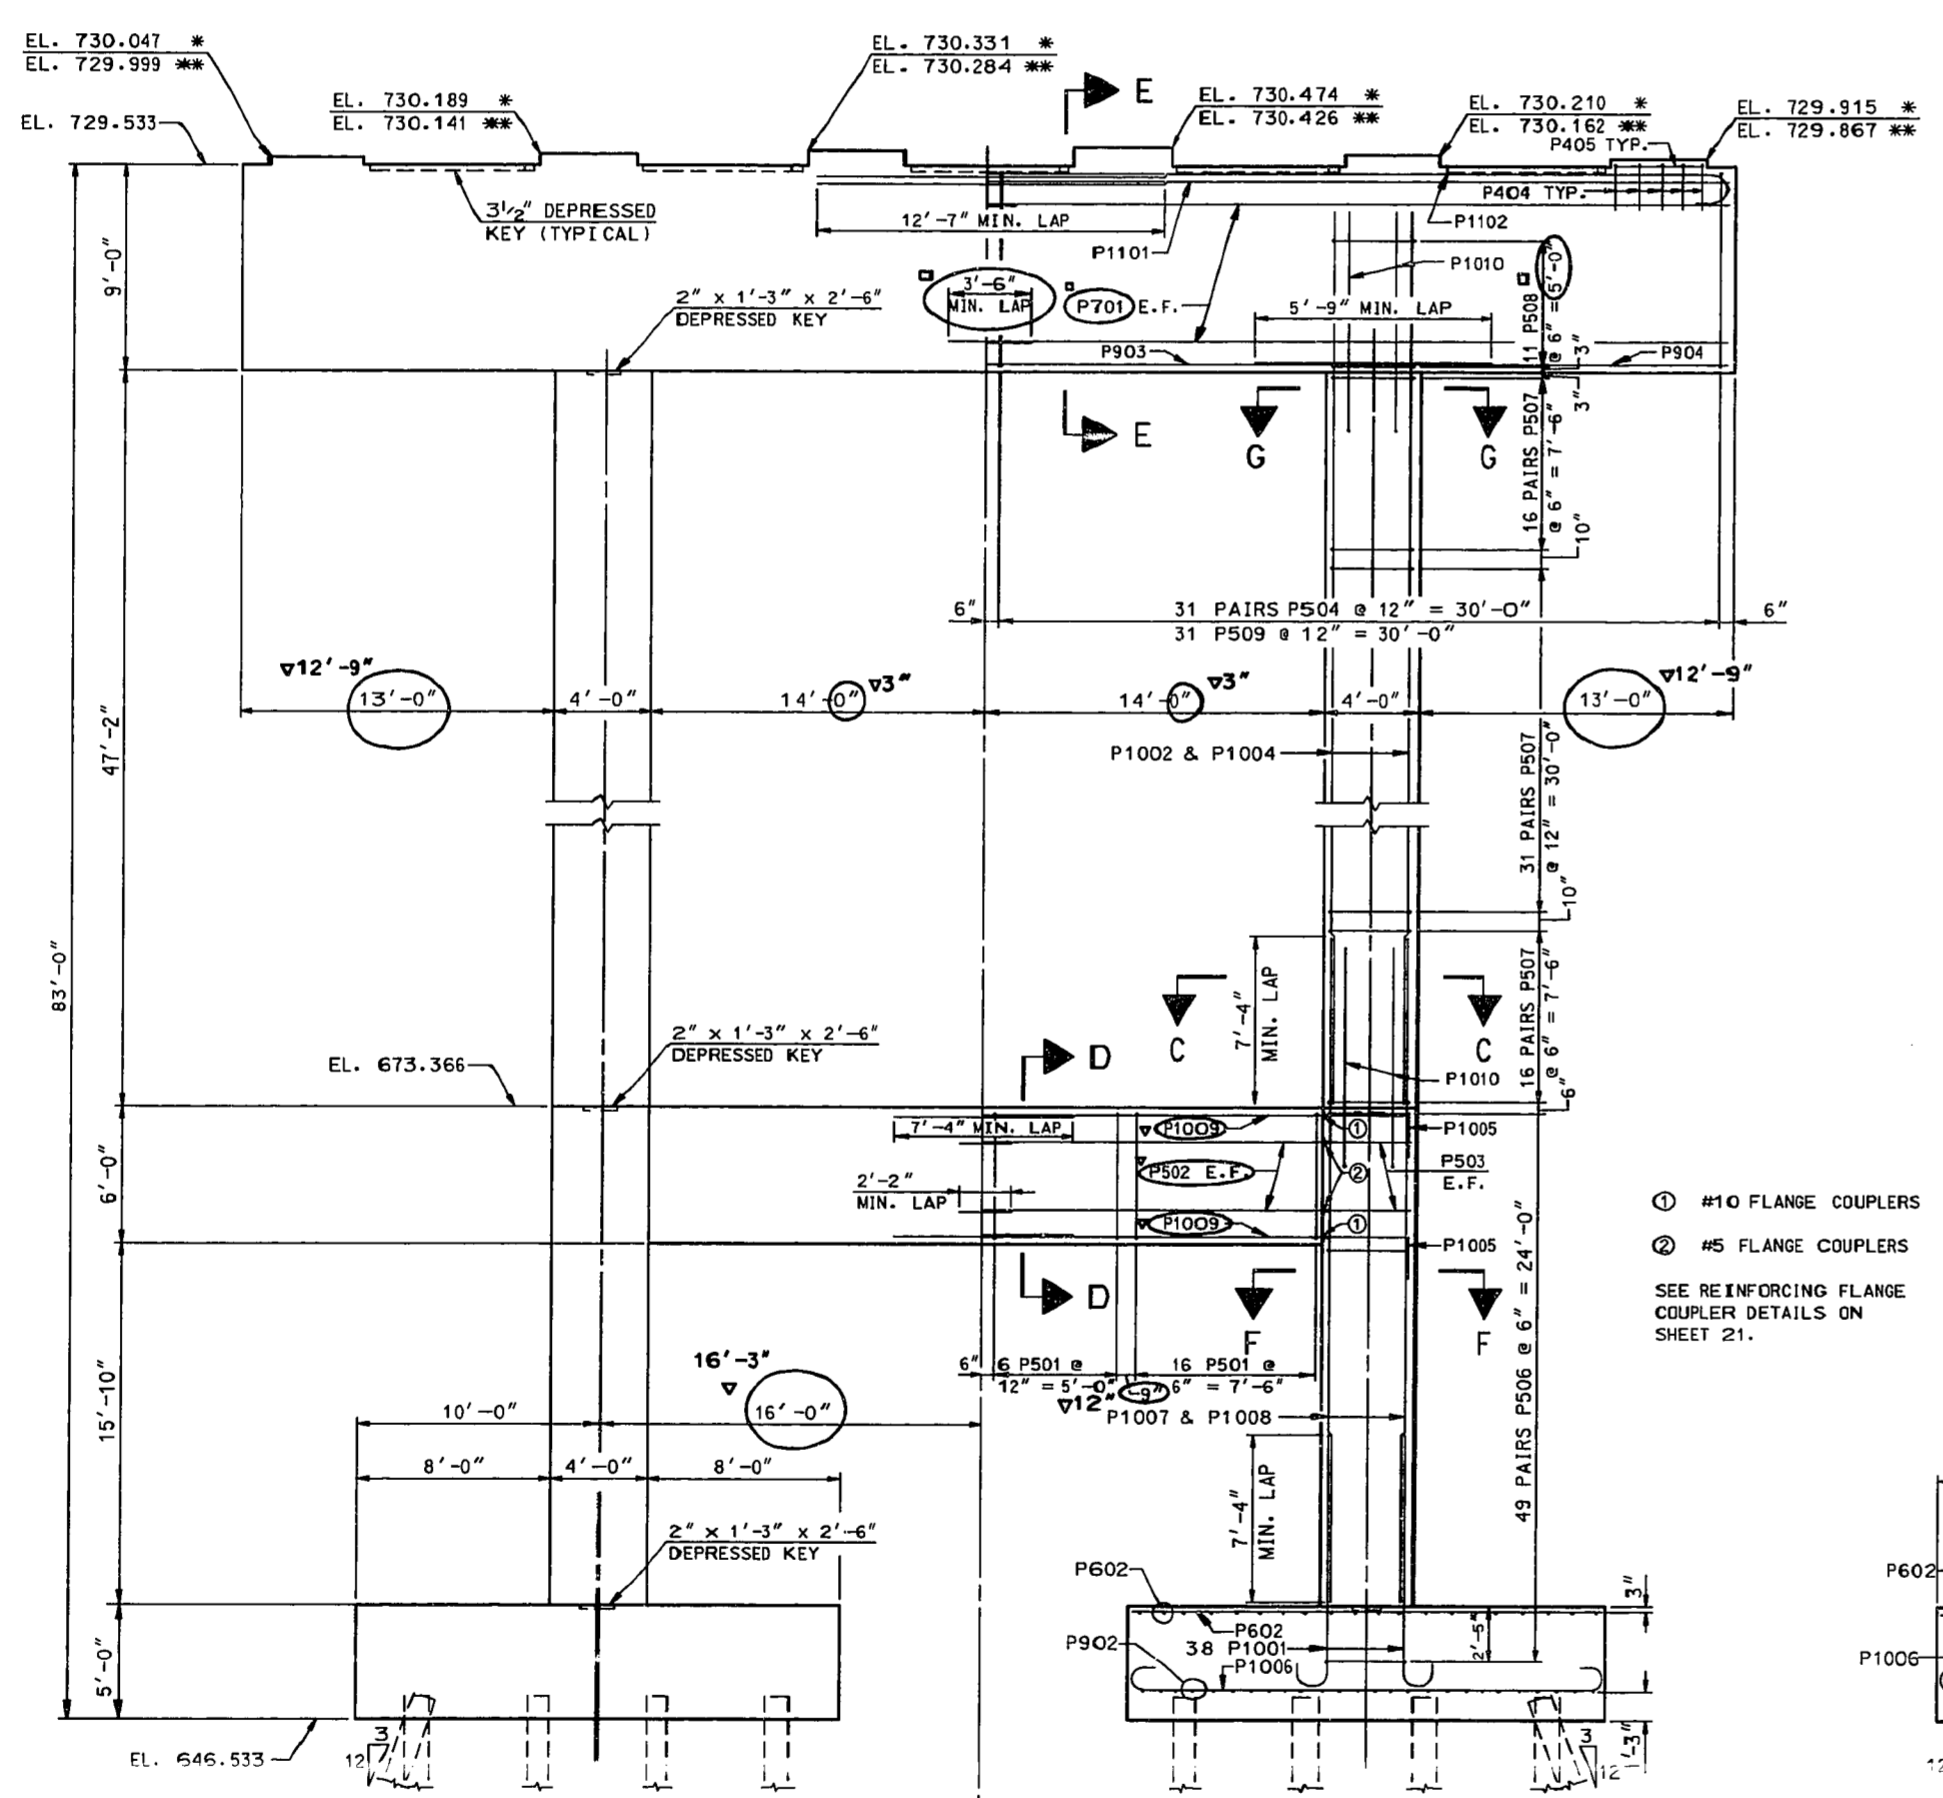


PART ELEVATION

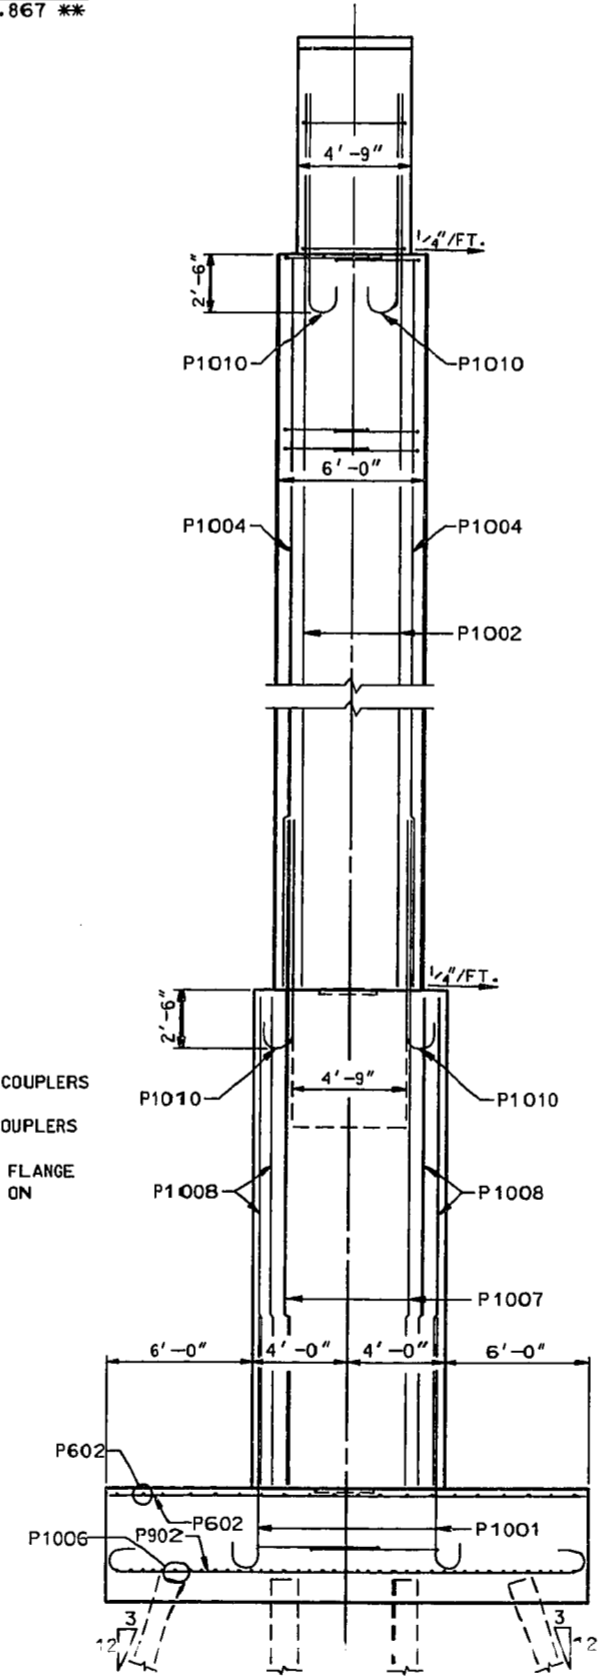


PART END ELEVATION

① #10 FLANGE COUPLERS  
 ② #5 FLANGE COUPLERS  
 SEE REINFORCING FLANGE COUPLER DETAILS ON SHEET 21.

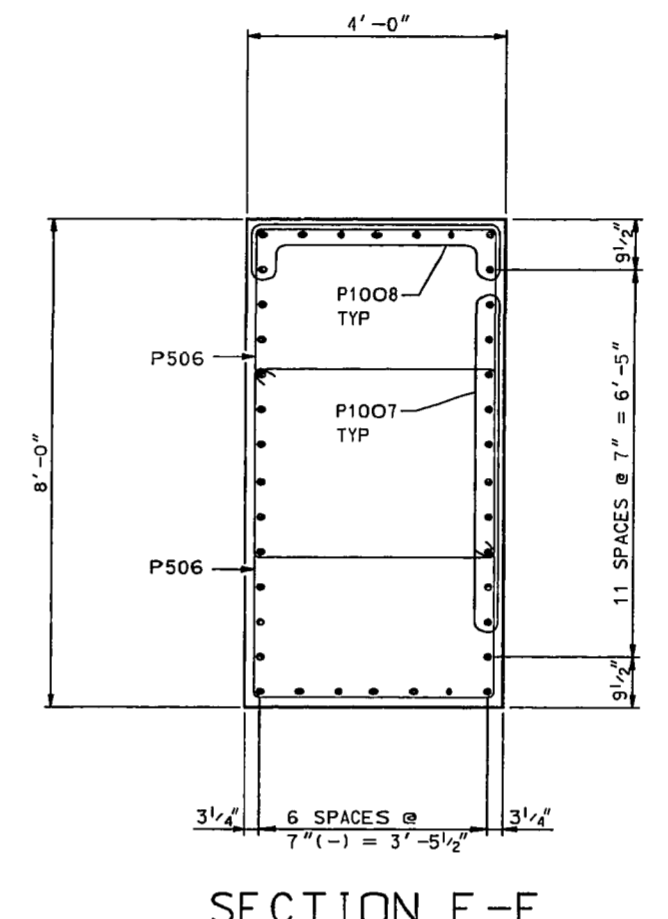


SECTION F-F

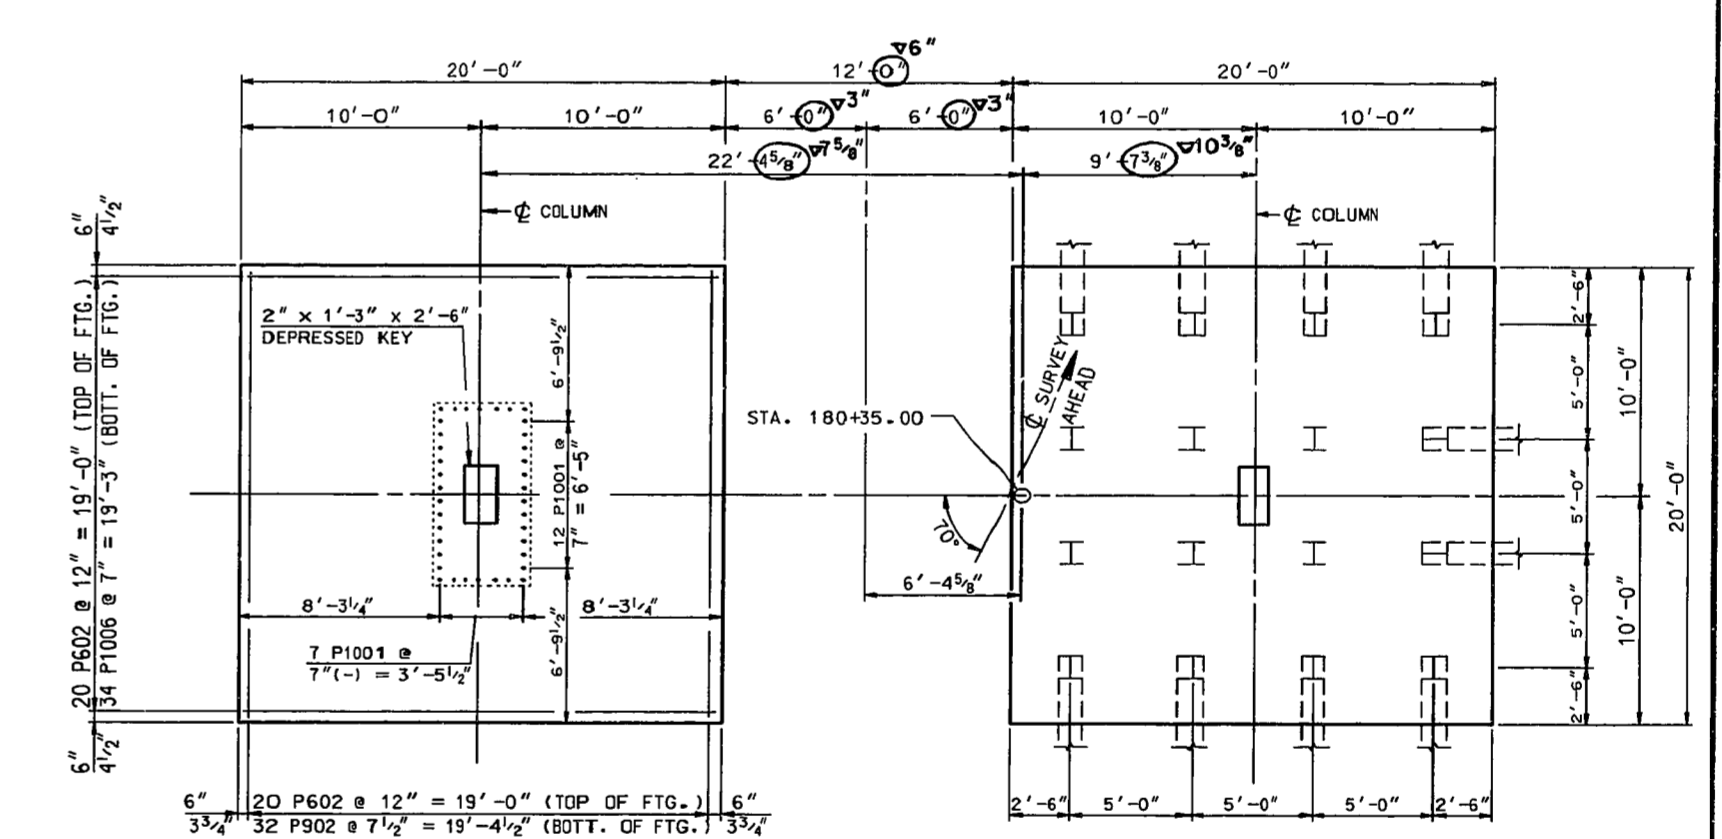

PLAN OF FOOTING

FOR SECTIONS C-C, D-D, E-E AND G-G, SEE SHEET 21.

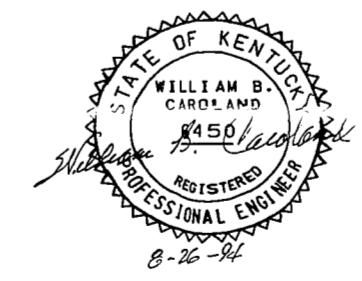

PIER 1


U.S. 62/68 OVER LAWRENCE CREEK SHEET 15  
**COMMONWEALTH OF KENTUCKY**  
**DEPARTMENT OF HIGHWAYS**  
 FRANKFORT  
 COUNTY OF  
**MASON**  
 U.S. 62/68  
 ROAD  
 STATION 182+67.50 P. E. PROJECT NO.  
 CONSTRUCTION PROJECT NO. MAINTENANCE PROJECT NO.  
 DRAWING NO. 23687








DESIGNED BY: JCS  
 CHECKED BY: BDD  
 DATE: 8/1/94  
 REVISION: 1  
 DATE: 8/22/94  
 PREPARED BY: BDD  
 SECTION: SECTION  
 DATE: 8/1/94  
 DATE: 8/22/94  
 DATE: 8/1/94  
 DATE: 8/22/94  
 DATE: 8/1/94  
 DATE: 8/22/94

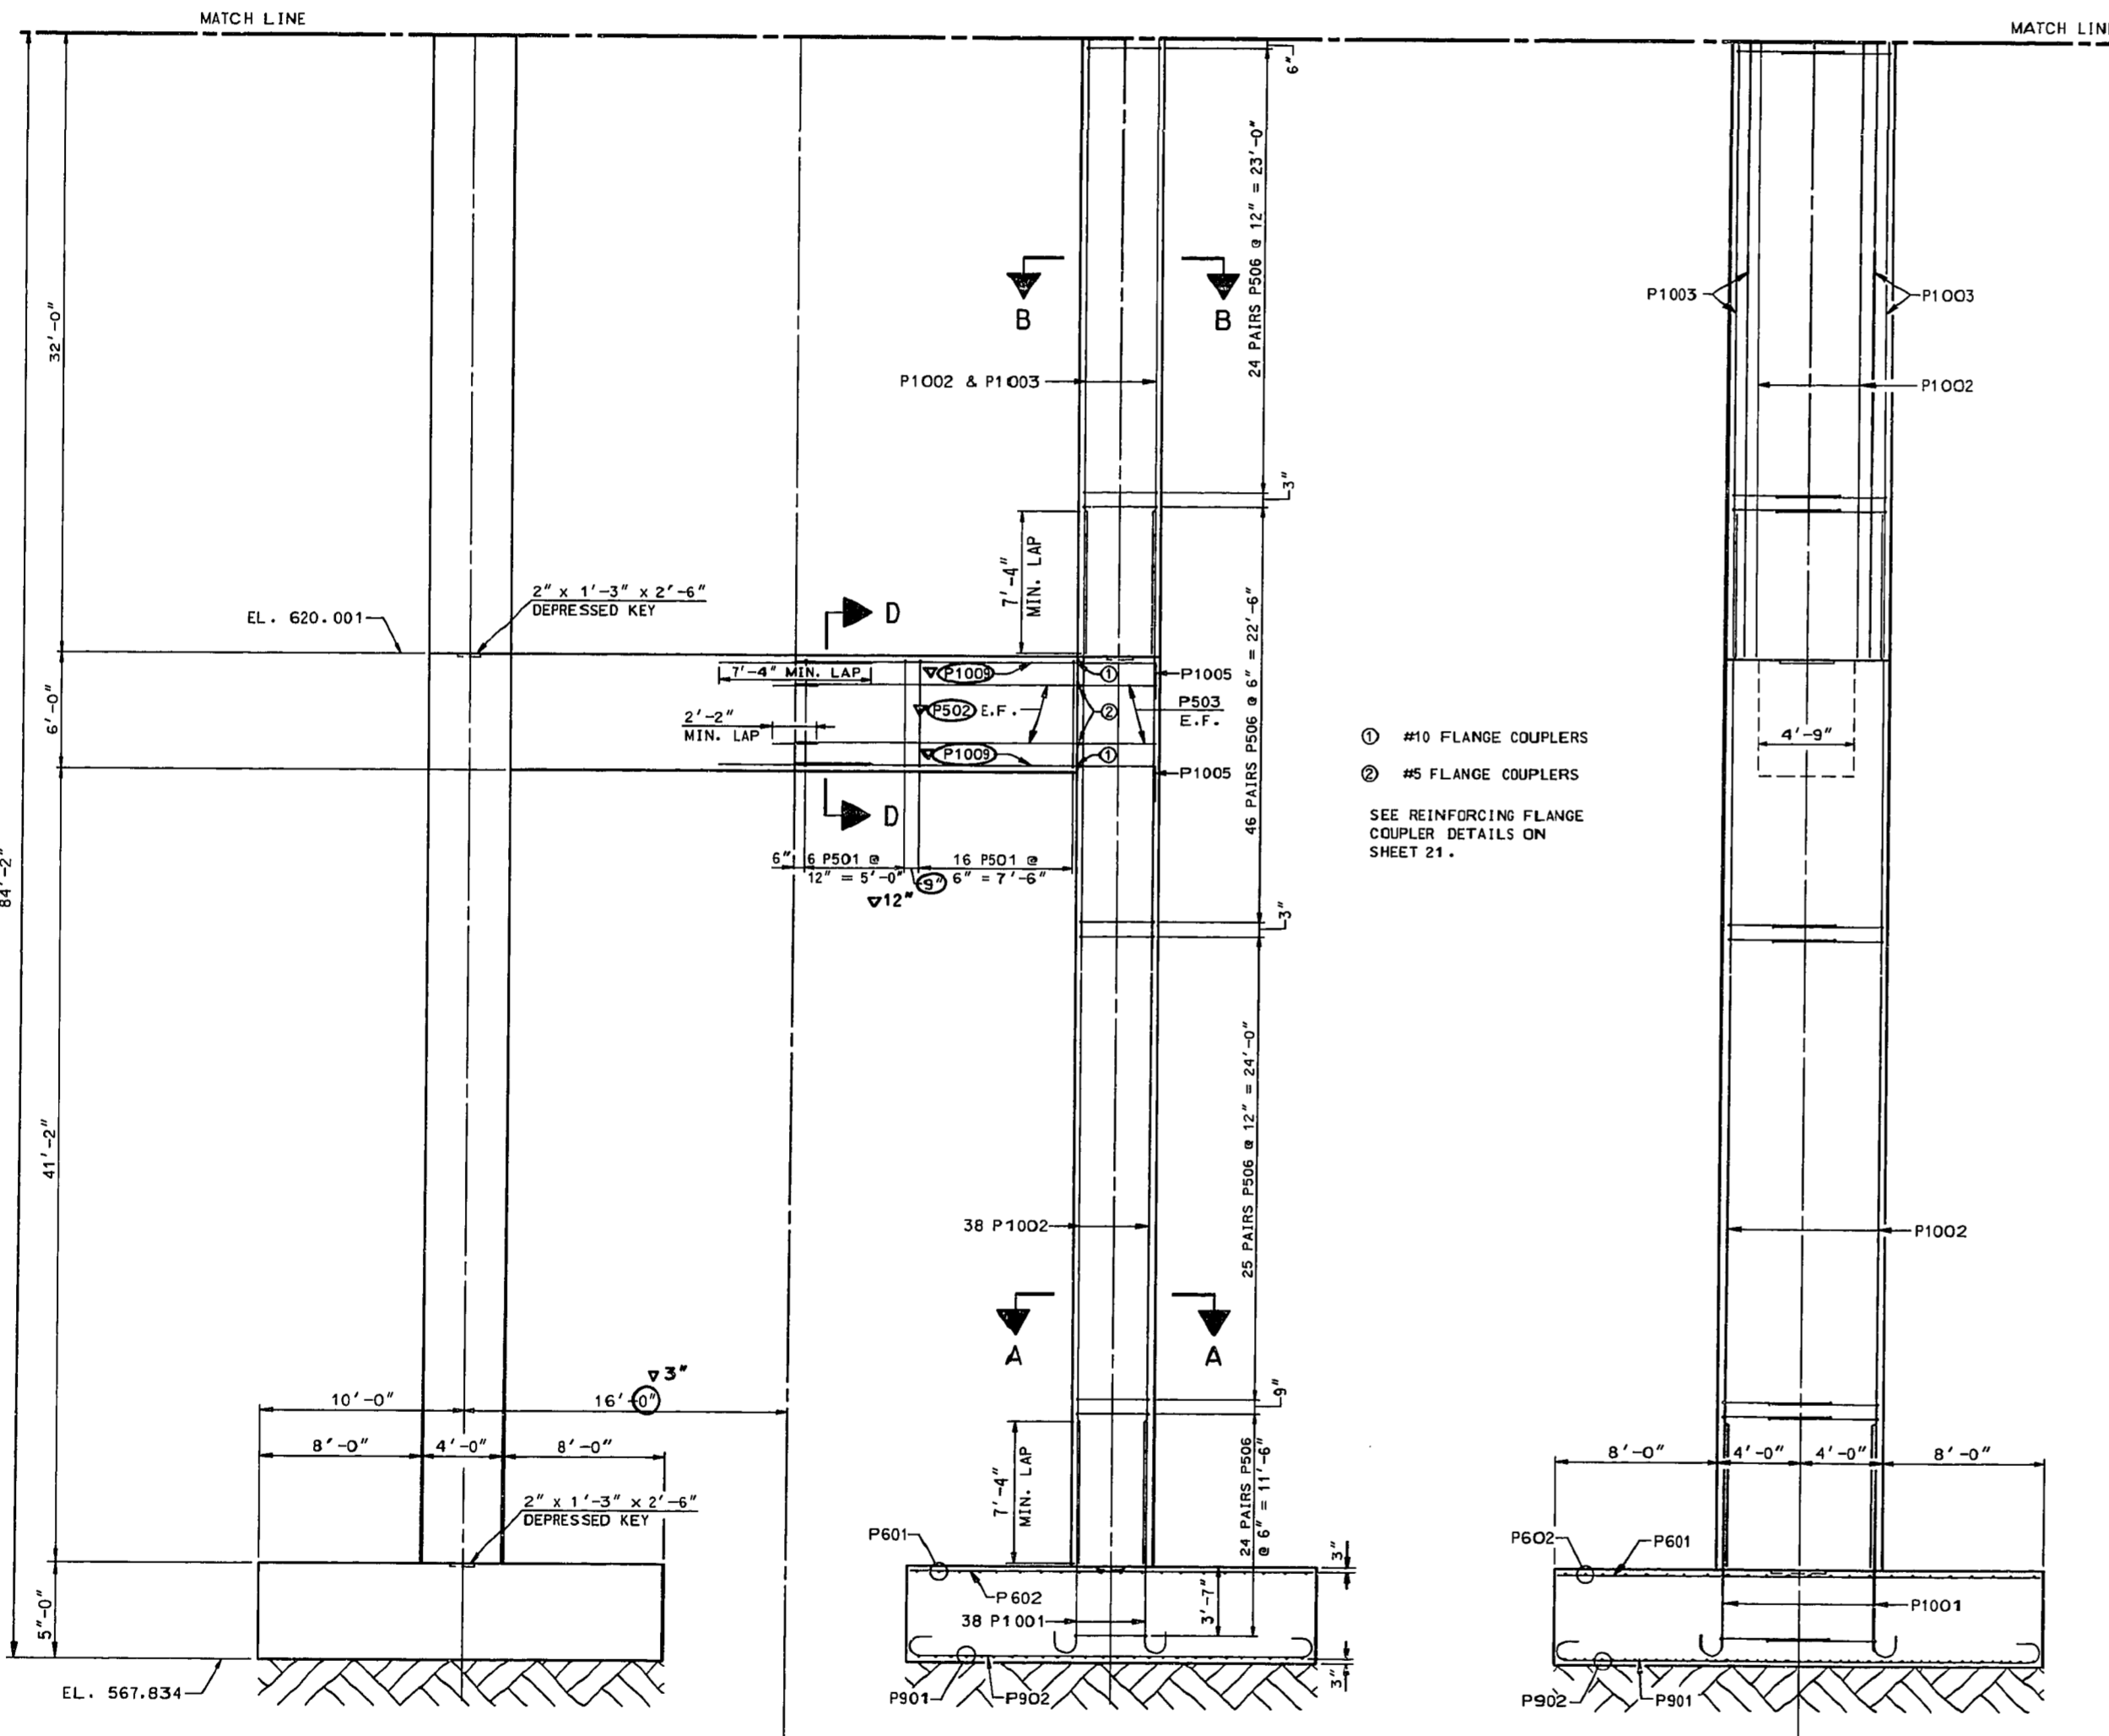

PART ELEVATION

PART END ELEVATION

① #10 FLANGE COUPLERS  
 ② #5 FLANGE COUPLERS  
 SEE REINFORCING FLANGE COUPLER DETAILS ON SHEET 21.

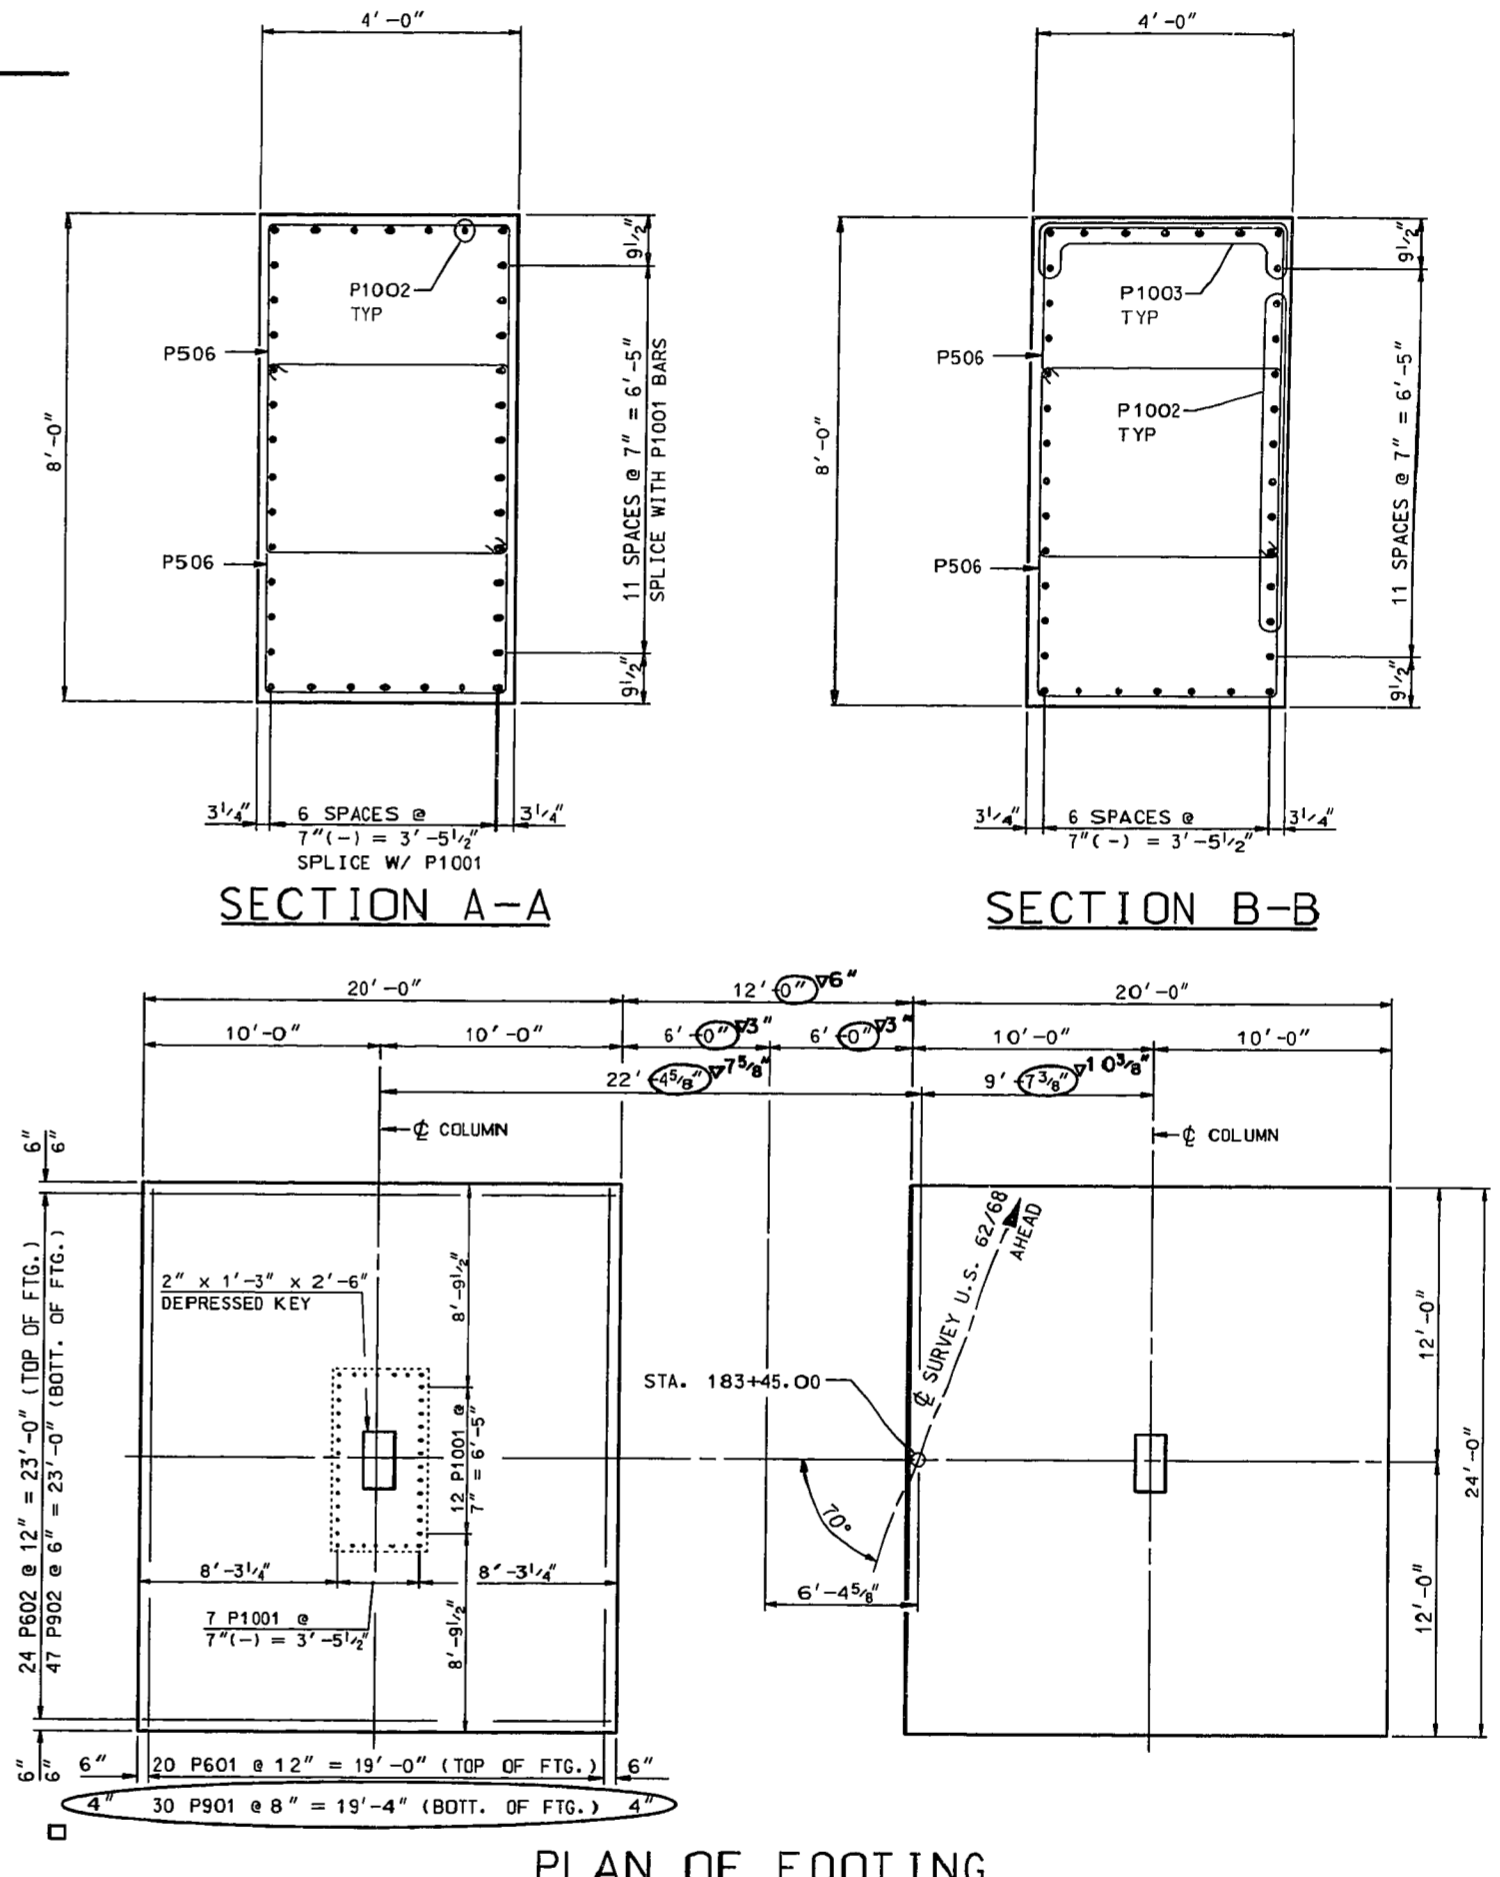

SECTION A-A

SECTION B-B

PLAN OF FOOTING

FOR SECTION D-D SEE SHEET 21.



PIER 3

U.S. 62/68 OVER LAWRENCE CREEK SHEET 18  
**COMMONWEALTH OF KENTUCKY**  
**DEPARTMENT OF HIGHWAYS**  
 FRANKFORT  
 COUNTY OF  
**MASON**  
 U.S. 62/68  
 ROAD  
 STATION 182+7.50 P. E. PROJECT NO.  
 CONSTRUCTION PROJECT NO. MAINTENANCE PROJECT NO. DRAWING NO. 23687








UPDATE DATE  
LETTING DATE


DESIGNED BY: JCS  
CHECKED BY: JCS  
DATE: 8/1/84  
REVISION: AS PER MARK UP  
DATE: 8/2/84

REVISION: AS PER MARK UP  
DATE: 8/2/84

SECTION CHECKED BY: JCS  
DATE: 8/2/84

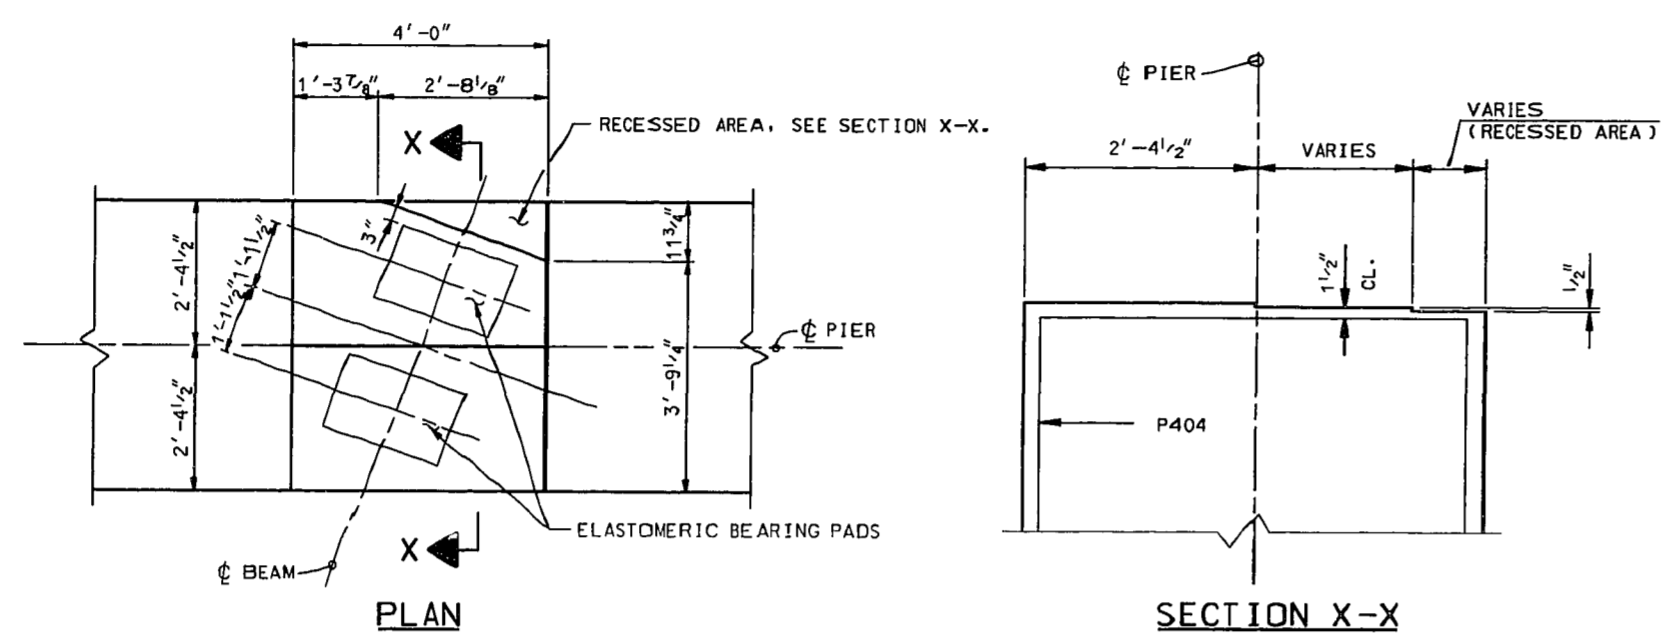


PEDESTAL DETAILS

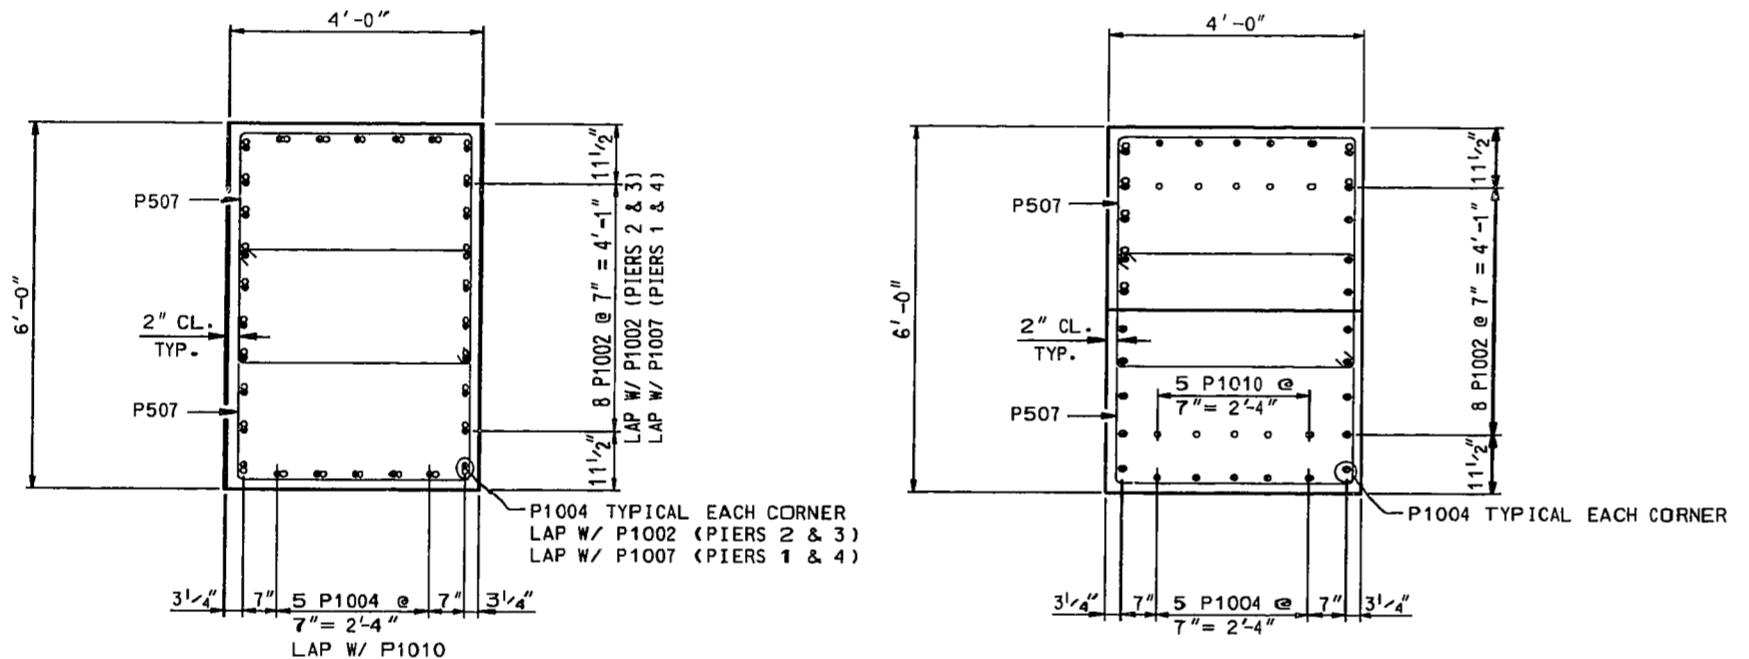


SECTION C-C

SECTION G-G

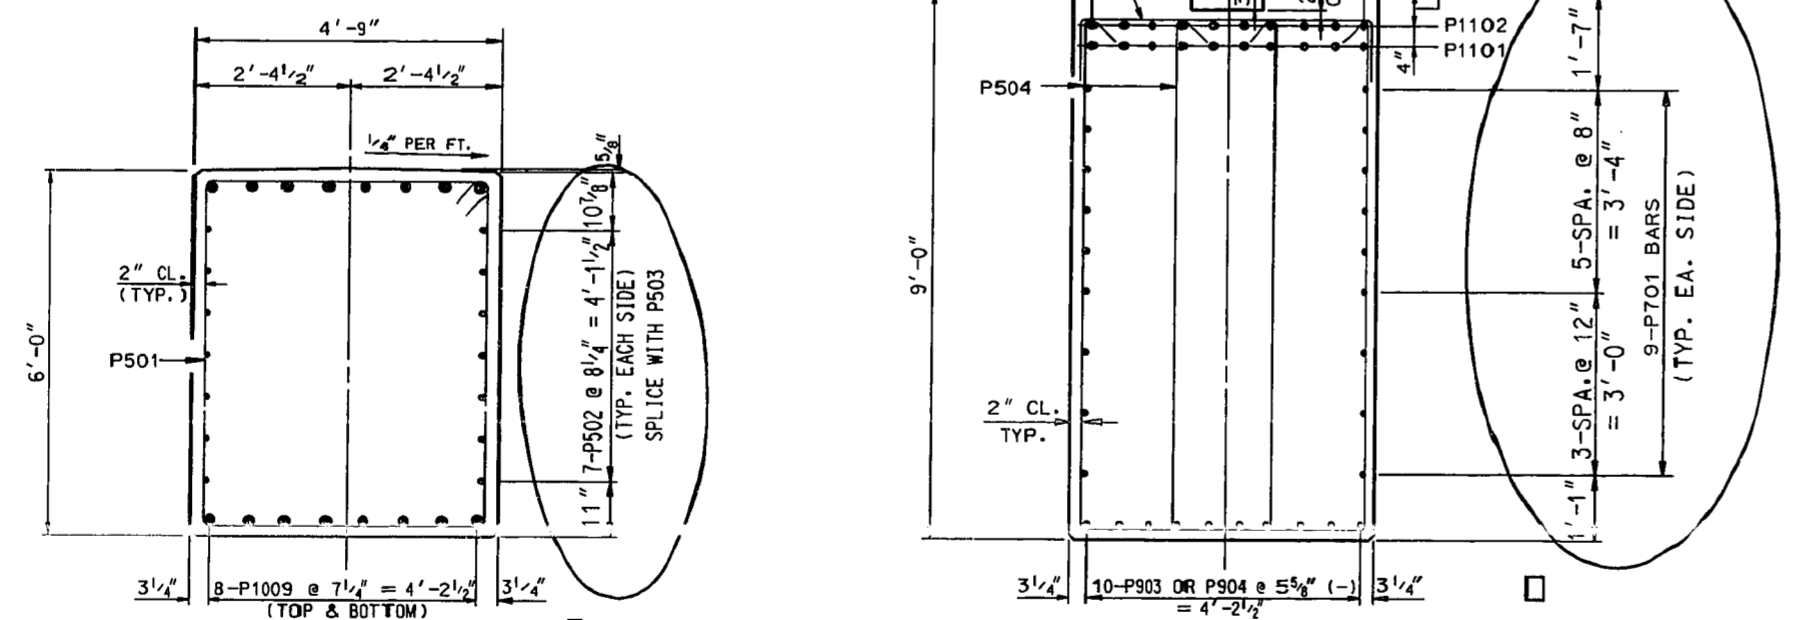


SECTION D-D


SECTION E-E

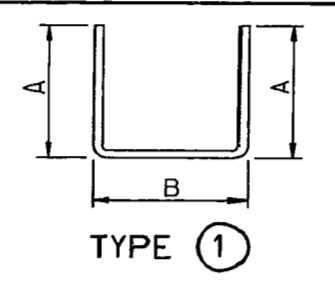


TYPE 1

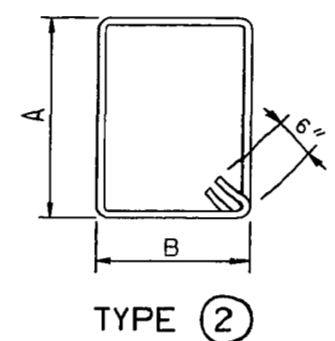


TYPE 2

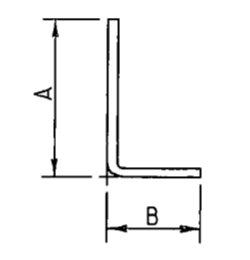


TYPE 3

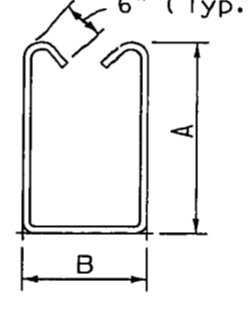


TYPE 4

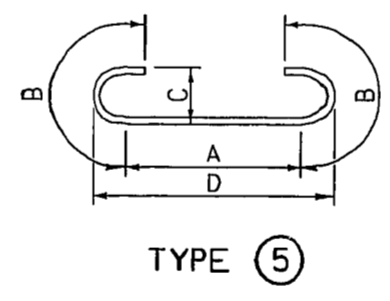

TYPE 5

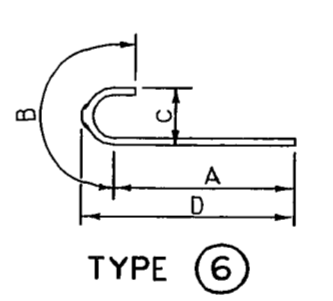

TYPE 6

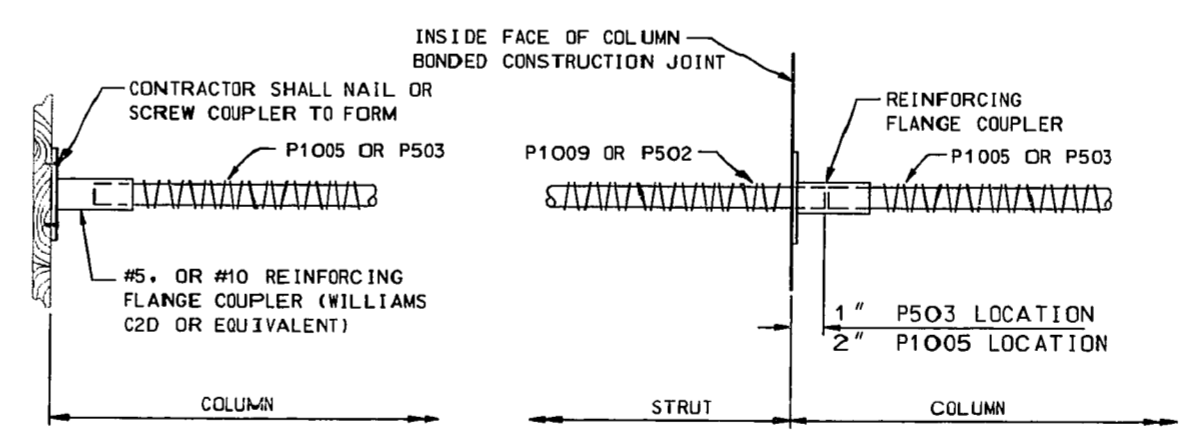

REINFORCING FLANGE COUPLER DETAILS

BILL OF REINFORCEMENT

MARK	TYPE	SIZE	NUMBER				LENGTH Ft. In.	LOCATION	QUANTITY							
			PIER 1	PIER 2	PIER 3	PIER 4			A	B	C	D				
P404	1	4	30	30	30	30	7 10	PEDESTAL	1	9	4	5				
P405	STR	4	36	36	36	36	3 9	PEDESTAL								
P501	2	5	44	88	88	44	20 11	STRUT	5	8	4	5				
P502	STR	5	28	56	56	28	15 1	STRUT								
P503	STR	5	28	56	56	28	3 10	COLUMN								
P504	4	5	124	124	124	124	20 6	CAP	8	4 1/2	2	11				
P505								NOT USED								
P506	2	5	196	592	592	196	18 9	COLUMN	5	4	3	8				
P507	2	5	252	252	252	252	15 7	COLUMN	3	9	3	8				
P508	2	5	22	22	22	22	16 5	CAP	4	2	3	8				
P509	1	5	62	62	62	62	6 4	CAP	1	0	4	5				
P601	STR	6		40	40		23 9	FOOTING								
P602	STR	6	80	48	48	80	19 8	FOOTING								
P701	STR	7	36	36	36	36	32 7	CAP								
P901	5	9		60	60		26 6	FOOTING	22	8	1	11	0	11 3/4	23	7 3/4
P902	5	9	64	94	94	64	22 6	FOOTING	18	8	1	11	0	11 3/4	19	7 3/4
P903	STR	9	10	10	10	10	37 9	CAP								
P904	STR	9	20	20	20	20	17 11	CAP								
P1001	6	10	76	76	76	76	14 8	COLUMN	12	6	2	2	1	1 1/4	13	0 5/8
P1002	STR	10	32	148	148	32	54 6	COLUMN								
P1003	STR	10		36	36		47 0	COLUMN								
P1004	STR	10	28	28	28	28	47 0	COLUMN								
P1005	3	10	32	64	64	32	5 9	COLUMN	3	10	2	0				
P1006	5	10	68			68	22 11	FOOTING	18	7	2	2	1	1 1/4	19	8 1/4
P1007	STR	10	40			40	29 2	COLUMN								
P1008	STR	10	36			36	21 6	COLUMN								
P1009	STR	10	32	64	64	32	17 8	STRUT								
P1010	6	10	40	40	40	40	11 8	COLUMN	9	6	2	2	1	1 1/4	10	0 5/8
P1101	STR	11	20	20	20	20	37 2	CAP								
P1102	6	11	20	20	20	20	39 5	CAP	37	0	2	5	1	2 3/4	37	7 3/8

ESTIMATE OF QUANTITIES

ITEM	UNIT	QUANTITY			
		PIER 1	PIER 2	PIER 3	PIER 4
CLASS "A" CONCRETE	CU. YDS.	417.2	648.2	648.2	417.2
STEEL REINFORCEMENT	LBS.	69975	109289	109289	69975
HP14 x 73 PILES	L.F.	1043	-	-	1992
TEST PILES	L.F.	45	-	-	70
PILE POINTS (14")	E.A.	32	-	-	32
STR. EXCAV. (COMMON)	C.Y.	-	184	138	-
STR. EXCAV. (ROCK)	C.Y.	-	695	469	-
		417.7	649.3	649.3	417.7
		71716	111850	111850	71716

U.S. 62/68 OVER LAWRENCE CREEK SHEET 21

COMMONWEALTH OF KENTUCKY  
DEPARTMENT OF HIGHWAYS  
FRANKFORT  
COUNTY OF  
MASON  
U.S. 62/68  
ROAD

STATION 182+67.50 P.E. PROJECT NO.  
CONSTRUCTION PROJECT NO. MAINTENANCE PROJECT NO. DRAWING NO. 23687













F-10971 (09/7) 09/7 E33  
 DESIGNED BY: I.B. SOSP. DATE: 6-24-64  
 CHECKED BY: L. SWANSON. DATE: 6-24-64  
 REVISIONS: NO. 1. BY: I.B. SOSP. DATE: 6-24-64  
 NO. 2. BY: I.B. SOSP. DATE: 6-24-64  
 NO. 3. BY: I.B. SOSP. DATE: 6-24-64  
 NO. 4. BY: I.B. SOSP. DATE: 6-24-64  
 NO. 100. BY: I.B. SOSP. DATE: 6-24-64

BILL OF REINFORCEMENT														
MARK	TYPE	NO.	SIZE	LENGTH		A		B		C		D		LOCATION
				FT.	IN.	FT.	IN.	FT.	IN.	FT.	IN.	FT.	IN.	
S1(E)	STR.	2	#6	3	0									TOP OF SLAB
S2(E)	STR.	2	#6	4	7									TOP OF SLAB
S3(E)	STR.	2	#6	6	2									TOP OF SLAB
S4(E)	STR.	2	#6	7	9									TOP OF SLAB
S5(E)	STR.	2	#6	9	4									TOP OF SLAB
S6(E)	STR.	2	#6	11	0									TOP OF SLAB
S7(E)	STR.	2	#6	12	7									TOP OF SLAB
S8(E)	STR.	2	#6	14	2									TOP OF SLAB
S9(E)	STR.	2	#6	15	9									TOP OF SLAB
S10(E)	STR.	2	#6	17	5									TOP OF SLAB
S11(E)	STR.	2	#6	19	0									TOP OF SLAB
S12(E)	STR.	2	#6	20	7									TOP OF SLAB
S13(E)	STR.	2	#6	22	2									TOP OF SLAB
S14(E)	STR.	2	#6	23	9									TOP OF SLAB
S15(E)	STR.	2	#6	25	5									TOP OF SLAB
S16(E)	STR.	2	#6	27	0									TOP OF SLAB
S17(E)	STR.	2	#6	28	7									TOP OF SLAB
S18(E)	STR.	2	#6	30	2									TOP OF SLAB
S19(E)	STR.	2	#6	31	10									TOP OF SLAB
S20(E)	STR.	2	#6	33	5									TOP OF SLAB
S21(E)	STR.	2	#6	35	0									TOP OF SLAB
S22(E)	STR.	2	#6	36	7									TOP OF SLAB
S23(E)	STR.	2	#6	38	3									TOP OF SLAB
S24(E)	STR.	2	#6	39	10									TOP OF SLAB
S25(E)	STR.	2	#6	41	5									TOP OF SLAB
S26(E)	STR.	2	#6	43	2									TOP OF SLAB
S27(E)	STR.	2	#6	44	9									TOP OF SLAB
S28(E)	STR.	2	#6	46	3									TOP OF SLAB
S29(E)	STR.	2	#6	47	10									TOP OF SLAB
S30(E)	STR.	2	#6	49	5									TOP OF SLAB
S31(E)	STR.	2	#6	51	1									TOP OF SLAB
S32(E)	STR.	2	#6	52	8									TOP OF SLAB
S33(E)	STR.	2	#6	54	3									TOP OF SLAB
S34(E)	STR.	2	#6	55	10									TOP OF SLAB
S35(E)	STR.	2	#6	57	5									TOP OF SLAB
S36(E)	STR.	2	#6	59	1									TOP OF SLAB
S37(E)	STR.	2	#6	60	8									TOP OF SLAB
S38(E)	STR.	2	#6	62	3									BOTTOM OF SLAB
S39(E)	STR.	2	#6	63	10									BOTTOM OF SLAB
S40(E)	STR.	2	#6	65	5									BOTTOM OF SLAB
S41(E)	STR.	2	#6	66	12									BOTTOM OF SLAB
S42(E)	STR.	2	#6	68	7									BOTTOM OF SLAB
S43(E)	STR.	2	#6	70	2									BOTTOM OF SLAB
S44(E)	STR.	2	#6	72	9									BOTTOM OF SLAB
S45(E)	STR.	2	#6	74	4									BOTTOM OF SLAB
S46(E)	STR.	2	#6	76	11									BOTTOM OF SLAB
S47(E)	STR.	2	#6	78	6									BOTTOM OF SLAB
S48(E)	STR.	2	#6	80	13									BOTTOM OF SLAB
S49(E)	STR.	2	#6	82	8									BOTTOM OF SLAB
S50(E)	STR.	2	#6	84	3									BOTTOM OF SLAB
S51(E)	STR.	2	#6	86	10									BOTTOM OF SLAB
S52(E)	STR.	2	#6	88	5									BOTTOM OF SLAB
S53(E)	STR.	2	#6	90	12									BOTTOM OF SLAB
S54(E)	STR.	2	#6	92	7									BOTTOM OF SLAB
S55(E)	STR.	2	#6	94	2									BOTTOM OF SLAB
S56(E)	STR.	2	#6	96	9									BOTTOM OF SLAB
S57(E)	STR.	2	#6	98	4									BOTTOM OF SLAB
S58(E)	STR.	2	#6	100	11									BOTTOM OF SLAB
S59(E)	STR.	2	#6	102	6									BOTTOM OF SLAB
S60(E)	STR.	2	#6	104	13									BOTTOM OF SLAB
S61(E)	STR.	2	#6	106	8									BOTTOM OF SLAB
S62(E)	STR.	2	#6	108	3									BOTTOM OF SLAB
S63(E)	STR.	2	#6	110	10									BOTTOM OF SLAB
S64(E)	STR.	2	#6	112	5									BOTTOM OF SLAB
S65(E)	STR.	2	#6	114	12									BOTTOM OF SLAB
S66(E)	STR.	1268	#6	40	0									TOP OF SLAB
S67(E)	STR.	1268	#6	26	0									TOP OF SLAB
S68(E)	STR.	933	#6	40	0									BOTTOM OF SLAB
S69(E)	STR.	933	#6	26	0									BOTTOM OF SLAB
S70(E)	STR.	13	#5	5	10									BARRIERS
S71(E)	STR.	12	#5	4	8									BARRIERS
S72(E)	STR.	1440	#5	40	0									SLAB & BARRIER
S73(E)	STR.	72	#5	11	0									SLAB & BARRIER
S74(E)	STR.	960	#6	40	0									BOTTOM OF SLAB
S75(E)	STR.	48	#6	11	0									BOTTOM OF SLAB
S76(E)	STR.	8	#6	40	0									END OF SLAB
S77(E)	STR.	8	#6	33	3									END OF SLAB
S78(E)	STR.	30	#6	10	0									SLAB ACUTE CORNERS
S79(E)	STR.	126	#8	60	0									TOP OF SLAB
S80(E)	STR.	252	#8	37	6									TOP OF SLAB
S81(E)	STR.	504	#8	35	0									TOP OF SLAB
S82(E)	STR.	64	#5	28	8									TOP OF BARRIER
S83(E)	STR.	96	#5	40	8									TOP OF BARRIER


BILL OF REINFORCEMENT														
MARK	TYPE	NO.	SIZE	LENGTH		A		B		C		D		LOCATION
				FT.	IN.	FT.	IN.	FT.	IN.	FT.	IN.	FT.	IN.	
D1(E)	STR.	350	#5	8	11									ABUT. & PIER DIA.
D2(E)	(2)	28	#5	13	0									ABUTMENT DIA.
D3(E)	(2)	20	#5	14	10									ABUTMENT DIA.
D4(E)	(2)	48	#5	16	10									ABUTMENT DIA.
D5(E)	STR.	240	#5	7	0									ABUT. & PIER DIA.
D6(E)	STR.	24	#5	32	2									ABUTMENT DIA.
D7(E)	(24)	8	#5	4	6									ABUTMENT DIA.
D8(E)	STR.	40	#5	6	9									PIER DIA.
D9(E)	(6)	28	#5	5	3									ABUTMENT DIA.
D10(E)	(3)	4	#5	18	9									ABUTMENT DIA.
D11(E)	(4)	275	#5	11	8									MID-SPAN DIA.
D12(E)	STR.	300	#5	10	3									MID-SPAN DIA.
D13(E)	(2)	40	#5	15	10									PIER DIA.
D14(E)	(2)	120	#5	19	2									PIER DIA.
D15(E)	(2)	40	#5	14	0									ABUTMENT DIA.
D16(E)	STR.	20	#4	5	8									MID-SPAN DIA.
D17(E)	(2)	2	#5	22	9									ABUTMENT DIA.
D18(E)	STR.	24	#9	4	0									PIER DIA.
D19(E)	(2)	16	#5	13	10									ABUTMENT DIA.

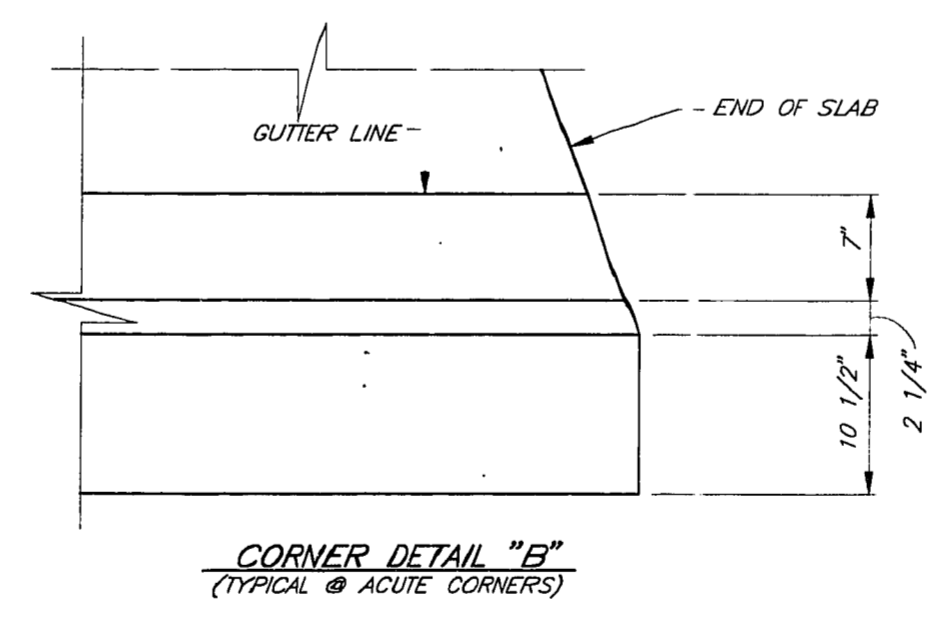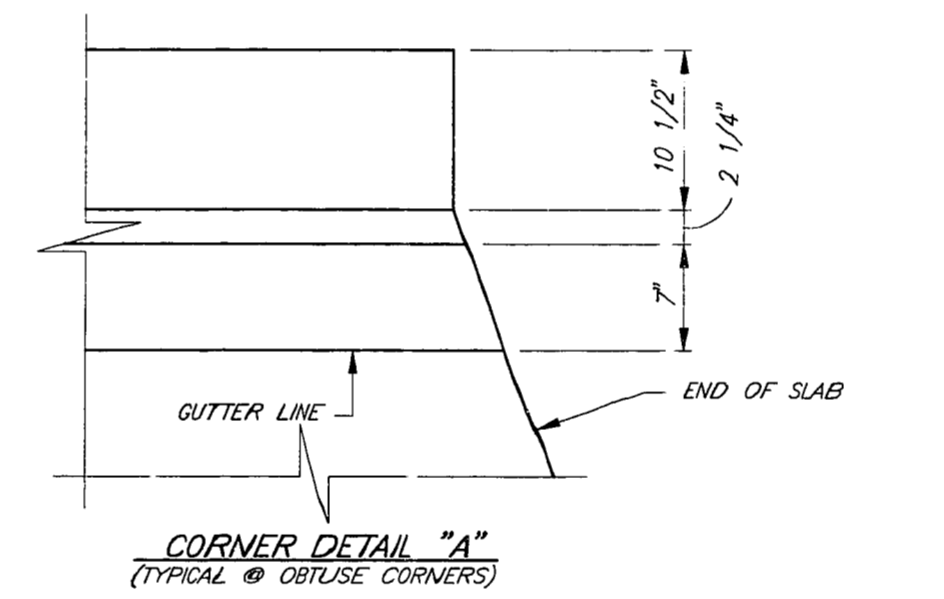



UPDATE DATE  
LETTING DATE

DESIGNED BY: \_\_\_\_\_ DATE: \_\_\_\_\_  
 CHECKED BY: \_\_\_\_\_ DATE: \_\_\_\_\_  
 REVISIONS: \_\_\_\_\_ DATE: \_\_\_\_\_  
 PREPARED BY: \_\_\_\_\_ DATE: \_\_\_\_\_






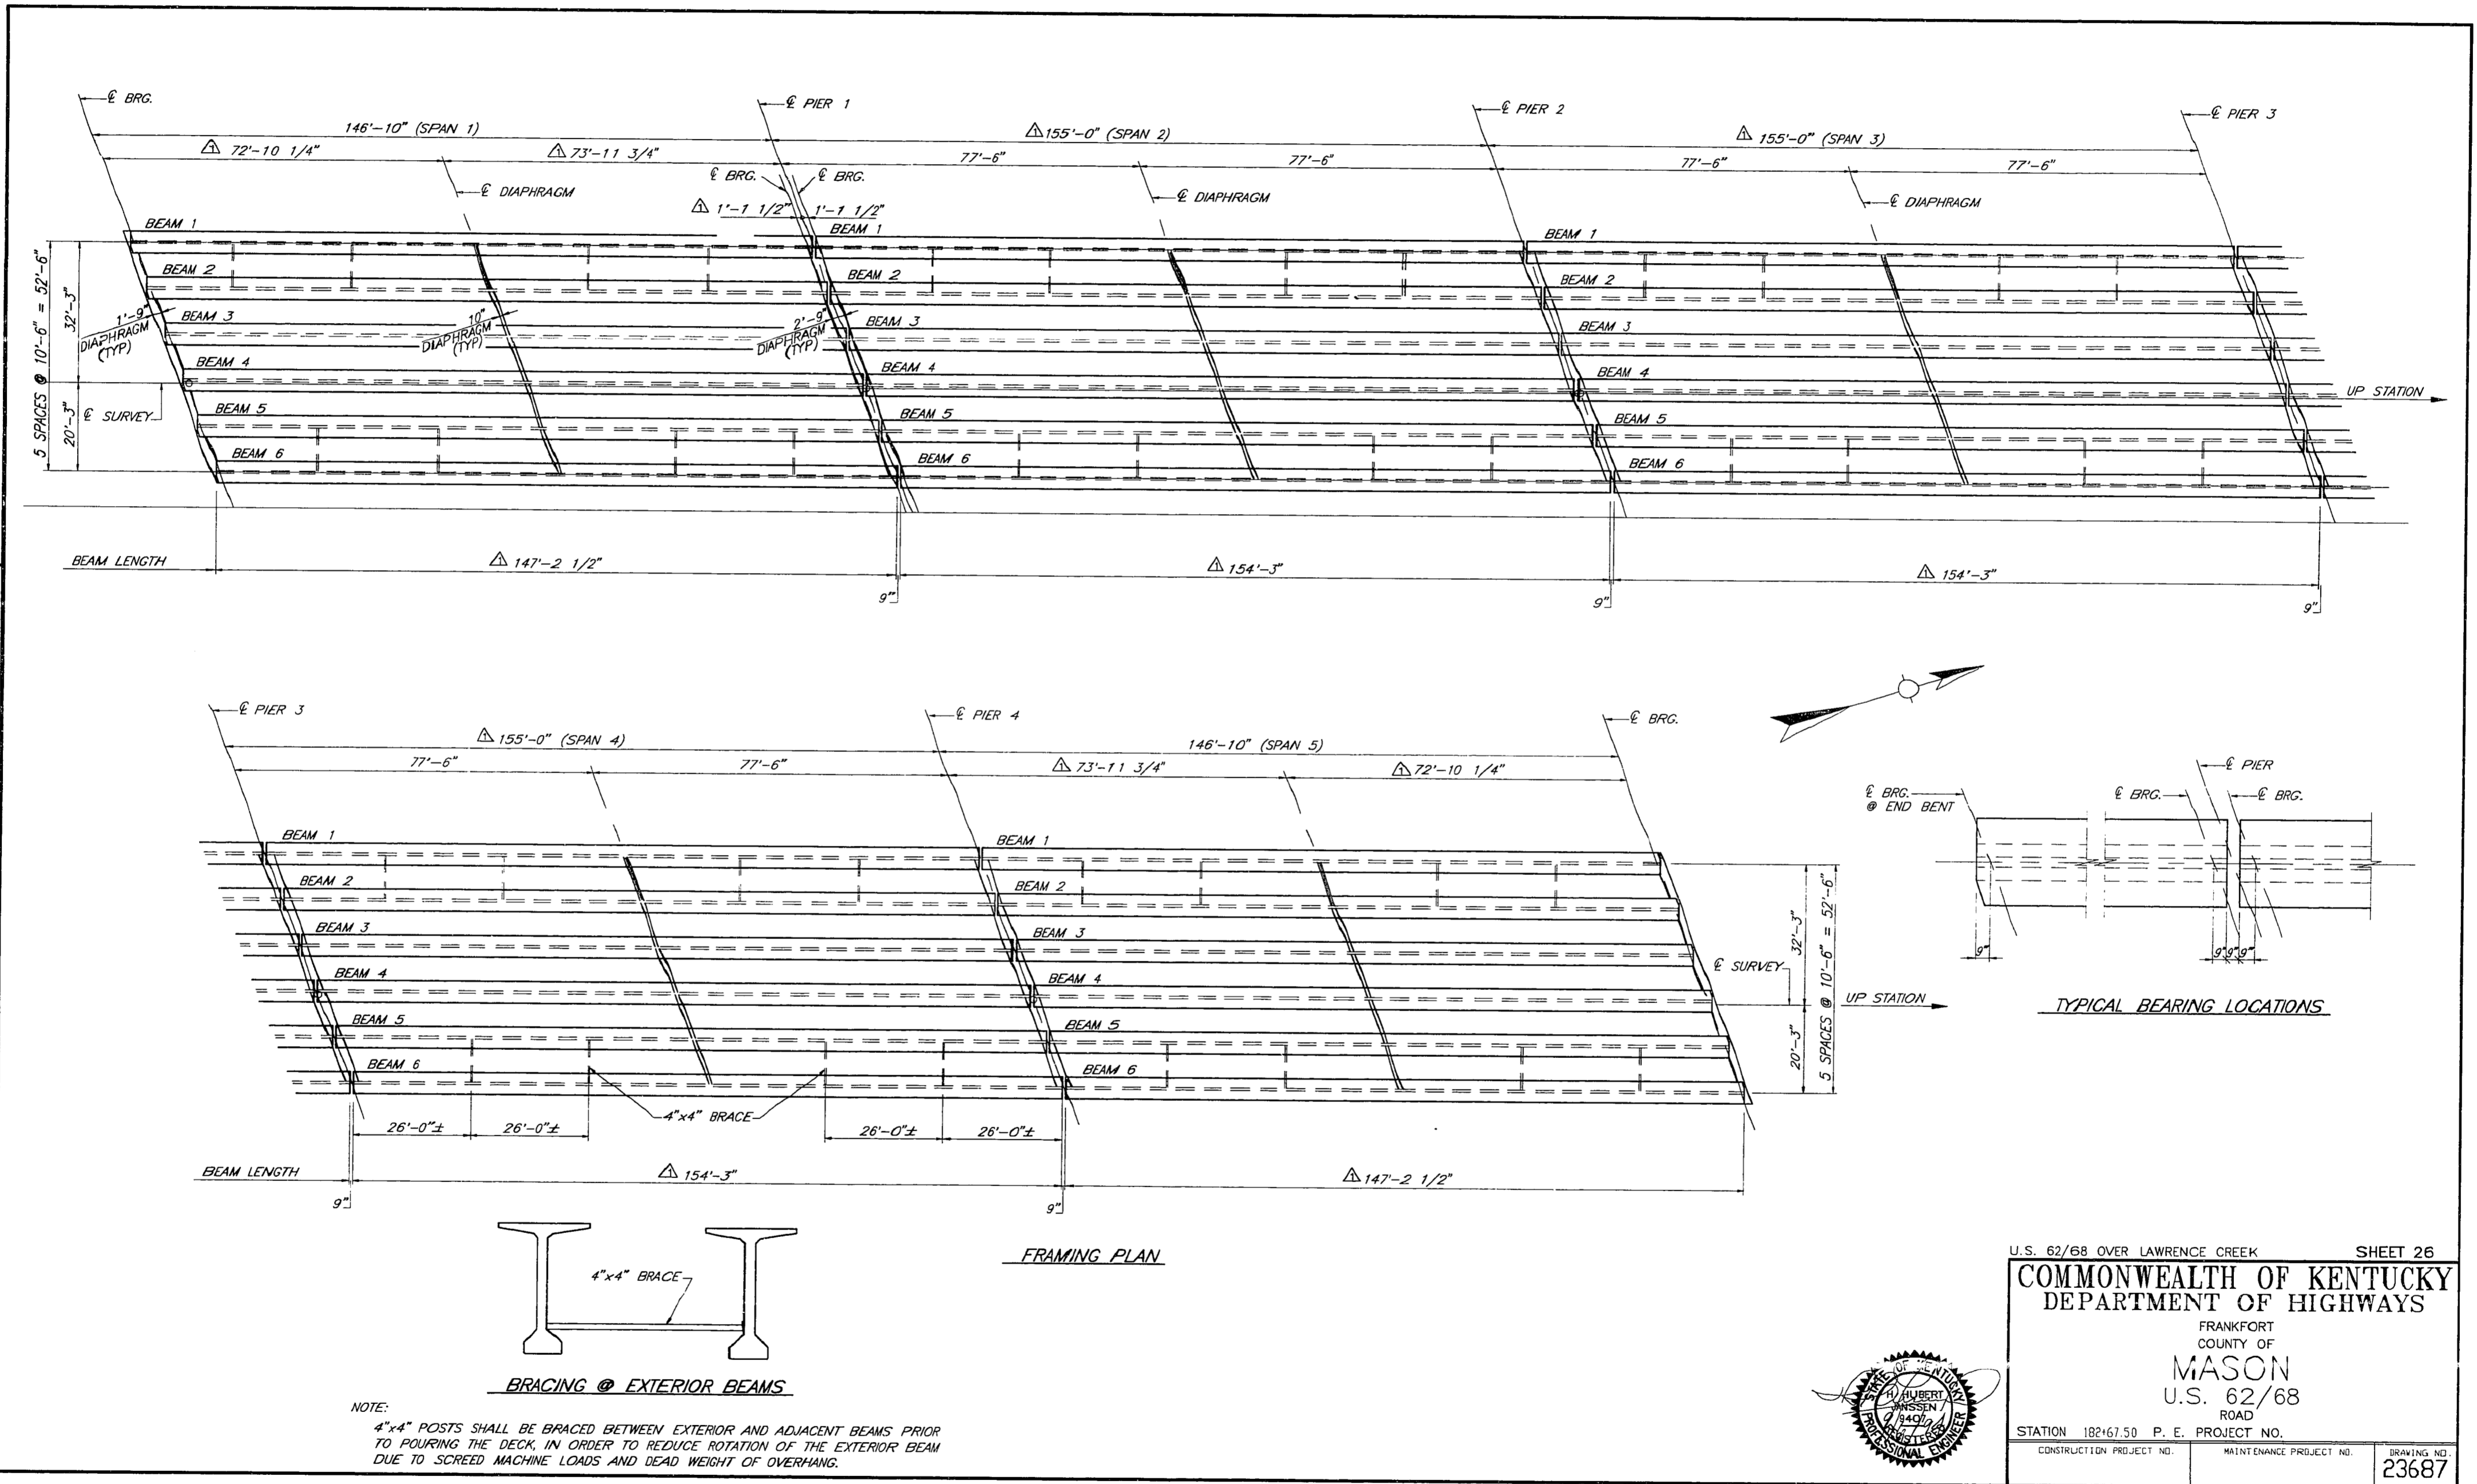


NOTE:  
 4"x4" POSTS SHALL BE BRACED BETWEEN EXTERIOR AND ADJACENT BEAMS PRIOR TO POURING THE DECK, IN ORDER TO REDUCE ROTATION OF THE EXTERIOR BEAM DUE TO SCREED MACHINE LOADS AND DEAD WEIGHT OF OVERHANG.

U.S. 62/68 OVER LAWRENCE CREEK SHEET 26  
**COMMONWEALTH OF KENTUCKY**  
 DEPARTMENT OF HIGHWAYS  
 FRANKFORT  
 COUNTY OF  
**MASON**  
 U.S. 62/68  
 ROAD  
 STATION 182+67.50 P. E. PROJECT NO.  
 CONSTRUCTION PROJECT NO. MAINTENANCE PROJECT NO.  
 DRAWING NO. 23687

UPDATE DATE  
LETTING DATE

DESIGNED BY: L.E. HESSUP  
CHECKED BY: R.E. HILLER  
REVISIONS BY: L.E. HESSUP  
DATE: 6-7-74  
DATE: 5-24-74  
DATE: 2-21-74

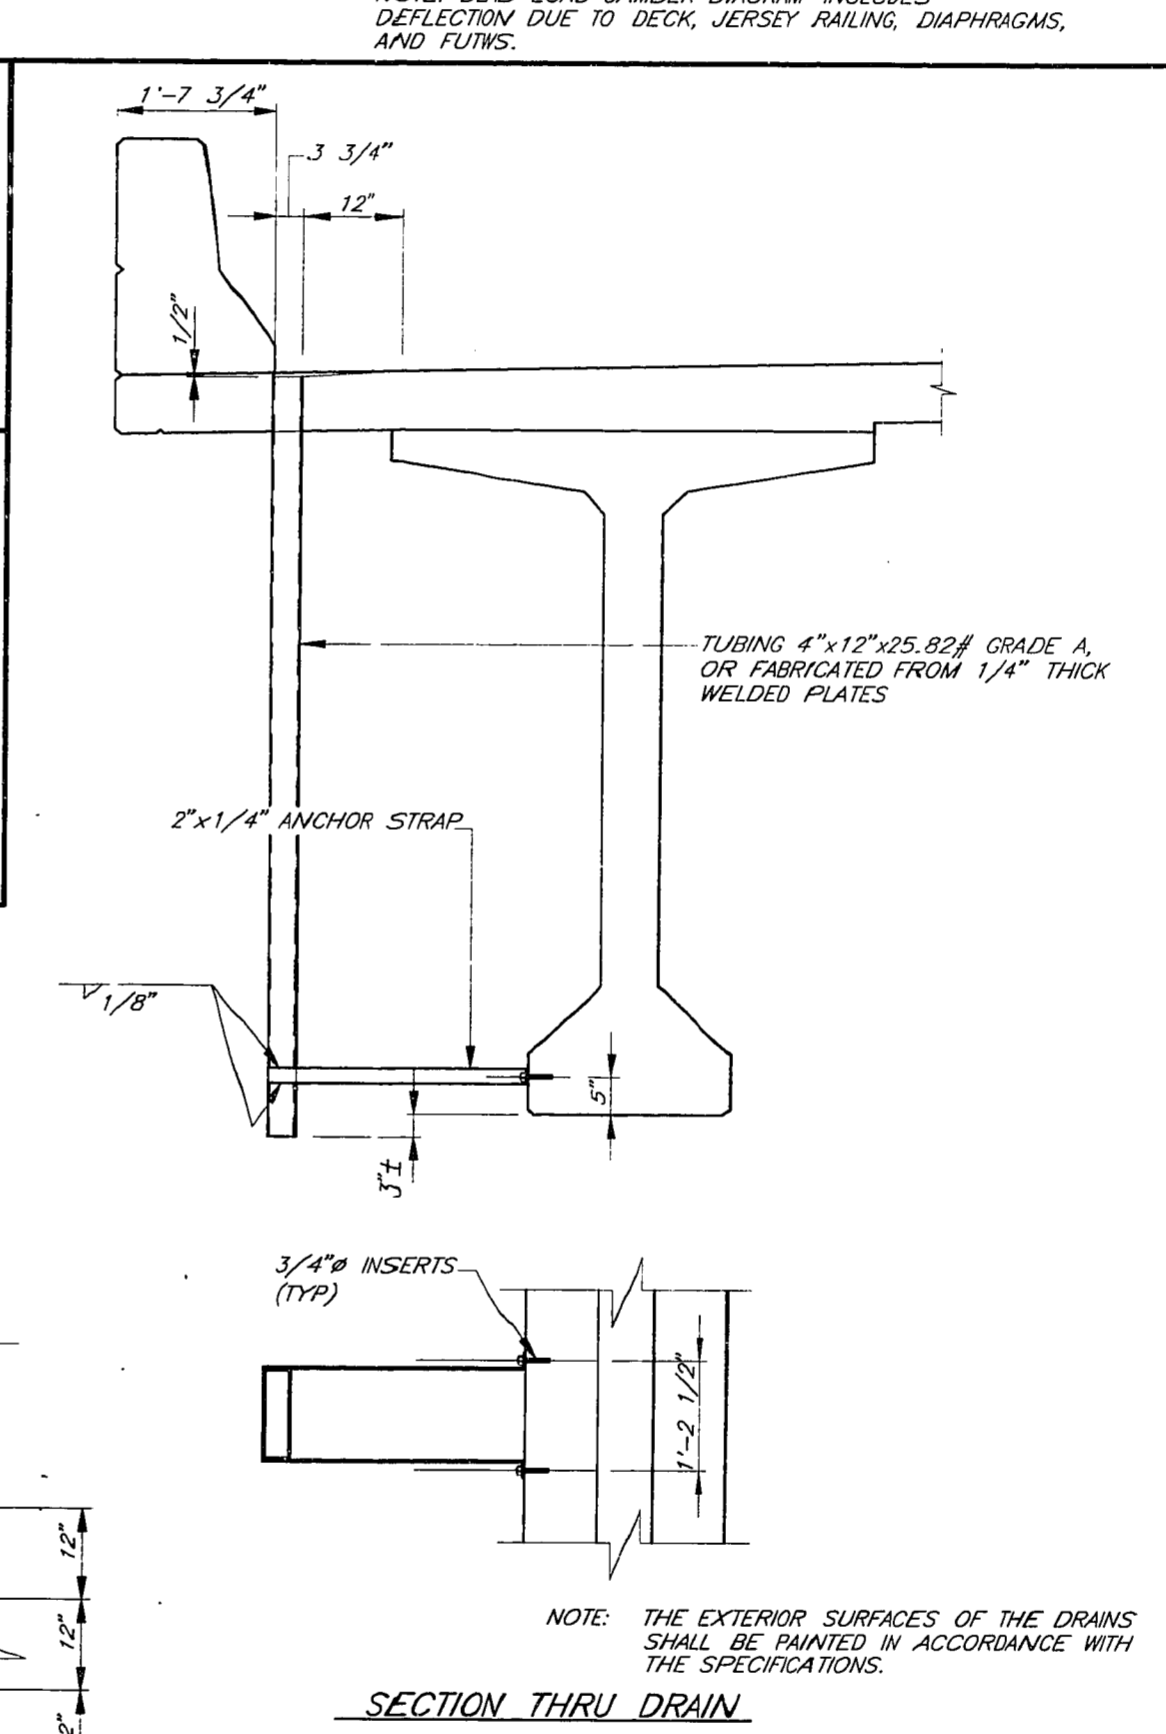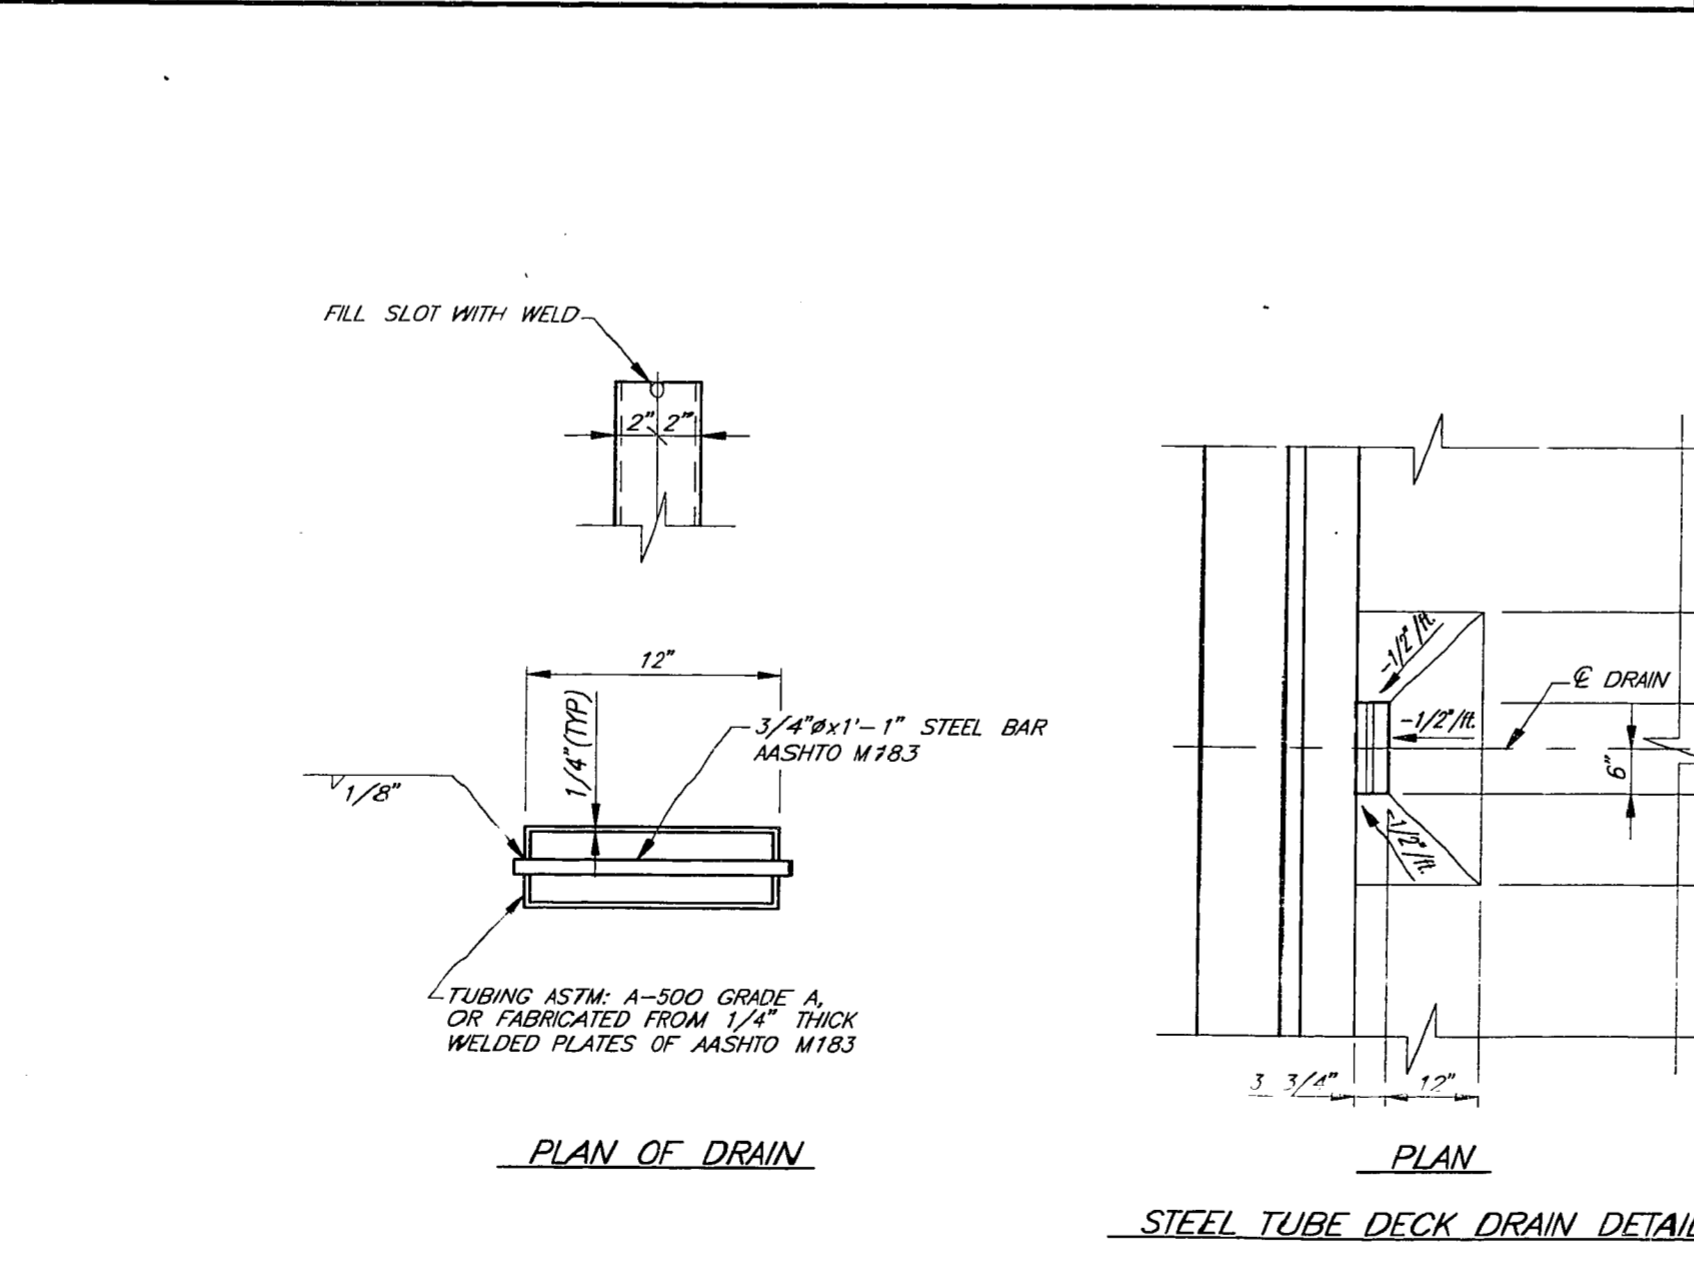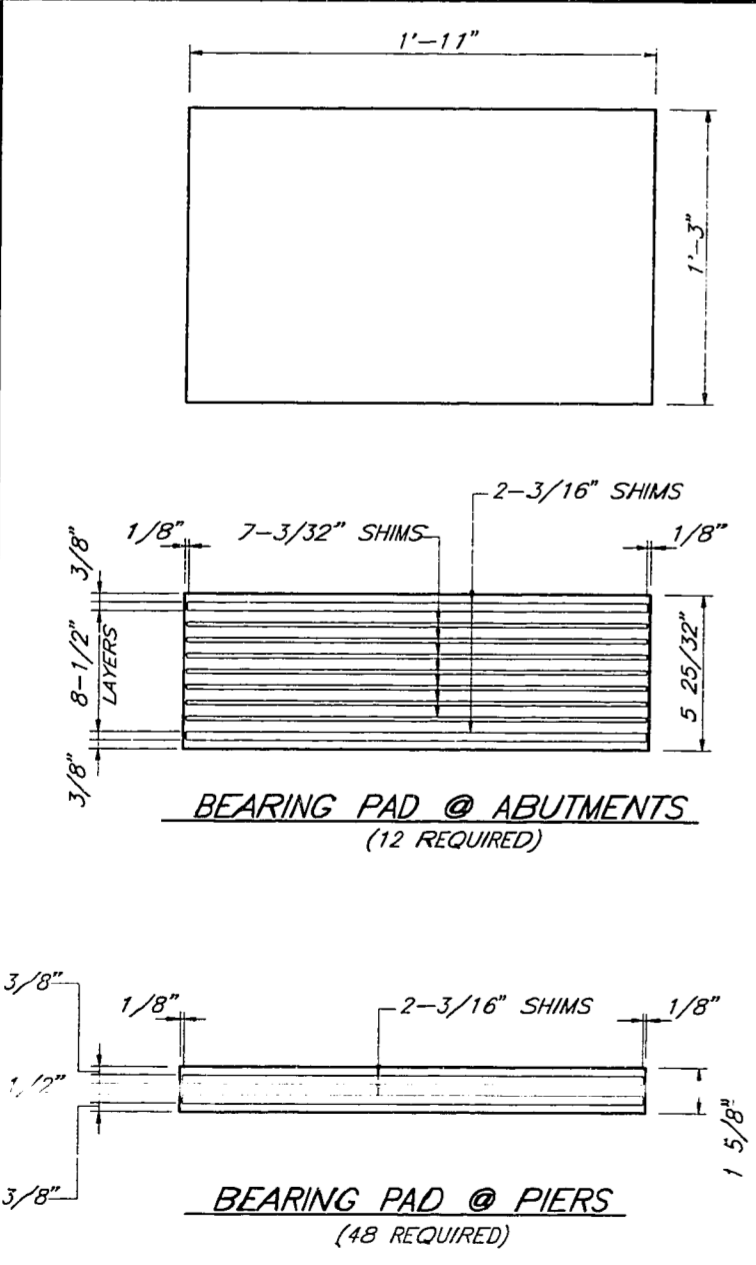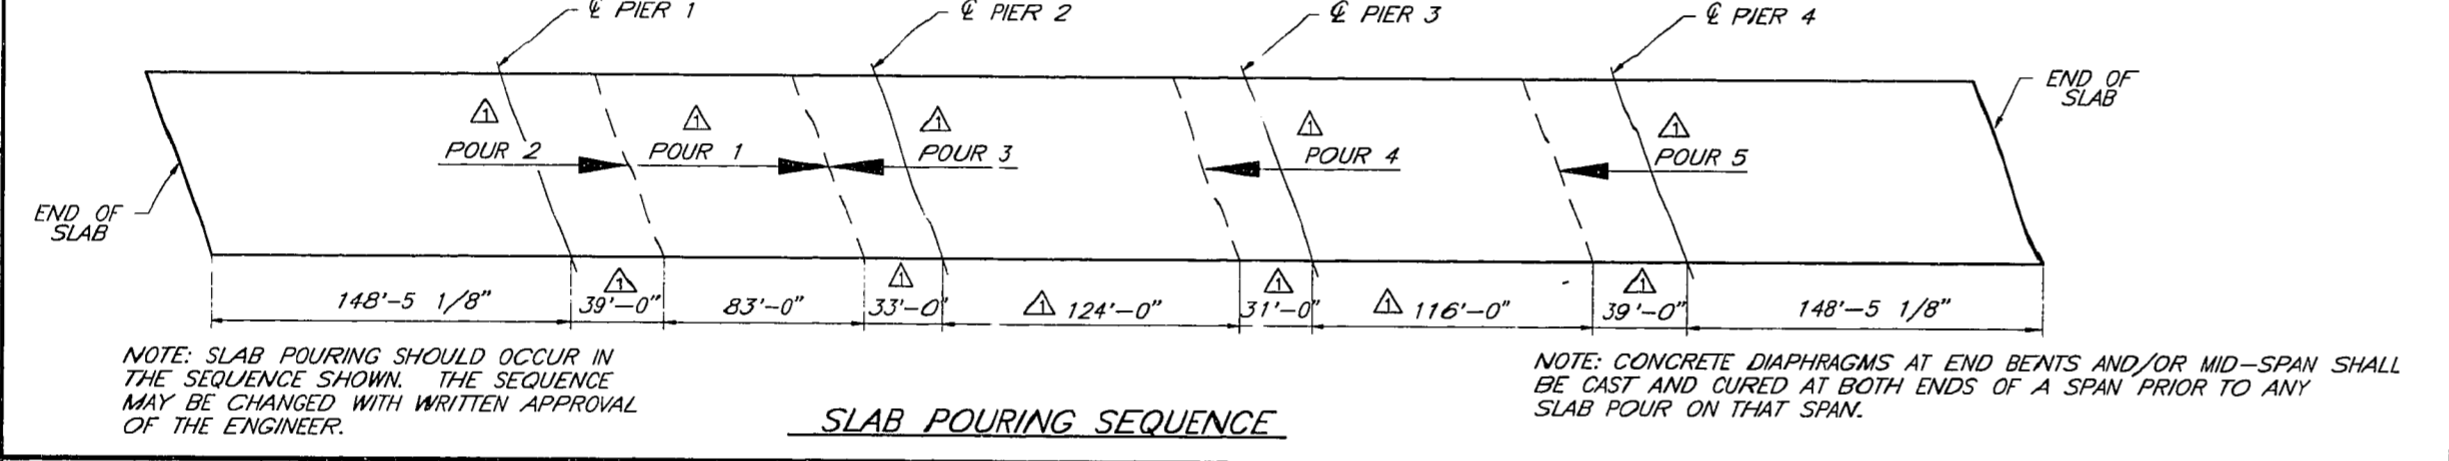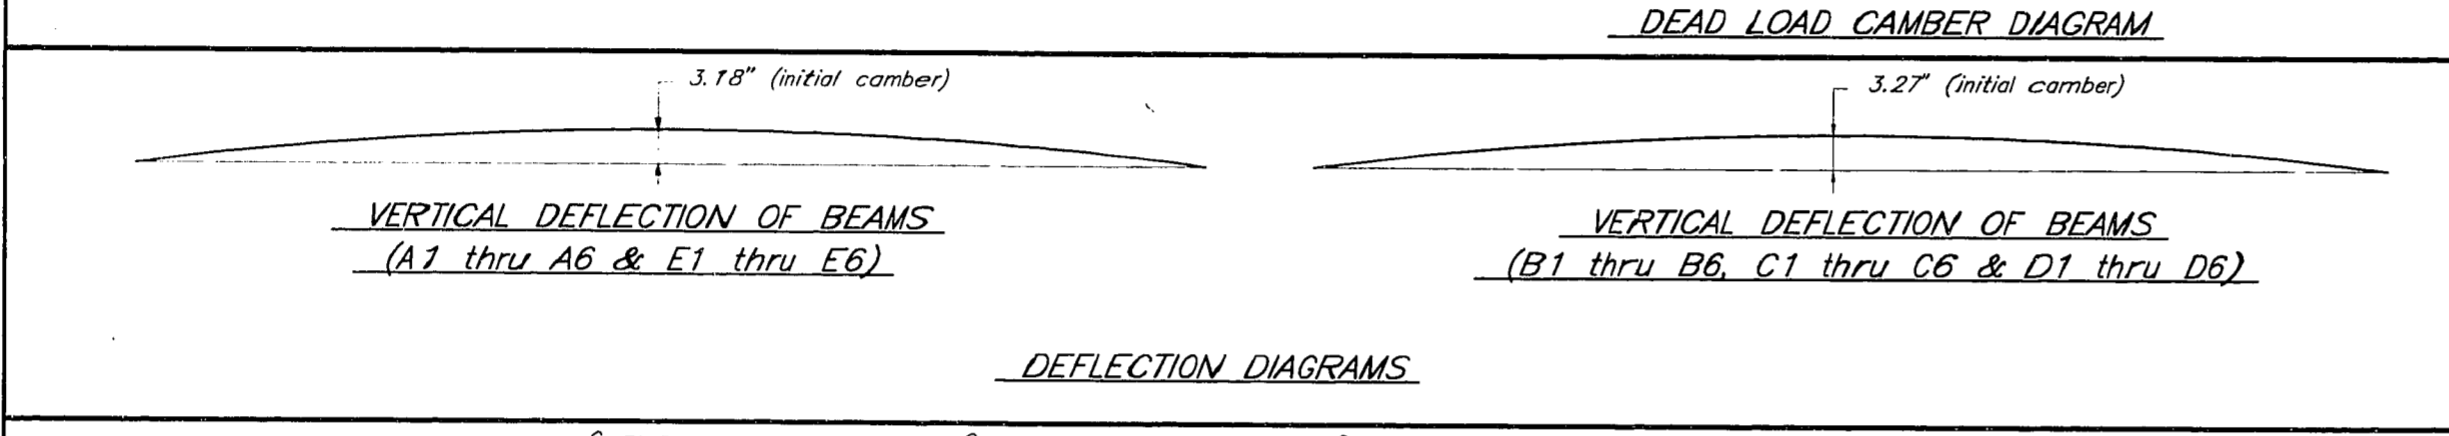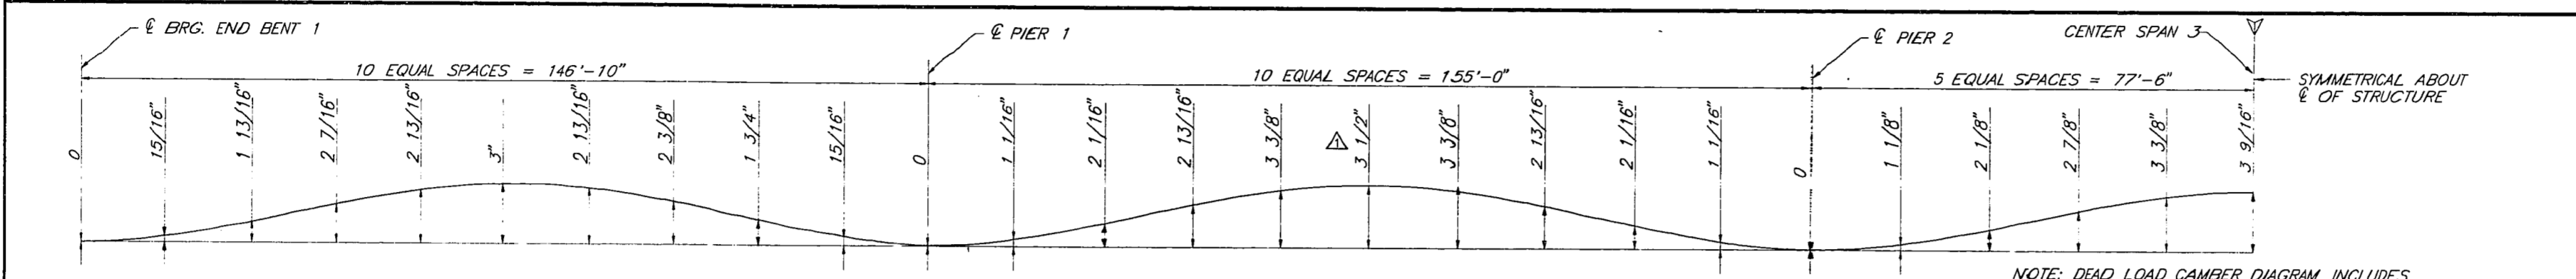

BILL OF REINFORCEMENT


VALID FOR 14'-3 1/2" BEAMS

MARK	SIZE	NUMBER	LENGTH		WEIGHT
			Ft.	In.	
W1(E)	#4	154	17	1	1757
W2(E)	#4	130	6	7 1/2	575
W3	#4	46	15	1	463
W4	#4	28	6	3 3/4	118
W5	#4	28	2	9 1/2	53
W6	#6	4	25	0	150
TOTAL					3116

VALID FOR 15'-4" BEAMS

MARK	SIZE	NUMBER	LENGTH		WEIGHT
			Ft.	In.	
W1(E)	#4	161	17	1	1837
W2(E)	#4	137	6	7 1/2	606
W3	#4	46	15	1	463
W4	#4	28	6	3 3/4	118
W5	#4	28	2	9 1/2	53
W6	#6	4	25	0	150
TOTAL					3227

BAR SHAPES

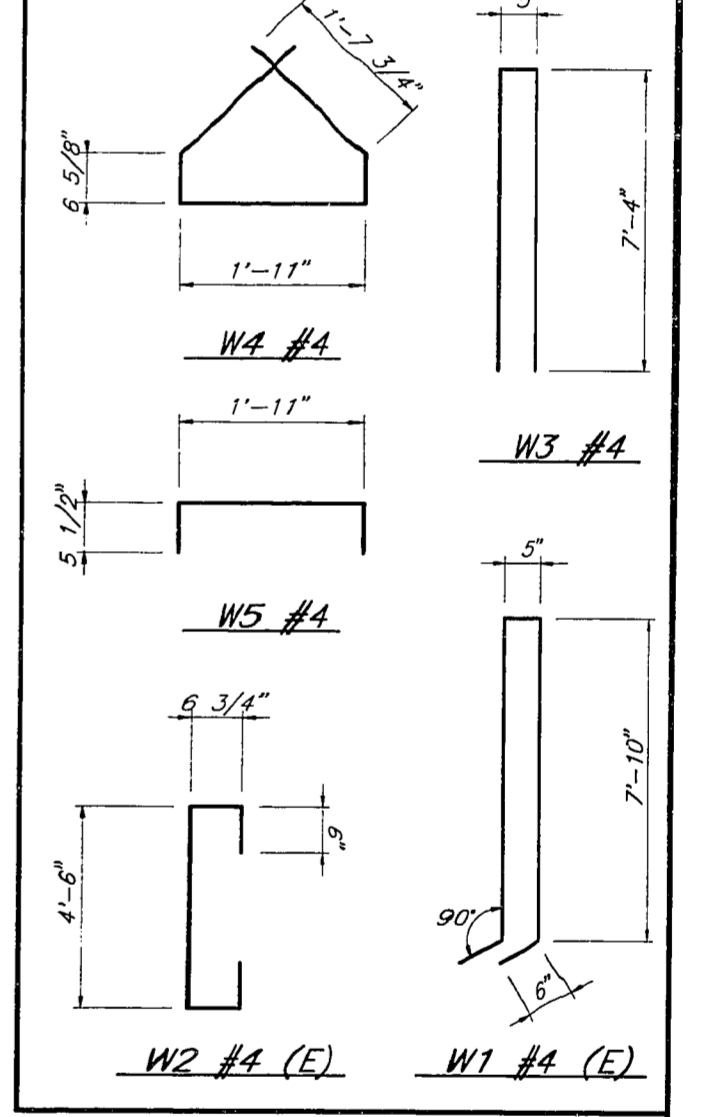

U.S. 62/68 OVER LAWRENCE CREEK SHEET 27

COMMONWEALTH OF KENTUCKY  
DEPARTMENT OF HIGHWAYS

FRANKFORT  
COUNTY OF  
MASON  
U.S. 62/68  
ROAD

STATION 182+67.50 P. E. PROJECT NO. 23687

CONSTRUCTION PROJECT NO. MAINTENANCE PROJECT NO. DRAWING NO. 23687












UPDATE DATE  
LETTING DATE

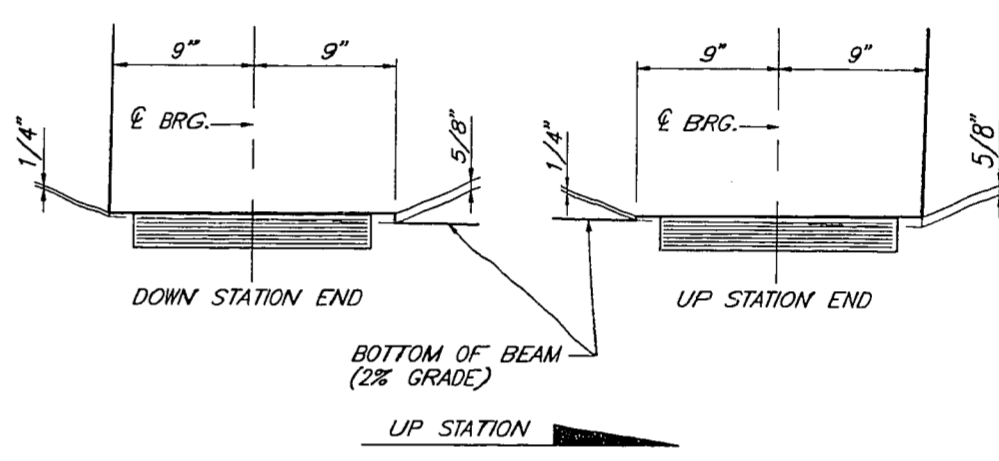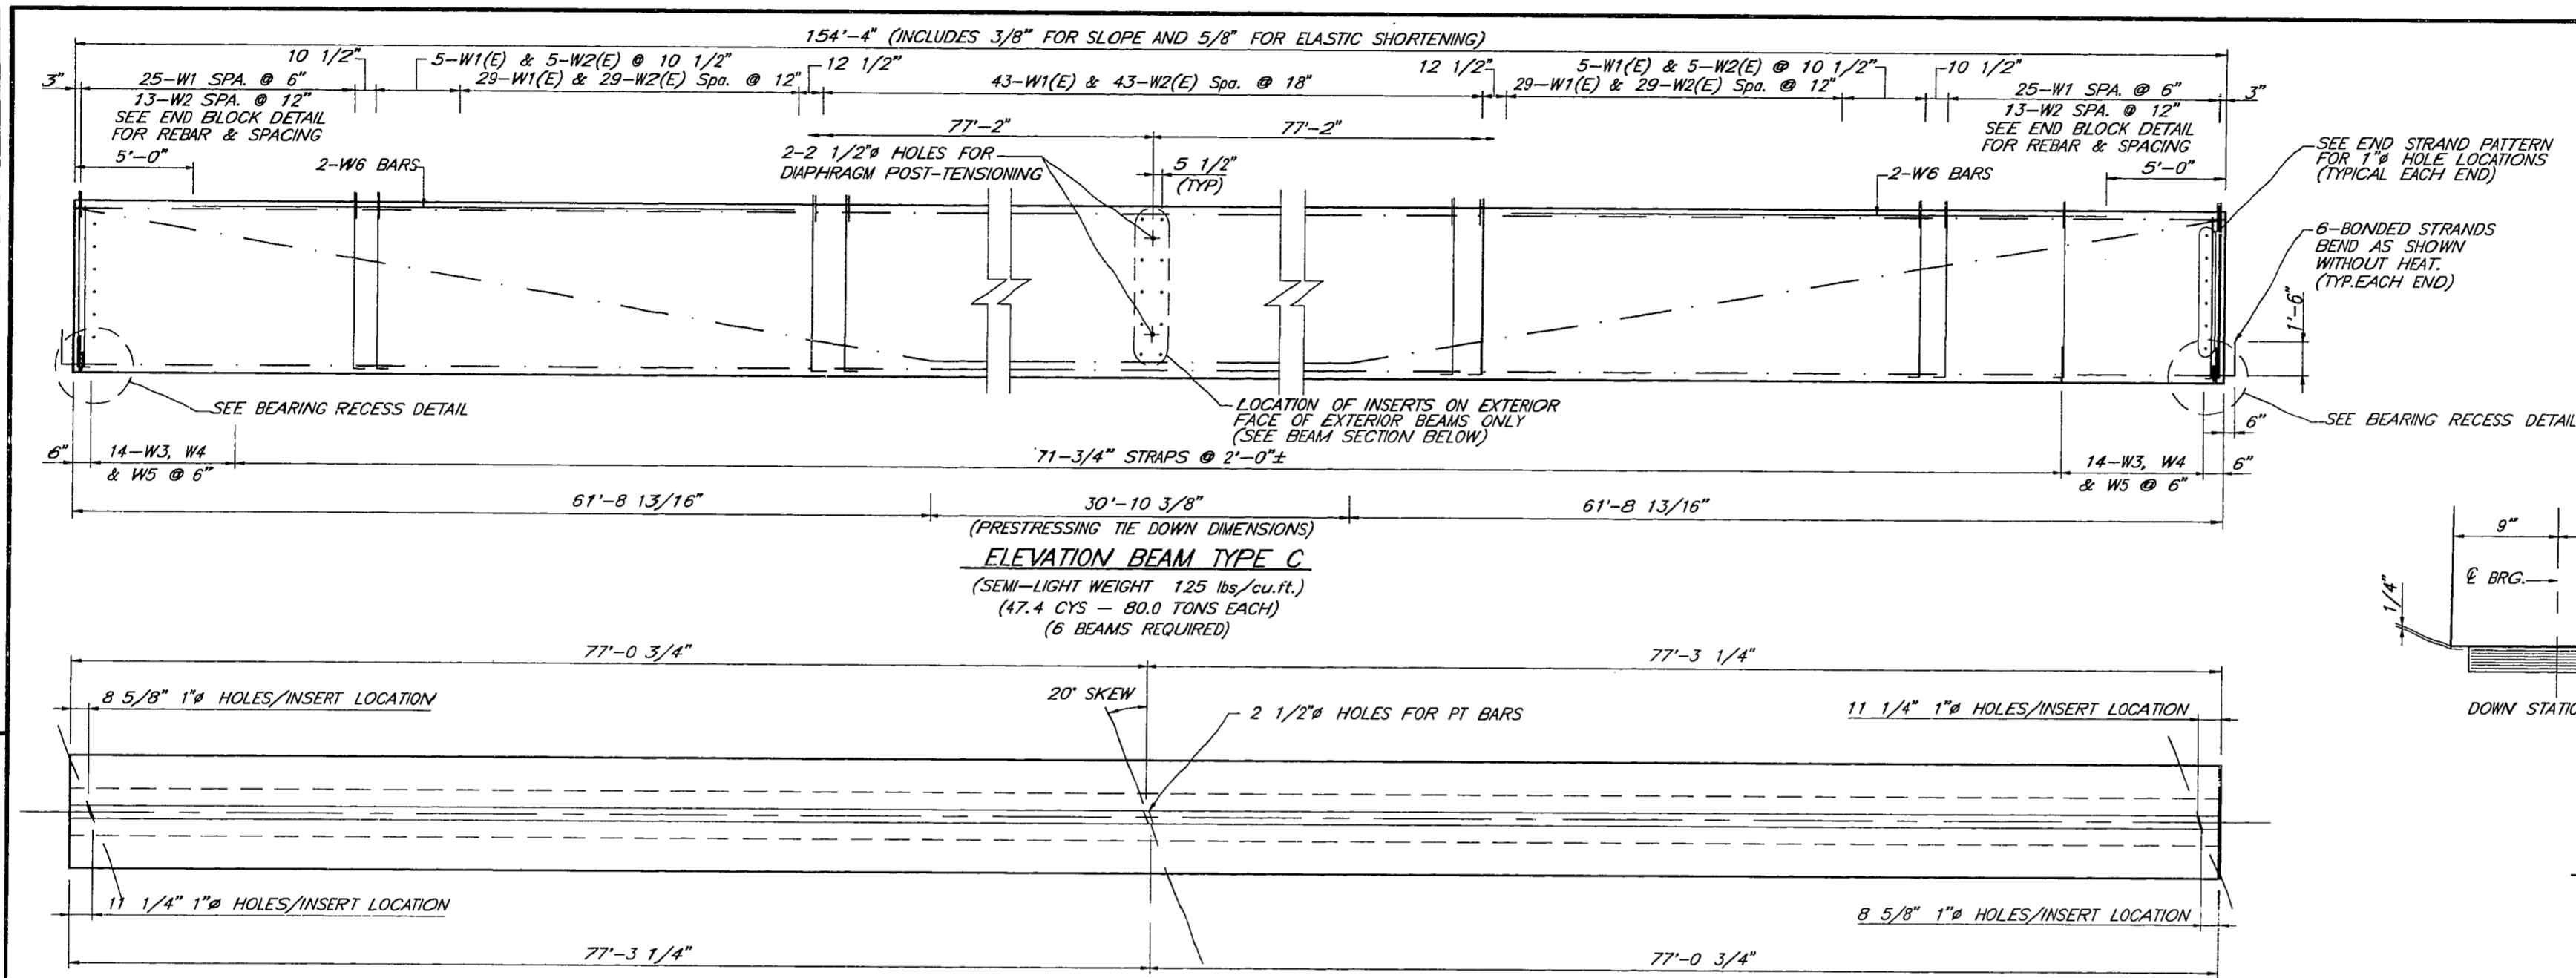


BEARING RECESS DETAILS

DESIGNED BY L.D. ESEIP... CHECKED BY L. SPANNS... DATE 6-5-84...  
 REVISIONS: NEW SHEET ADDED...  
 DATE 6-5-84...  
 CHECKED BY T.B. JESSE... DATE 6-5-84...  
 SECTION CHECKED BY... DATE...  
 DRAWING NO. 23687


PLAN  
(DIAPHRAGM INSERTS TO BE ON INTERIOR FACE OF EXTERIOR BEAMS)

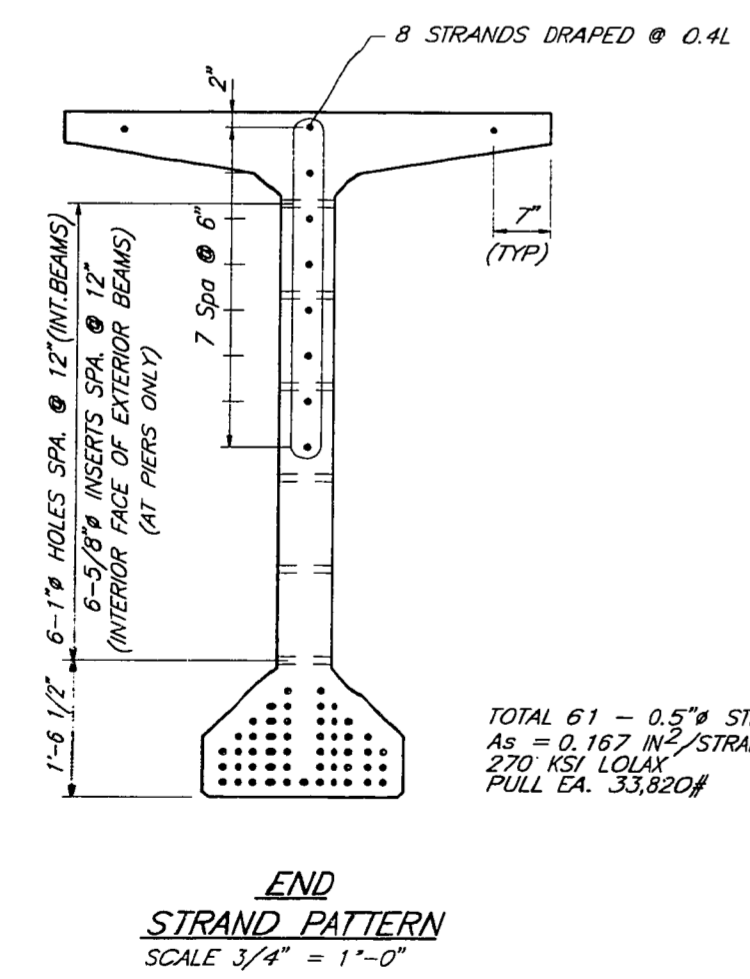


END STRAND PATTERN  
SCALE 3/4" = 1'-0"

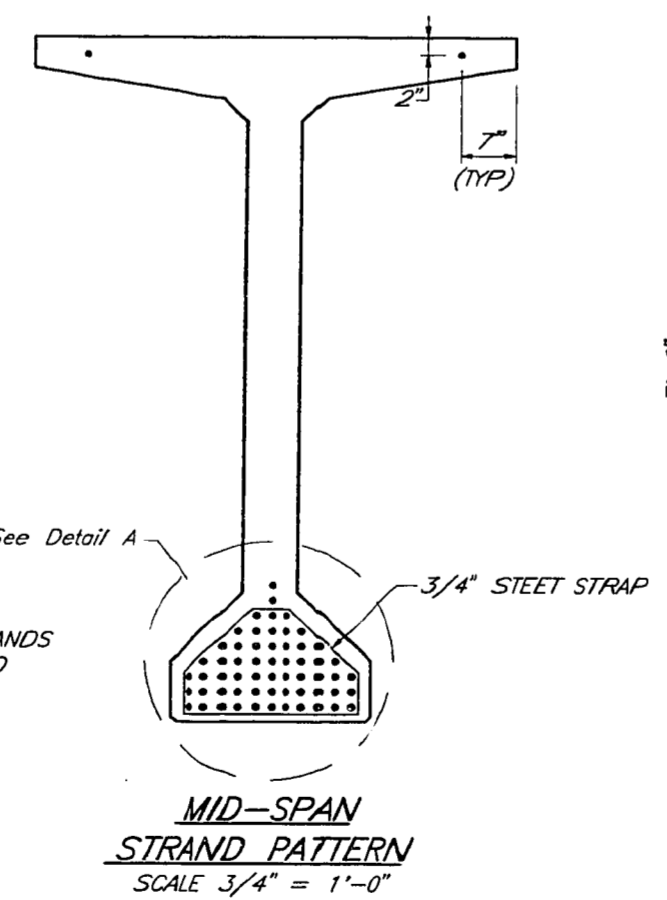


MID-SPAN STRAND PATTERN  
SCALE 3/4" = 1'-0"

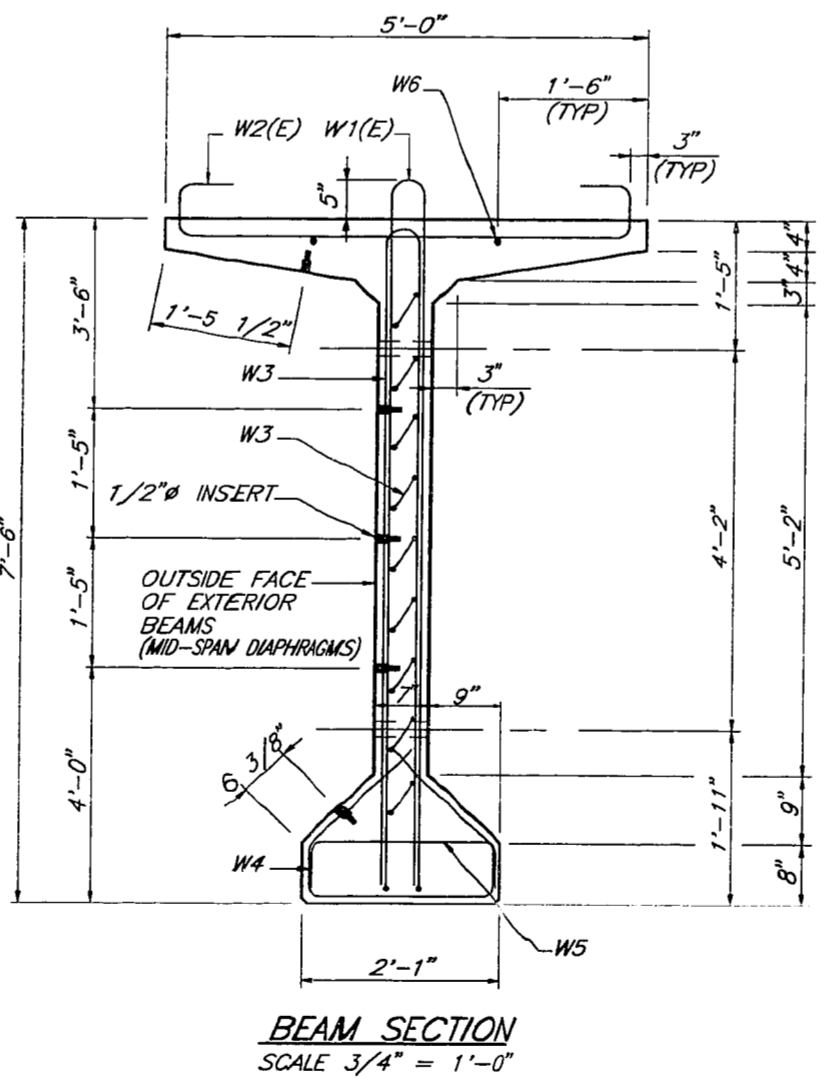

BEAM SECTION  
SCALE 3/4" = 1'-0"

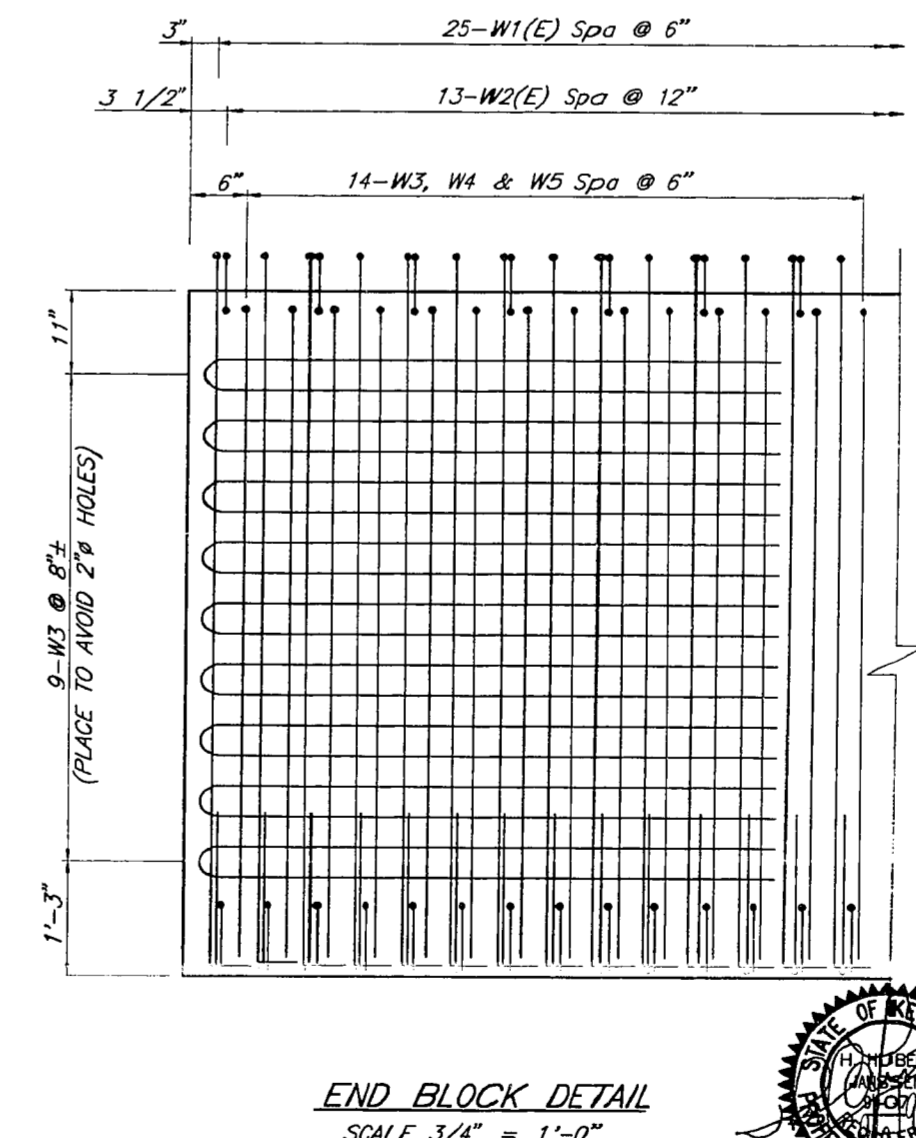


END BLOCK DETAIL  
SCALE 3/4" = 1'-0"

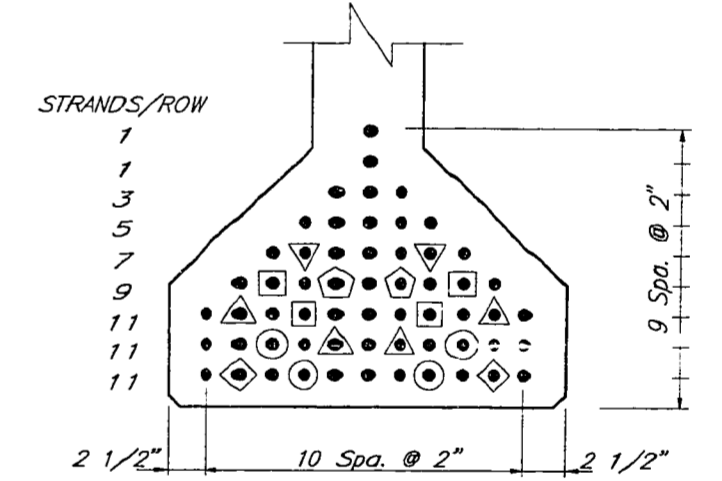

DETAIL "A"  
SCALE 1 1/2" = 1'-0"

- ▽ - INDICATES STRANDS DEBONDED 5.0'
- ◊ - INDICATES STRANDS DEBONDED 10.0'
- ◻ - INDICATES STRANDS DEBONDED 15.0'
- ◼ - INDICATES STRANDS DEBONDED 20.0'
- ◾ - INDICATES STRANDS DEBONDED 25.0'
- ◿ - INDICATES STRANDS DEBONDED 30.0'

BEAMS VALID FOR SPAN 3  
 U.S. 62/68 OVER LAWRENCE CREEK SHEET 29A  
**COMMONWEALTH OF KENTUCKY**  
**DEPARTMENT OF HIGHWAYS**  
 FRANKFORT COUNTY OF  
**MASON**  
 U.S. 62/68  
 ROAD  
 STATION 182+67.50 P. E. PROJECT NO.  
 CONSTRUCTION PROJECT NO. MAINTENANCE PROJECT NO.  
 DRAWING NO. 23687

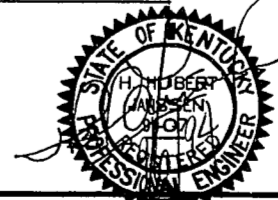

07/12/69  
 DESIGNED BY L.E. SEEP - CHECKED BY L. SPANNS - DATE 8-19-68  
 REVISIONS: REVISION 1, DATE 8-19-68; REVISION 2, DATE 9-28-68  
 DETAILED BY S.E. TEELE - CHECKED BY T.D. ASSEP - DATE 8-17-68  
 APPROVED BY GRAPHIC SECTION CHECKED BY DATE

CONCRETE

△ CONCRETE FOR PRECAST BEAMS SHALL BE CLASS "SL", A SEMI-LIGHTWEIGHT MIX WITH A UNIT WEIGHT OF 125 LBS/CUBIC FEET. SEE SPECIAL PROVISIONS FOR CONCRETE MIX REQUIREMENTS.

MATERIALS DESIGN SPECIFICATIONS

△ FC = 7000 PSI  
 FS = 270000 PSI

PRESTRESSING REINFORCEMENT

ALL PRESTRESSING STRANDS SHALL BE 1/2 INCH UNCOATED, SEVEN WIRE LOW RELAXATION 270 KSI SPECIAL (ASTM)A116-80 (0.5 INCH NOMINAL DIAMETER 0.167 SQ INCH AREA WITH A G.U.T.S. OF 45000 LBS PER STRAND)-M20.3. SPACING TO BE 2 INCHES VERTICALLY AND HORIZONTALLY.

△ COST OF THE PRESTRESSING STRAND IS INCLUDED IN THE COST OF THE PRESTRESSED BEAM.

TENSIONING METHOD

BEAMS SHALL BE PRETENSIONED.

ELASTOMERIC BEARING PADS.

THE MATERIAL SPECIFICATIONS FOR ELASTOMERIC BEARING PADS SHALL CONFORM TO THE AASHTO STANDARD SPECIFICATIONS FOR HIGHWAY BRIDGES EXCEPT THAT THE REQUIREMENT OF THE LOW TEMPERATURE TEST IS WAIVED AND A DUROMETER HARDNESS OF ~~50~~ 60 IS REQUIRED. THE COST OF THIS ITEM IS TO BE INCLUDED IN THE PRICE PER LINEAR FOOT FOR PRECAST BEAMS.

CONSTRUCTION METHOD (PRECAST BEAMS)

NO BOND STRESS SHALL BE TRANSFERRED TO THE CONCRETE, NOR SHALL END ANCHORS BE RELEASED, UNTIL THE CONCRETE HAS ATTAINED A COMPRESSIVE STRENGTH AS SHOWN BY STANDARD CYLINDERS MADE AND CURED IDENTICALLY WITH THE BEAMS, OF AT LEAST A MINIMUM STRENGTH OF 5000 PSI. CYLINDER STRENGTH SHALL BE 7000 PSI AT OR PRIOR TO 28 DAYS. AN INITIAL FORCE SHALL BE APPLIED TO EACH LOW RELAXATION STRAND SUCH AS TO DEVELOP A STRESS OF 202,500 PSI. BEAMS WITH HONEYCOMB OF SUCH EXTENT AS TO AFFECT THE STRENGTH OR RESISTANCE TO DETERIORATION WILL NOT BE ACCEPTED. AN ALLOWANCE OF 1" SHALL BE MADE FOR SHORTENING OF BEAMS DUE TO SHRINKAGE AND ELASTIC CHANGE.

SHOP DRAWINGS AND CALCULATIONS MUST BE SUBMITTED BY THE MANUFACTURER THROUGH THE CONTRACTOR. THESE ARE TO INCLUDE THE DESTRESSING ORDER (SEE SPECIAL PROVISIONS FOR ADDITIONAL ITEMS).

DEFORMED WIRE FABRIC

DEFORMED WIRE FABRIC MAY BE USED IN THE PRECAST BEAMS IN LIEU OF REINFORCING BARS, PROVIDED AN EQUIVALENT AREA OF STEEL IS FURNISHED. WIRE FABRIC SHALL CONFORM TO THE REQUIREMENTS OF AASHTO SPECIFICATION W221 (A497) AND IS TO BE MADE OF DEFORMED WIRE CONFORMING TO AASHTO SPECIFICATION W225 (A496).

PAYMENT FOR PRECAST CONCRETE BEAMS

THE BASIS OF PAYMENT FOR THE PRESTRESSED CONCRETE BEAMS SHALL BE AT THE CONTRACT UNIT PRICE PER LINEAR FOOT OF BEAM, IN ACCORDANCE WITH THE SPECIFICATIONS.

△ PAYMENT FOR POST-TENSIONING

THE COST OF ALL POST-TENSIONING HARDWARE (STRANDS, DUCTS, ANCHOR ASSEMBLIES, ETC.) AND POST-TENSIONING OPERATIONS (STRESSING, GROUTING, ETC.) SHALL BE INCLUDED IN THE COST OF ~~OTHER ITEMS~~ CLASS "AA" CONCRETE.

TESTING PRESTRESSED CONCRETE MEMBERS

IN ADDITION TO THE REQUIREMENTS OF SECTION 605 OF THE DEPARTMENT'S STANDARD SPECIFICATIONS, FABRICATORS OF PRESTRESSED CONCRETE MEMBERS SHALL FURNISH, AS PART OF THEIR QUALITY CONTROL EQUIPMENT, A PACHOMETER FOR DETERMINING THE DEPTH OF CONCRETE COVER OVER STEEL REINFORCEMENT. THE METER FURNISHED SHALL BE AN "R" METER AS MANUFACTURED BY JAMES ELECTRONICS, INC., CHICAGO, ILLINOIS, OR APPROVED EQUAL. THE PACHOMETER SHALL BE AVAILABLE FOR USE BY BOTH THE FABRICATOR'S QUALITY CONTROL PERSONNEL AND THE DEPARTMENT'S INSPECTOR(S).

NO SEPARATE PAYMENT WILL BE MADE FOR FURNISHING THE METER AS THIS IS CONSIDERED INCIDENTAL TO THE PRESTRESSED CONCRETE WORK.

GENERAL BEAM NOTES

BEAMS SHALL BE CAST A MINIMUM OF 28 DAYS BEFORE DECK IS POURED.

TOP OF BEAMS ARE TO BE SCORED TRANSVERSELY AT ABOUT 3 INCH CENTERS WITH POINTED TOOL (MAX DEPTH OF SCORING 1/4 INCH).

ALL REINFORCING IN PRECAST BEAMS SHALL BE GRADE 60.

SEVERAL LIFTING DEVICES ARE SATISFACTORY. THE TYPE USED MUST BE GUARANTEED BY THE BEAM MANUFACTURER AND APPROVED BY THE ENGINEER ON THE SHOP DRAWINGS. BEAMS ARE TO BE LIFTED AND SUPPORTED AT THE LOCATIONS AS SHOWN IN THE PLANS DURING HANDLING, STORAGE, AND TRANSPORTATION.


INITIAL PULL PER STRAND 33,820#.

DURING LIFTING, TRANSPORTATION, STORAGE, AND ERECTION, BEAMS SHALL BE MAINTAINED VERTICALLY AT ALL TIMES. FAILURE TO DO SO COULD RESULT IN SUDDEN FAILURE OF BEAMS.


ADEQUATE BRACING MUST BE PROVIDED AT ALL TIMES DURING STORAGE, TRANSPORTATION, AND ERECTION TO RESIST LATERAL LOADS.

A MINIMUM OF 2 BEAMS SHOULD BE ERECTED IN ANY GIVEN SPAN TO ALLOW FOR ADEQUATE BRACING OF THE BEAMS.

BEAMS HAVE BEEN DESIGNED FOR A MAXIMUM SUPER-ELEVATION OF 5%. THIS IS TO BE VERIFIED BY THE BEAM MANUFACTURER AND CONTRACTOR.

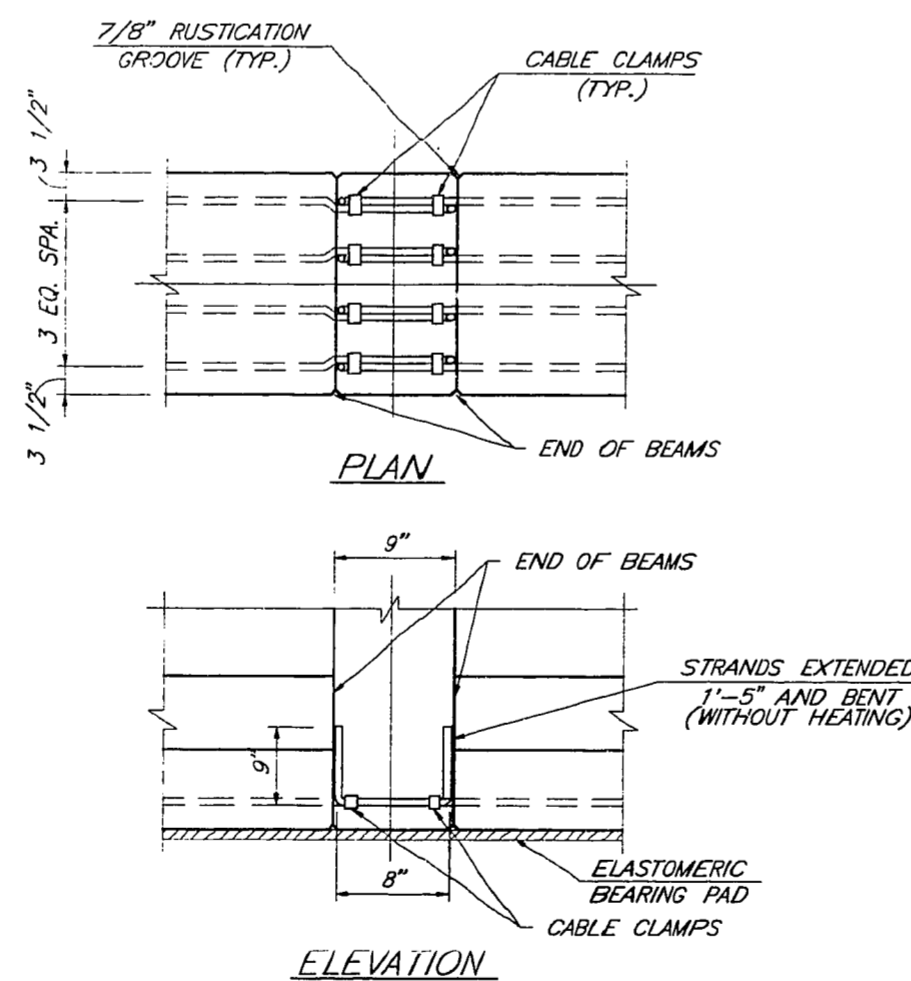

△ STRAND SPLICE DETAIL  
 BEAM ENDS AT PIERS

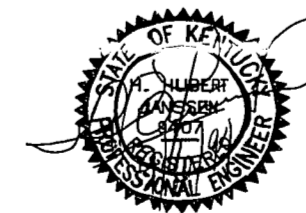

△ SHEET 30

U.S. 62/68 OVER LAWRENCE CREEK

**COMMONWEALTH OF KENTUCKY**  
**DEPARTMENT OF HIGHWAYS**

FRANKFORT  
 COUNTY OF  
**MASON**  
 U.S. 62/68  
 ROAD

STATION 182+67.50 P. E. PROJECT NO. \_\_\_\_\_  
 CONSTRUCTION PROJECT NO. \_\_\_\_\_ MAINTENANCE PROJECT NO. \_\_\_\_\_ DRAWING NO. 23687







F:\097\097K-3E2  
 DESIGNED BY: L.L. EISEL  
 CHECKED BY: R.A. EISEL  
 REVISED BY: M.A. EISEL  
 SECTION CHECKED BY: M.A. EISEL  
 U.S. SHAWNS - DATE 6-74  
 T.B. JESSUP - DATE 6-74  
 DATE DATE  
 DATE DATE  
 DATE DATE

LINE	LEFT GUTTER LINE	BEAM #1		BEAM #2		BEAM #3		BEAM #4		SURVEY	BEAM #5		BEAM #6		RIGHT GUTTER LINE
		CONSTR. ELEV.	TOP OF GIRDER	CONSTR. ELEV.	TOP OF GIRDER	CONSTR. ELEV.	TOP OF GIRDER	CONSTR. ELEV.	TOP OF GIRDER		CONSTR. ELEV.	TOP OF GIRDER	CONSTR. ELEV.	TOP OF GIRDER	
A-A	741.371	741.422		741.564		741.706		741.831		741.827	741.585	741.289	741.184		
B-B	741.339	741.390		741.532		741.674		741.799		741.796	741.553	741.258	741.152		
C-C	738.402	738.453		738.595		738.738		738.862		738.859	738.616	738.321	738.215		
D-D	735.302	735.353		735.495		735.638		735.762		735.759	735.516	735.221	735.115		
0-0	741.305	741.377		741.591											
1-1	741.185	741.260		741.458		741.656									
2-2	741.063	741.142		741.341		741.540		741.720		741.721	741.529				
3-3	740.938	741.021		741.222		741.422		741.603		741.604	741.413	741.174		741.088	
4-4	740.809	740.896		741.099		741.300		741.483		741.484	741.295	741.056		740.971	
5-5	740.676	740.766		740.971		741.175		741.360		741.361	741.173	740.937		740.852	
6-6	740.537	740.630		740.838		741.044		741.232		741.233	741.048	740.813		740.729	
7-7	740.393	740.487		740.698		740.908		741.099		741.100	740.917	740.685		740.602	
8-8	740.242	740.337		740.552		740.765		740.959		740.960	740.780	740.551		740.469	
9-9	740.084	740.181		740.399		740.615		740.812		740.814	740.637	740.411		740.330	
10-10	739.920	740.017		740.238		740.458		740.659		740.661	740.487	740.264		740.184	
11-11	739.750	739.846		740.071		740.294		740.498		740.500	740.329	740.110		740.032	
12-12	739.573	739.668		739.896		740.123		739.949		740.332	740.165	739.872		739.795	
13-13	739.391	739.485		739.715		739.945		740.155		740.158	739.993	739.781		739.705	
14-14	739.203	739.295		739.528		739.761		739.974		739.977	739.815	739.606		739.531	
15-15	739.011	739.101		739.336		739.571		739.787		739.790	739.631	739.424		739.350	
16-16	738.815	738.903		739.140		739.377		739.595		739.598	739.441	739.237		739.164	
17-17	738.617	738.703		738.947		739.179		739.399		739.402	739.246	739.045		738.973	
18-18	738.417	738.502		738.740		738.979		739.199		739.203	739.049	738.848		738.777	
19-19	738.297	738.368		738.564		738.778		738.998		739.002	738.848	738.649		738.578	
20-20	738.183	738.254		738.457		738.647		738.826		738.826	738.647	738.448		738.377	
21-21	738.066	738.138		738.336		738.533		738.713		738.713	738.521	738.279		738.193	
22-22	737.946	738.019		738.218		738.417		738.597		738.598	738.406	738.166		738.080	
23-23	737.820	737.895		738.097		738.298		738.480		738.481	738.290	738.051		737.965	
24-24	737.699	737.767		737.971		738.175		738.359		738.360	738.171	737.933		737.848	
25-25	737.552	737.632		737.840		738.046		738.233		738.234	738.047	737.812		737.727	
26-26	737.409	737.490		737.701		737.910		738.101		738.102	737.918	737.685		737.602	
27-27	737.258	737.341		737.556		737.768		737.962		737.963	737.783	737.553		737.471	
28-28	737.100	737.185		737.403		737.619		737.816		737.818	737.640	737.414		737.333	
29-29	736.934	737.021		737.242		737.462		737.663		737.665	737.491	737.268		737.188	
30-30	736.762	736.849		737.074		737.298		737.502		737.504	737.333	737.114		737.036	
31-31	736.582	736.670		736.898		737.125		737.333		737.336	737.169	736.953		736.876	
32-32	736.396	736.484		736.716		736.946		737.157		737.160	736.996	736.784		736.708	
33-33	736.204	736.292		736.527		736.760		736.974		736.977	736.816	736.608		736.533	
34-34	736.007	736.094		736.332		736.568		736.785		736.788	736.630	736.425		736.351	
35-35	735.806	735.893		736.132		736.370		736.590		736.593	736.437	736.235		736.162	
36-36	735.601	735.688		735.928		736.168		736.390		736.393	736.240	736.039		735.968	
37-37	735.395	735.481		735.722		735.963		736.186		736.190	736.037	735.839		735.768	
38-38	735.240	735.310		735.515		735.756		735.980		735.983	735.832	735.635		735.565	
39-39	735.126	735.197		735.394		735.590		735.773		735.776	735.625	735.429		735.359	
40-40	735.010	735.084		735.281		735.477		735.656		735.656	735.463	735.222		735.152	
41-41	734.891	734.967		735.165		735.363		735.542		735.543	735.350	735.109		735.023	
42-42	734.768	734.846		735.046		735.246		735.427		735.428	735.236	734.996		734.910	
43-43	734.639	734.720		734.923		735.125		735.308		735.309	735.119	734.880		734.795	
44-44	734.504	734.587		734.794		734.998		735.185		735.185	734.998	734.761		734.676	
45-45	734.363	734.448		734.658		734.866		735.055		735.056	734.871	734.637		734.553	
46-46	734.215	734.302		734.515		734.727		734.919		734.920	734.738	734.507		734.425	
47-47	734.060	734.148		734.365		734.580		734.776		734.777	734.599	734.371		734.289	
48-48	733.897	733.987		734.207		734.426		734.625		734.627	734.452	734.228		734.147	

ALL SCREED ELEVATIONS GIVEN ARE TOP OF DECK ELEVATIONS INCLUDING POINTS WITHIN THE PARABOLIC CROWN

TAKE ELEVATIONS ON TOP OF BEAM AT POINTS INDICATED AFTER ALL BEAMS ARE SET. READ ELEVATIONS TO THREE DECIMALS USING A TARGET ROD AND LEVEL READINGS IN TABLES UNDER "TOP OF BEAM ELEVATIONS".

COMPUTE DIMENSION "X" AS FOLLOWS

"CONSTRUCTION ELEVATION MINUS "TOP OF BEAM ELEVATION" EQUALS DIMENSION "X". CONSTRUCTION ELEVATION INCLUDES CAMBER DUE TO WEIGHT OF CONCRETE SLAB BARRIER AND FUTURE SURFACING.

MEASURING OF DIMENSION "X" GIVES THE FINAL CHECK ON BEAM TOLERANCES FOR CAMBER, BEAM DAMAGE AND ERRORS IN ERECTION THAT PRODUCE REVERSE CAMBERS, SAGS AND UNSIGHTLY FASMA BEAMS.

FOR SETTING TEMPLATES MEASURE DIMENSION "Y" ABOVE TOP OF BEAM FOR TOP OF TEMPLATE. DO NOT SET TEMPLATE BY ELEVATIONS.

CONSTRUCT BARRIER TO ROADWAY GRADE. DO NOT ADD CAMBER TO BARRIER.

SLAB THICKNESS CONTROL

AFTER THE SLAB FORMS ARE ERECTED AND BEFORE THE SLAB REINFORCEMENT IS PLACED THE RESIDENT ENGINEER SHALL TAKE FIELD ELEVATIONS AT THE SLAB THICKNESS CHECK POINTS AND ENTER THEM IN THE TABLE IN THE SPACE PROVIDED. THE SLAB THICKNESS SHALL THEN BE COMPUTED. IF THE COMPUTED SLAB THICKNESS VARIES MORE THAN 1/4" FROM THE PLAN THICKNESS ALLOWING 1/320 OF THE SLAB SPAN FOR DEFLECTION OF THE FORM WORK, THE FORM SHALL BE ADJUSTED UNTIL THE COMPUTED SLAB THICKNESS IS WITHIN THE TOLERANCE ALLOWED.

TABLE OF ELEVATIONS FOR CONTROL OF SLAB THICKNESS

SLAB CHECK POINT	TOP OF SLAB ELEV.	BOTT. OF SLAB ELEV.	COMPUTED SLAB THICKNESS
V - 1	741.359		
W - 2	741.441		
X - 3	741.521		
Y - 4	741.413		
Z - 5	741.059		
V - 7	740.593		
W - 8	740.658		
X - 9	740.722		
Y - 10	740.597		
Z - 11	740.220		
V - 14	739.412		
W - 15	738.454		
X - 16	738.495		
Y - 17	738.347		
Z - 18	738.948		
V - 21	738.237		
W - 22	738.318		
X - 23	738.398		
Y - 24	738.289		
Z - 25	737.930		
V - 28	737.596		
W - 27	737.662		
X - 28	737.726		
Y - 29	737.601		
Z - 30	737.224		
V - 31	736.784		
W - 32	736.831		
X - 33	736.876		
Y - 34	736.732		
Z - 35	736.336		
V - 39	735.295		
W - 40	735.379		
X - 41	735.462		
Y - 42	735.356		
Z - 43	735.000		
V - 46	734.409		
W - 47	734.473		
X - 48	734.535		

U.S. 62/68 OVER LAWRENCE CREEK SHEET 32  
 COMMONWEALTH OF KENTUCKY  
 DEPARTMENT OF HIGHWAYS

FRANKFORT  
 COUNTY OF  
 MASON  
 U.S. 62/68  
 ROAD  
 STATION 182+67.50 P. E. PROJECT NO.  
 CONSTRUCTION PROJECT NO. MAINTENANCE PROJECT NO.  
 DRAWING NO. 23687








DRAWING SCALE: 1" = 10'  
DRAWING NOT TO SCALE

COUNTY OF	FISCAL YEAR	SHEET NO.	TOTAL SHEETS

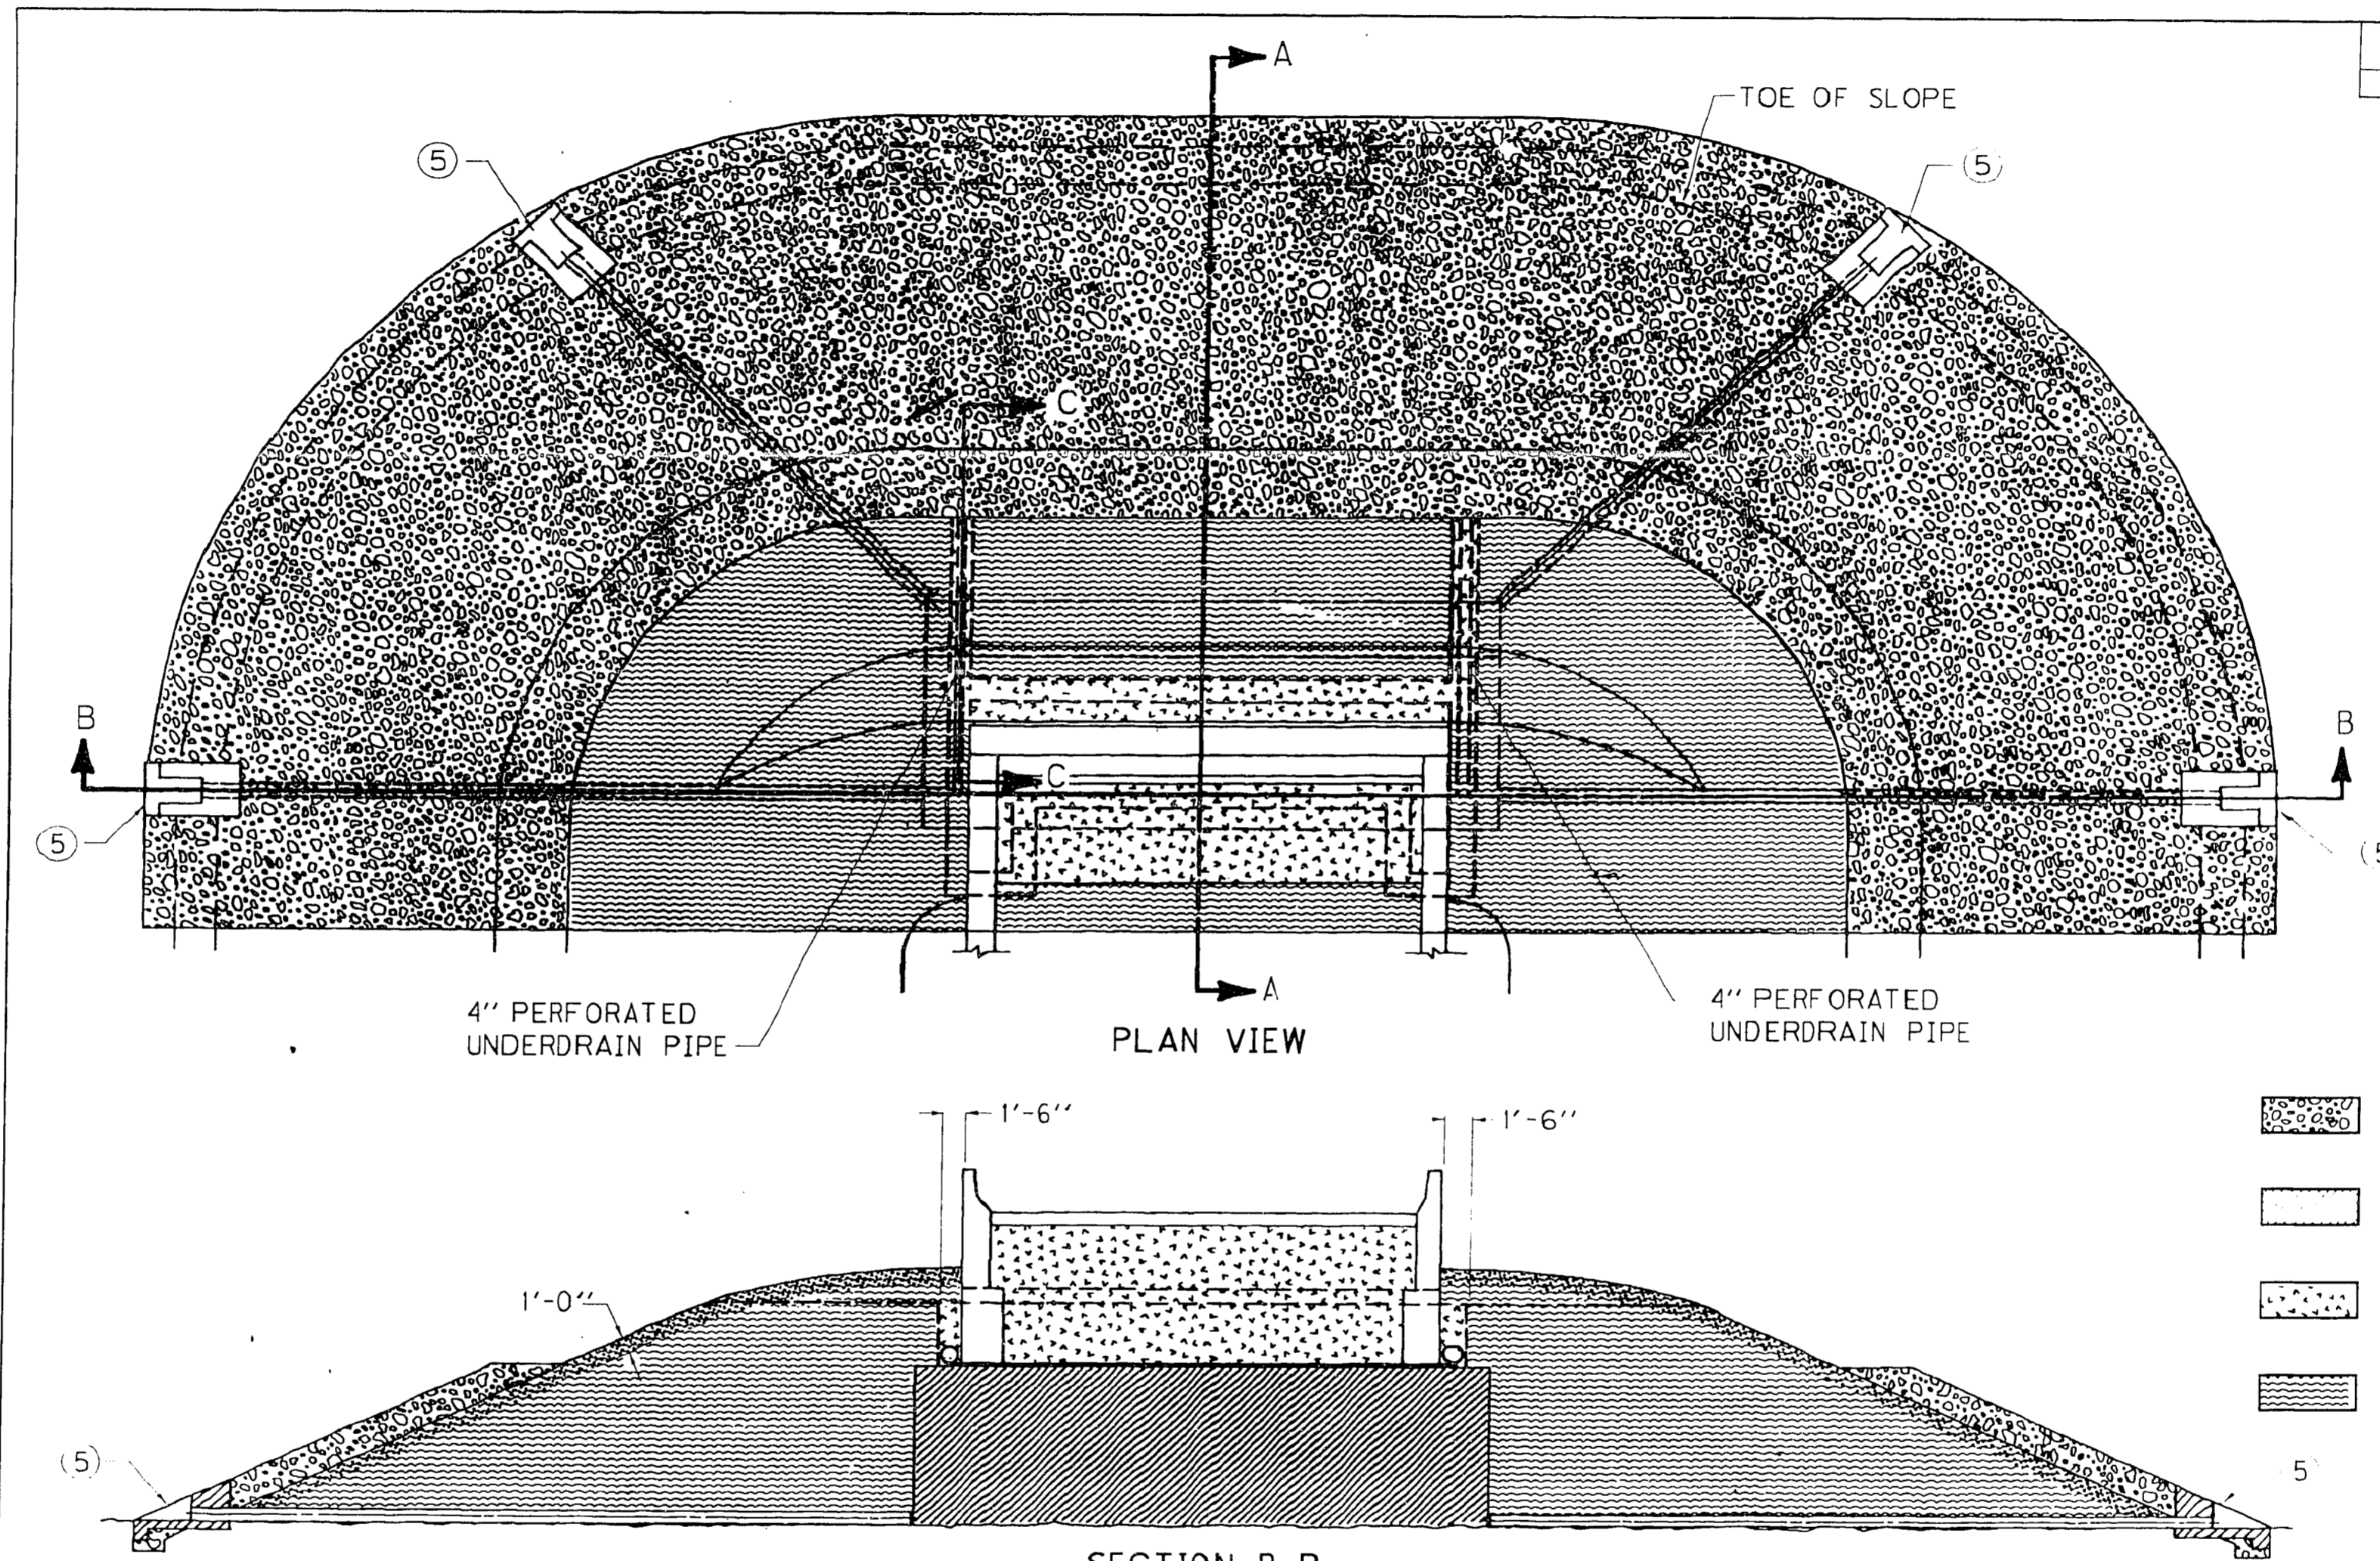

**LEGEND**

	(1) SLOPE PROTECTION (SEE BRIDGE PLANS)
	(2) EARTH CORE
	(3) STRUCTURE GRANULAR BACKFILL
	(4) ROADWAY FILL-GRANULAR EMB.
	(5) 8\"/>

**NOTES:**  
 THE PURPOSE OF THIS DRAWING AND CURRENT STANDARD DRAWING RGX-105 IS TO DEFINE THE LIMITS OF THE FOUR MATERIALS SHOWN. FOR SIMPLICITY PURPOSES, AN END-BENT WITH WINGS ON A ZERO DEGREE SKEW IS SHOWN. THE SAME PRINCIPLES WOULD APPLY FOR MORE VARIED STRUCTURES.  
 SHADED PORTION REPRESENTS LIMITS OF NON-ERODABLE GRANULAR EMBANKMENT.

- (1) SLOPE PROTECTION SHALL BE REQUIRED WHEN AND AS NOTED ON THE BRIDGE PLANS.
- (2) EARTH CORE SHALL BE REQUIRED AT ALL TIMES.
- (3) STRUCTURE GRANULAR BACKFILL SHALL BE REQUIRED AT ALL TIMES.
- (4) ROADWAY FILL-GRANULAR EMBANKMENT SHALL BE REQUIRED WHEN AND AS NOTED ON THE ROADWAY PLANS.
- (5) 8\"/> PERFORATED PIPE WHEN REQUIRED BY CURRENT SPECIAL PROVISION NO. 69. FOR HEADWALL CONSTRUCTION SEE CUR. STD. DWG. RDP-010.

SHEET 34

SEP 051 006L 017-018D / FL 04 00001017-01ED  
 KENTUCKY  
 DEPARTMENT OF HIGHWAYS


**TREATMENT OF  
 EMBANKMENT AT  
 BRIDGE END-BENT  
 STRUCTURES**

SUBMITTED: *Chera S. Dugan* 1/30/92  
DRY CLOVE DIVISION DATE  
 STATE HIGHWAY ENGINEER



DRAWING SCALE: 7/8"  
DRAWING NOT TO SCALE

COUNTY OF	FISCAL YEAR	SHEET NO.	TOTAL SHEETS

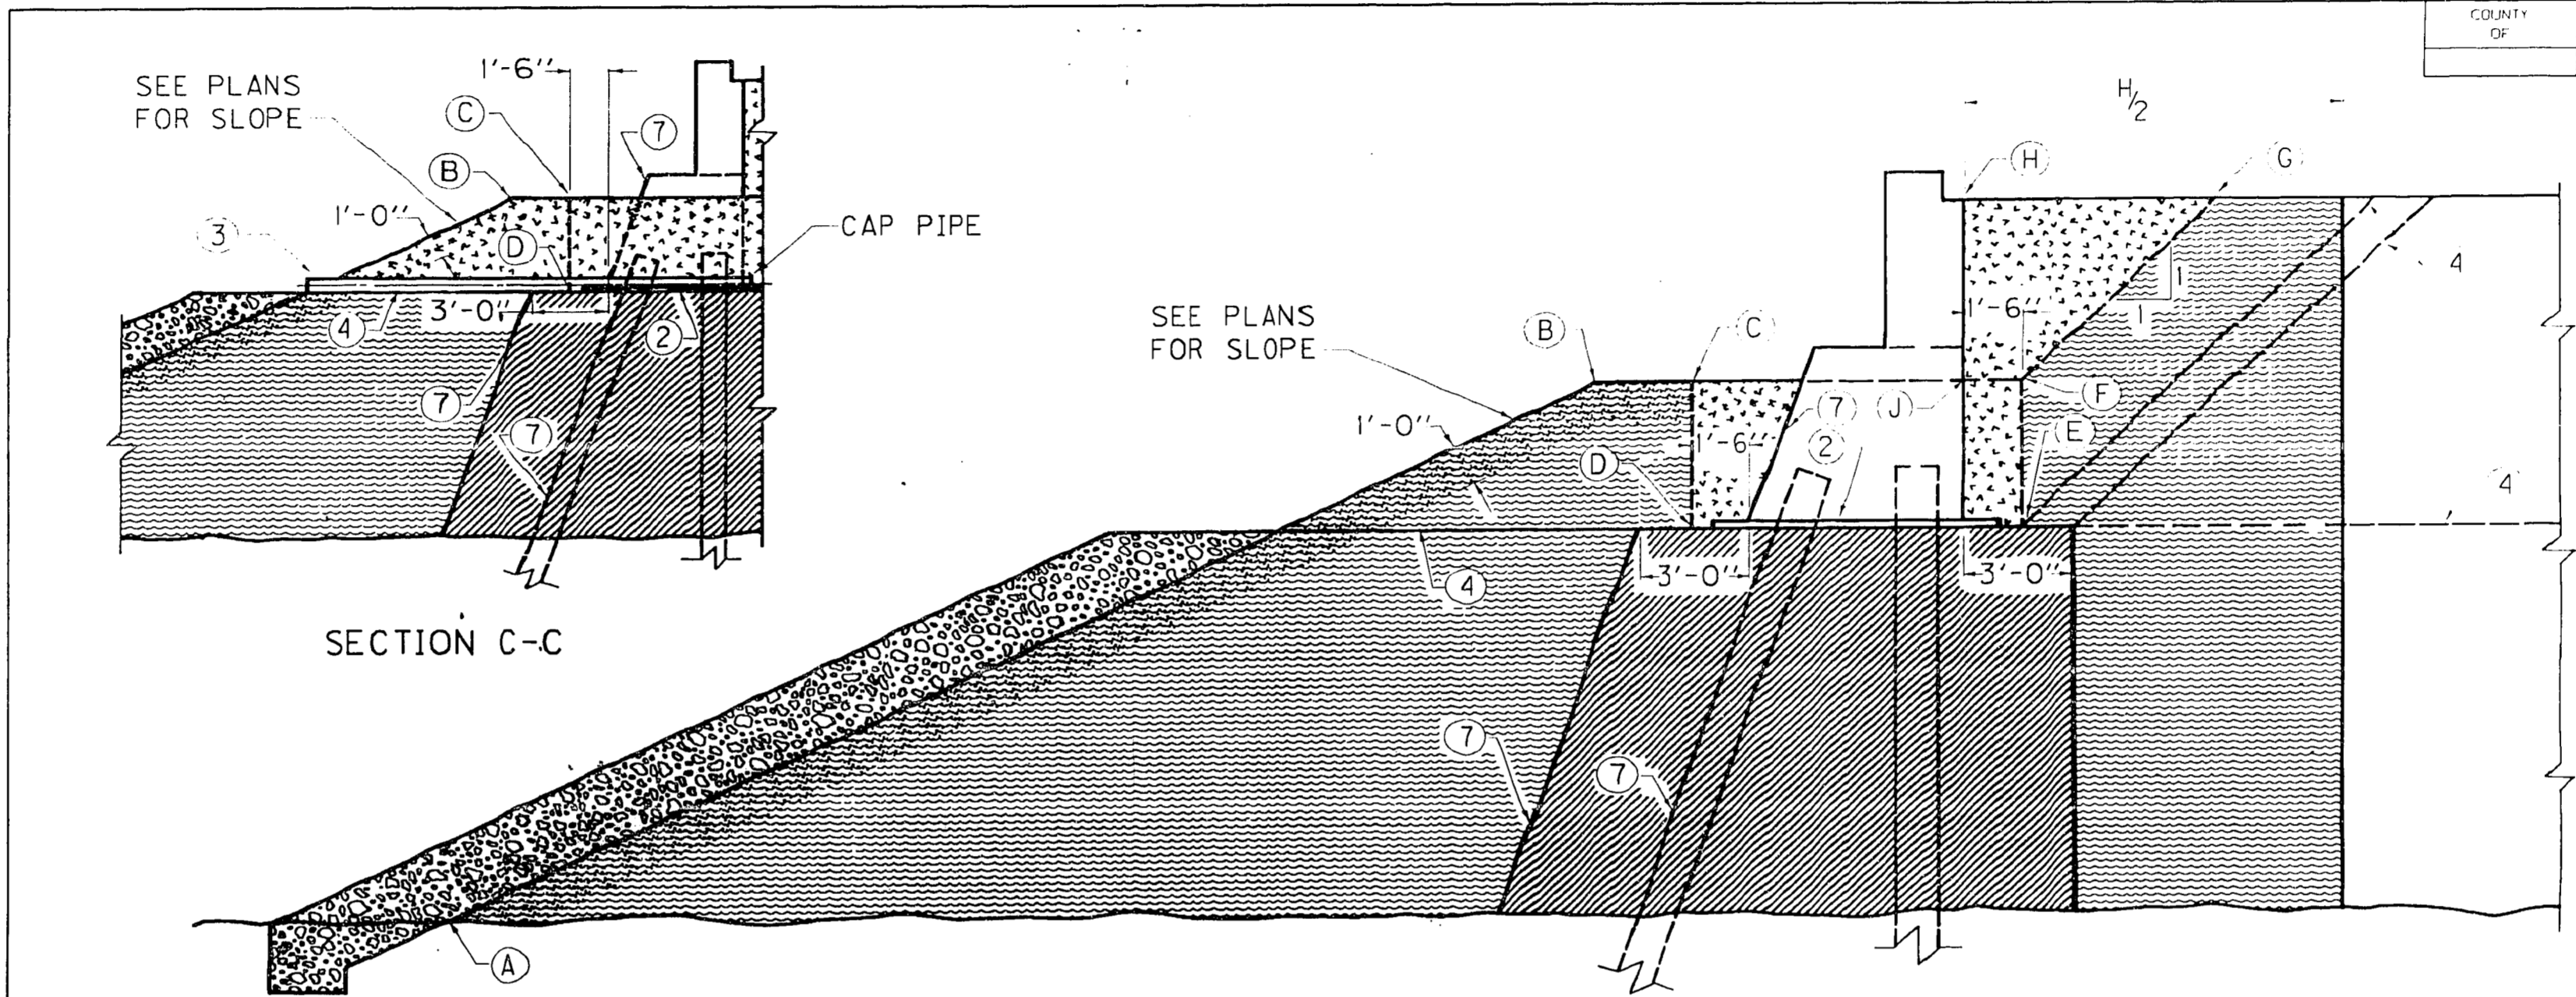

CONSTRUCTION SEQUENCE "A"

1. CONSTRUCT EMBANKMENT TO SLOPES A, B, F, AND G SUCH THAT NO UNCOMPACTED OR LOOSE MATERIAL SHALL REMAIN.
2. EXCAVATE FOR END-BENT TO C, D, E, AND F.
3. DRIVE PILING.
4. PLACE 2" MORTAR BED OR ANY CLASS CONCRETE.
5. CONSTRUCT CONCRETE END-BENT.
6. BACKFILL TO C, D, E, F, G, H, AND J.
7. INSTALL 4" PERFORATED UNDERDRAIN PIPE AND BACKFILL.

① CONSTRUCTION SEQUENCE "B"

1. CONSTRUCT EMBANKMENT TO TEMPORARY SLOPE (4).
2. DRIVE PILING.
3. PLACE 2" MORTAR BED OR ANY CLASS CONCRETE.
4. CONSTRUCT CONCRETE END-BENT.
5. BACKFILL TO FINISHED GRADE.
6. INSTALL 4" PERFORATED UNDERDRAIN PIPE AND BACKFILL.

NOTES

- ① CONSTRUCTION SEQUENCE "B" IS A PERMITTED ALTERNATE BY THE CONTRACTOR ONLY WHEN ROADWAY FILL-GRANULAR EMBANKMENT IS REQUIRED.
- ② 2" MORTAR BED OR ANY CLASS CONCRETE.
- ③ 4" PERFORATED UNDERDRAIN PIPE WRAPPED WITH FILTER FABRIC FOR DRAINING THE EXCAVATED TRENCH AND STRUCTURE GRANULAR BACKFILL.
- ④ ACCEPTABLE ALTERNATES FOR TEMPORARY SLOPES (CONSTRUCTION SEQUENCE "B").
5. H = EMBANKMENT HEIGHT MEASURED FROM SUBGRADE ELEVATION AT POINT (H) TO THE LOWEST ELEVATION AT THE TOE OF THE SLOPE.
6. SHADED PORTION [diagonal lines] AND [stippled] REPRESENTS LIMITS OF NON-ERODABLE GRANULAR EMBANKMENT.
- ⑦ SLOPES ARE EQUAL.
8. SEE CUR. SPECIAL PROVISION NO. 69 FOR CONSTRUCTION AND MATERIAL REQUIREMENTS, METHOD OF MEASUREMENT AND BASIS OF PAYMENT.
9. STRUCTURE GRANULAR BACKFILL SHALL BE PLACED AS A COMPLETE SEPARATE OPERATION AFTER CONSTRUCTION OF ALL OTHER EMBANKMENT.
10. INDIVIDUAL FRAGMENTS LARGER THAN 4 INCHES IN ANY DIMENSION SHALL NOT BE PERMITTED WITHIN 3 FEET OF THE STRUCTURE.

LEGEND

[stippled pattern]	SLOPE PROTECTION (SEE BRIDGE PLANS)
[diagonal lines]	EARTH CORE
[stippled pattern]	STRUCTURE GRANULAR BACKFILL
[horizontal lines]	ROADWAY FILL-GRANULAR EMBANKMENT

SHEET 35

SSF 0810062 CIP-18L/FLC-1502 H-17-018 D


KENTUCKY  
DEPARTMENT OF HIGHWAYS

TREATMENT OF  
EMBANKMENT AT  
BRIDGE END-BENT  
STRUCTURES

SUBMITTED: *Charles J. Rayne* 1/30/52  
APPROVED: STATE HIGHWAY ENGINEER


DATE: 1/30/52  
 DRAWN BY: J. A. [unclear]  
 CHECKED BY: [unclear]  
 REVISIONS: [unclear]  
 APPROVED BY: [unclear]

UPDATE DATE  
LETTING DATE

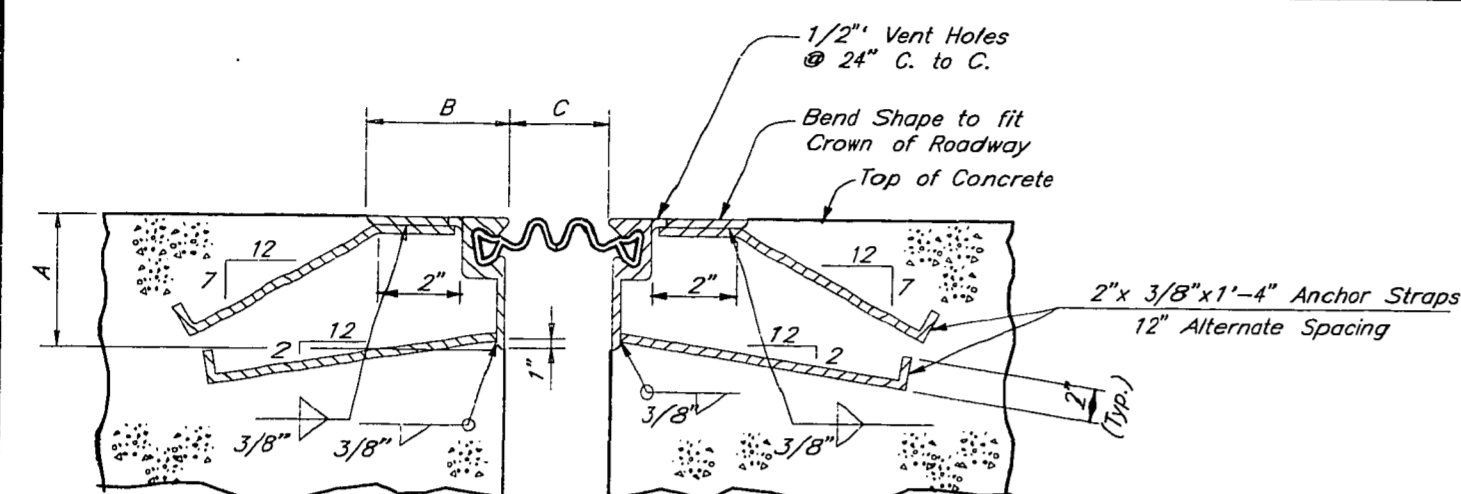


**CROSS SECTION ~ TYPE "A"**

Shop Splice is Permissible in Steel Using Continuous Groove welds.

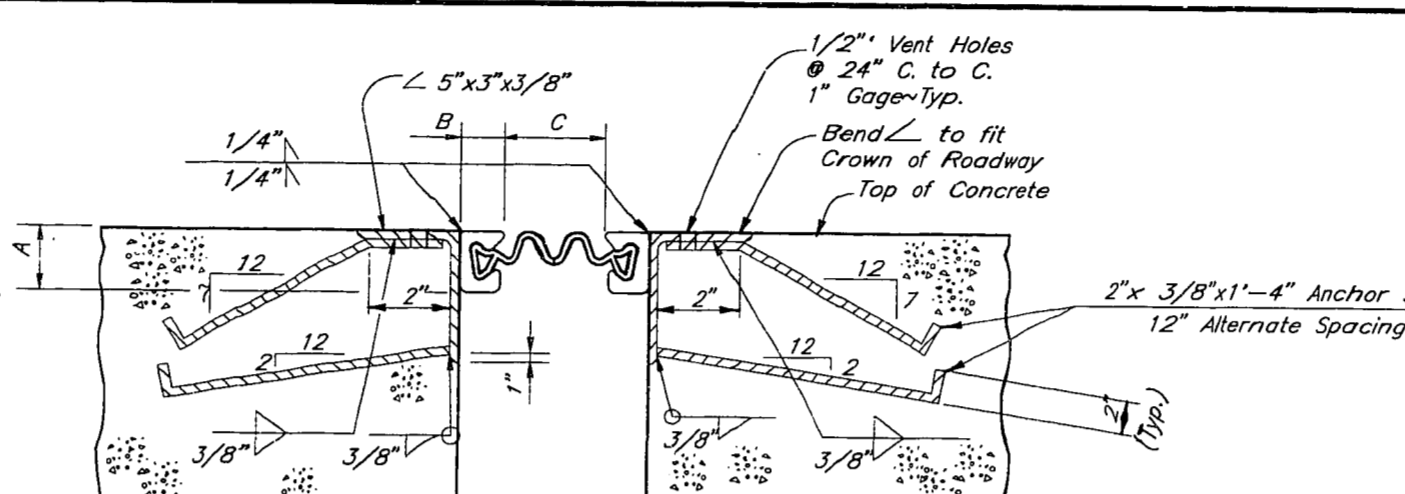


**CROSS SECTION ~ TYPE "B"**

Shop Splice is Permissible in Steel Using Continuous Groove welds.

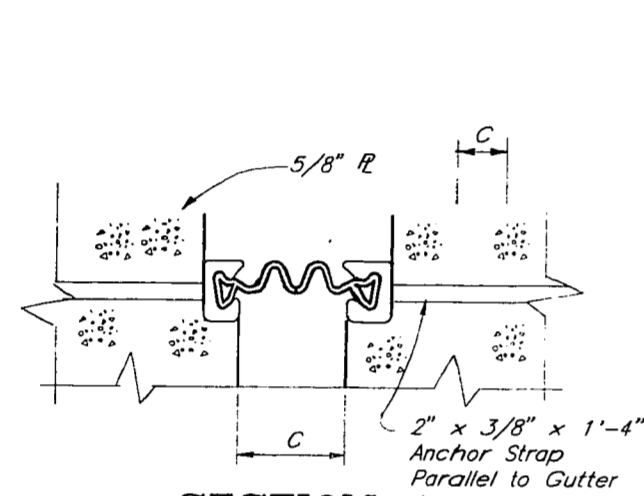


**SECTION A-A**

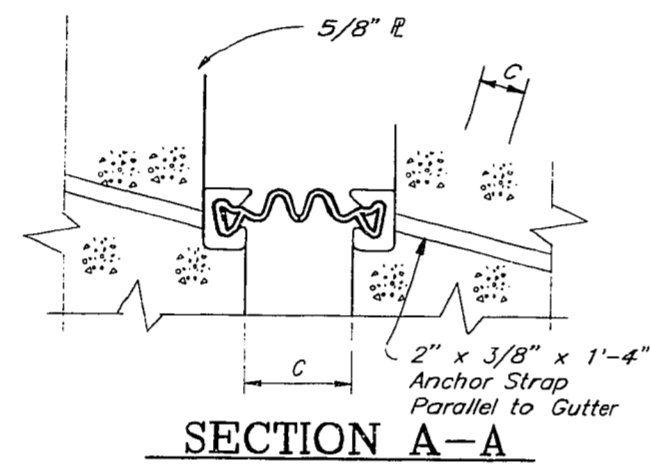


**SECTION A-A**

Note:  
Joint Openings Shall Be Adjusted For Each 10° Above or Below 60° F. Decrease or Increase Respectively by Increment Shown.


INCREMENT FOR 10° TEMPERATURE CHANGE		
— STEEL SPAN —		
180'-240'	241'-320'	321'-360'
3/16"	1/4"	5/16"
— CONCRETE SPAN —		
320'-420'	421'-560'	561'-700'
3/16"	1/4"	5/16"

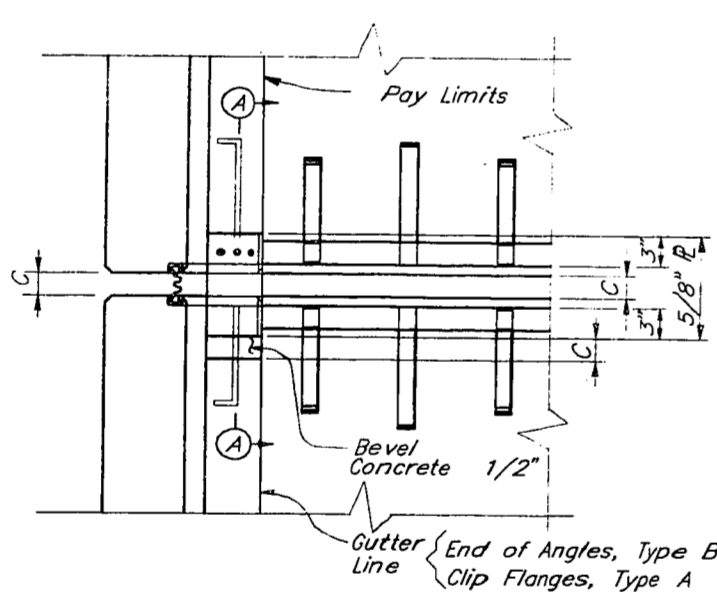

**TYPICAL END TREATMENT  
0° SKEWED BRIDGE**

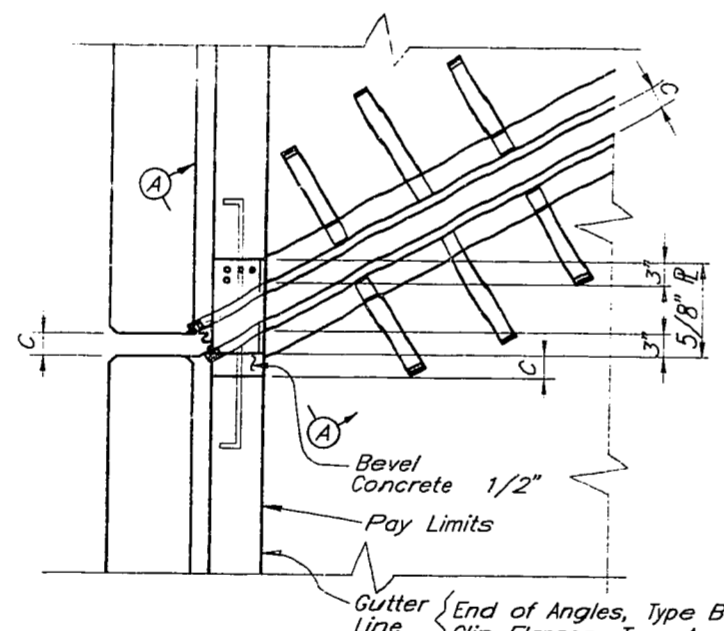

**TYPICAL END TREATMENT  
SKEWED BRIDGE**

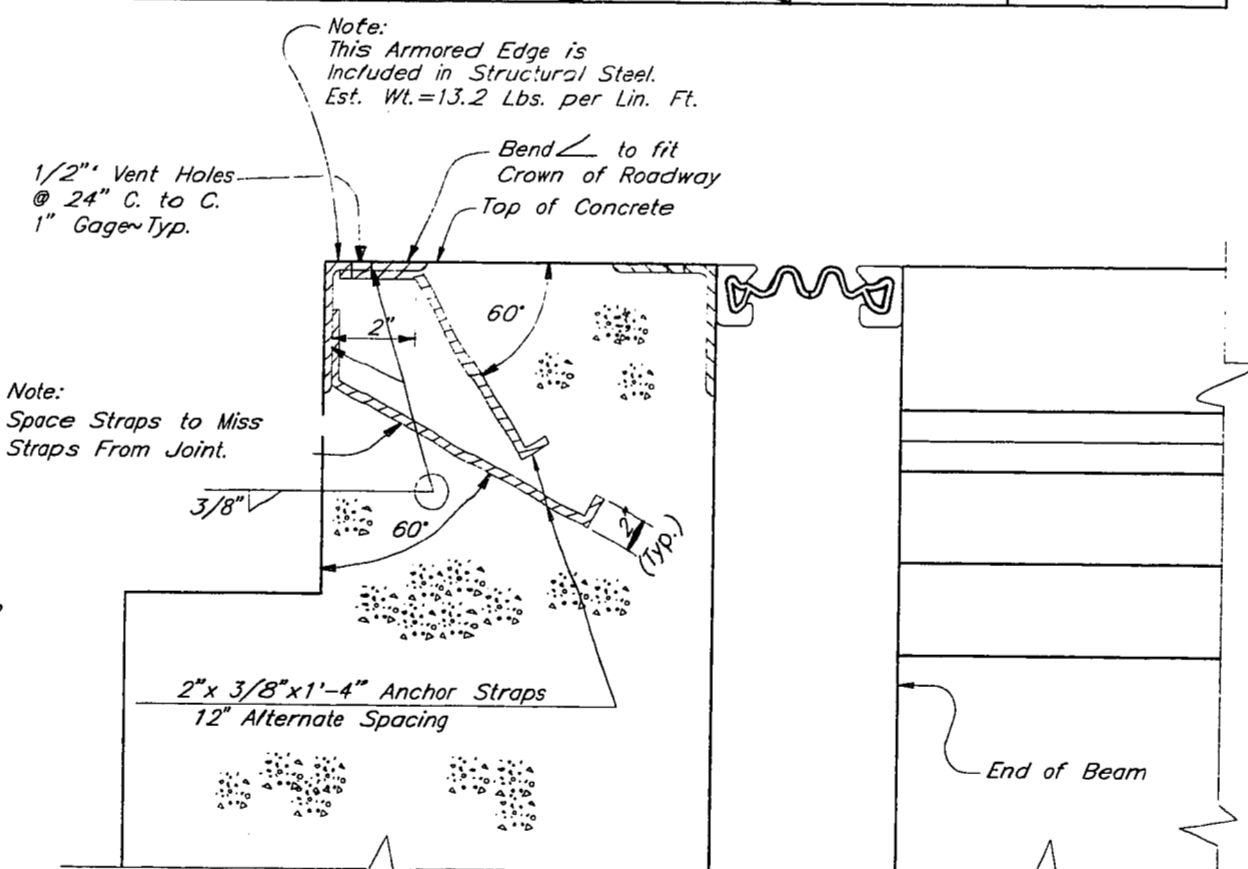

**CROSS SECTION OF EXPANSION DAM AT ABUTMENT**

**NEOPRENE EXPANSION DAM (4")**

**GENERAL NOTES**

**SPECIFICATIONS**

THE KENTUCKY DEPARTMENT OF HIGHWAYS STANDARD SPECIFICATIONS FOR ROAD AND BRIDGE CONSTRUCTION, CURRENT EDITION SHALL APPLY TO THIS PROJECT.

**INSTALLATION PROCEDURE**

THE ENDS OF THE JOINT SEAL SHALL BE SEALED TO PREVENT THE ENTRANCE OF WATER AND FOREIGN MATERIAL.

**WELDING SPECIFICATIONS**

TECHNIQUES AND WELDING PROCEDURE SHALL COMPLY WITH JOINT SPECIFICATION ANS/ AASHTO/AWS D1.5-88 BRIDGE WELDING CODE WITH REVISIONS.

**BASIS OF PAYMENT**

THE ACCEPTED QUANTITIES OF EXPANSION DAM WILL BE PAID FOR AT THE CONTRACT UNIT PRICE PER LINEAR FOOT FOR EACH SIZE, MEASURED ALONG THE CENTERLINE OF JOINT. THIS PAYMENT SHALL BE FULL COMPENSATION FOR ALL MATERIALS (INCLUDING JOINT SEAL, ARMORED EDGES, ANCHOR STRAPS, 1" X 3/16" BARS, WELDING AND WELDING MATERIALS AND INSTALLING HARDWARE) AND INSTALLATION. PAYMENT WILL BE MADE UNDER:

PAY ITEM	PAY UNIT
EXPANSION DAM (4") NEOPRENE	LINEAR FOOT

**MATERIAL SPECIFICATIONS**

STEEL MATERIAL SHALL BE NEW, COMMERCIAL GRADE STEEL SUITABLE FOR WELDING. ACCEPTANCE WILL BE BASED ON VISUAL INSPECTION BY THE ENGINEER. JOINT SEALING MATERIAL, ONLY, SHALL BE IN ACCORDANCE WITH SECTION 807.02.03 OF THE SPECIFICATIONS.

**LOCATION**

THE LOCATION OF EXPANSION DAMS SHALL BE IN ACCORDANCE WITH THE DETAIL PLANS.

**PAINT**

ALL STRUCTURAL STEEL SHALL BE CLEANED AND PAINTED IN ACCORDANCE WITH THE SPECIFICATIONS, EXCEPT THAT AREA IN CONTACT WITH CONCRETE SHALL NOT BE PAINTED.

**PAY LIMITS**

THE PAY LIMITS SHALL BE GUTTER LINE TO GUTTER LINE.

**SHOP PLANS**

CONTRARY TO THE SPECIFICATIONS, SHOP PLANS WILL NOT BE REQUIRED.

**ALTERNATE NEOPRENE EXPANSION DAMS**

TYPE	MODEL	SUPPLIER	A	B	C*
A	WABO STRIP SEAL Type C Extrusion With S-400 Seal	Watson Bowman Associates Inc.	4 1/4"	3 3/4"	2"
A	ONFLEX Type C-C Extrusion With 40SS Seal	Structural Accessories Inc.	4 1/4"	3 3/4"	2"
A	STEEL FLEX Type SSCM With 400 Seal	D. S. Brown Co.	4 1/4"	3 3/4"	2"
B	WABO STRIP SEAL Type A Extrusion With S-400 Seal	Watson Bowman Associates Inc.	2"	1 1/2"	2"
B	STEEL FLEX Type SSA With 400 Seal	D. S. Brown Co.	2"	1 1/2"	2 1/2"
B	GEN STRIP CD Profile A Steel Extrusion With Gen Strip CD Seal	General Tire Co.	2"	1 3/8"	2 1/4"
B	ONFLEX Type AM2 Extrusion With 40SEQ Seal	Structural Accessories Inc.	2"	1 1/4"	2"

\*Joint Opening At 60° F.

U.S. 62/68 OVER LAWRENCE CREEK SHEET 36

COMMONWEALTH OF KENTUCKY  
DEPARTMENT OF HIGHWAYS

FRANKFORT  
COUNTY OF

MASON

U.S. 62/68

ROAD

STATION 182+67.50 P. E. PROJECT NO.

CONSTRUCTION PROJECT NO.

MAINTENANCE PROJECT NO.

DRAWING NO.  
23687

DESIGNED BY: I.D. JESSUP  
CHECKED BY: B.E. MILLER  
PREPARED BY: G.M.H. SECTION  
DATE: 6-5-64  
REVISIONS:  
DATE: 6-5-64  
REVISIONS:  
DATE: 6-5-64